
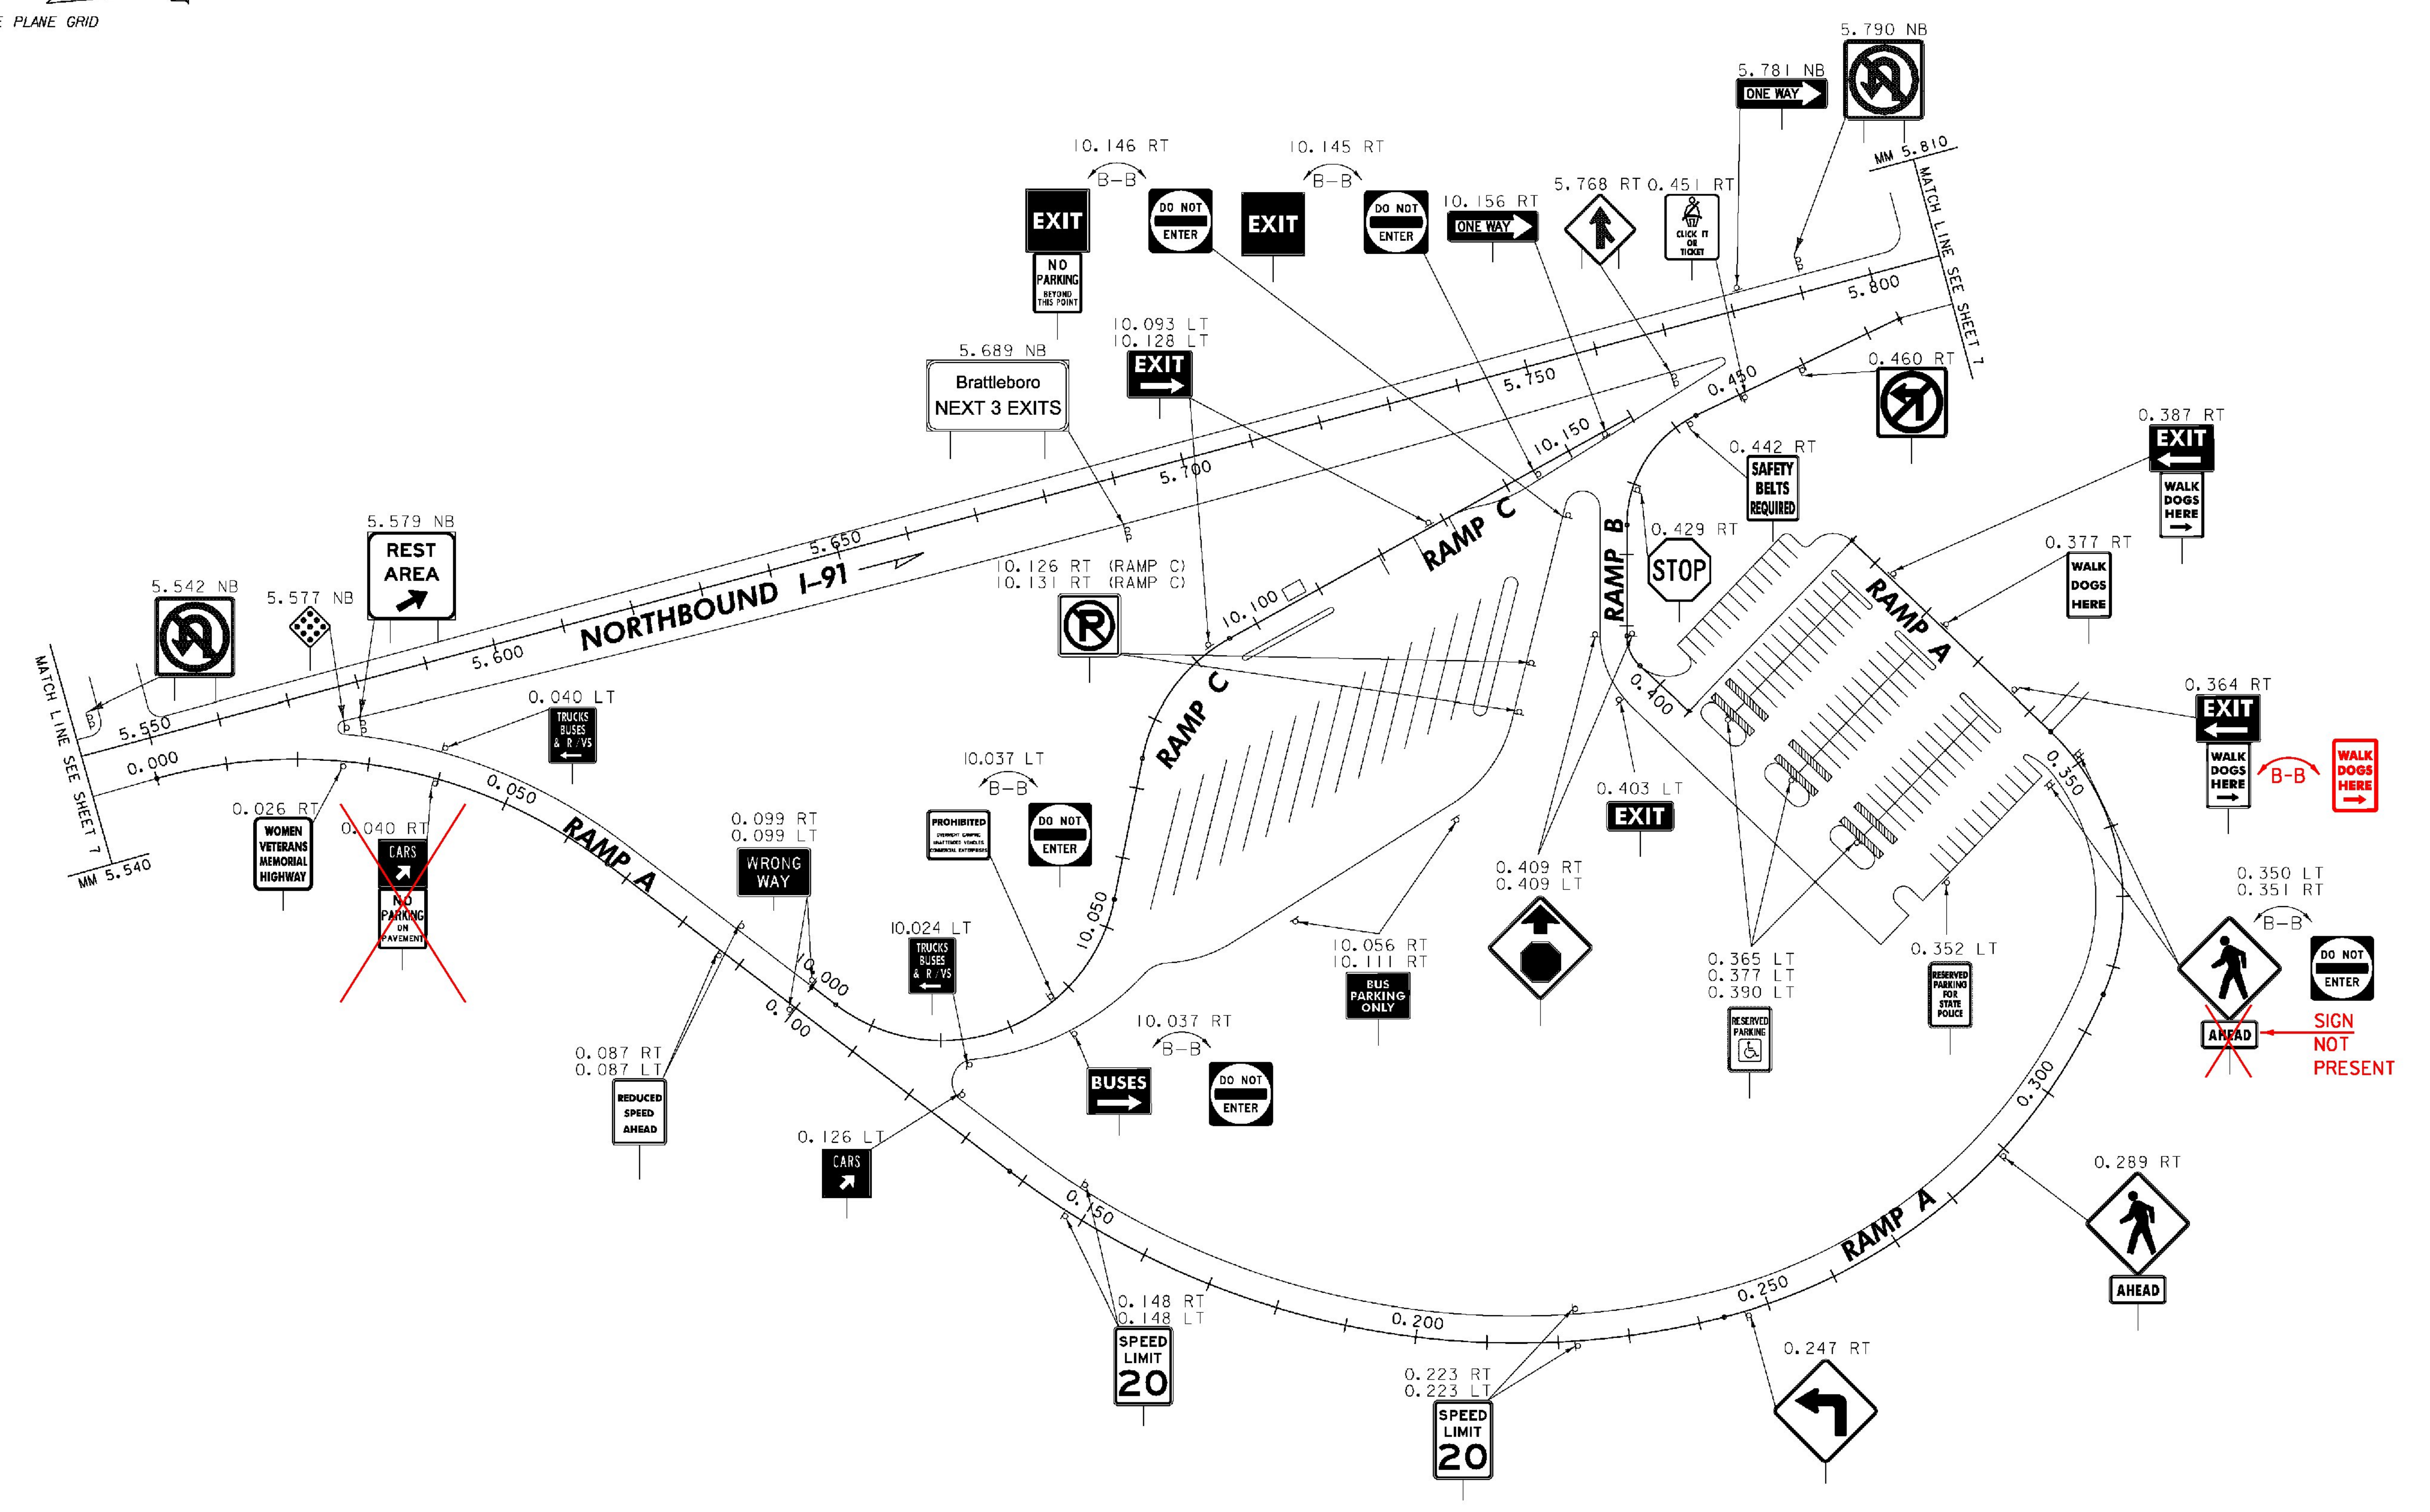


REMOVING SIGNS  
 TYPE A: 60  
 TYPE B: 2

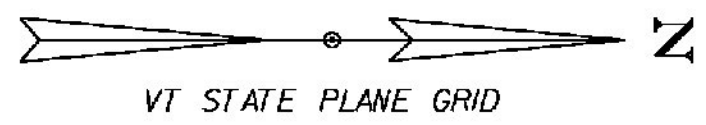

MATCH LINE SEE SHEET 7

MATCH LINE SEE SHEET 1

ALL SIGNS AND POSTS WILL BE REMOVED UNLESS OTHERWISE NOTED

LEGEND  
 [RET] - RETAIN  
 [R&S] - REMOVE & SALVAGE

PROJECT NAME:	GUILFORD-ROCKINGHAM
PROJECT NUMBER:	IMG SIGN(44)
FILE NAME:	z12A528welcome.dgn
PLOT DATE:	4/17/2014
PROJECT LEADER:	C. GREGORY
DRAWN BY:	S. FORTIER
DESIGNED BY:	J. SMITH
CHECKED BY:	D. MUNRO
GUILFORD WELCOME CENTER EXISTING SIGNS	SHEET 20 OF 157

**CLD CONSULTING ENGINEERS**  
 540 Commercial Street, Manchester, NH 03101  
 (603) 668-8223 • Fax: (603) 668-8802  
 cld@cldeengineers.com • www.cldeengineers.com  
 Maine • New Hampshire • Vermont

NOT TO SCALE

CLD 12-0350 MODEL: Existing