





REMOVING SIGNS
 TYPE A: 58
 TYPE B: 2
 BRIDGE PLAQUE: 2

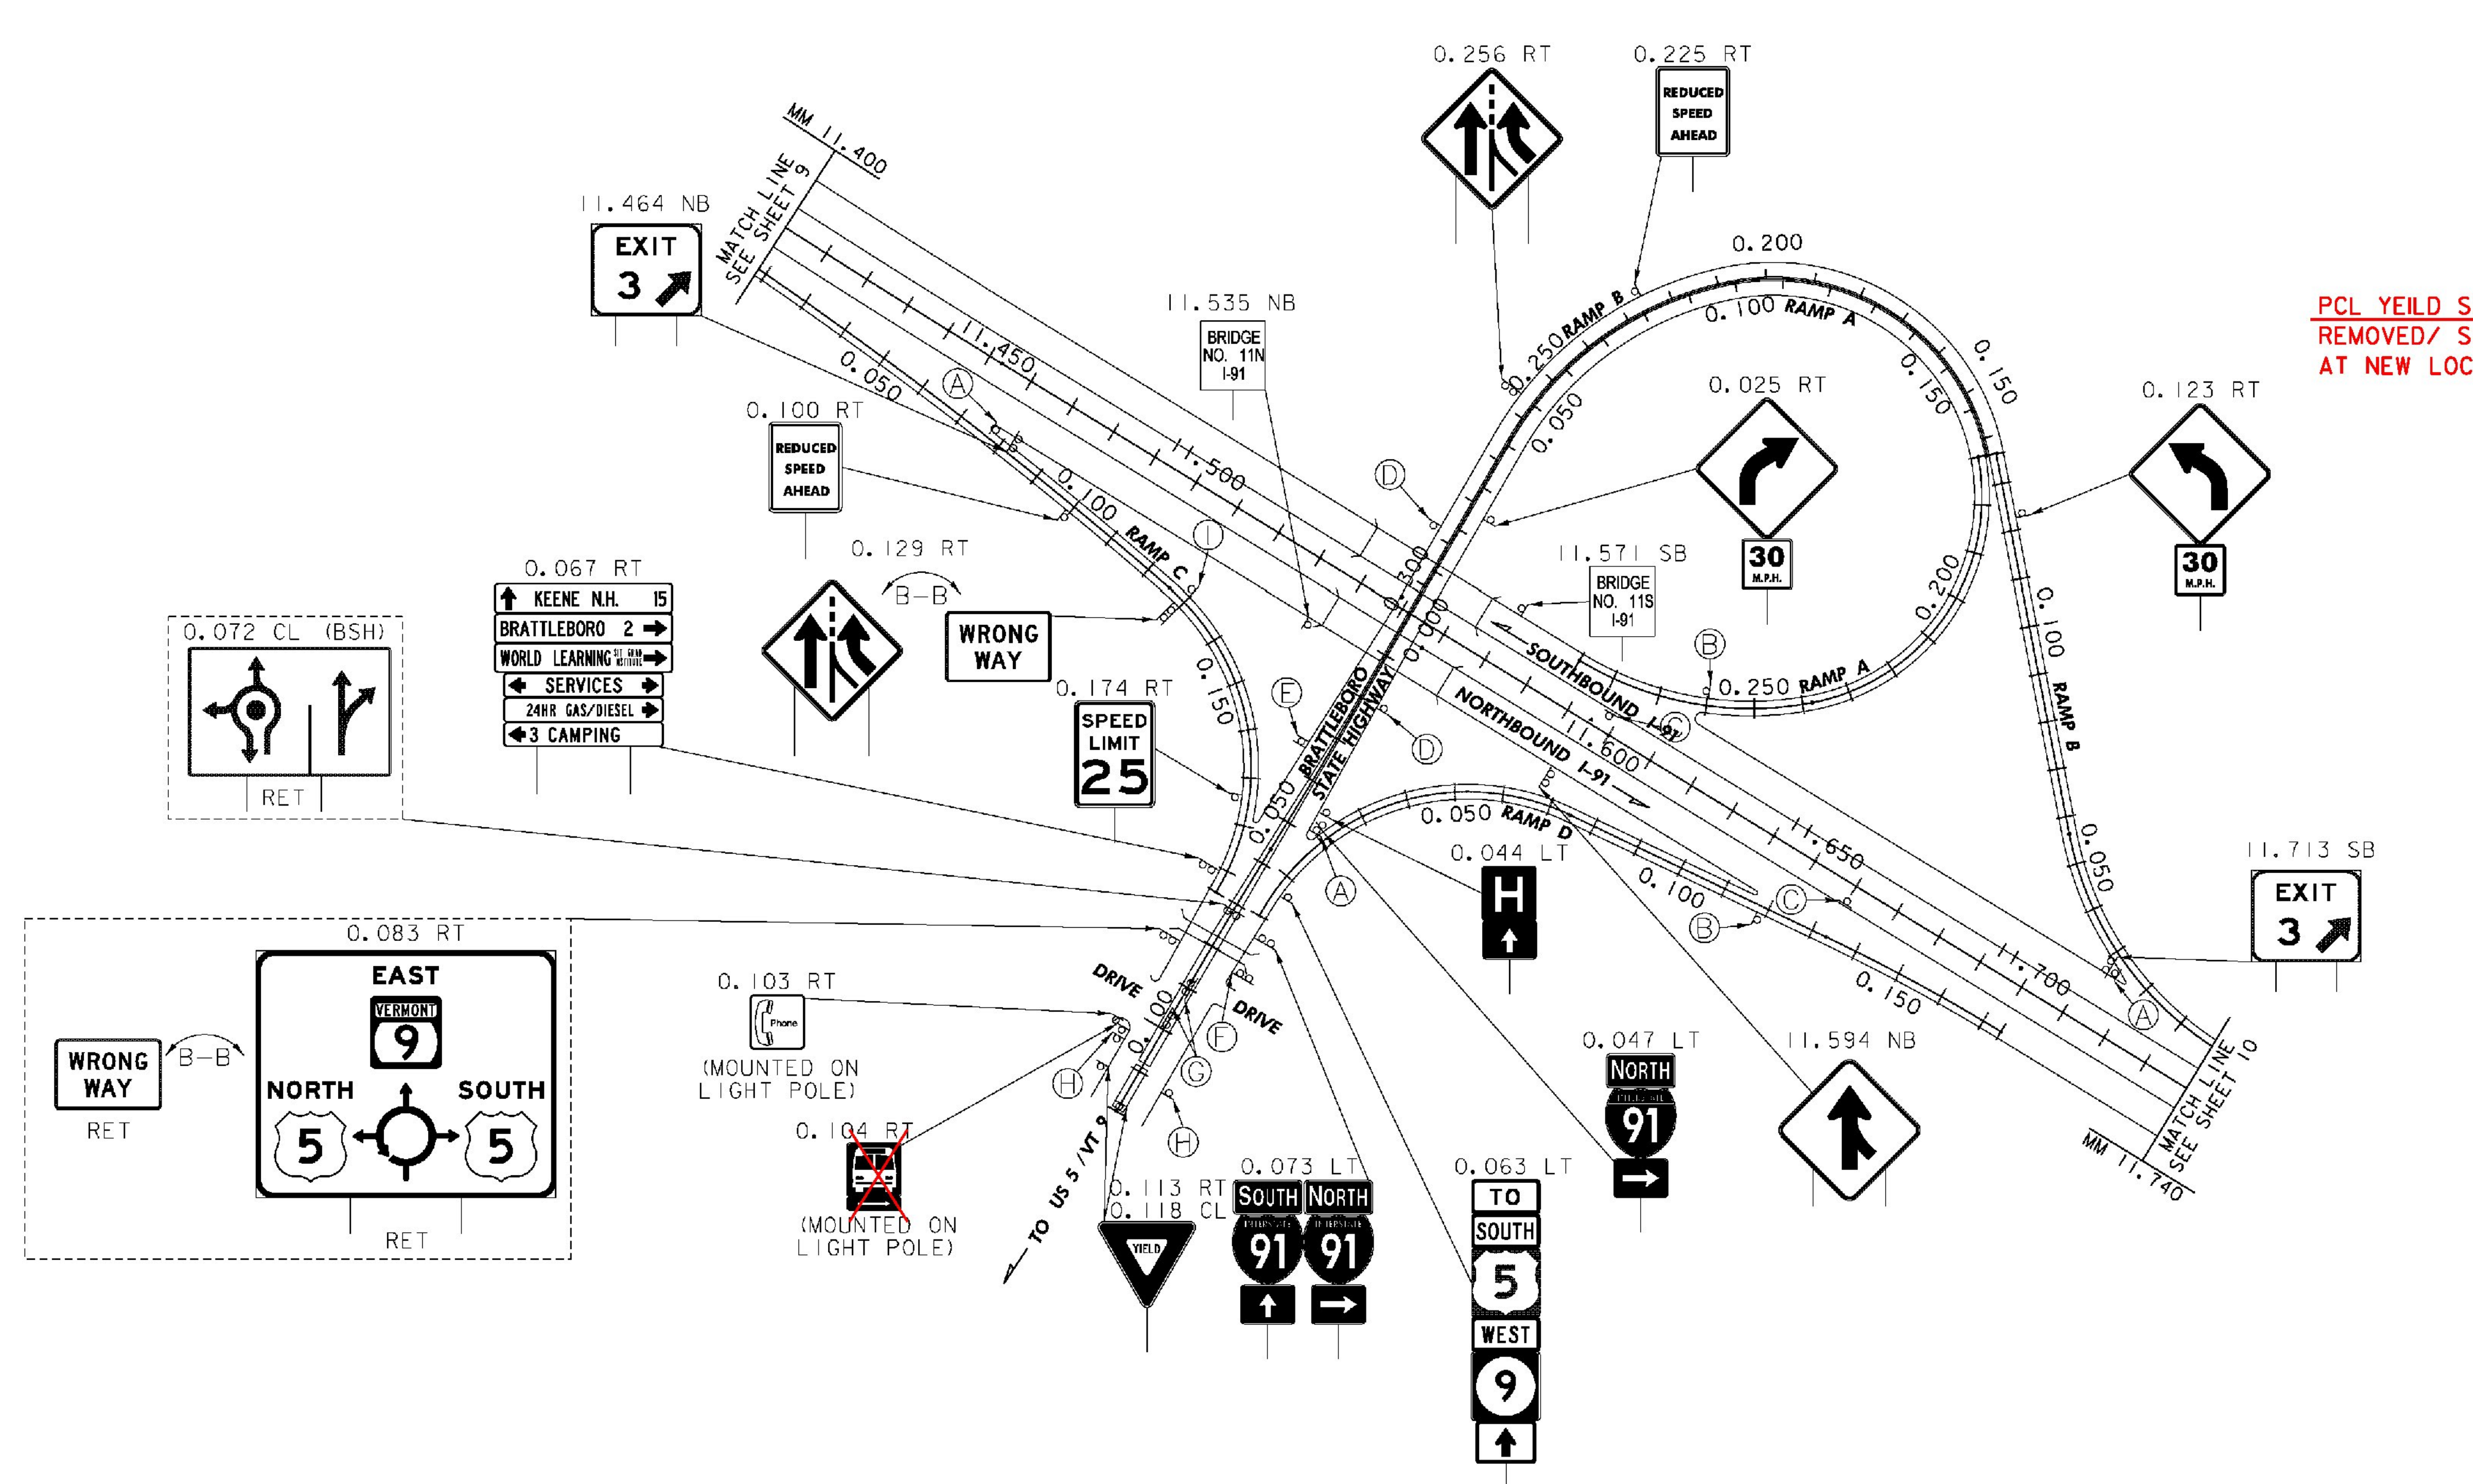

PCL YEILD SIGN
 REMOVED/ SALVAGED
 AT NEW LOCATION

- (A) 11.459 NB
11.715 SB
0.048 LT (BSH)
- (B) 0.260 RT (RAMP A)
0.119 RT (RAMP D)
- (C) 11.598 SB
11.660 NB
- (D) 0.288 RT (RAMP B)
0.020 LT (BSH)
- (E) 0.034 RT (BSH)
- (F) 0.082 LT (BSH)
- (G) 0.090 CL (BSH) (FACING NORTH)
0.098 CL (BSH) (FACING SOUTH)
- (H) 0.106 RT (BSH)
0.111 LT (BSH)
- (I) 0.129 LT (RAMP C)

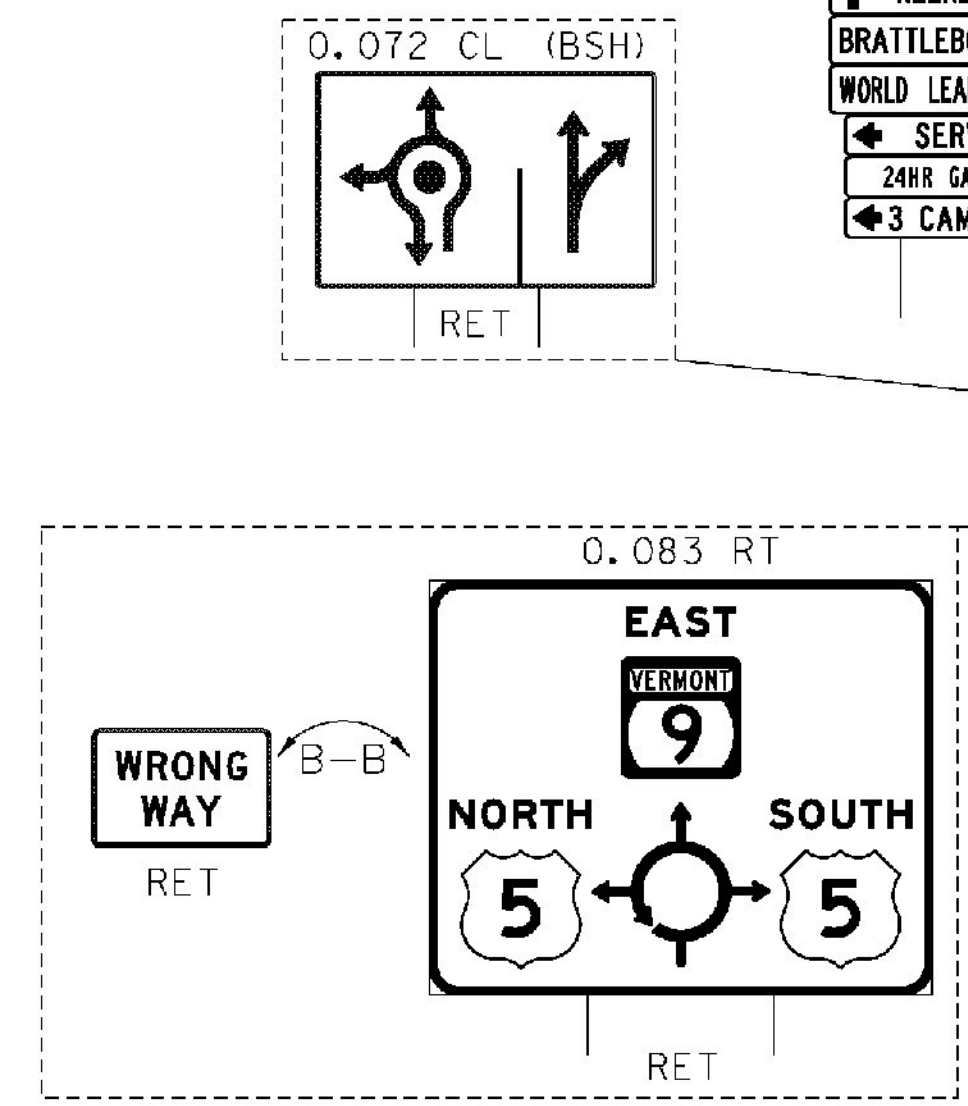

LEGEND
 [RET] - RETAIN
 [R&S] - REMOVE & SALVAGE

ALL SIGNS AND POSTS WILL BE
 REMOVED UNLESS OTHERWISE NOTED

PROJECT NAME:	GUILFORD-ROCKINGHAM
PROJECT NUMBER:	IMG SIGN(44)
FILE NAME:	z12A5281n103.dgn
PROJECT LEADER:	C. GREGORY
DESIGNED BY:	J. SMITH
INTERCHANGE 3 EXISTING SIGNS	
PLOT DATE:	4/17/2014
DRAWN BY:	S. FORTIER
CHECKED BY:	D. MUNRO
SHEET	26 OF 157

CLD CONSULTING ENGINEERS
 540 Commercial Street, Manchester, NH 03101
 (603) 668-8223 • Fax: (603) 668-8802
 cld@cldengineers.com • www.cldengineers.com
 Maine • New Hampshire • Vermont

NOT TO SCALE

CLD 12-0350 MODEL: Existing