


REMOVING SIGNS
 TYPE A: 13
 TYPE B: 1

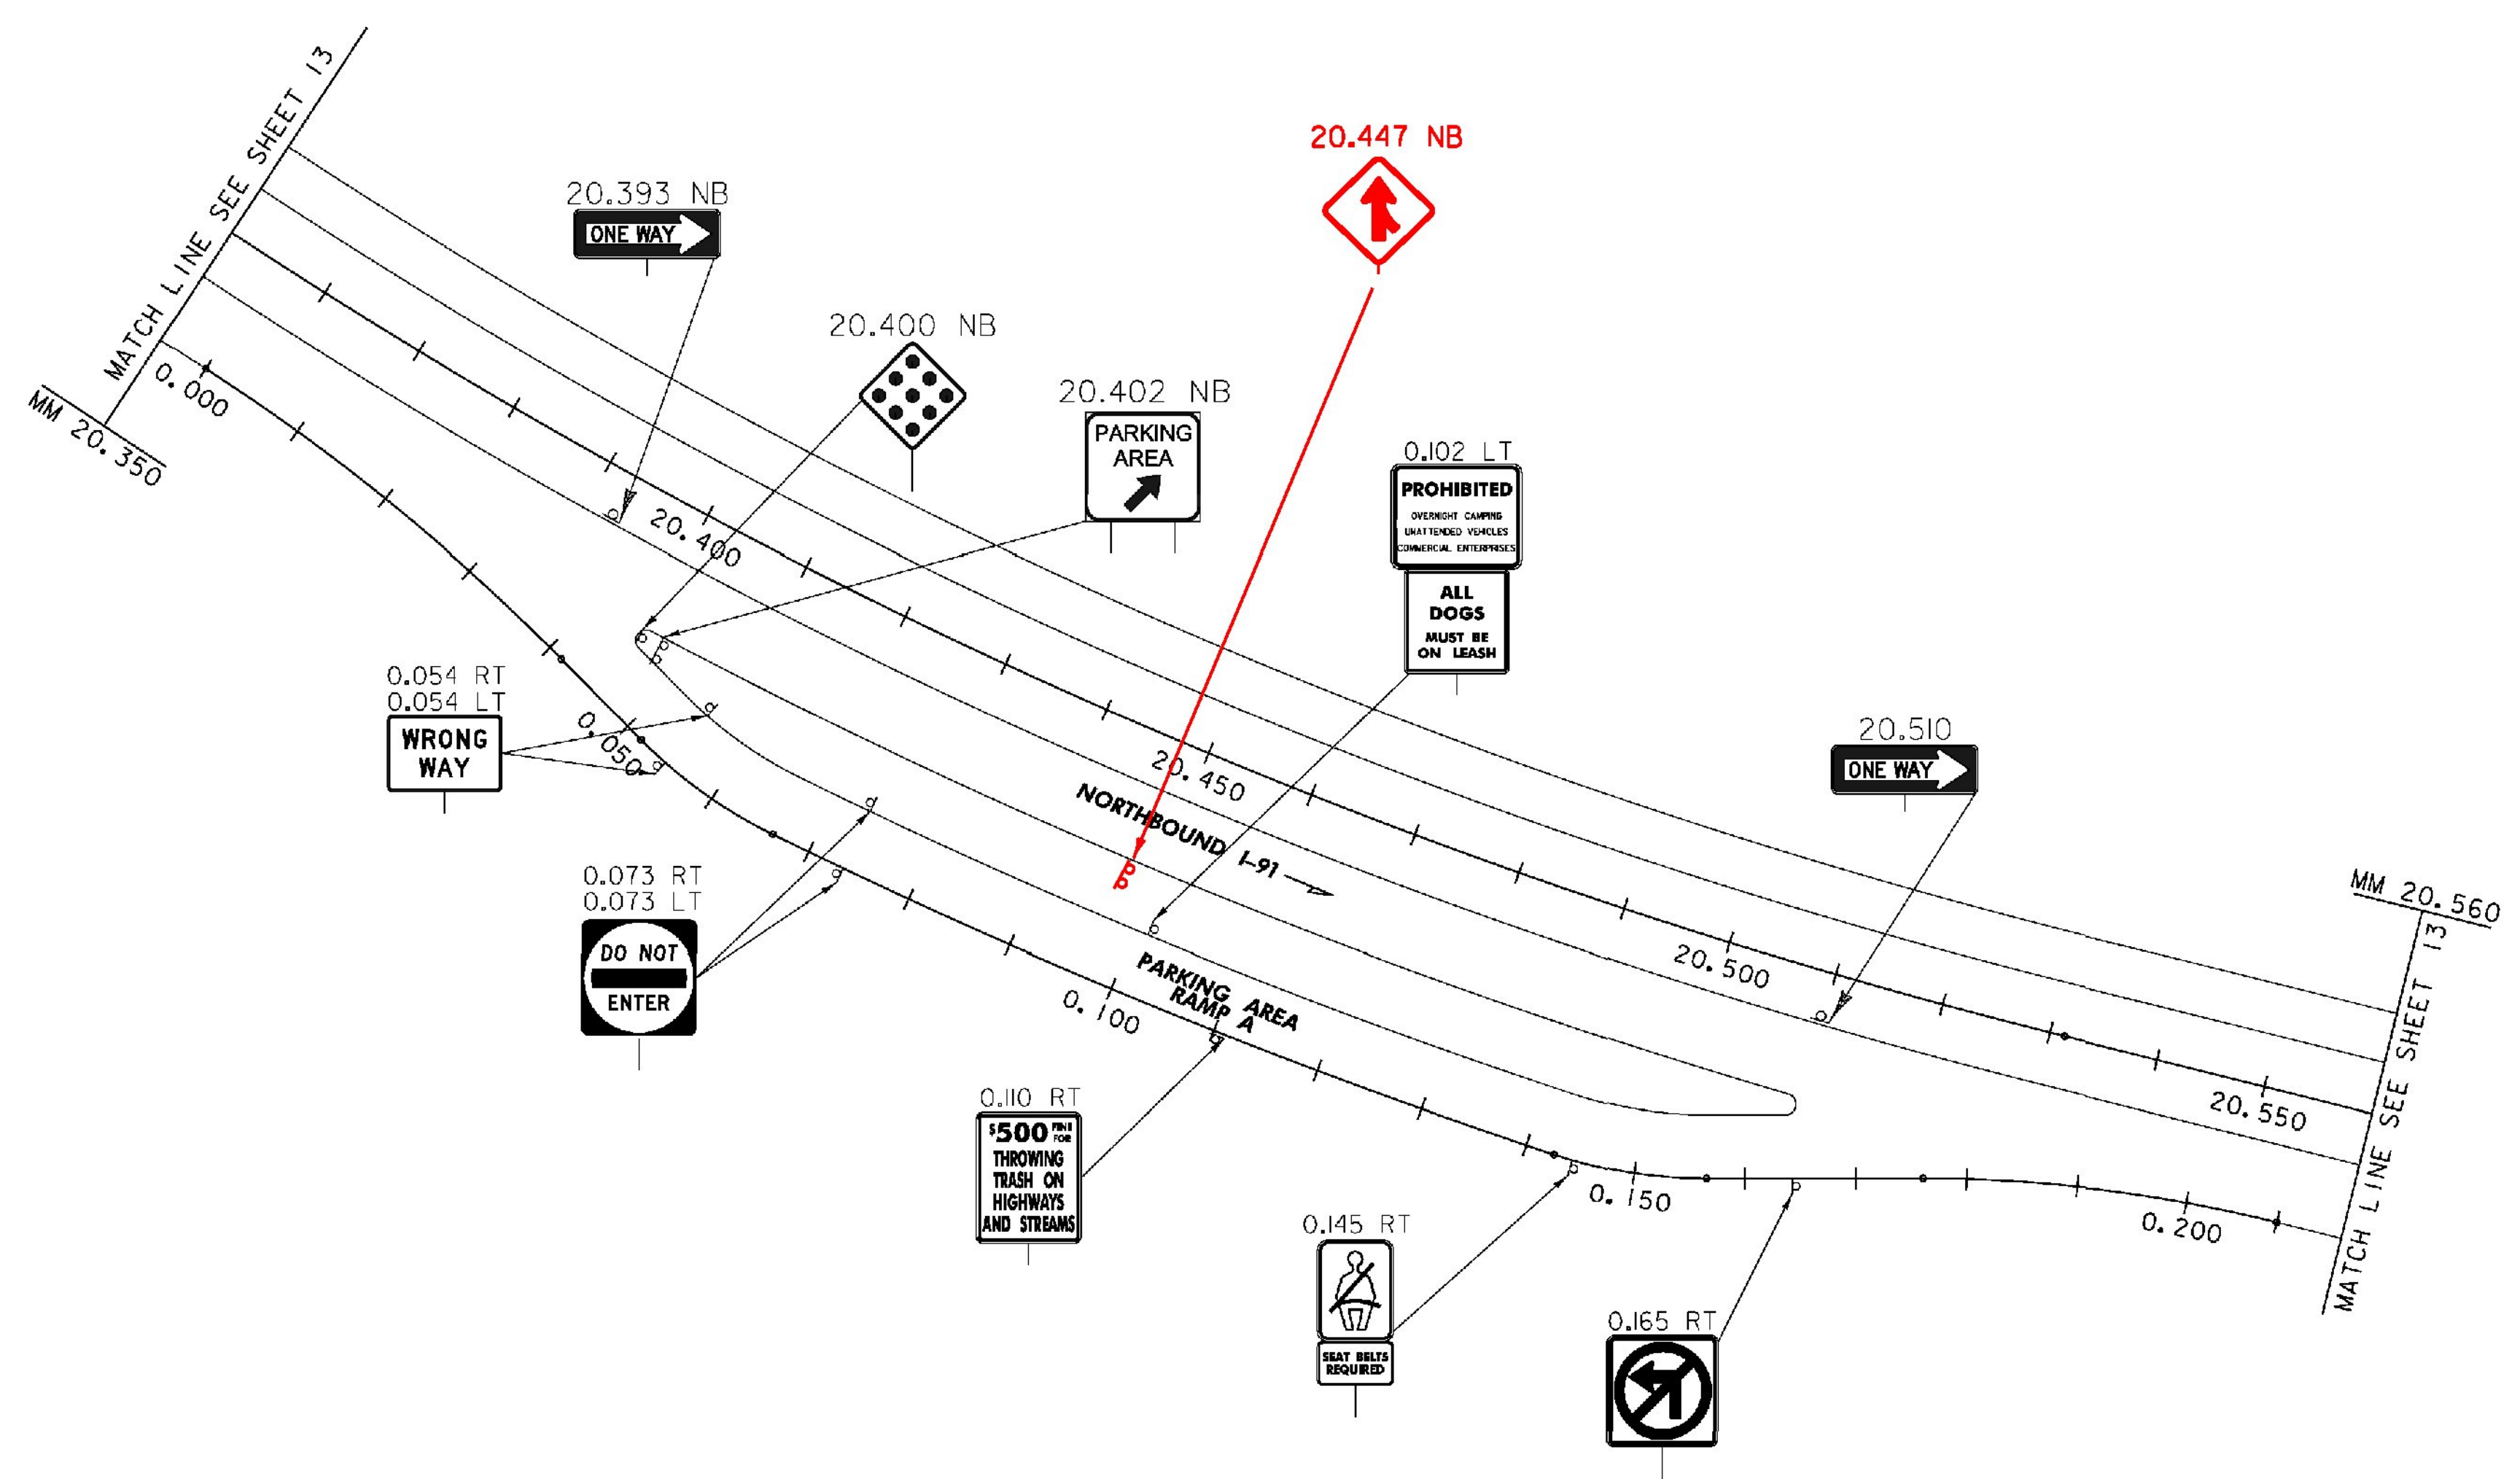

CLD 12-0350 MODEL: Existing Parking NB MM 20.4

NOT TO SCALE

LEGEND
 [RET] - RETAIN
 [R&S] - REMOVE & SALVAGE

ALL SIGNS AND POSTS WILL BE REMOVED UNLESS OTHERWISE NOTED

PROJECT NAME:	GUILFORD-ROCKINGHAM	
PROJECT NUMBER:	IMG SIGN(44)	
FILE NAME:	z12A528parking.dgn	PLOT DATE:
PROJECT LEADER:	C. GREGORY	DRAWN BY:
DESIGNED BY:	J. SMITH	CHECKED BY:
NB PARKING AREA MM 20.4 EXISTING SIGNS		SHEET 30 OF 157

540 Commercial Street, Manchester, NH 03101
 (603) 668-8223 • Fax: (603) 668-8802
 clc@cldeengineers.com • www.cldeengineers.com
 Maine • New Hampshire • Vermont