


REMOVING SIGNS
 TYPE A: 14
 TYPE B: 1

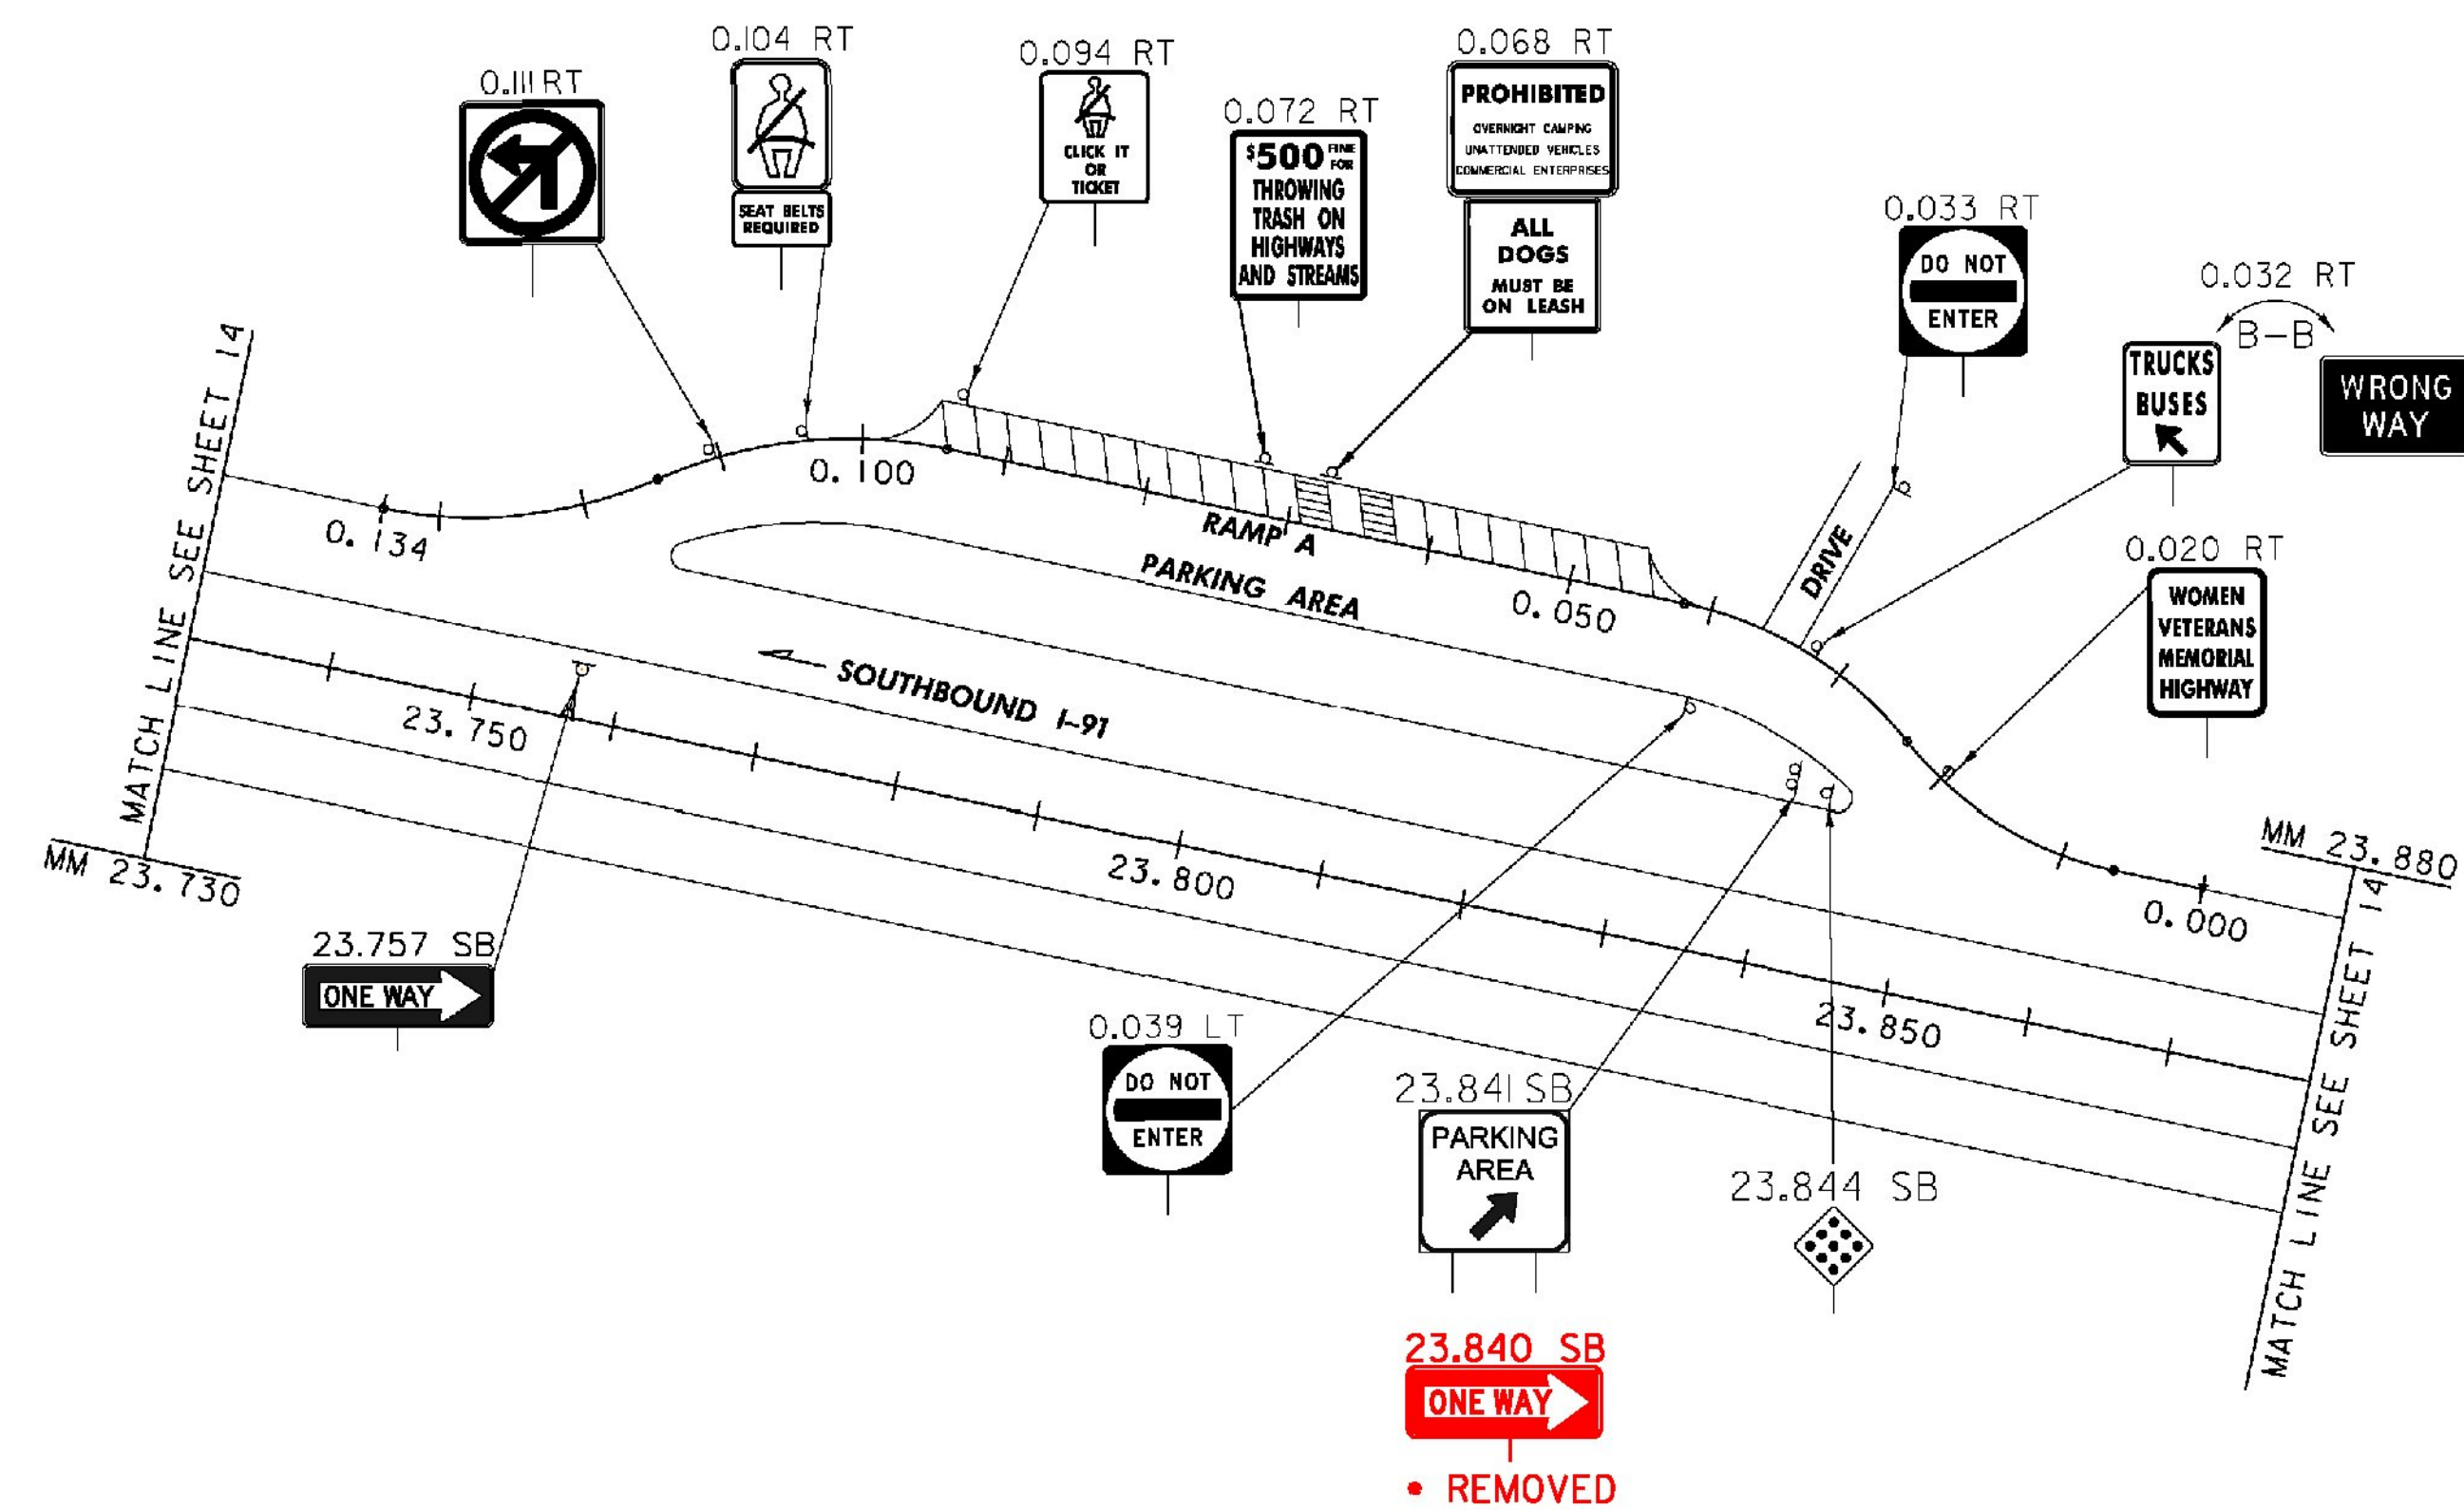

CLD 12-0350 MODEL: Existing Parking SB MM 23.8

NOT TO SCALE

LEGEND
 [RET] - RETAIN
 [R&S] - REMOVE & SALVAGE

ALL SIGNS AND POSTS WILL BE REMOVED UNLESS OTHERWISE NOTED

| | | |
|--|---------------------|-------------|
| PROJECT NAME: | GUILFORD-ROCKINGHAM | |
| PROJECT NUMBER: | IMG SIGN(44) | |
| FILE NAME: | z12A528parking.dgn | PLOT DATE: |
| PROJECT LEADER: | C. GREGORY | DRAWN BY: |
| DESIGNED BY: | J. SMITH | CHECKED BY: |
| SB PARKING AREA MM 23.8 EXISTING SIGNS | | SHEET |
| | | 36 OF 157 |

CLD CONSULTING ENGINEERS
 540 Commercial Street, Manchester, NH 03101
 (603) 868-8223 • Fax: (603) 868-8802
 cld@clidengineers.com • www.cldengineers.com
 Maine • New Hampshire • Vermont