


• NOT INSTALLED DUE TO LOCATION NEAR LOW UTILITY LINE.

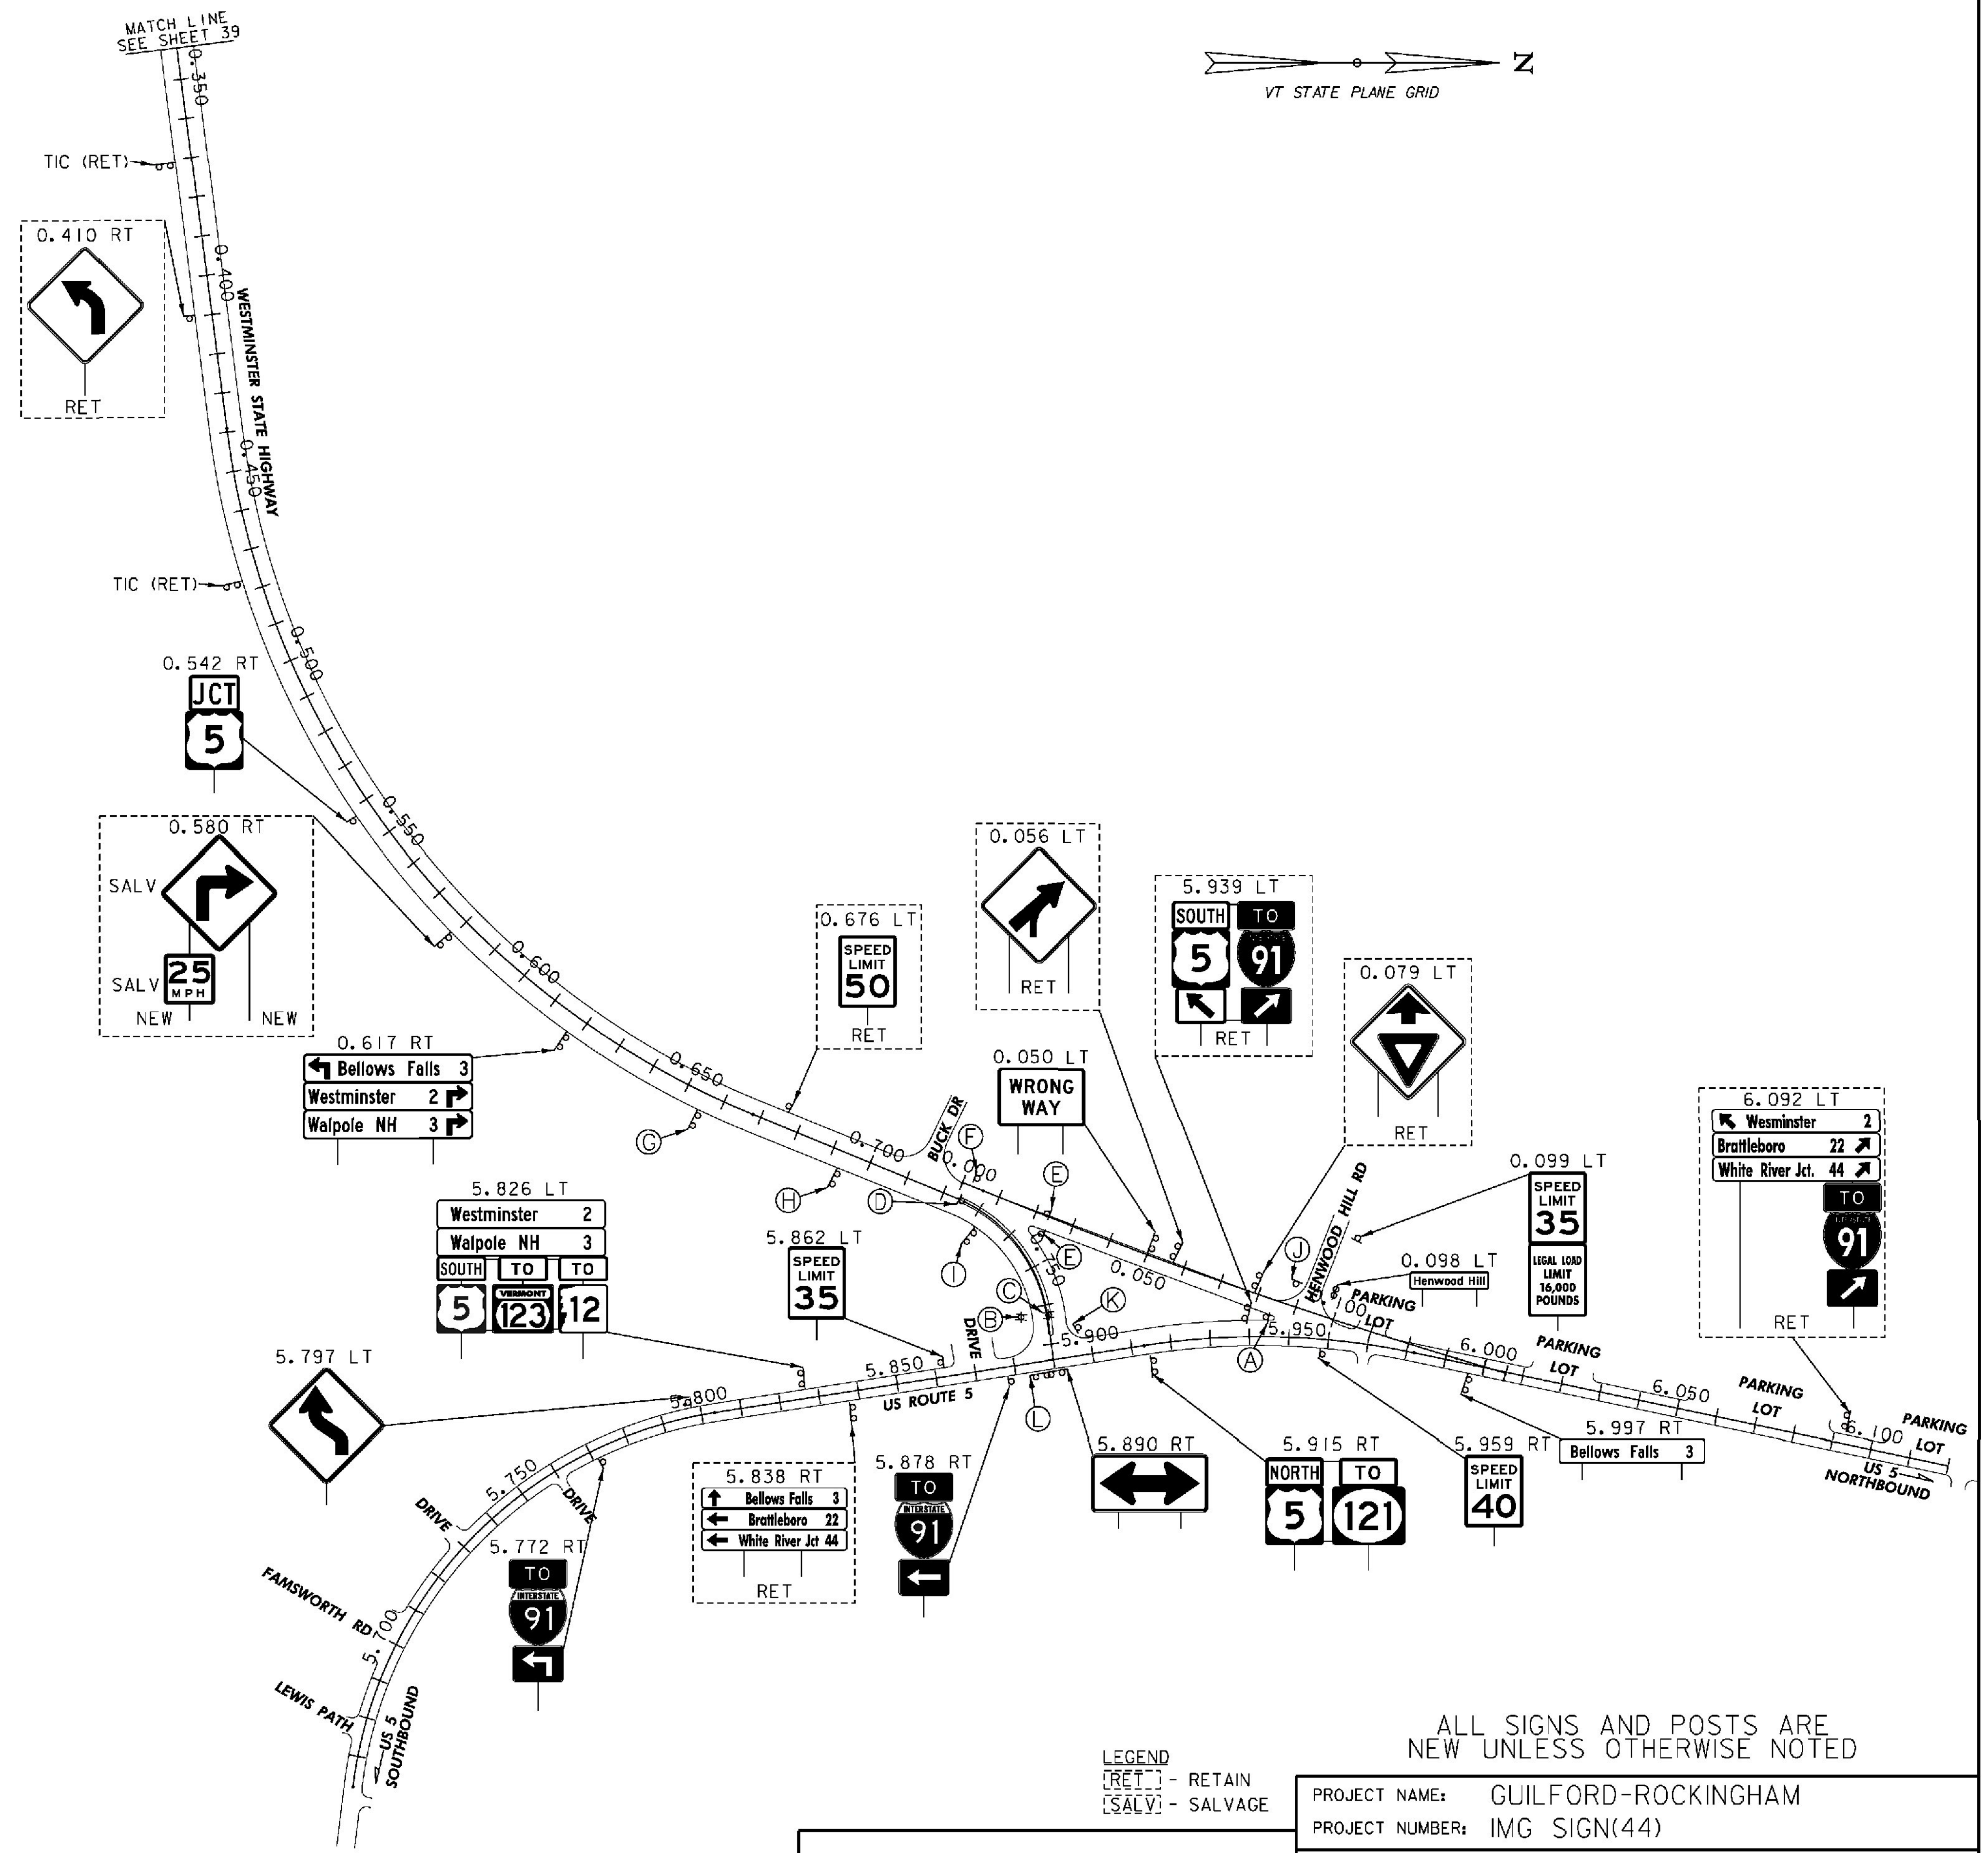

NOT TO SCALE

LEGEND  
 (RET) - RETAIN  
 (SALV) - SALVAGE

ALL SIGNS AND POSTS ARE NEW UNLESS OTHERWISE NOTED

PROJECT NAME:	GUILFORD-ROCKINGHAM
PROJECT NUMBER:	IMG SIGN(44)
FILE NAME:	z12A5281n105.dgn
PROJECT LEADER:	C. GREGORY
DESIGNED BY:	J. SMITH
INTERCHANGE 5 PROPOSED SIGNS (2)	
PLOT DATE:	4/17/2014
DRAWN BY:	S. FORTIER
CHECKED BY:	D. MUNRO
SHEET	41 OF 157

CLD 12-0350 MODEL: Proposed02