


LEGEND
 [RET] - RETAIN
 [R&S] - REMOVE AND SALVAGE

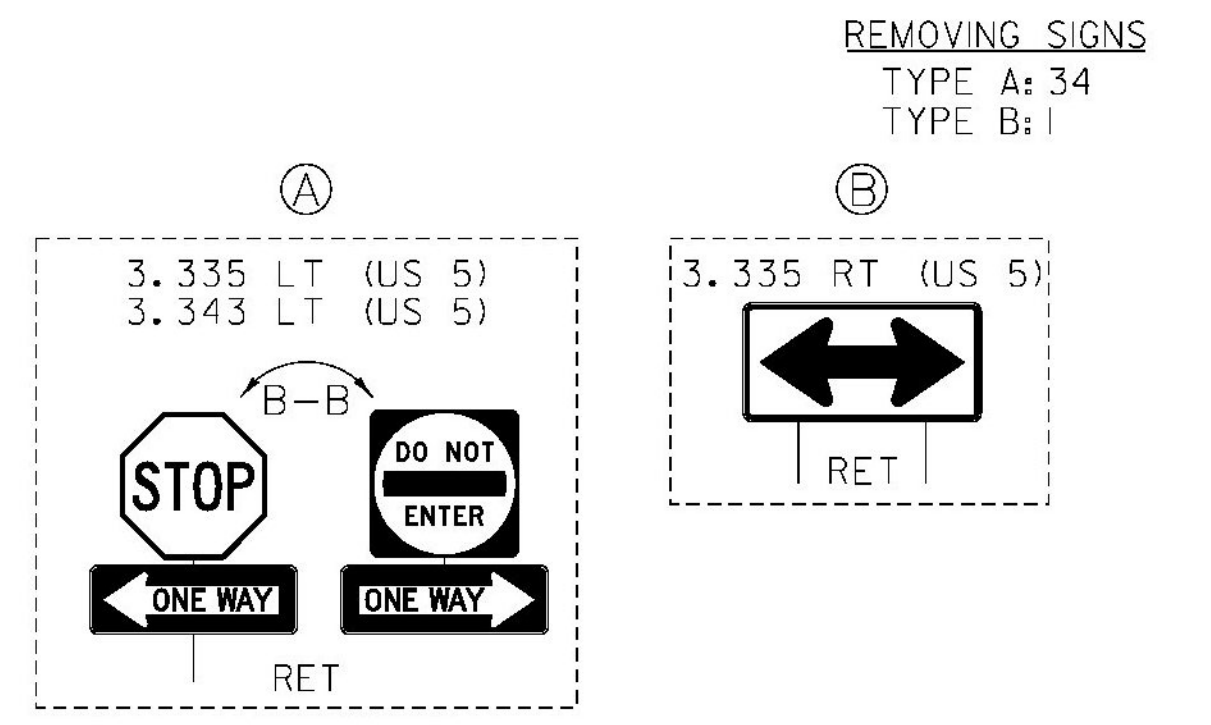

ALL SIGNS AND POSTS WILL BE REMOVED UNLESS OTHERWISE NOTED

PROJECT NAME:	GUILFORD-ROCKINGHAM
PROJECT NUMBER:	IMG SIGN(44)
FILE NAME:	z12A528In+06.dgn
PROJECT LEADER:	C. GREGORY
DESIGNED BY:	J. SMITH
INTERCHANGE 6 EXISTING SIGNS (1)	
PLOT DATE:	4/17/2014
DRAWN BY:	S. FORTIER
CHECKED BY:	D. MUNRO
SHEET	42 OF 157

NOT TO SCALE

CLD 12-0350 MODEL: Exist+ng01