



MM 19.114 SB

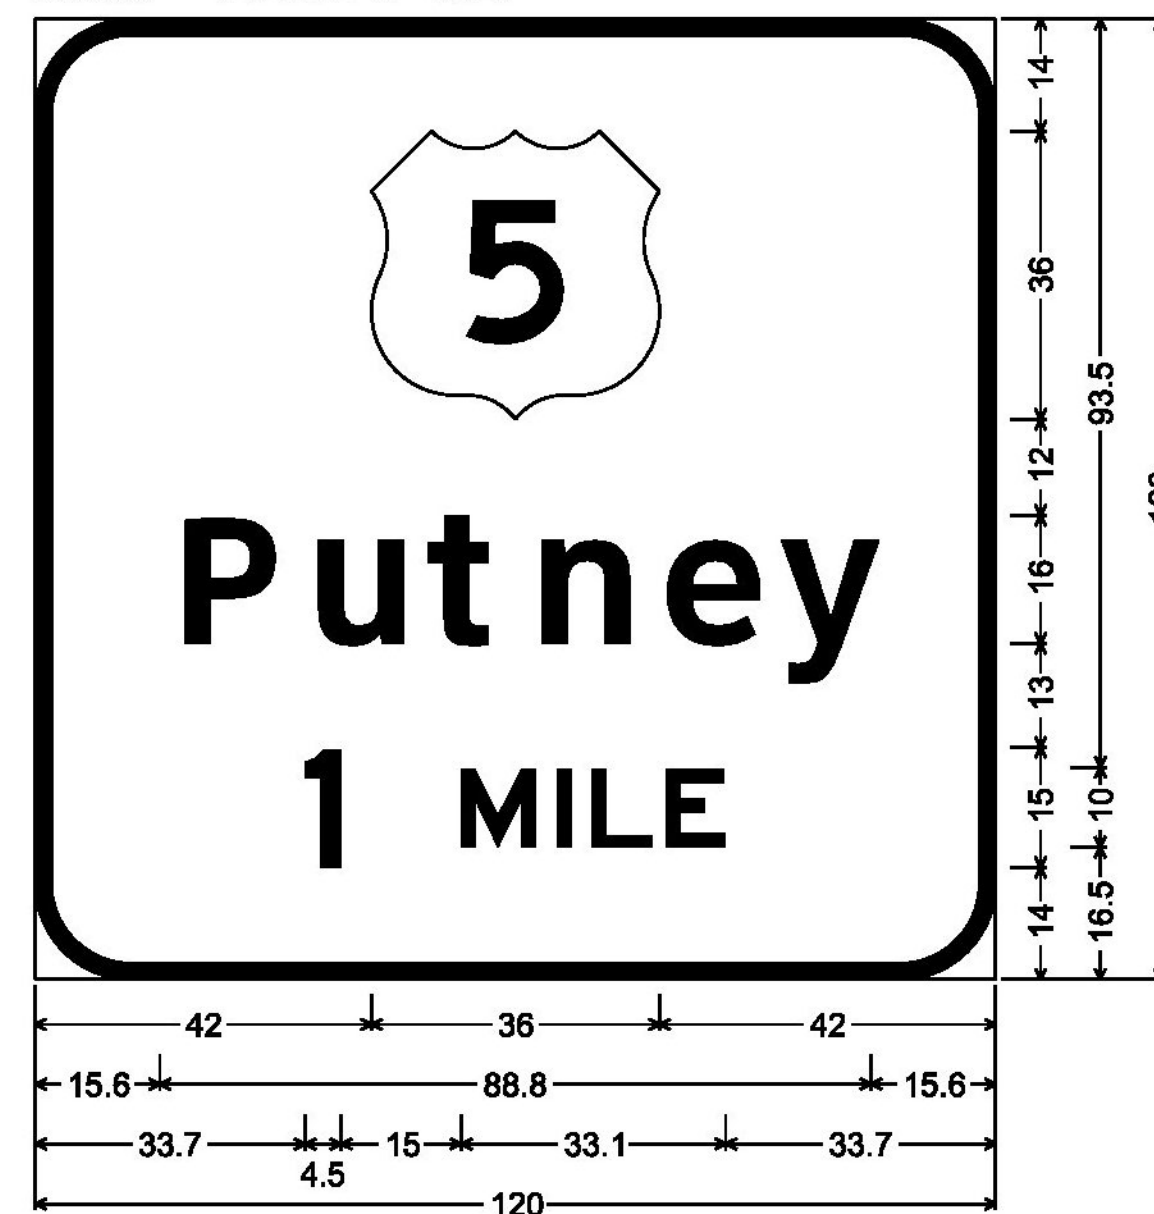

12.0" Radius, 2.0" Border, White on Green;  
[Putney] ClearviewHwy-5-W; [1 MILE] E 2K;


MM 17.275 NB  
MM 18.750 SB

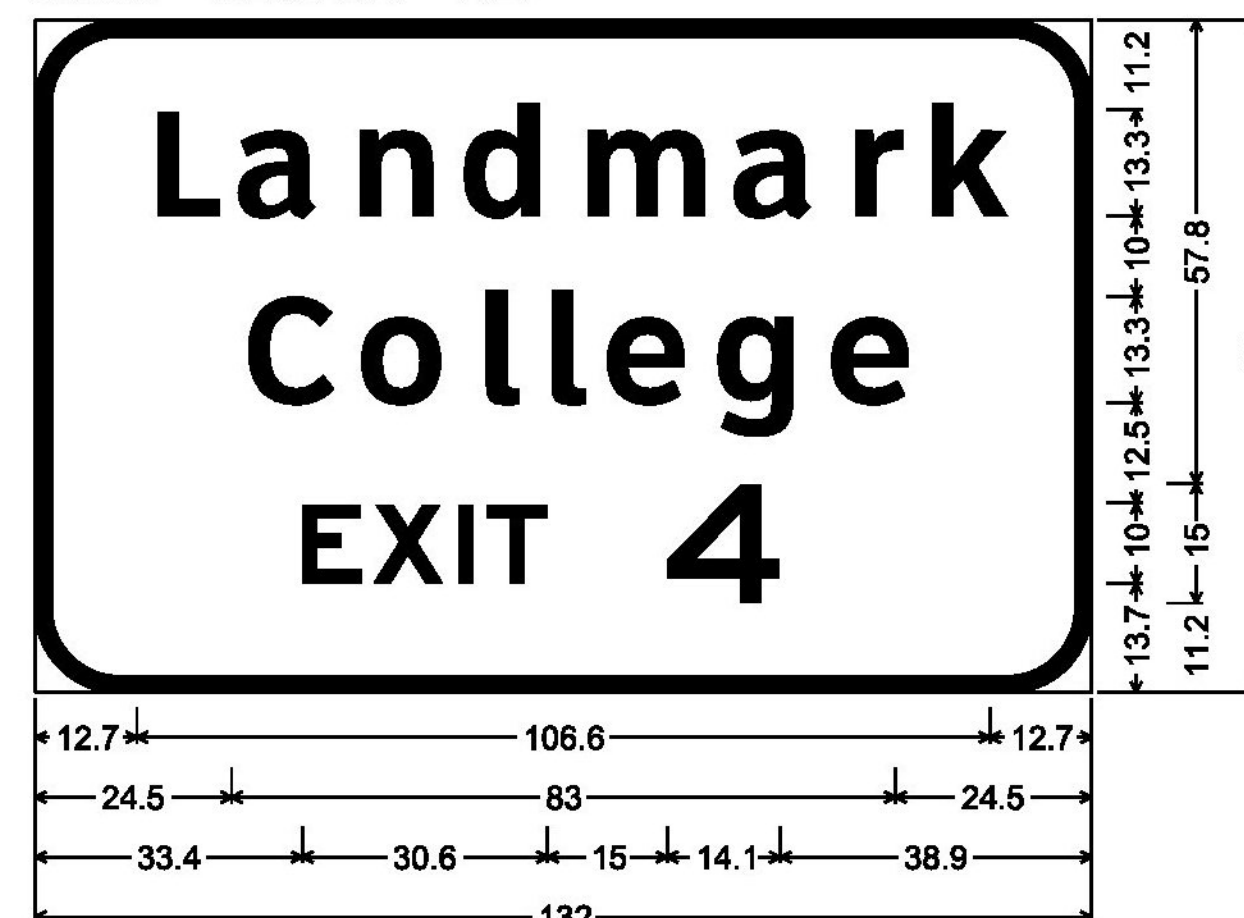

10.5" Radius, 2.0" Border, White on Green;  
[Landmark] ClearviewHwy-5-W; [College] ClearviewHwy-5-W;  
[EXIT] E 2K; [4] E 2K;


LAYOUT OF SIGN LEGEND TO  
ACCOMMODATE FUTURE EXIT NUMBER 18

MM 18.570 SB

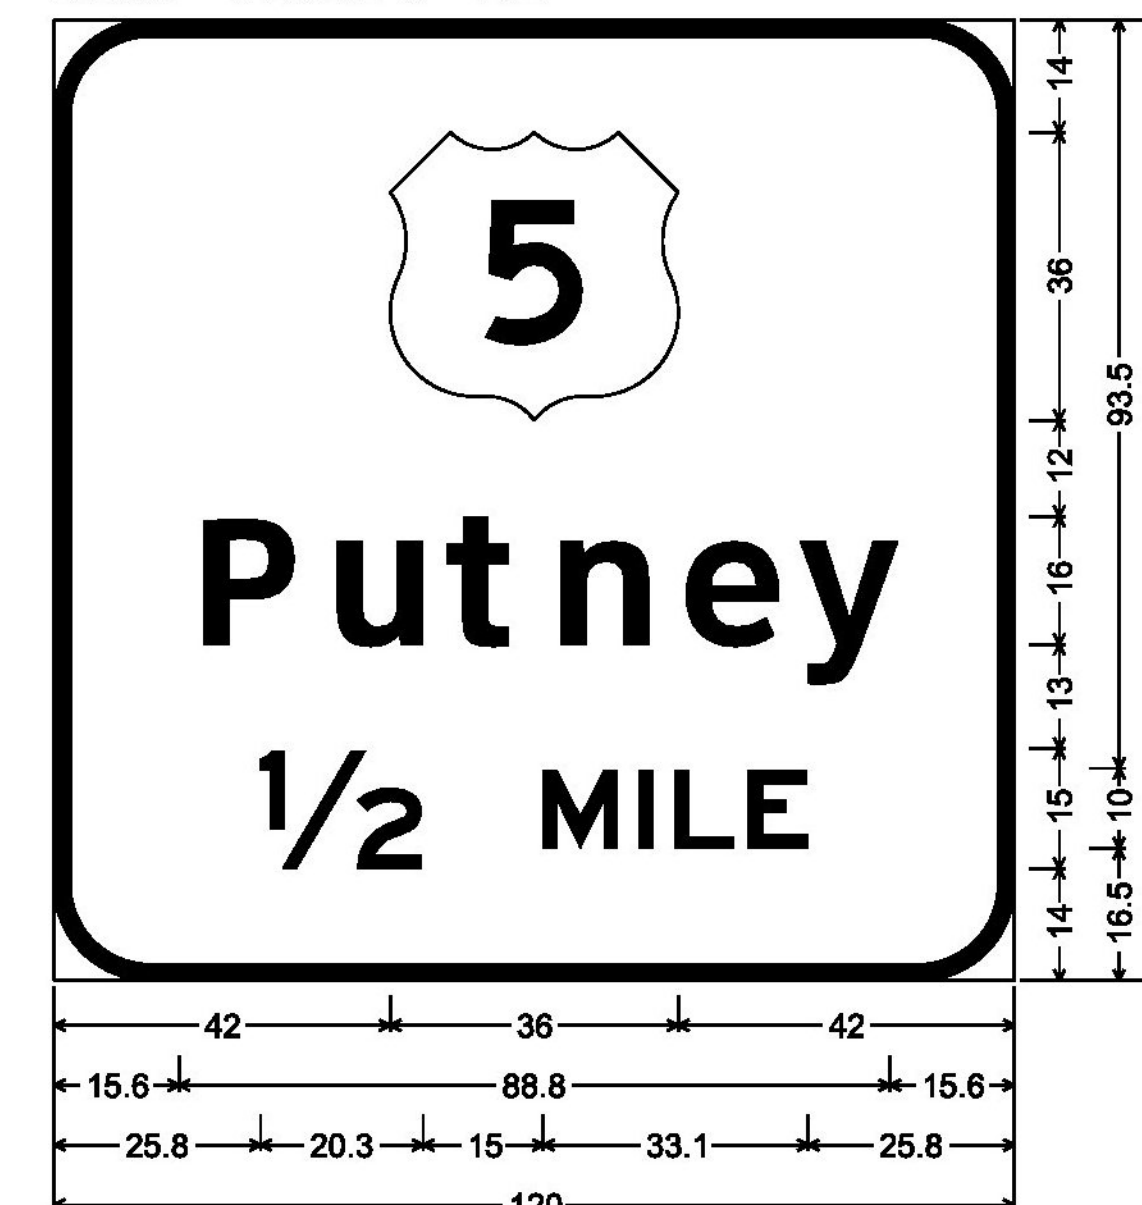


12.0" Radius, 2.0" Border, White on Green;  
[Putney] ClearviewHwy-5-W; [1/2] E 2K; [MILE] E 2K;

MM 17.684 NB  
MM 18.323 SB

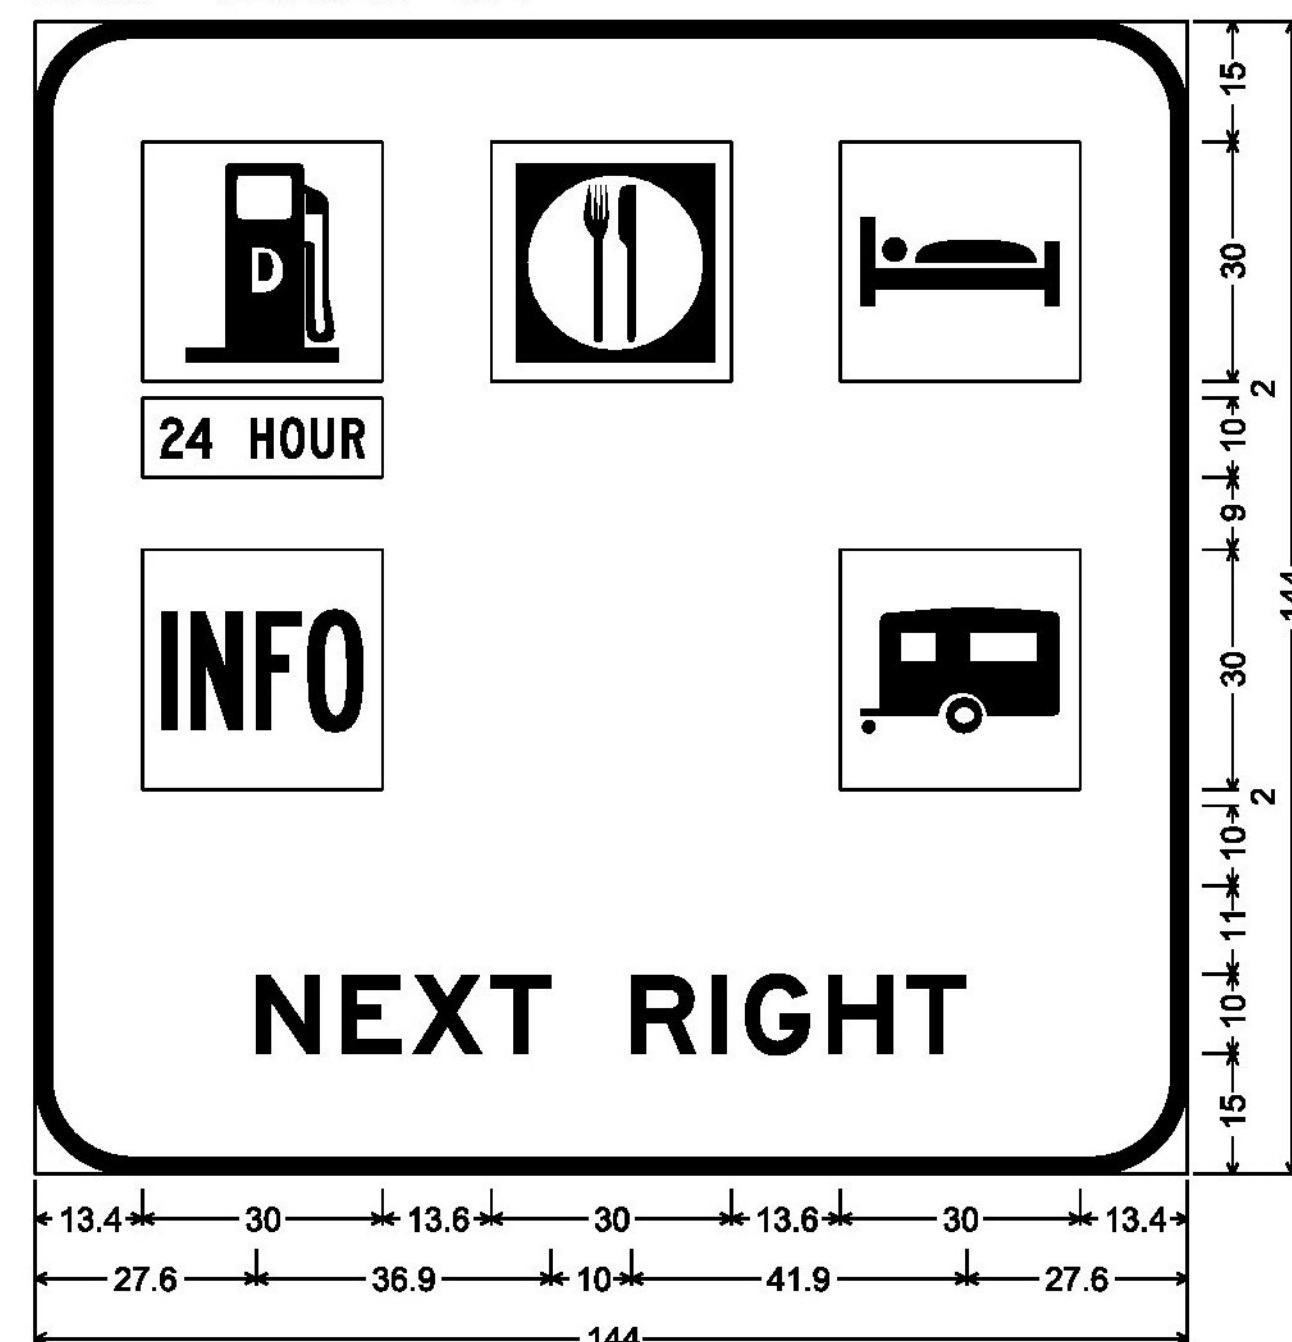


12.0" Radius, 2.0" Border, White on Blue;  
[NEXT RIGHT] E 2K;

MM 18.161 SB

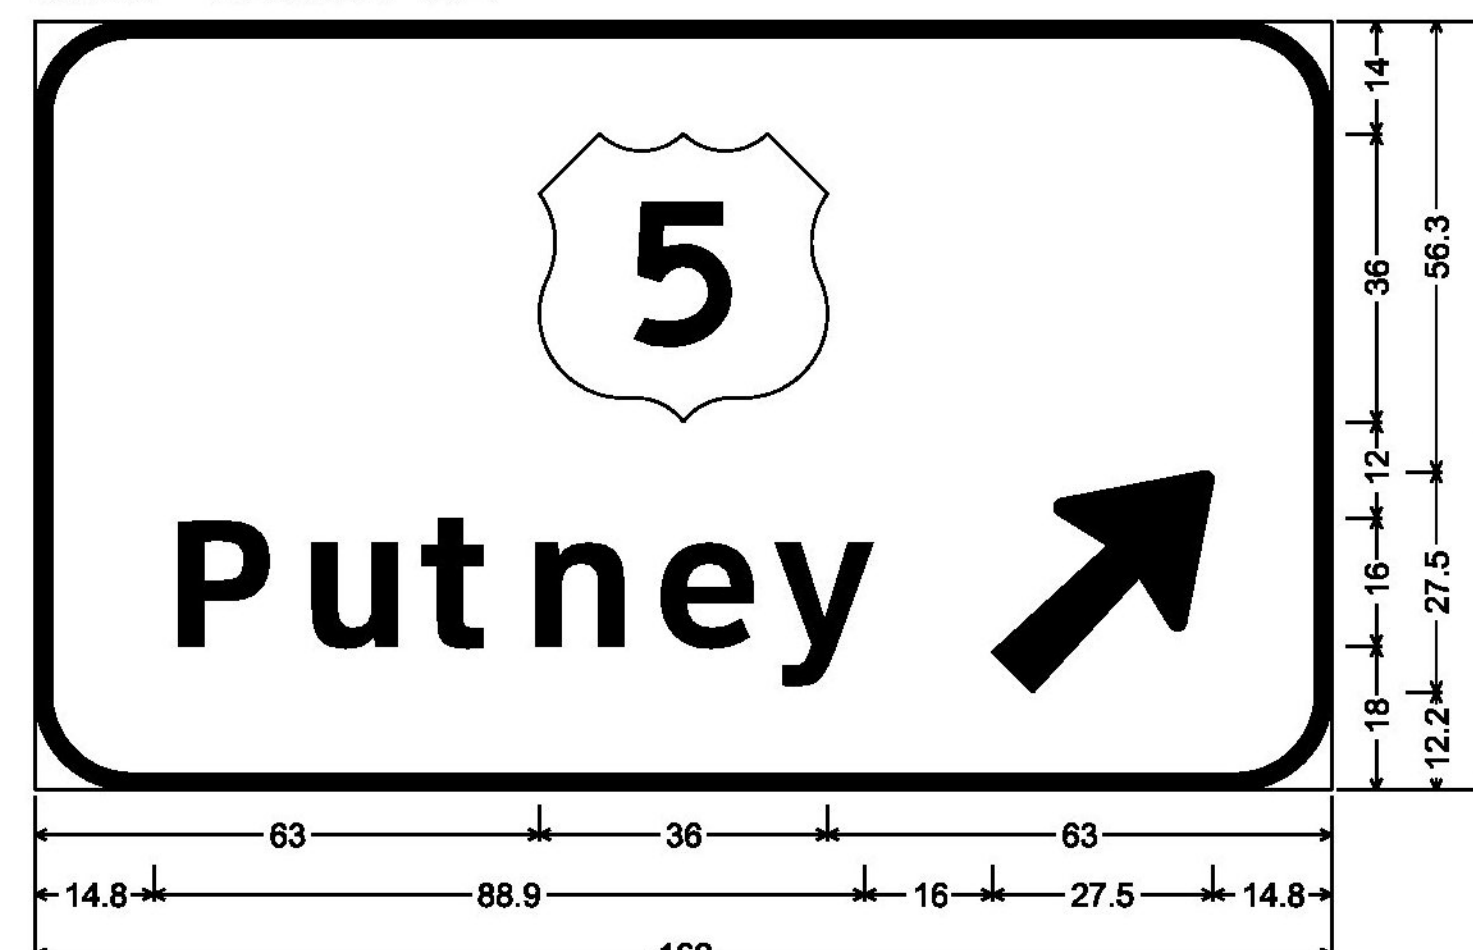


12.0" Radius, 2.0" Border, White on Green;  
[Putney] ClearviewHwy-5-W; Arrow 180 - 35.0° 45°;

MM 17.230 SB

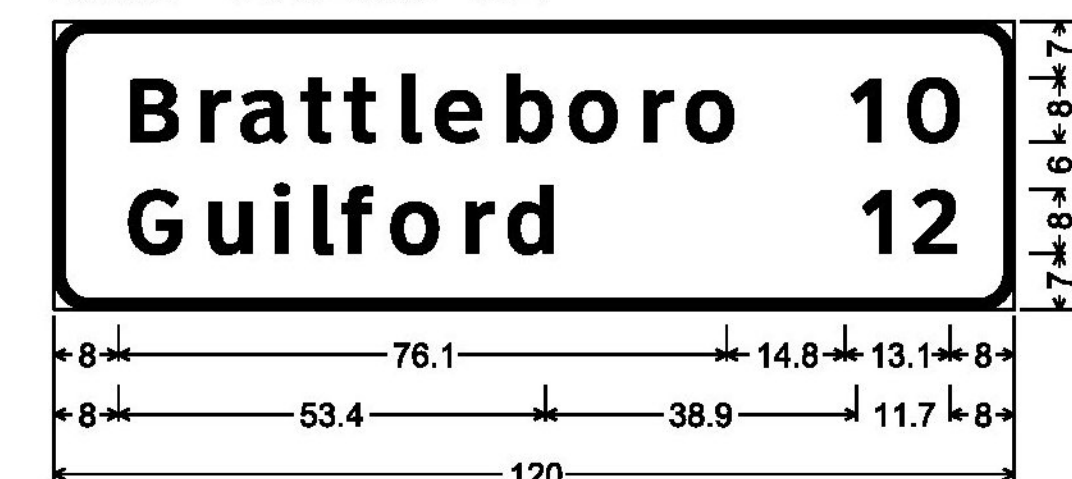

4.5" Radius, 1.3" Border, White on Green;  
[Brattleboro] ClearviewHwy-5-W; [10] ClearviewHwy-5-W;  
[Guilford] ClearviewHwy-5-W; [12] ClearviewHwy-5-W;

MM 18.920 NB

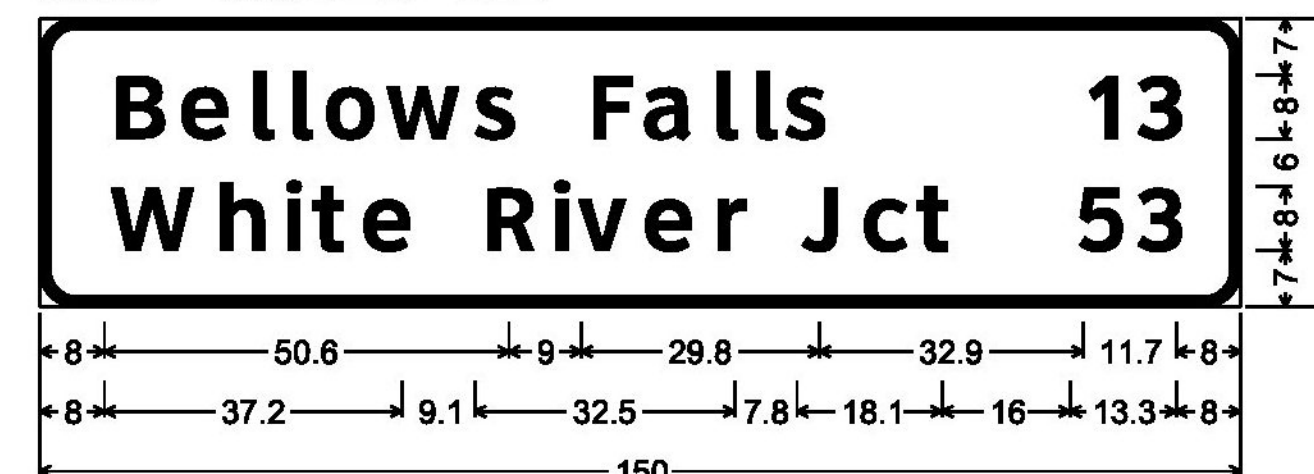

4.5" Radius, 1.3" Border, White on Green;  
[Bellows Falls] ClearviewHwy-5-W; [13] ClearviewHwy-5-W;  
[White River Jct] ClearviewHwy-5-W; [53] ClearviewHwy-5-W;

