

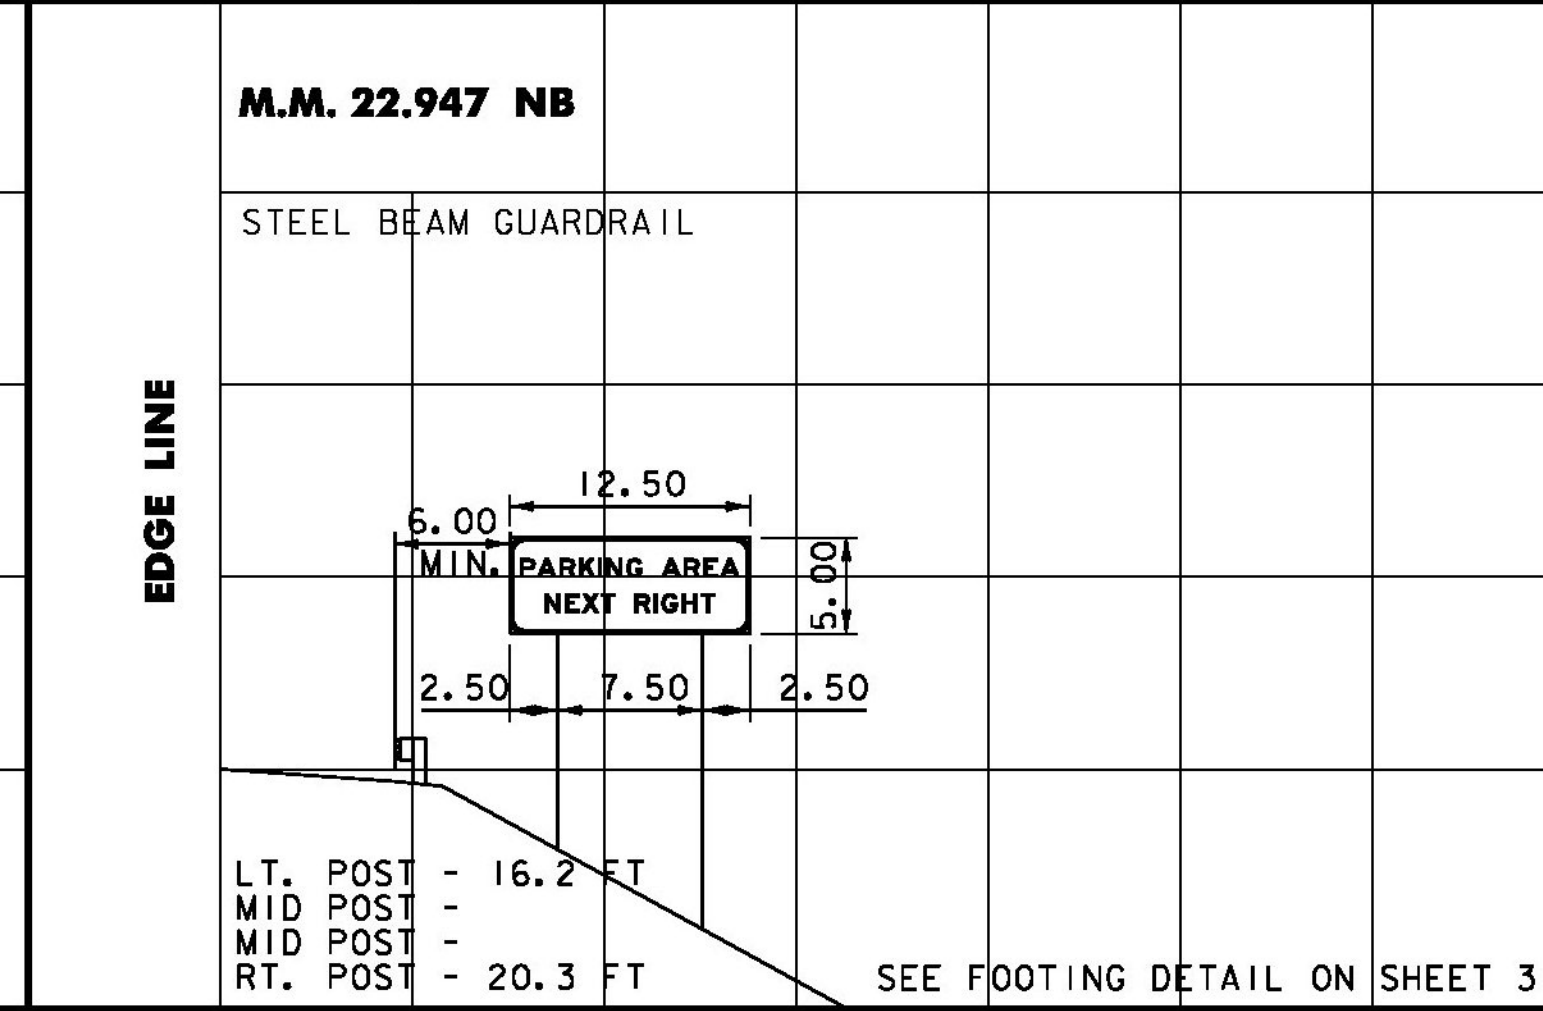
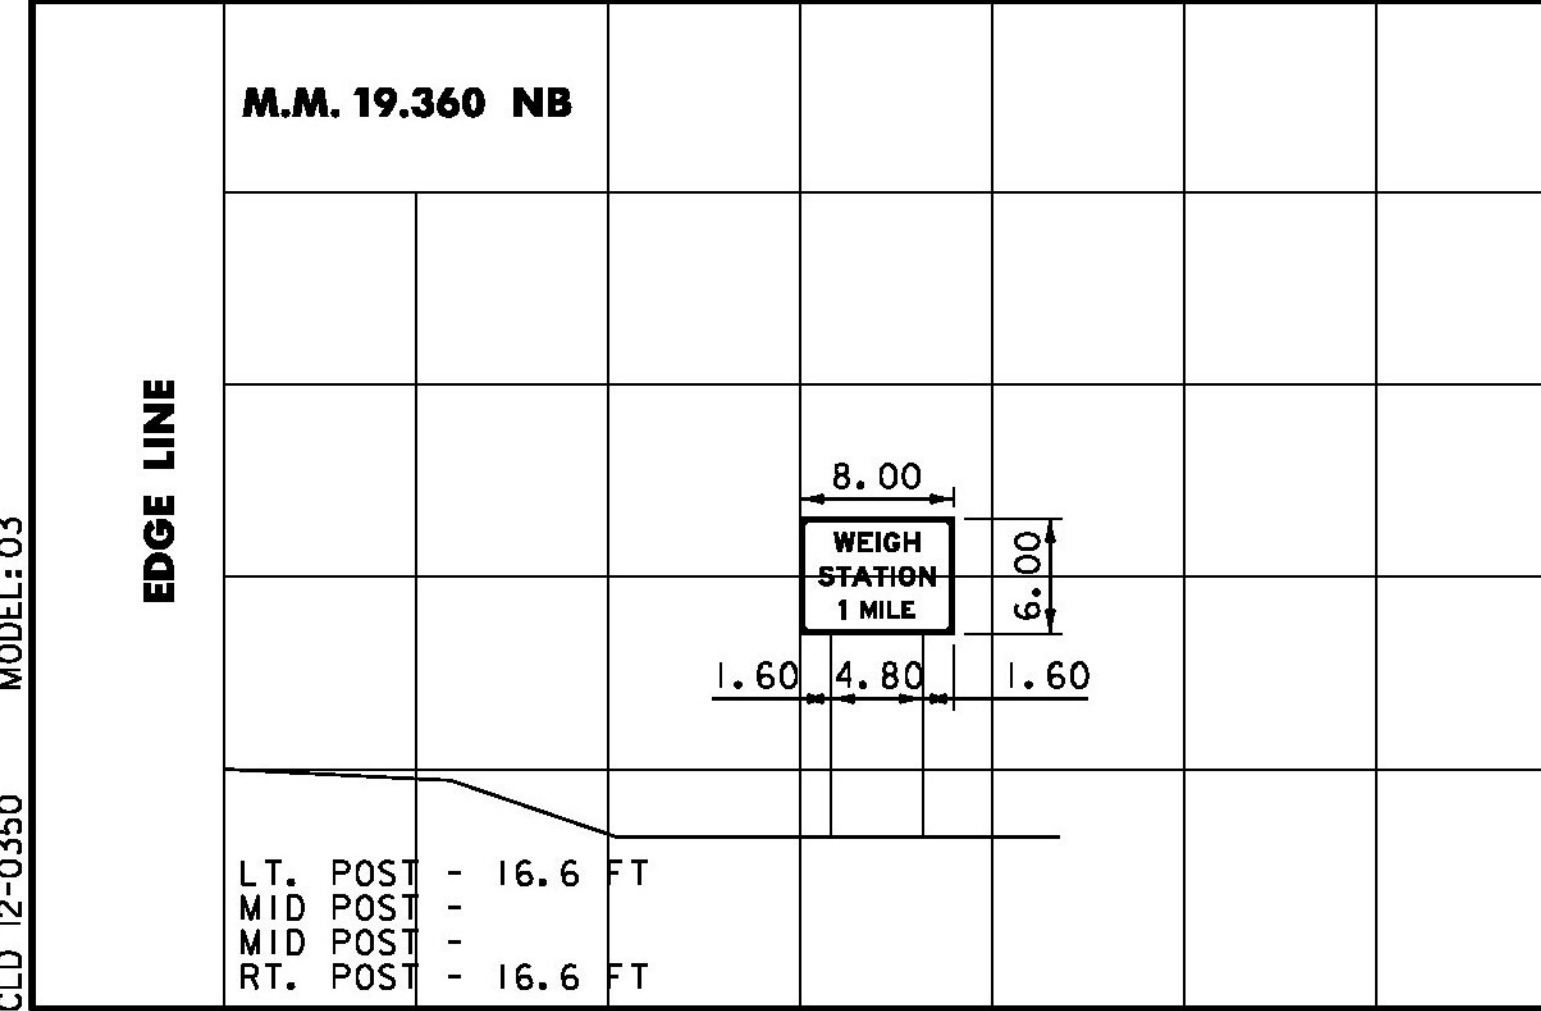
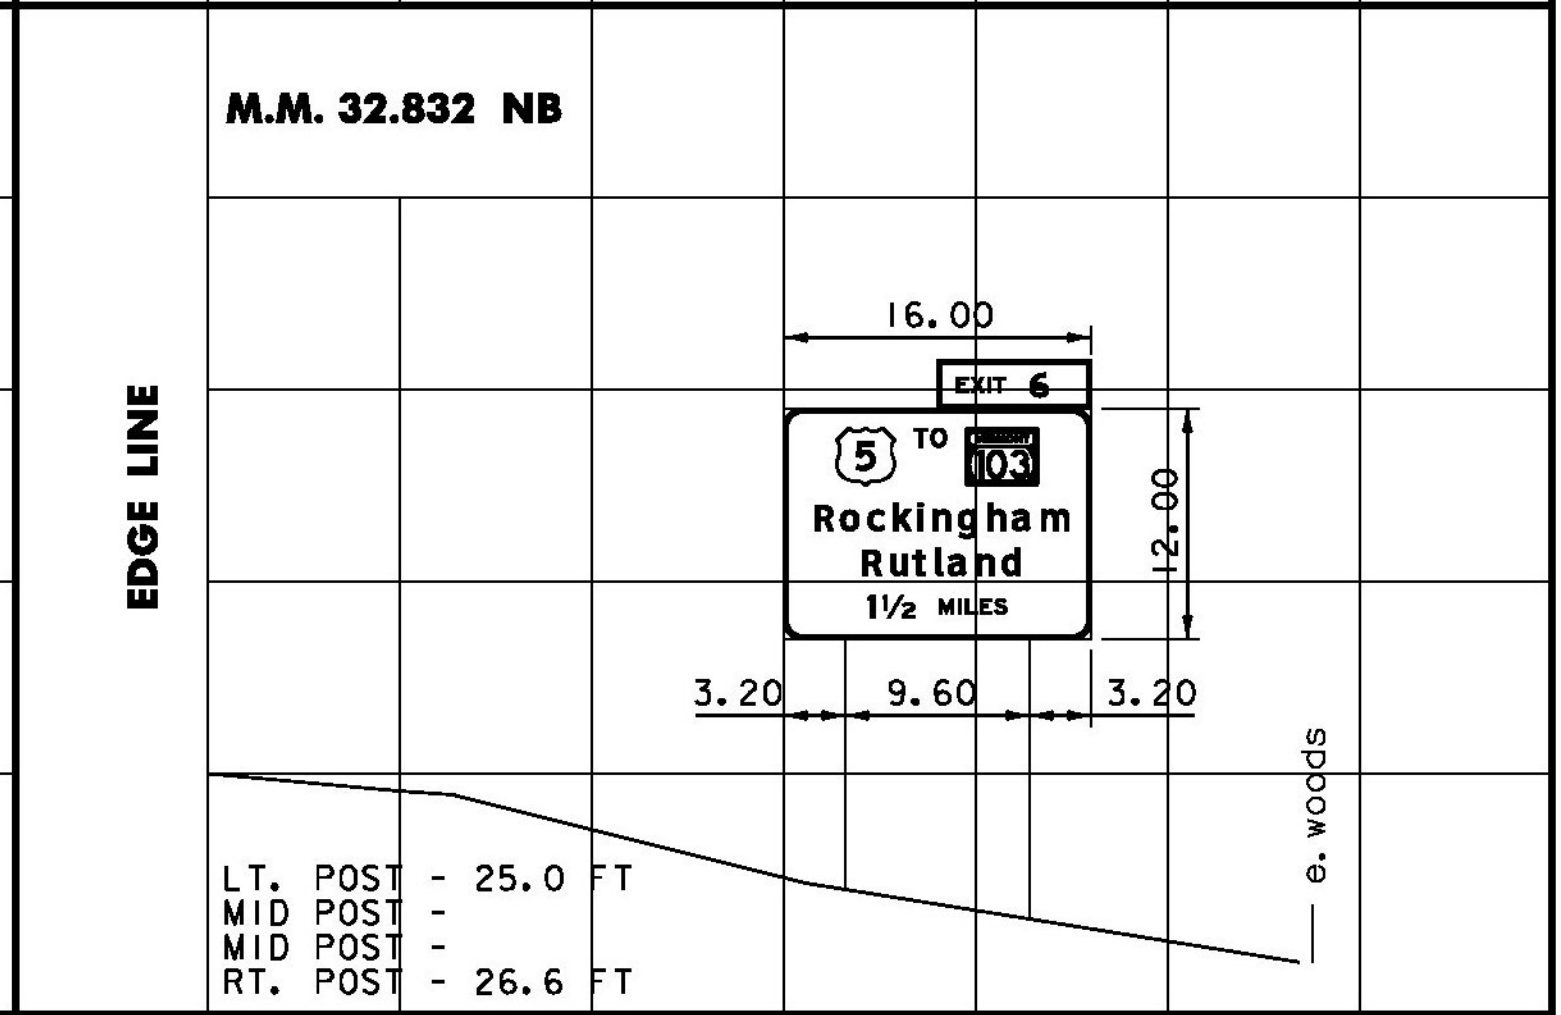
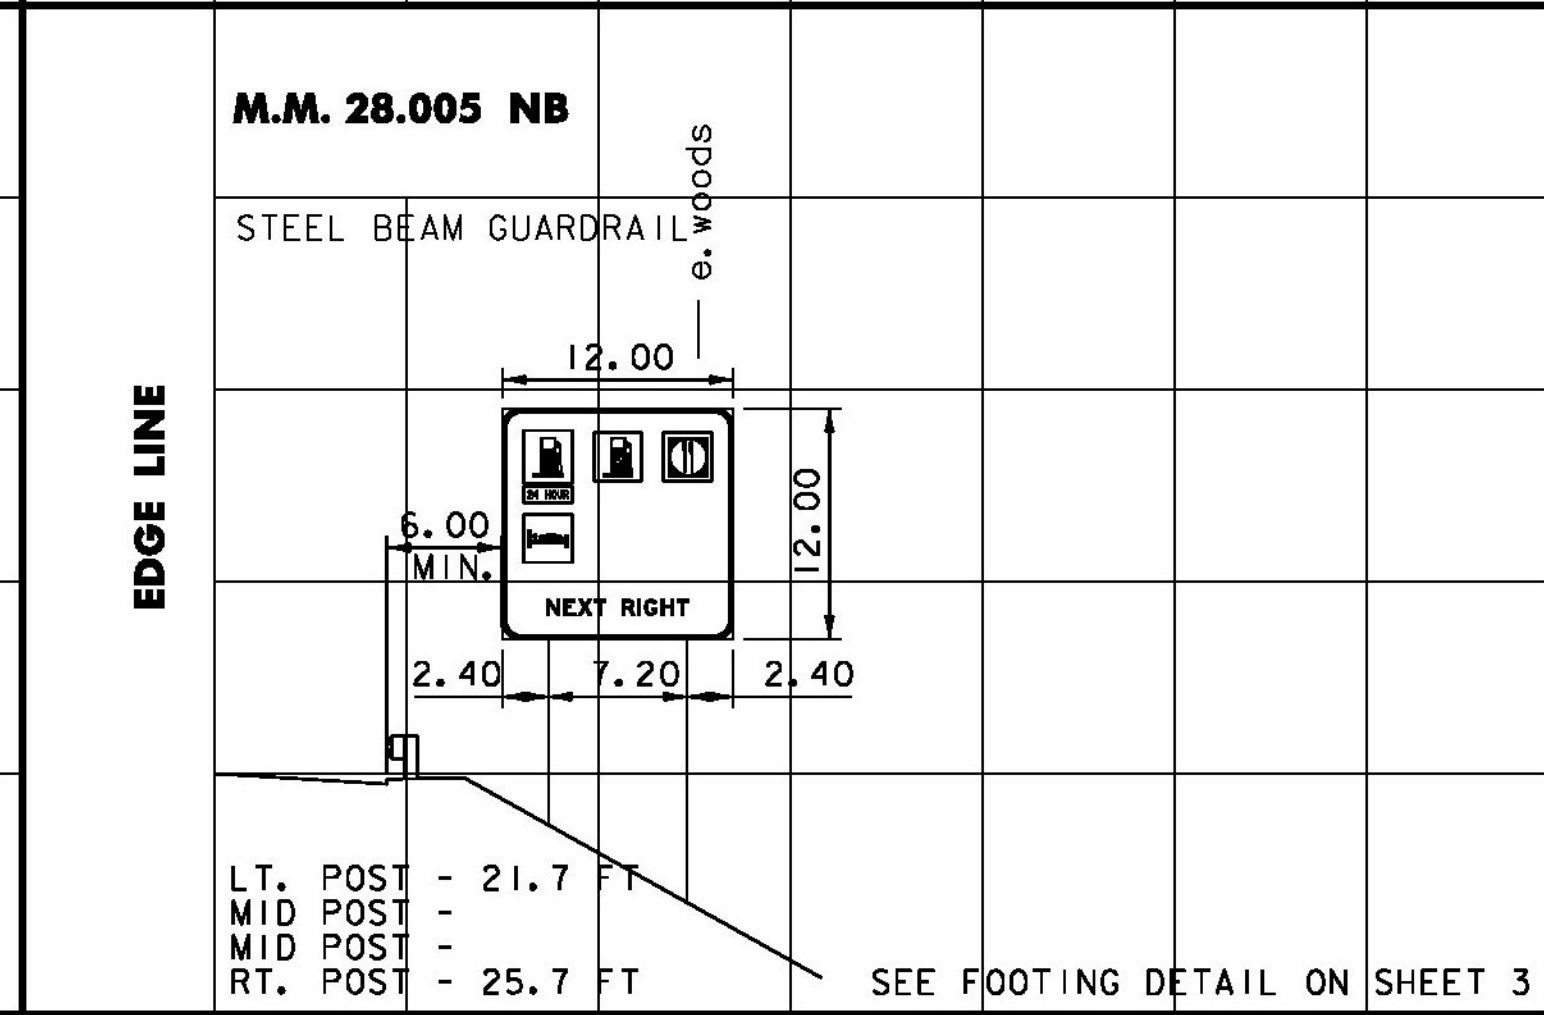
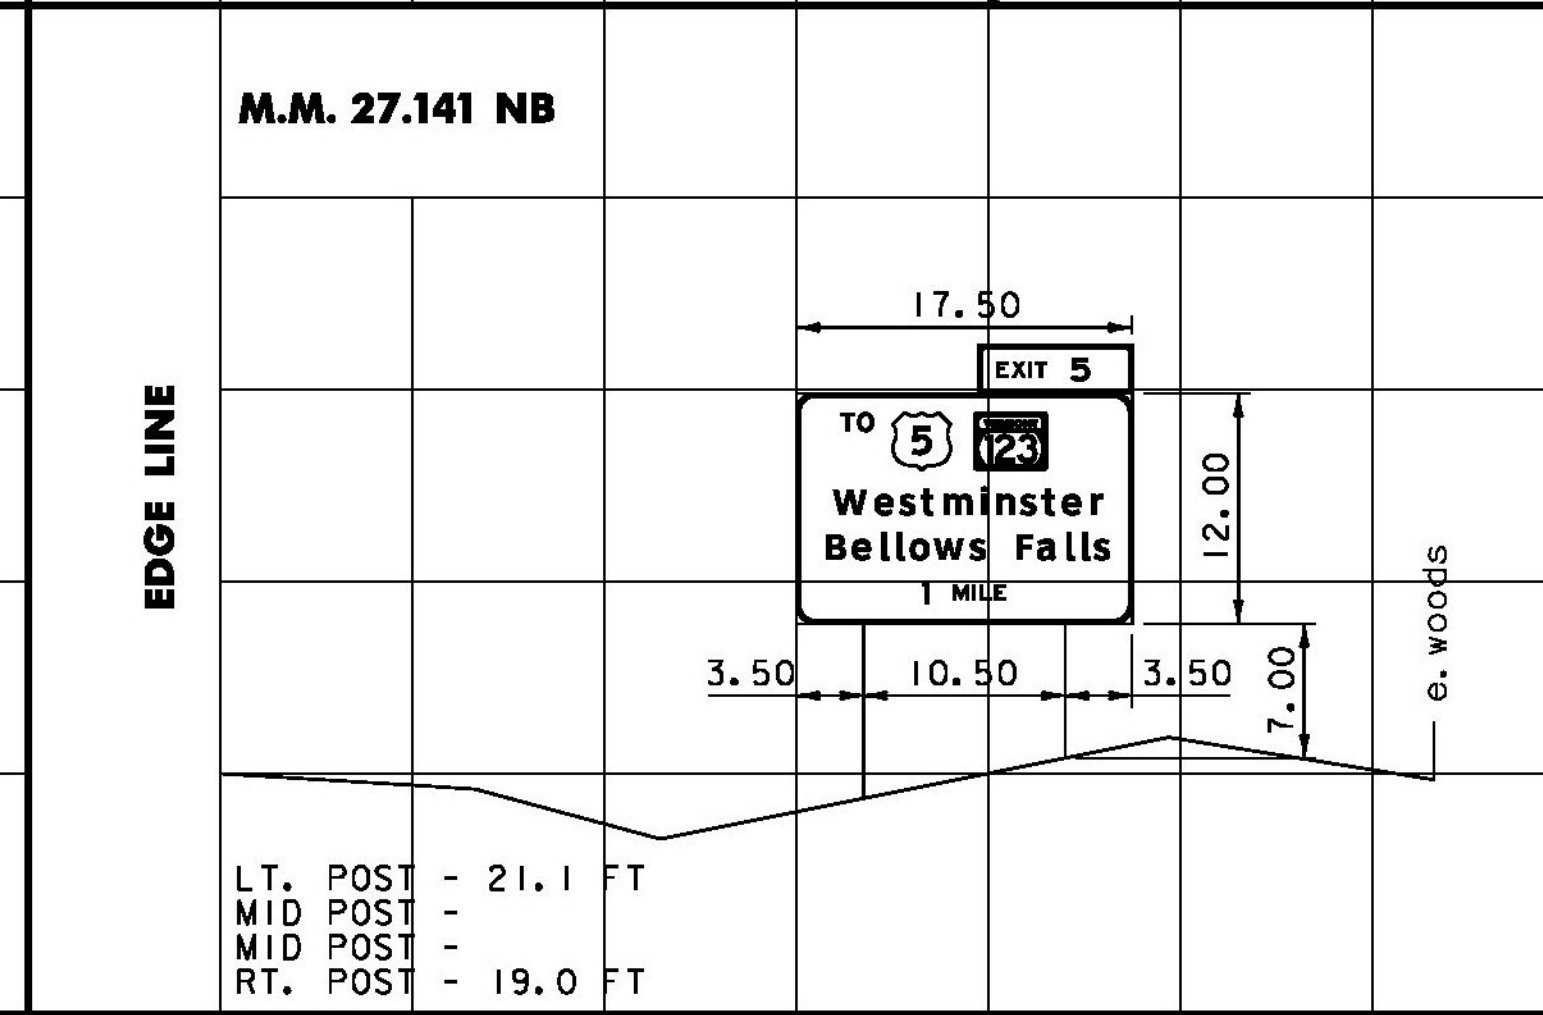
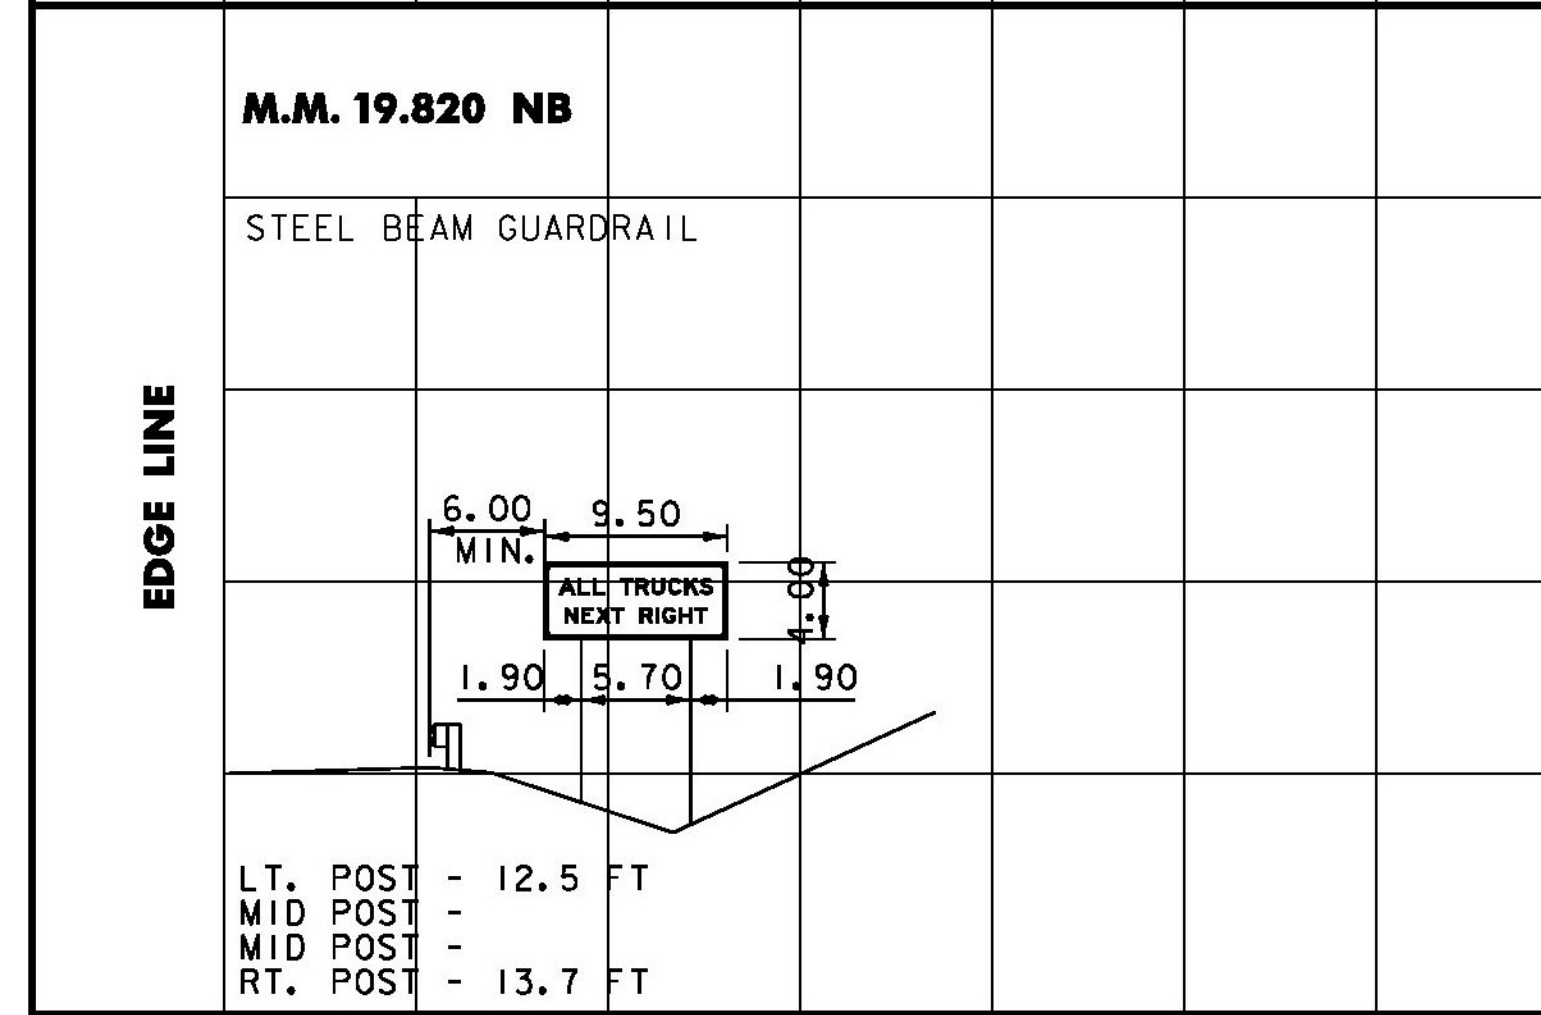
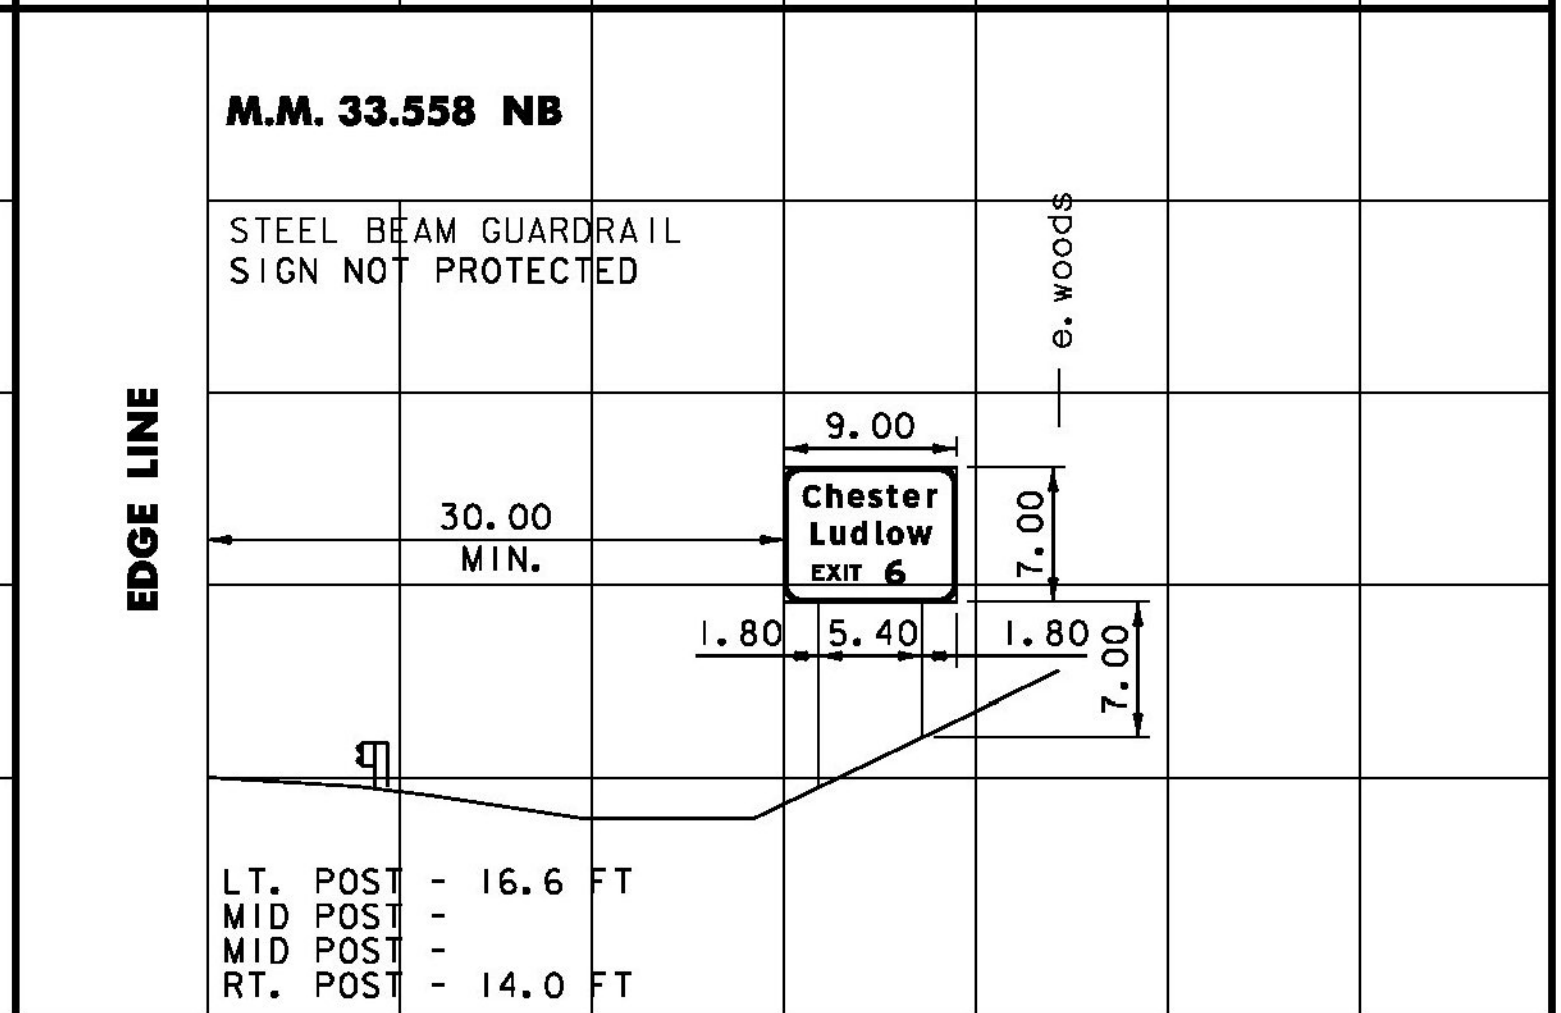
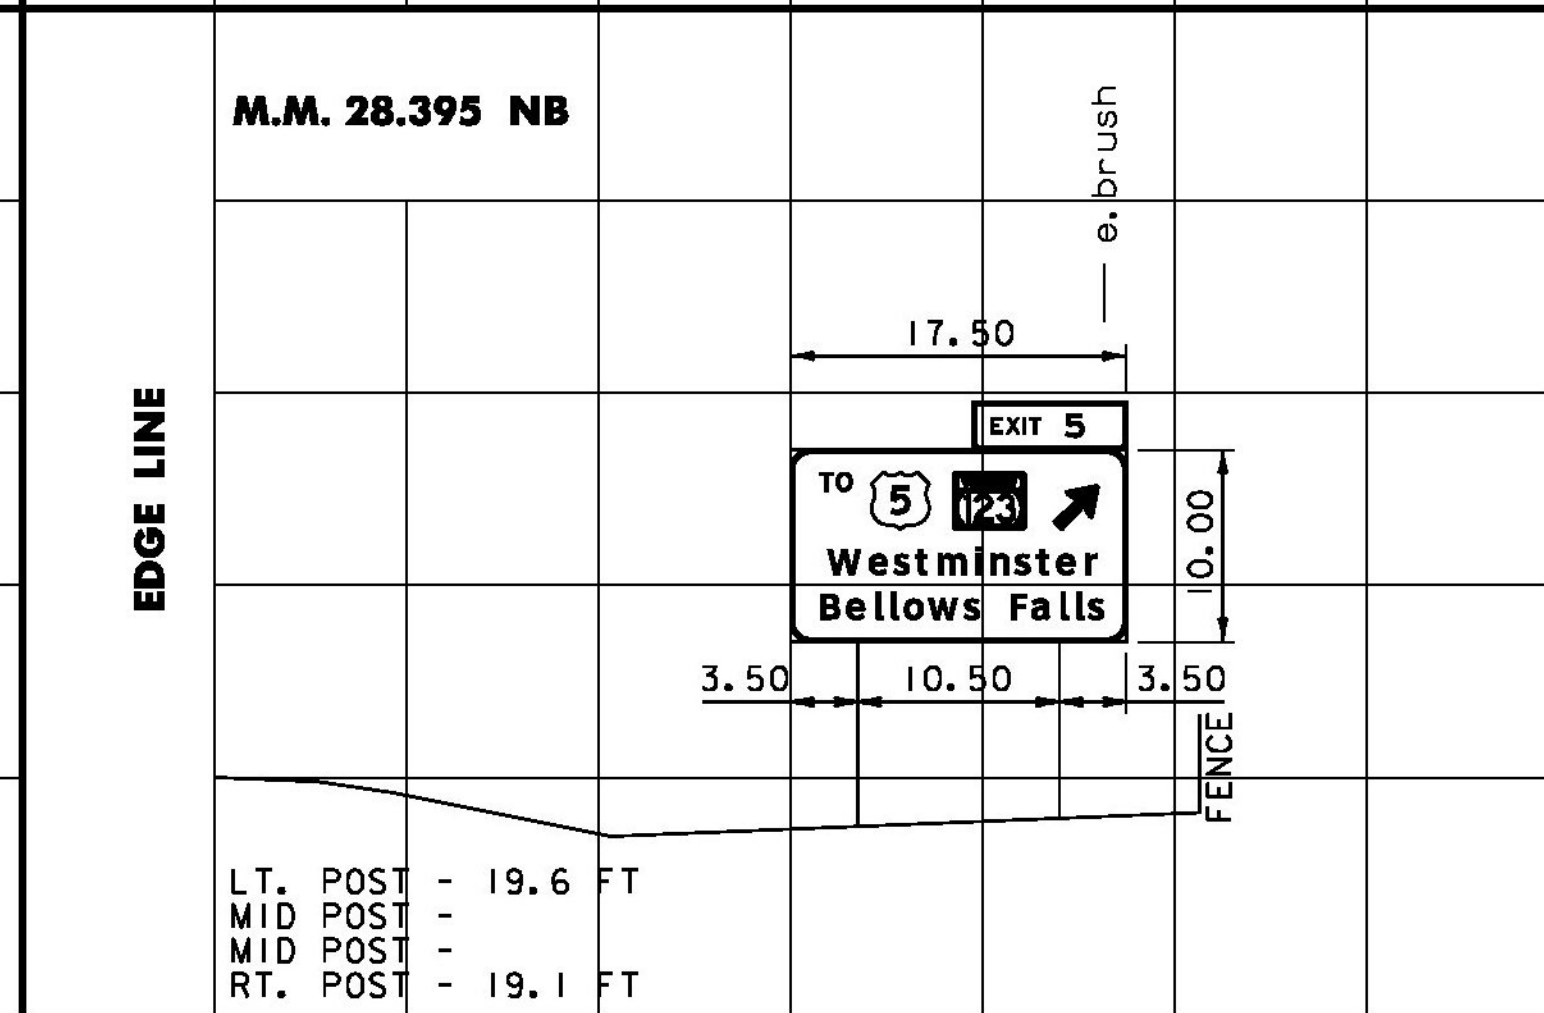
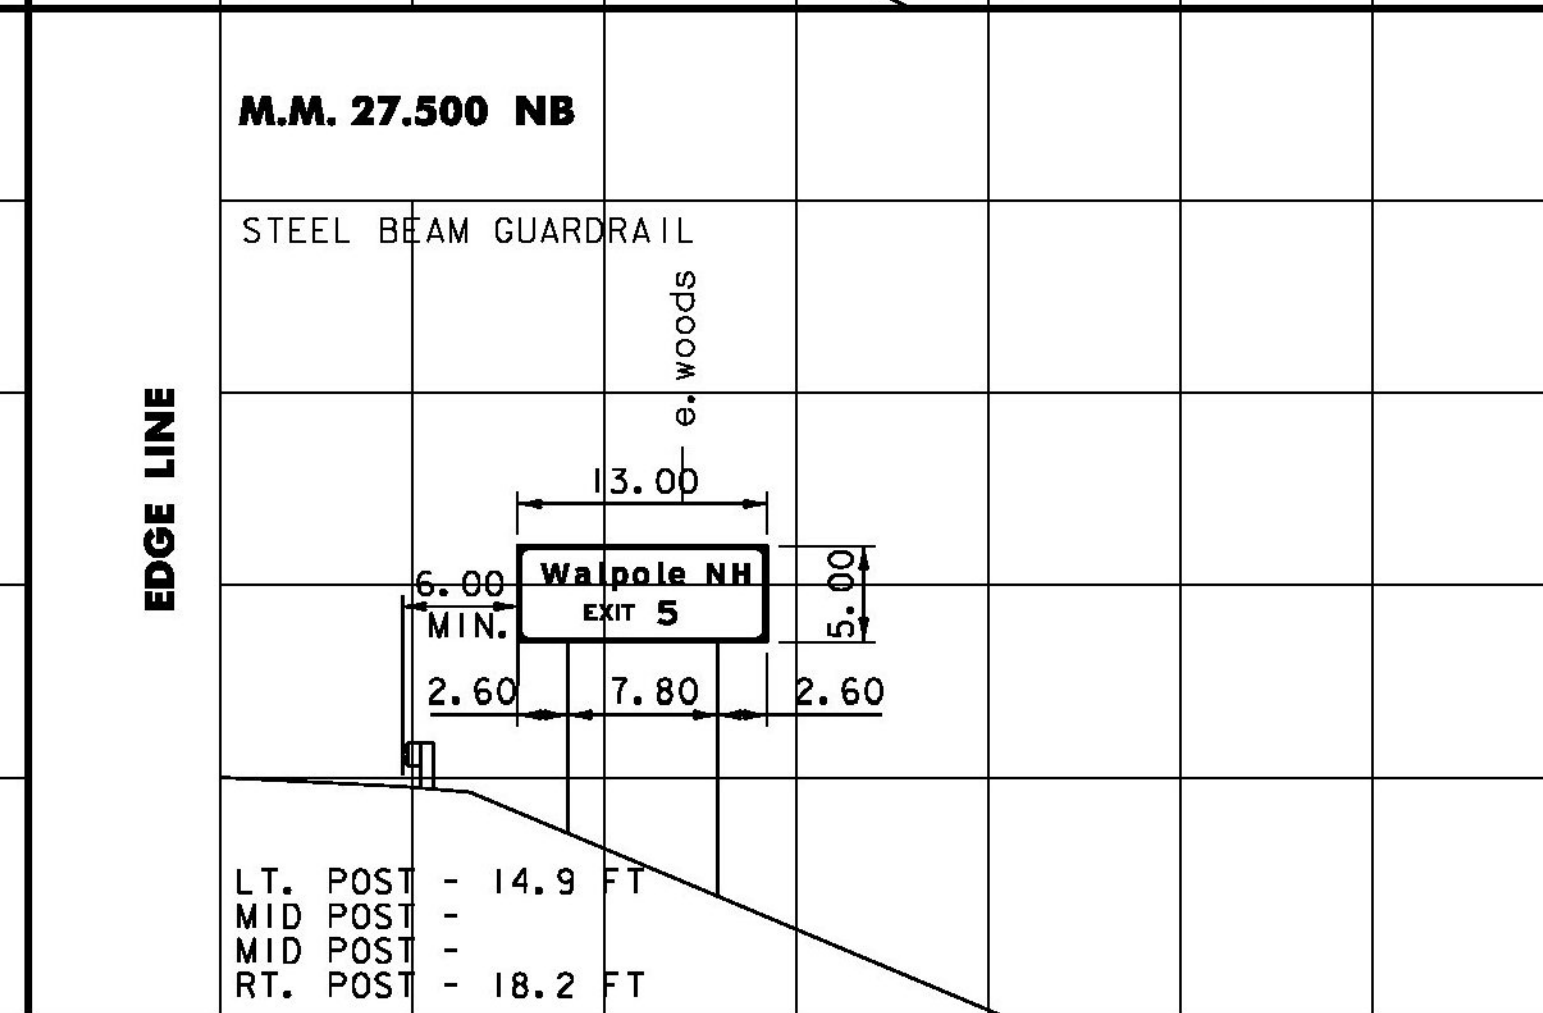
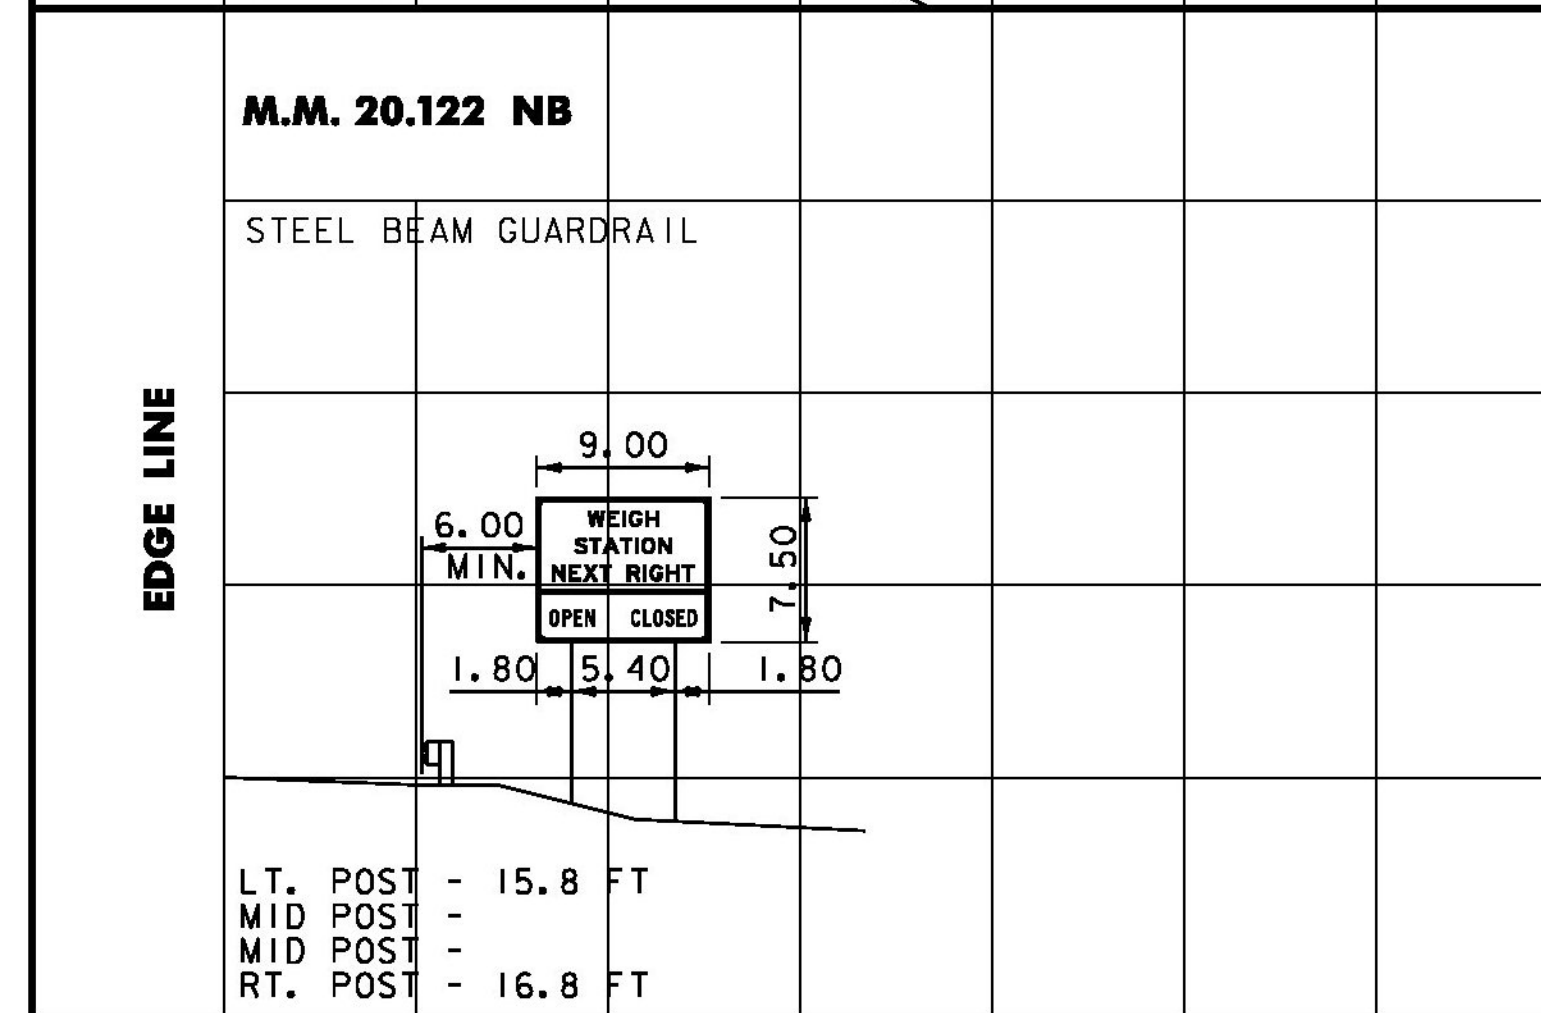
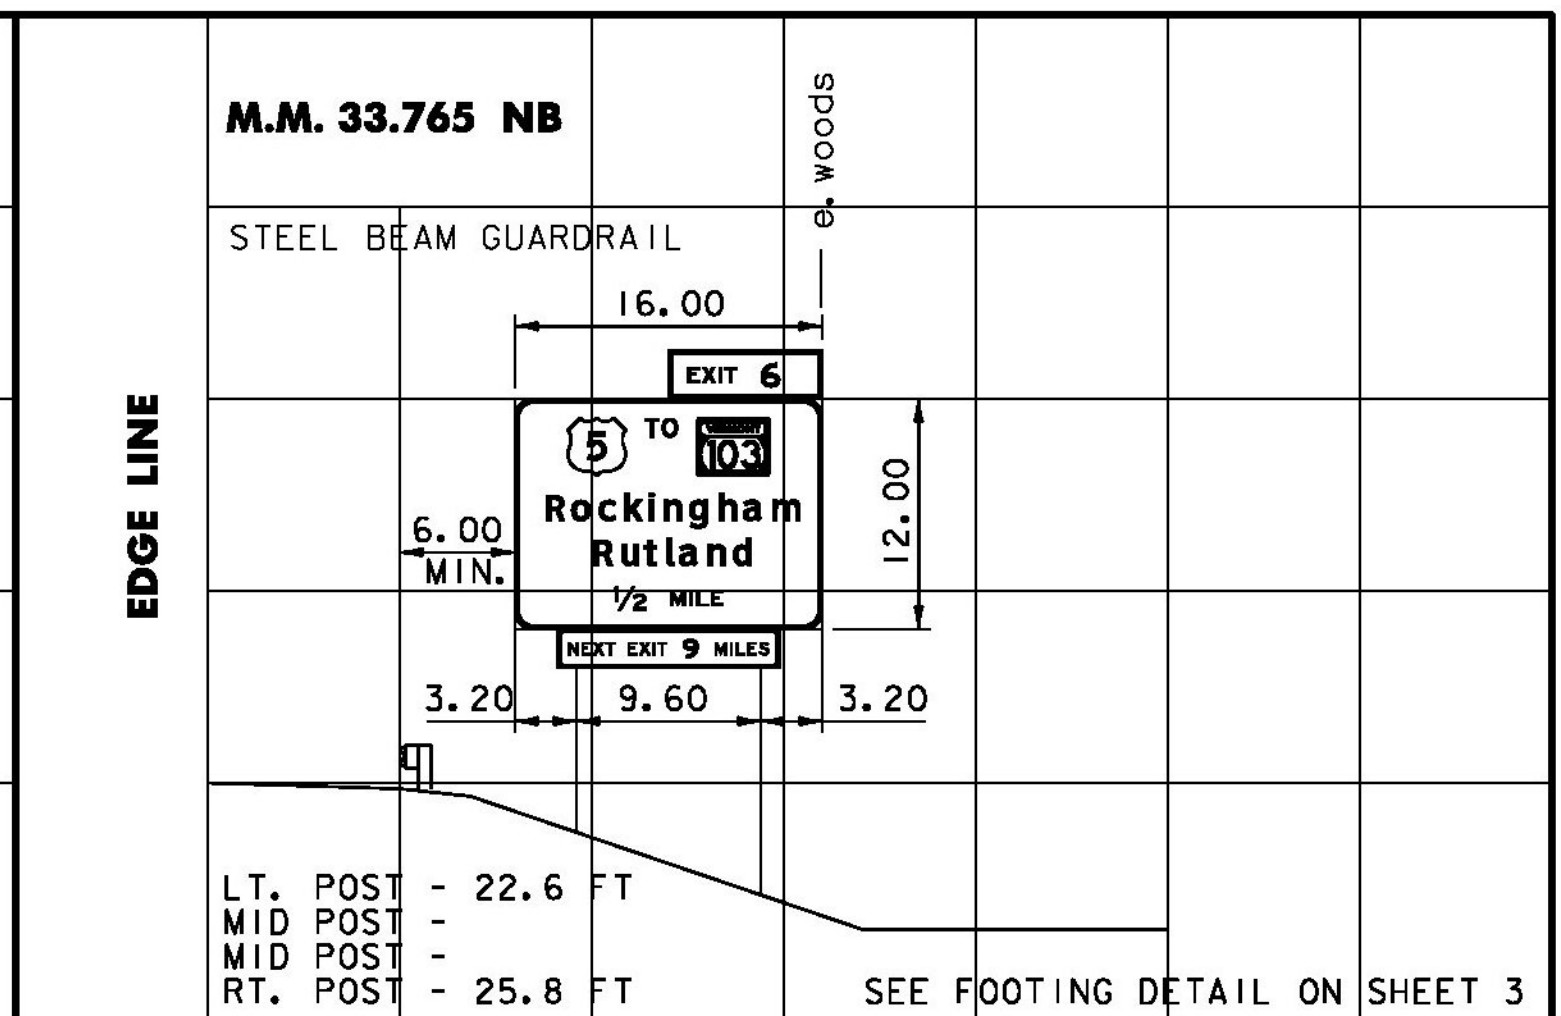
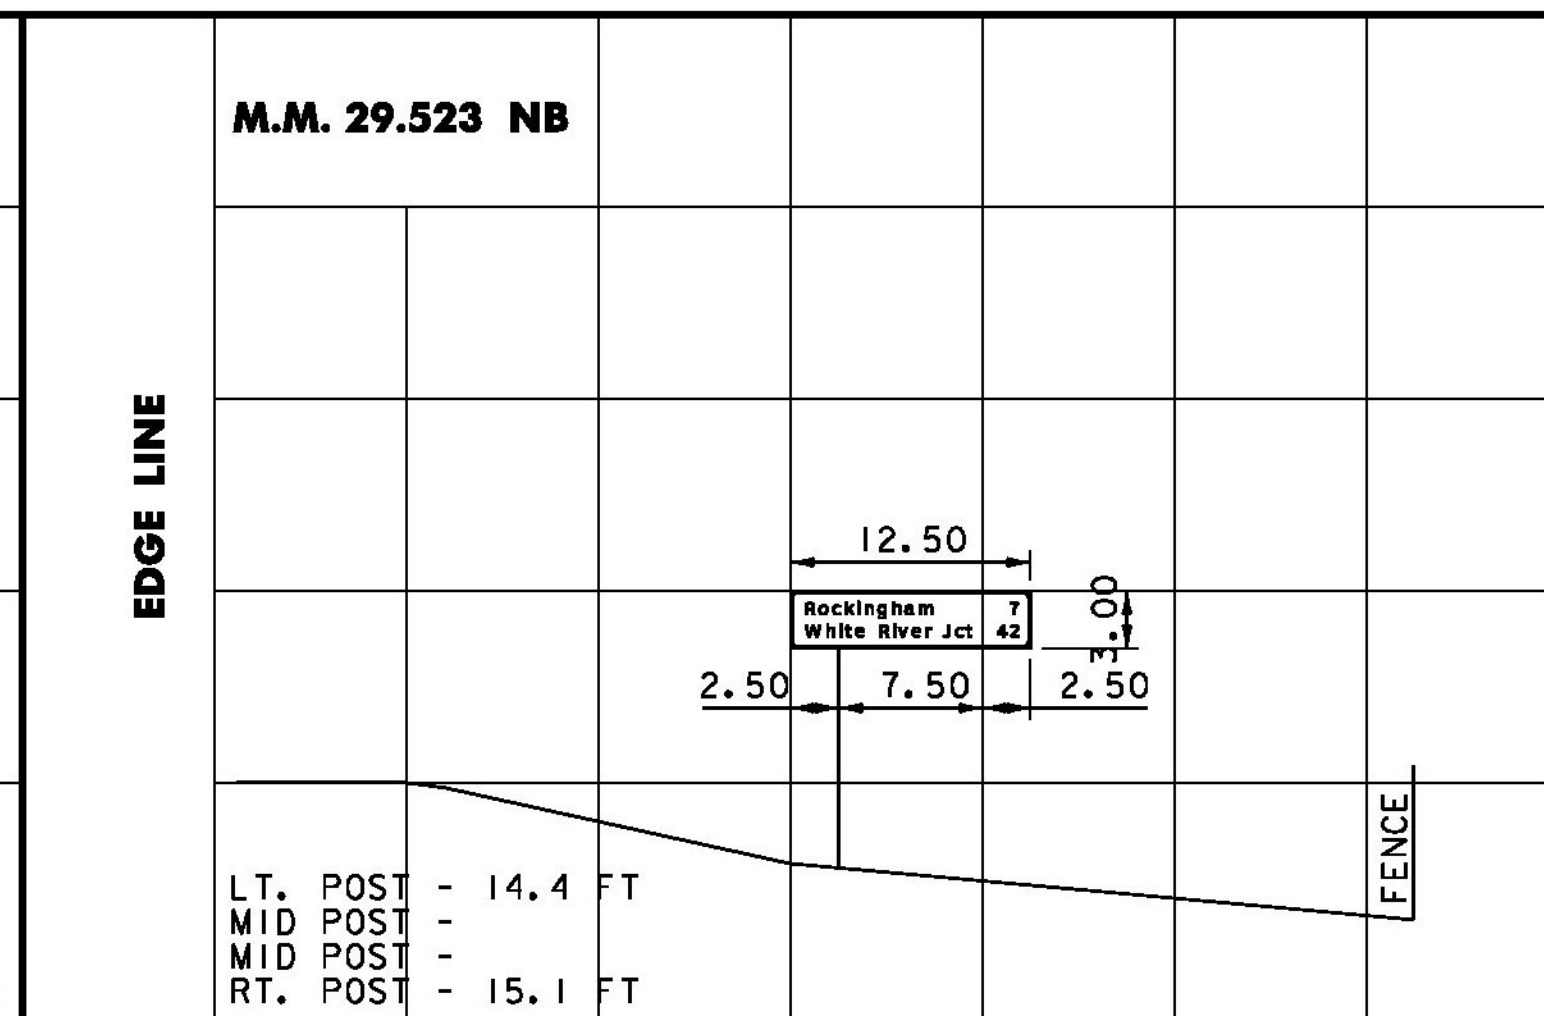
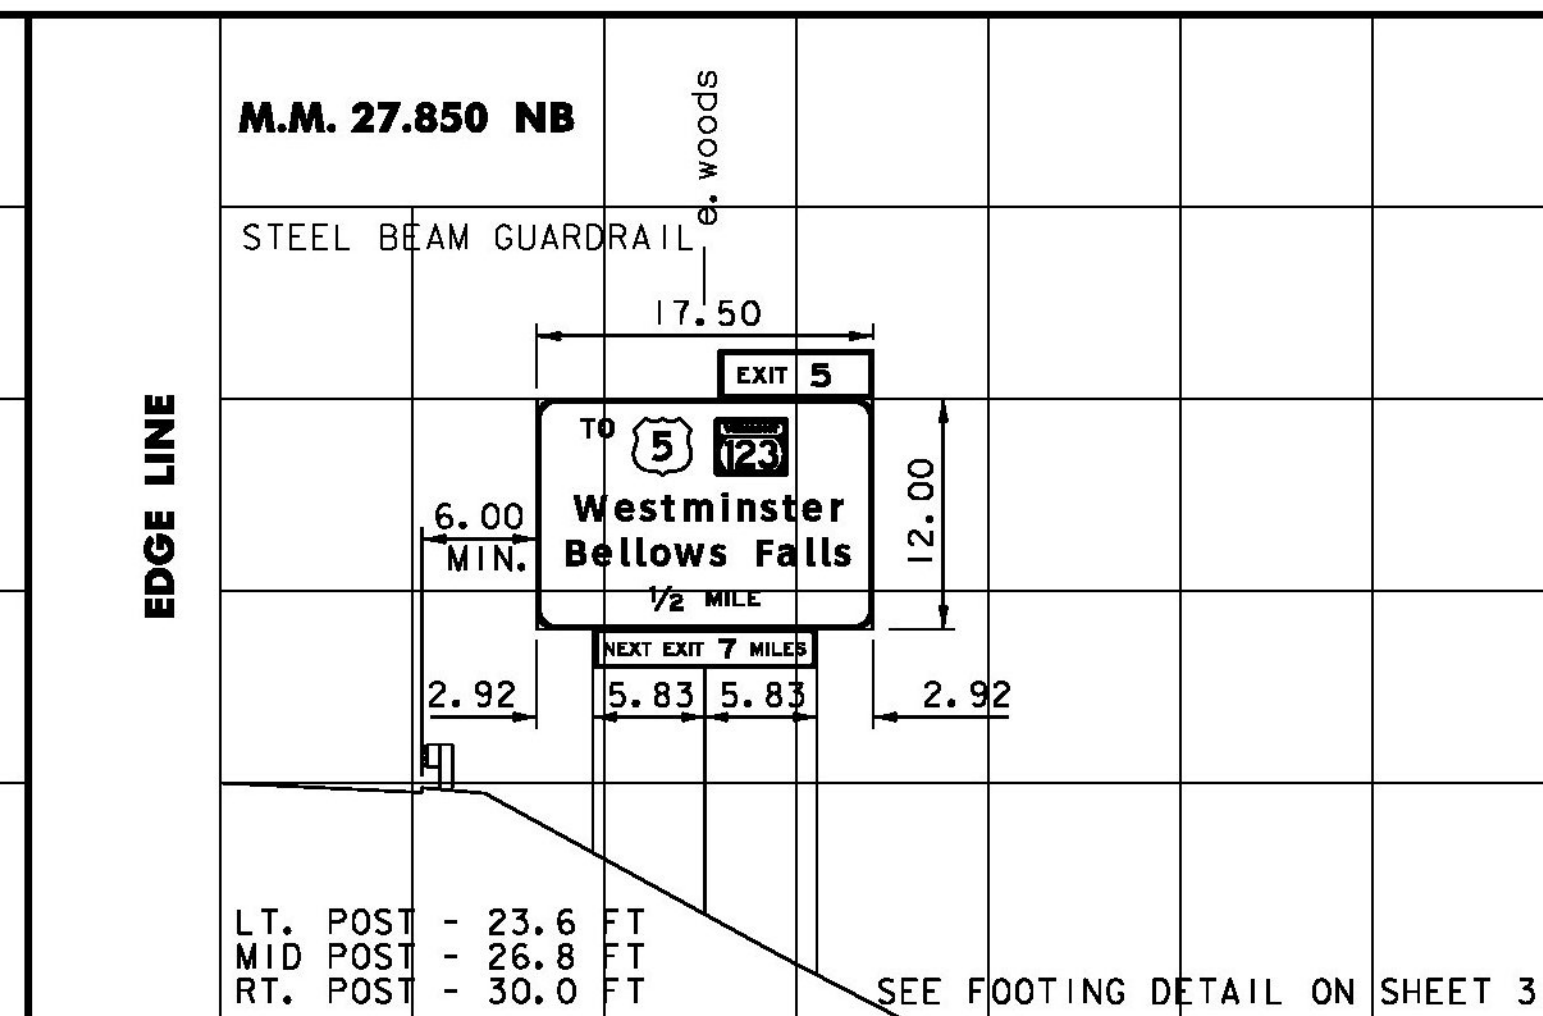


CLD 12-0350 MODEL: 03

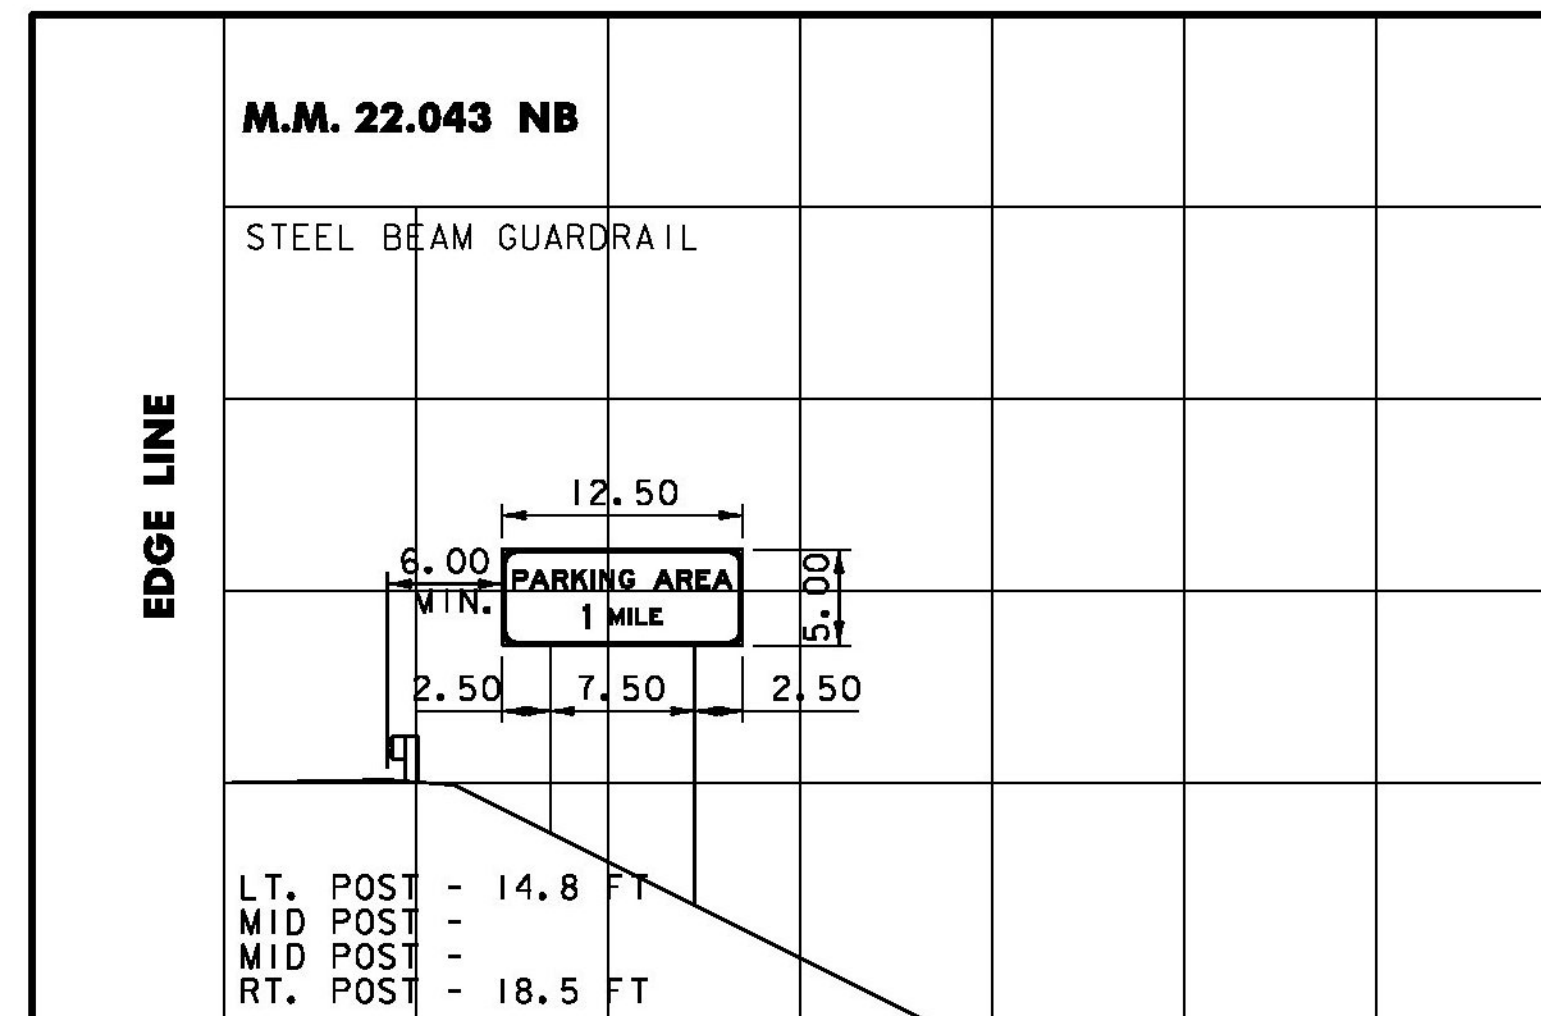

DIMENSIONS FOR CRITICAL OFFSETS OR CLEARANCES SHOWN FOR CONVENIENCE, REFER TO STANDARD SHEET E-120 FOR PLACEMENT GUIDELINES.

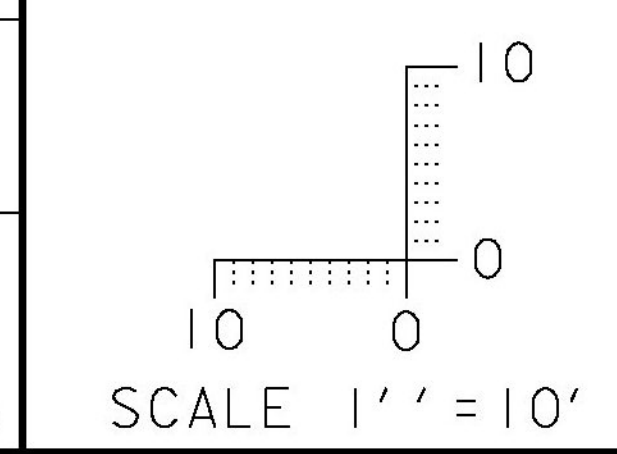

**CLD CONSULTING ENGINEERS**

540 Commercial Street, Manchester, NH 03101  
(603) 668-8223 • Fax: (603) 668-8802  
cid@cldeengineers.com • www.cldeengineers.com  
Maine • New Hampshire • Vermont

PROJECT NAME: GUILFORD-ROCKINGHAM	PLOT DATE: 4/17/2014
PROJECT NUMBER: IMG SIGN(44)	DRAWN BY: S. GOODWIN
FILE NAME: z12A528xs.dgn	CHECKED BY: D. MUNRO
DESIGNED BY: J. SMITH	SHEET 153 OF 157
CROSS SECTION SHEET 3	