

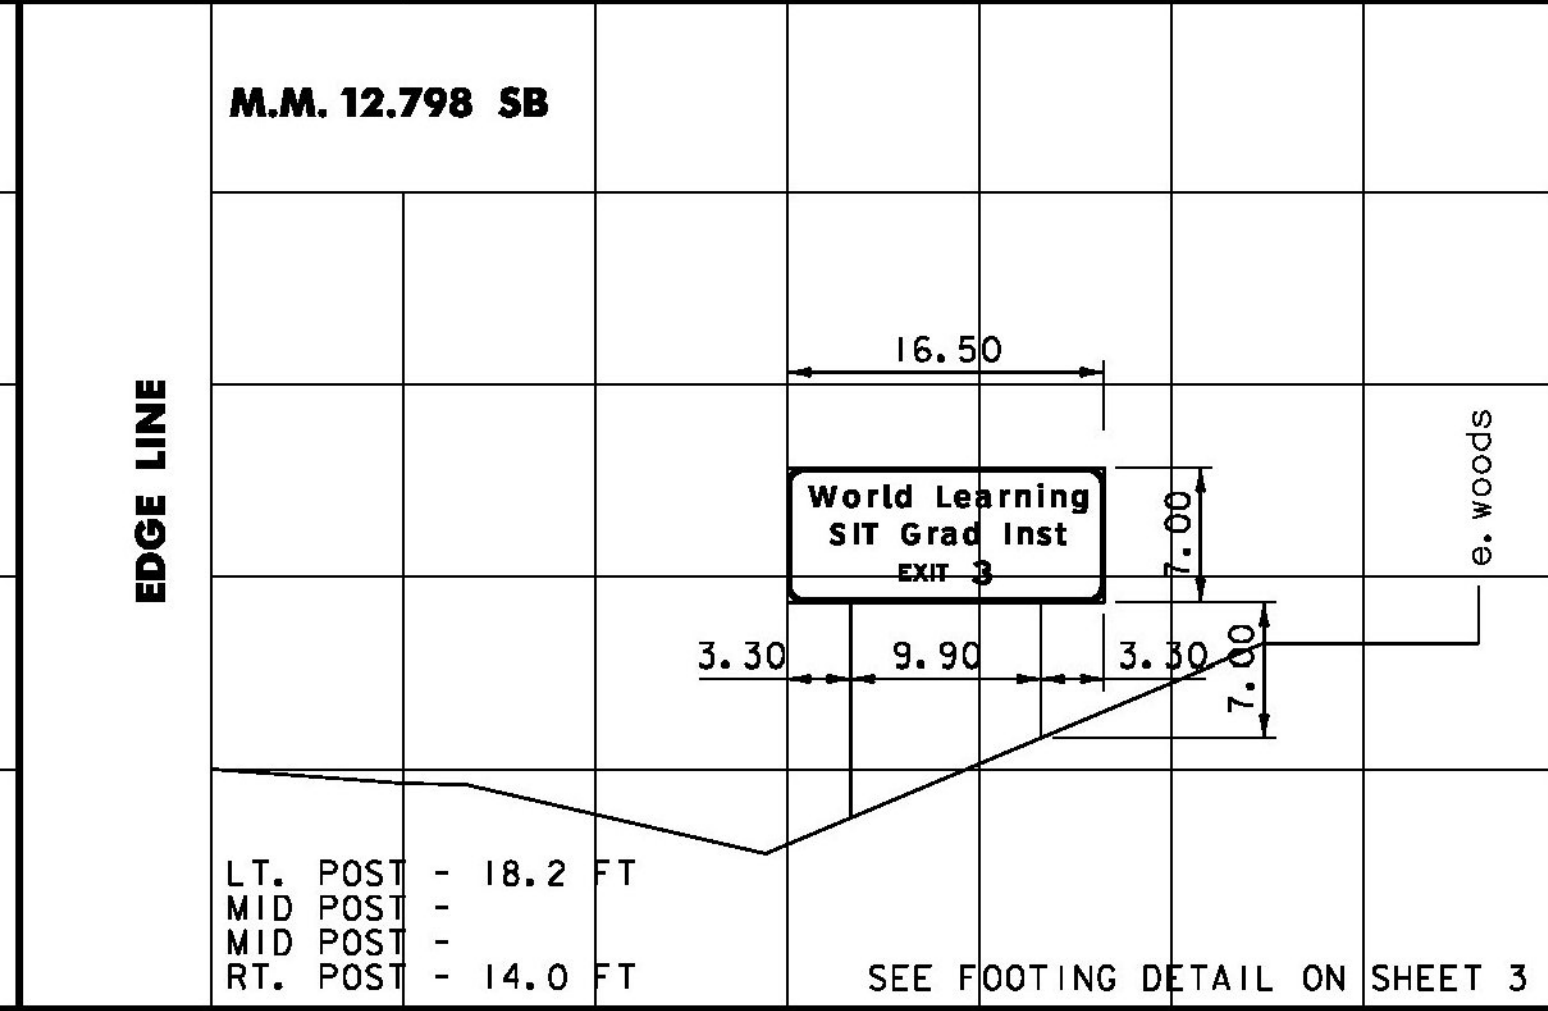
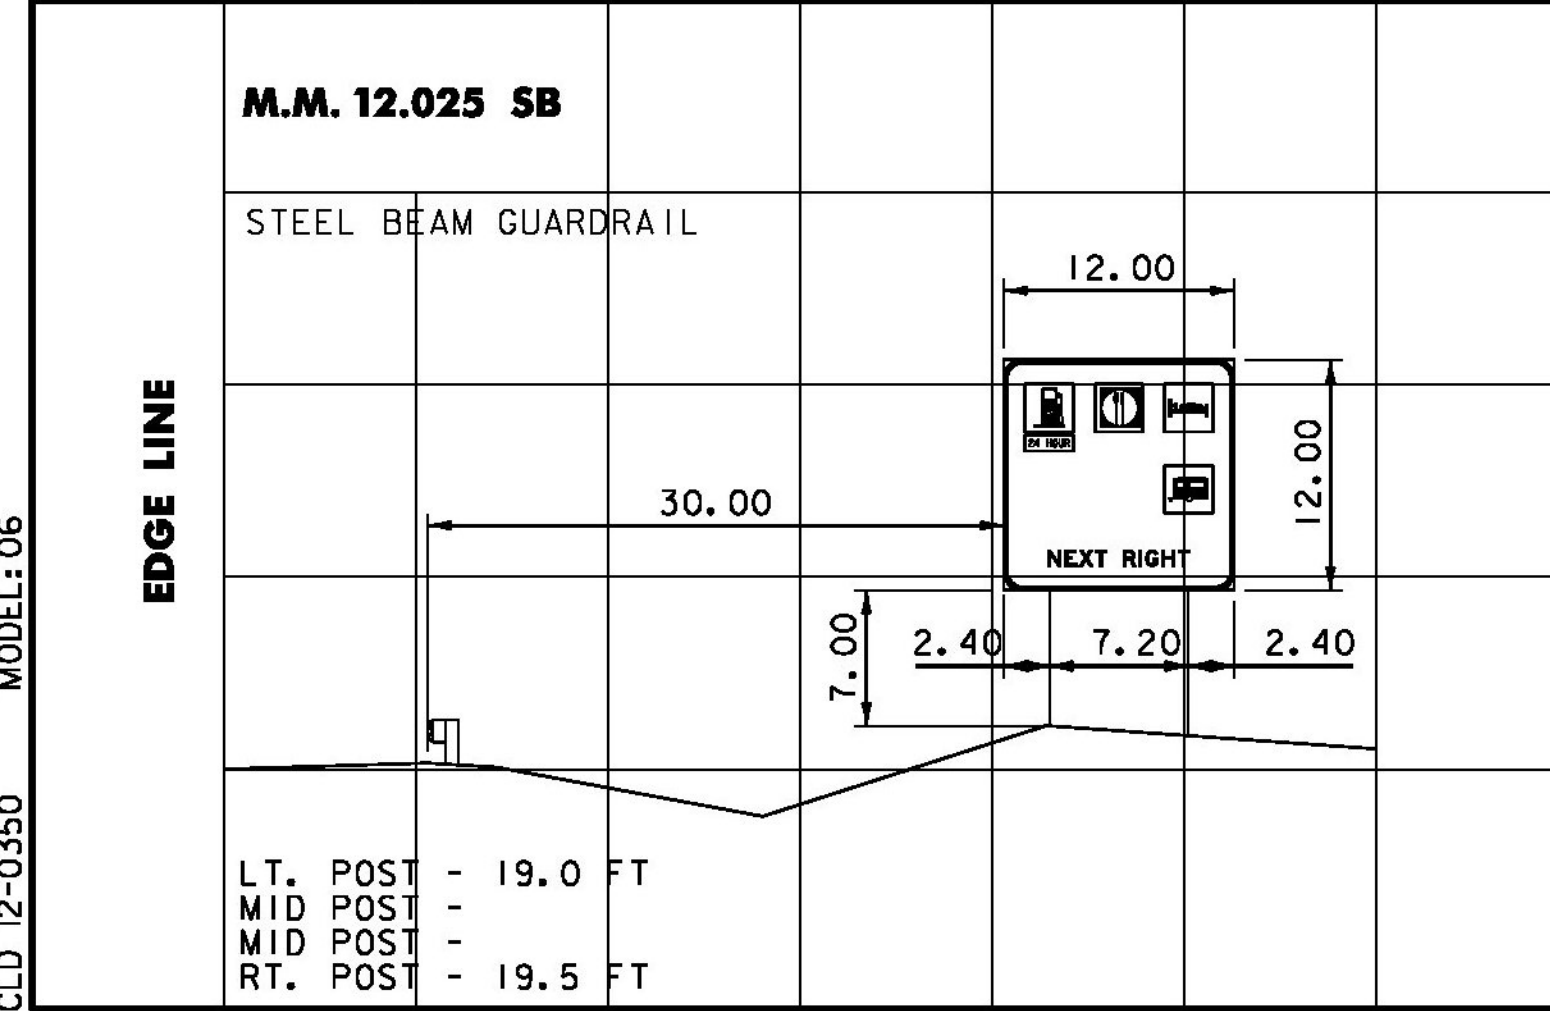
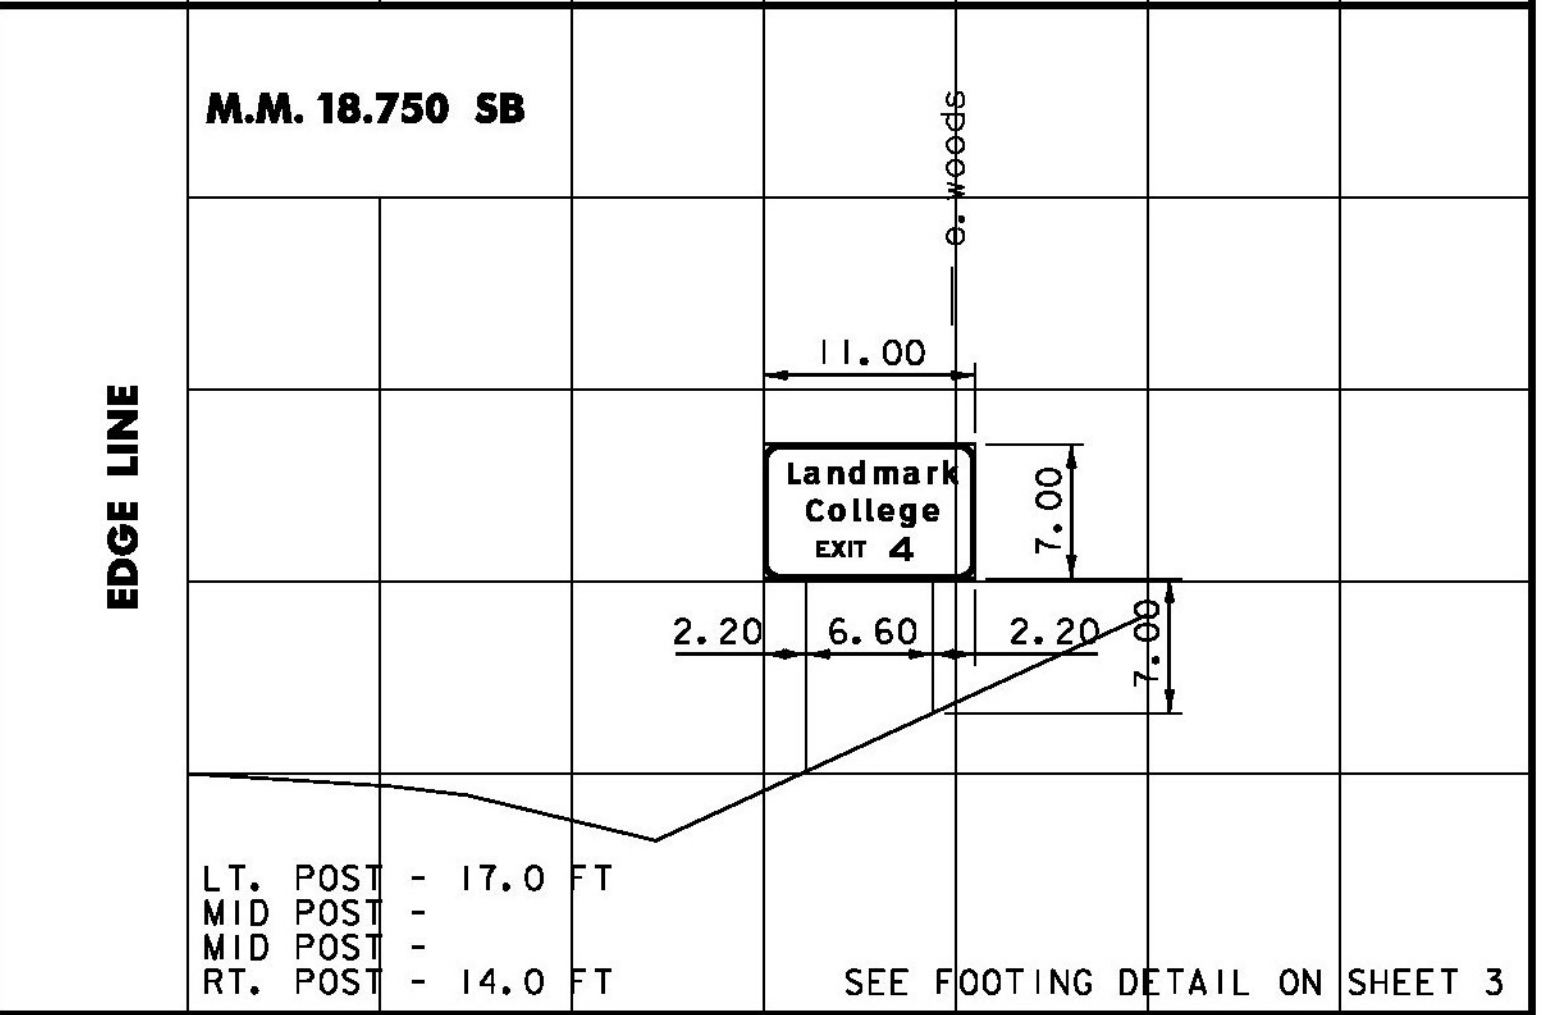
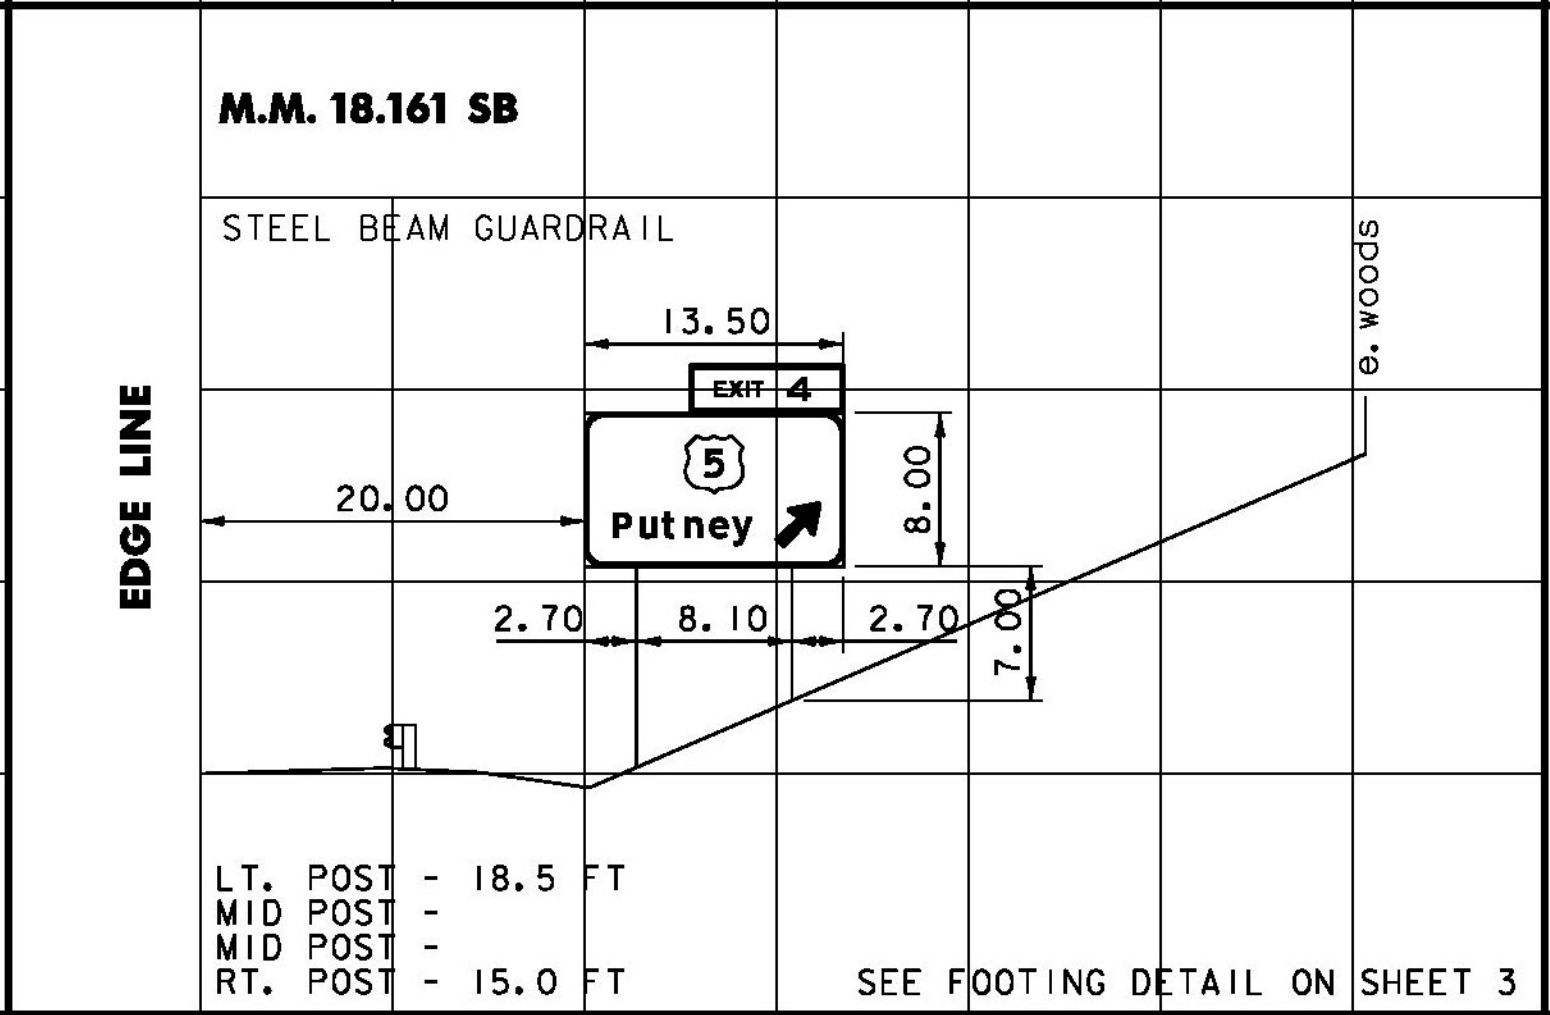
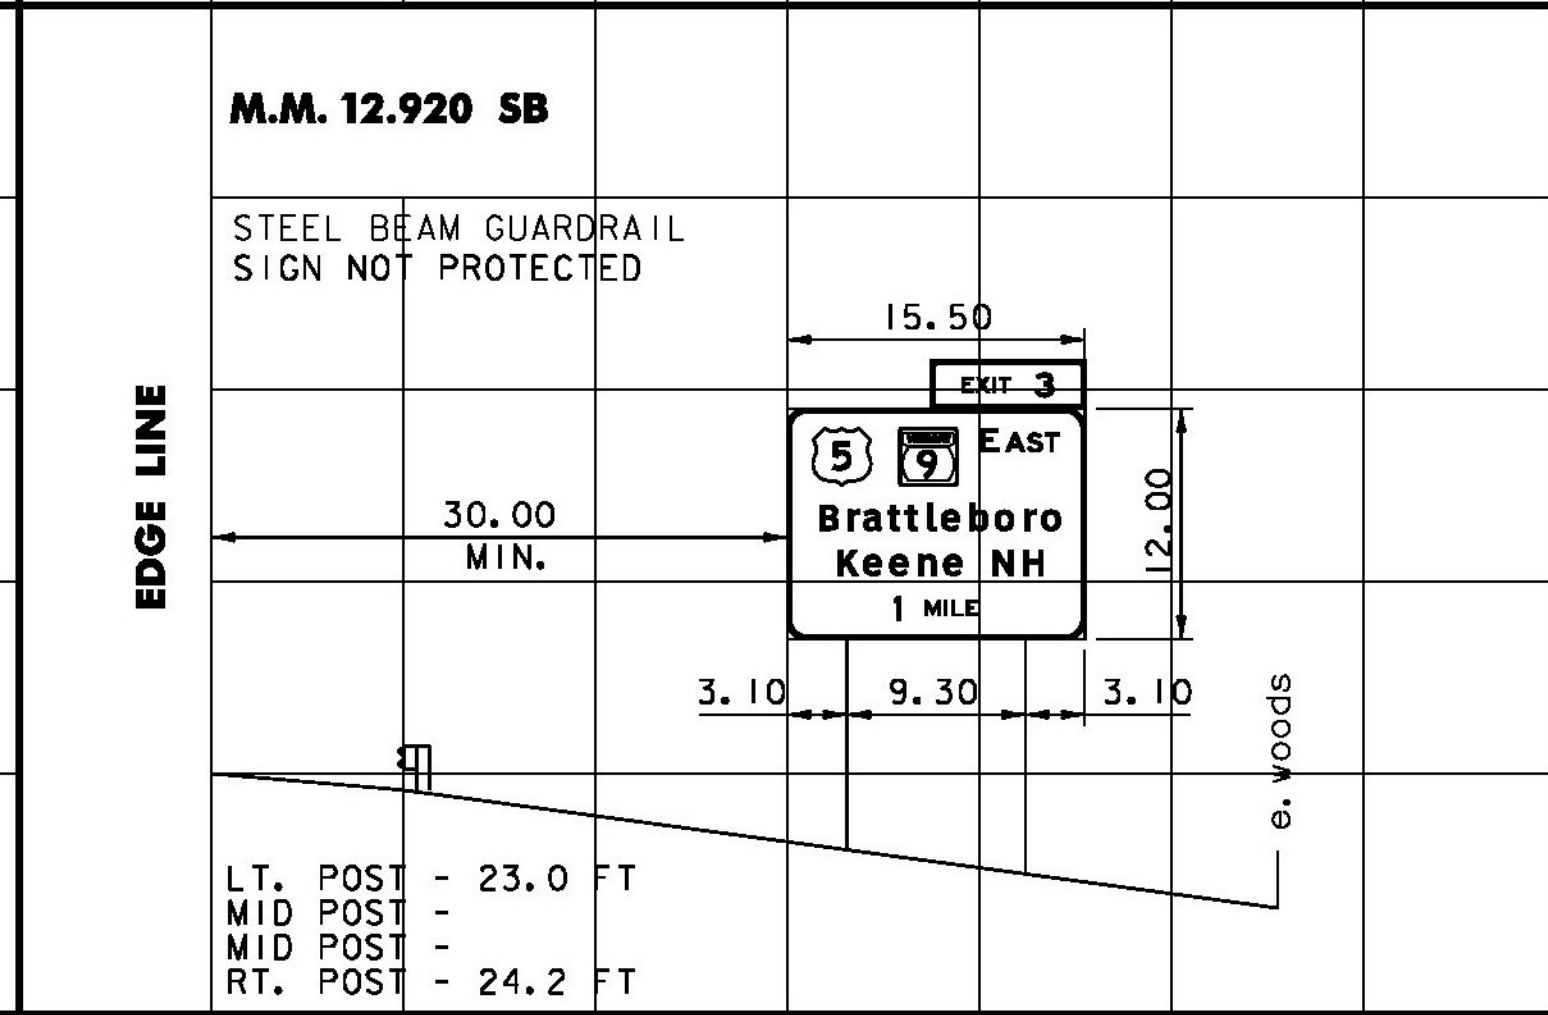
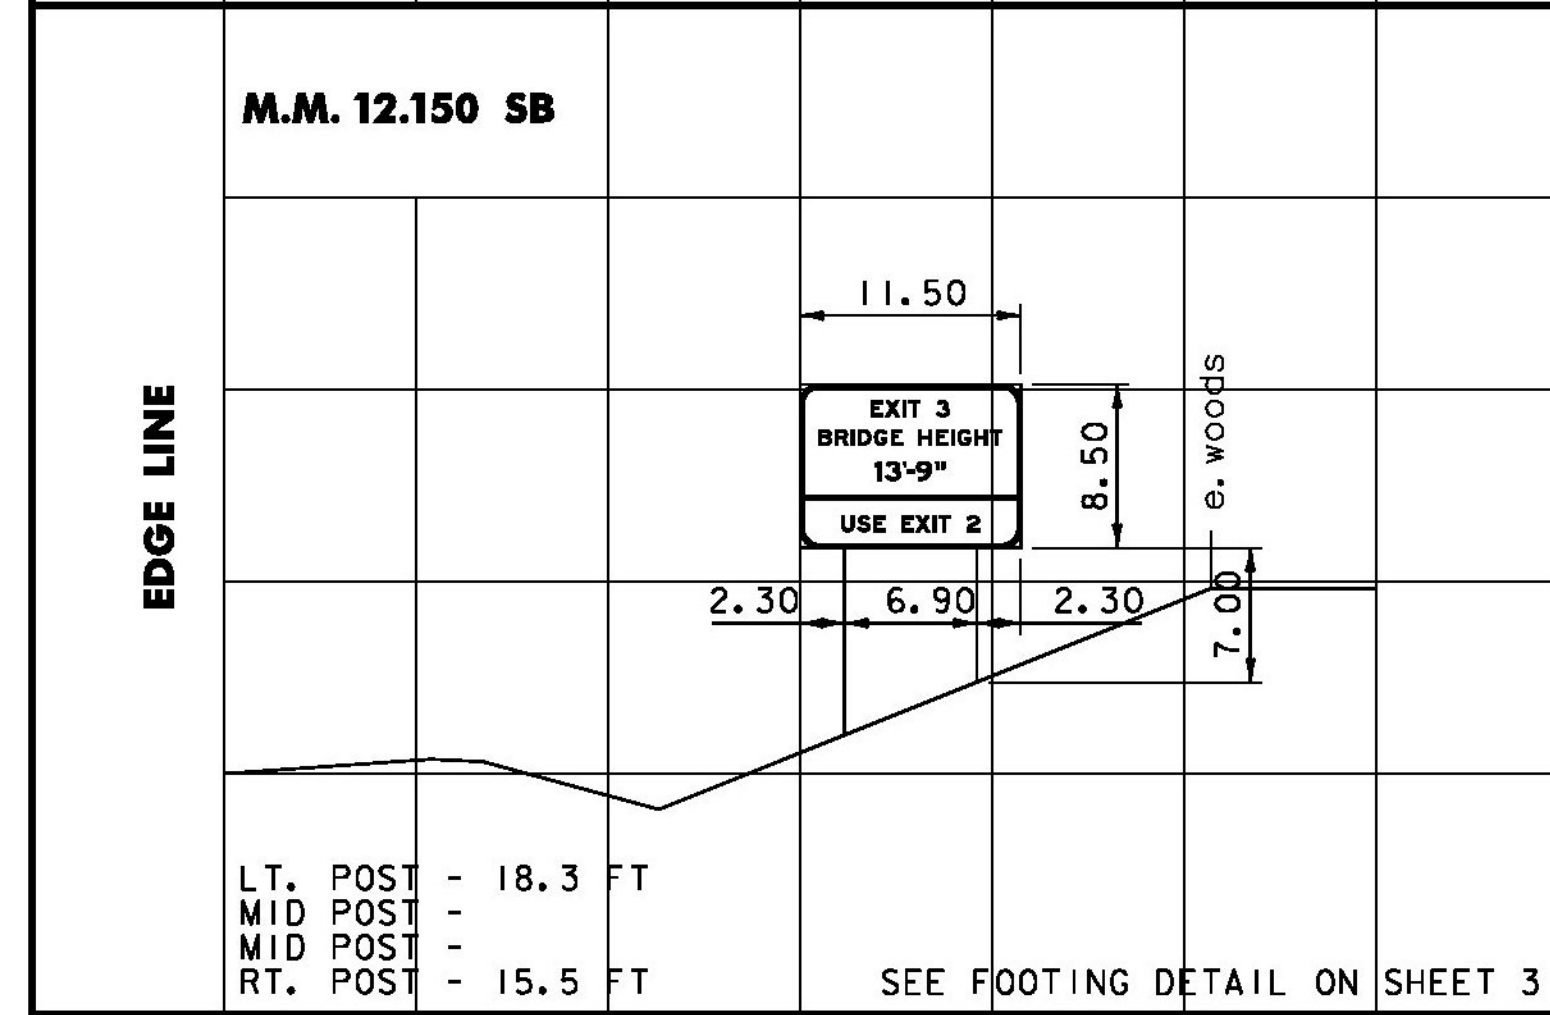
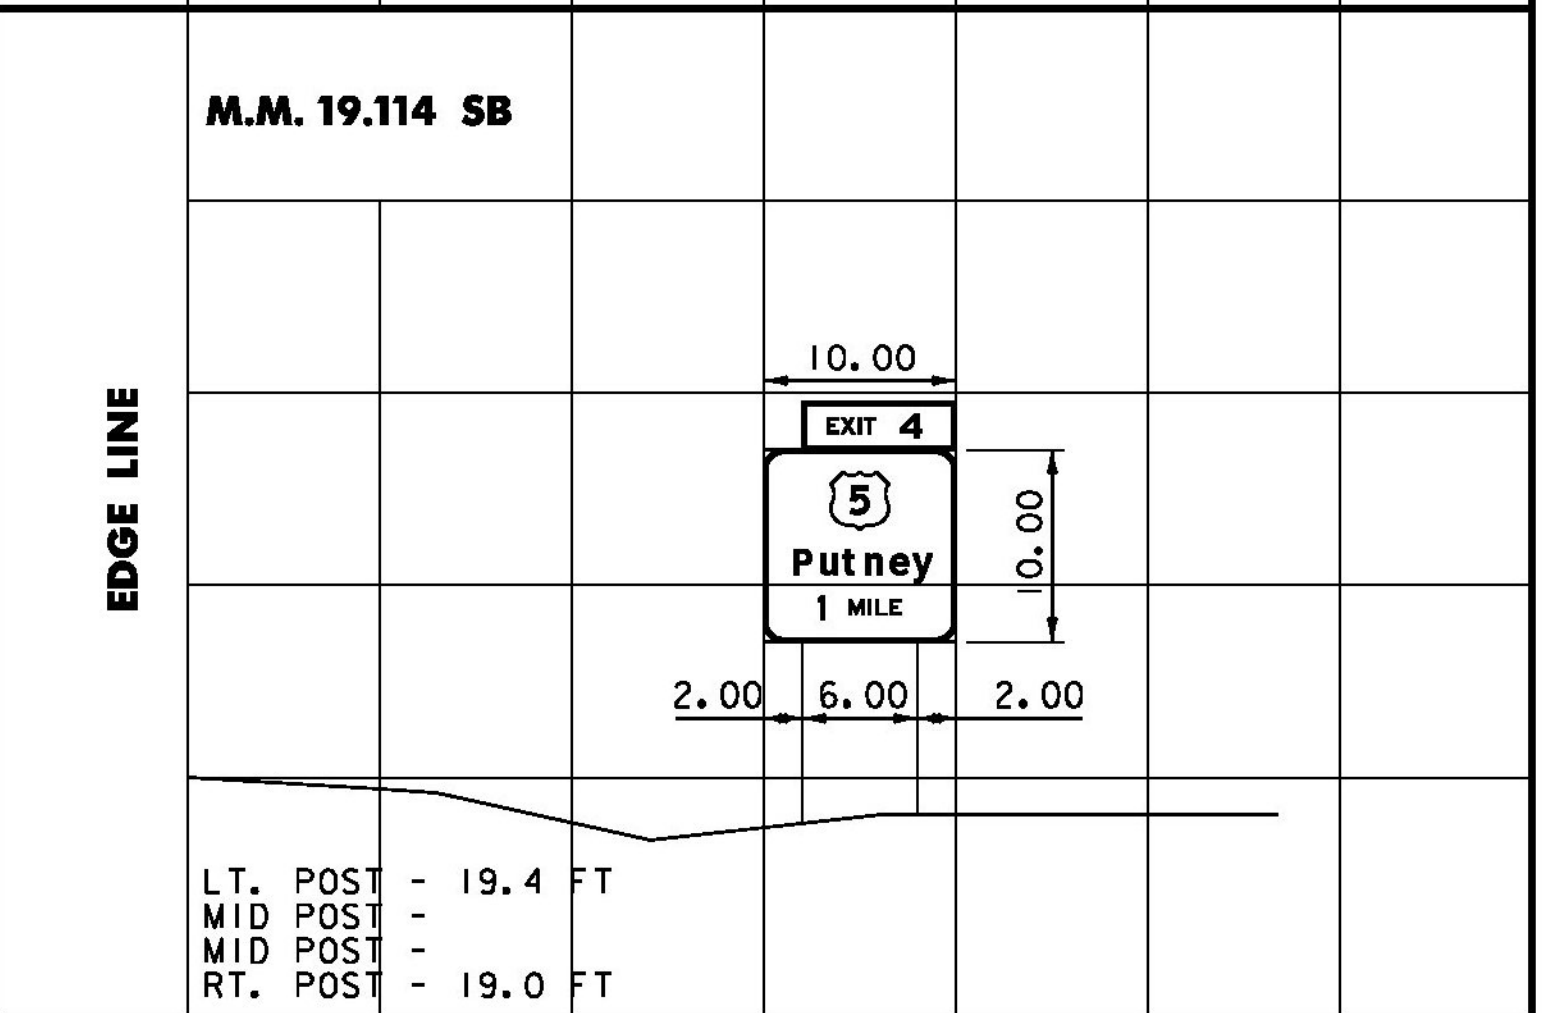
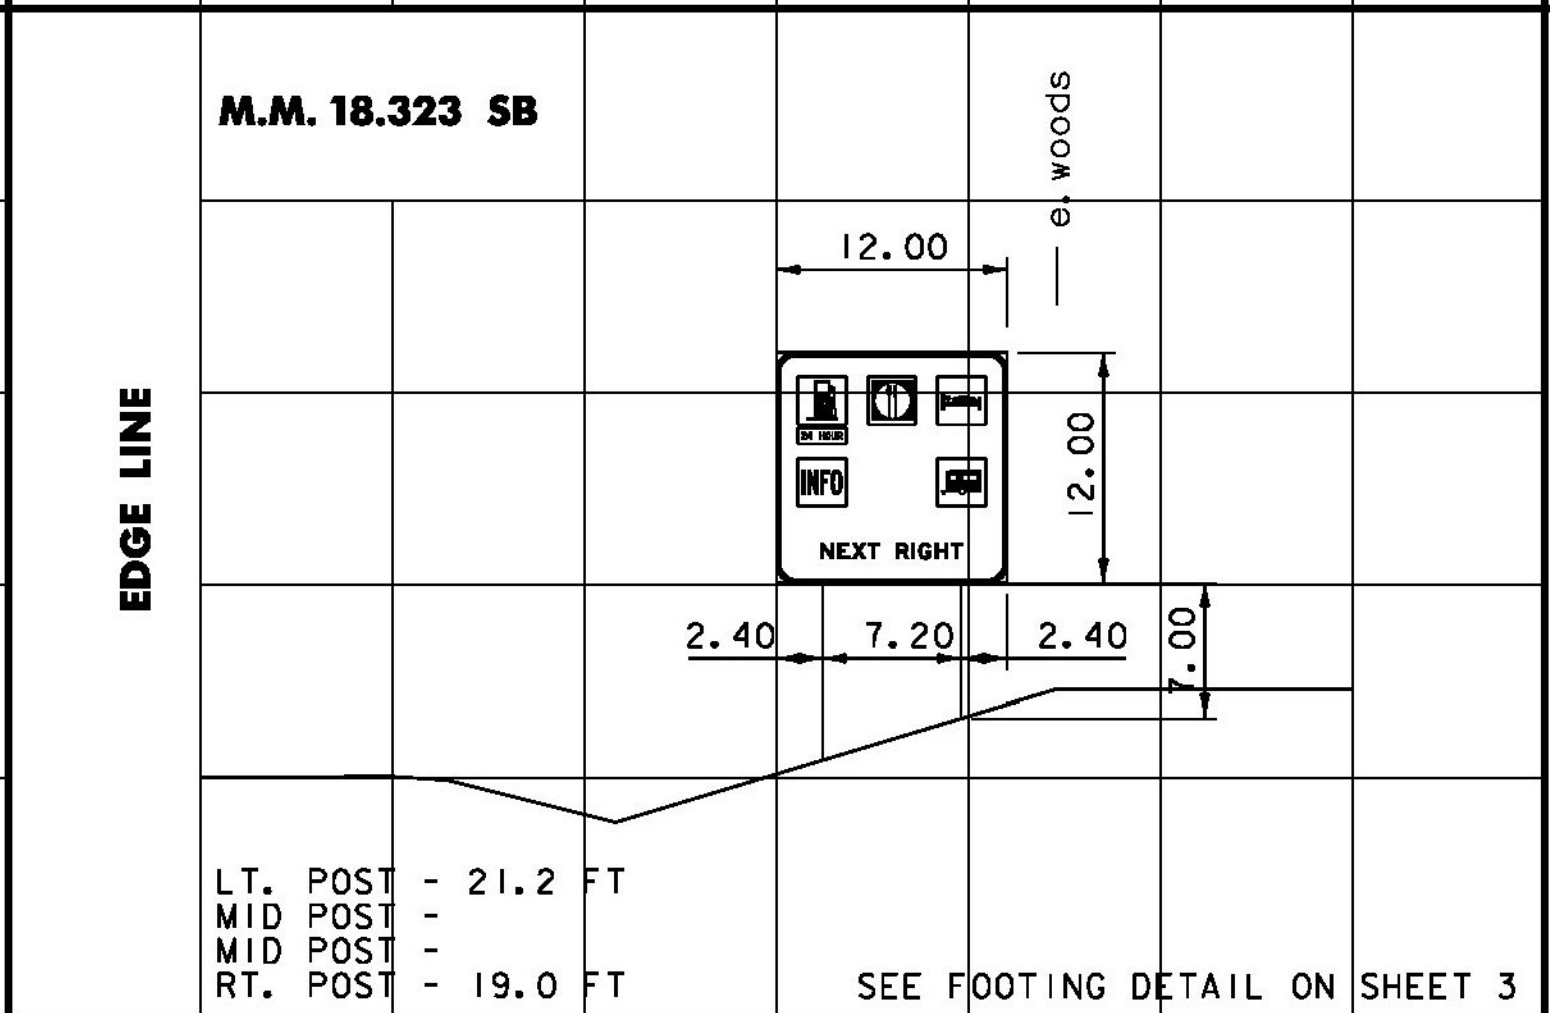
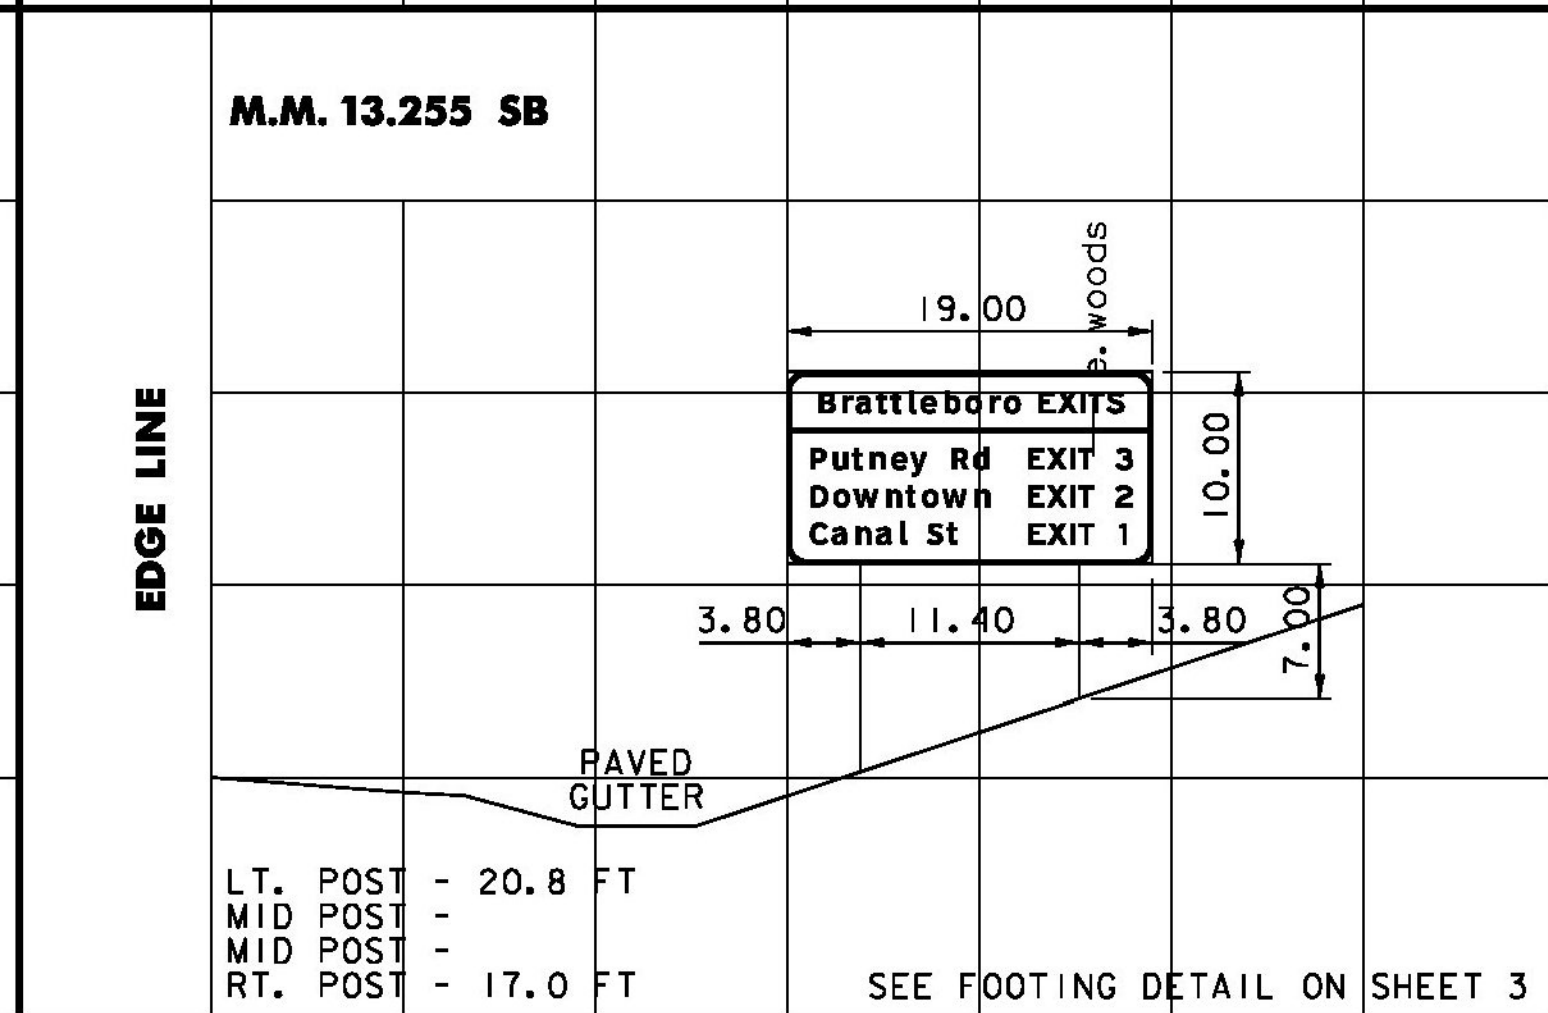
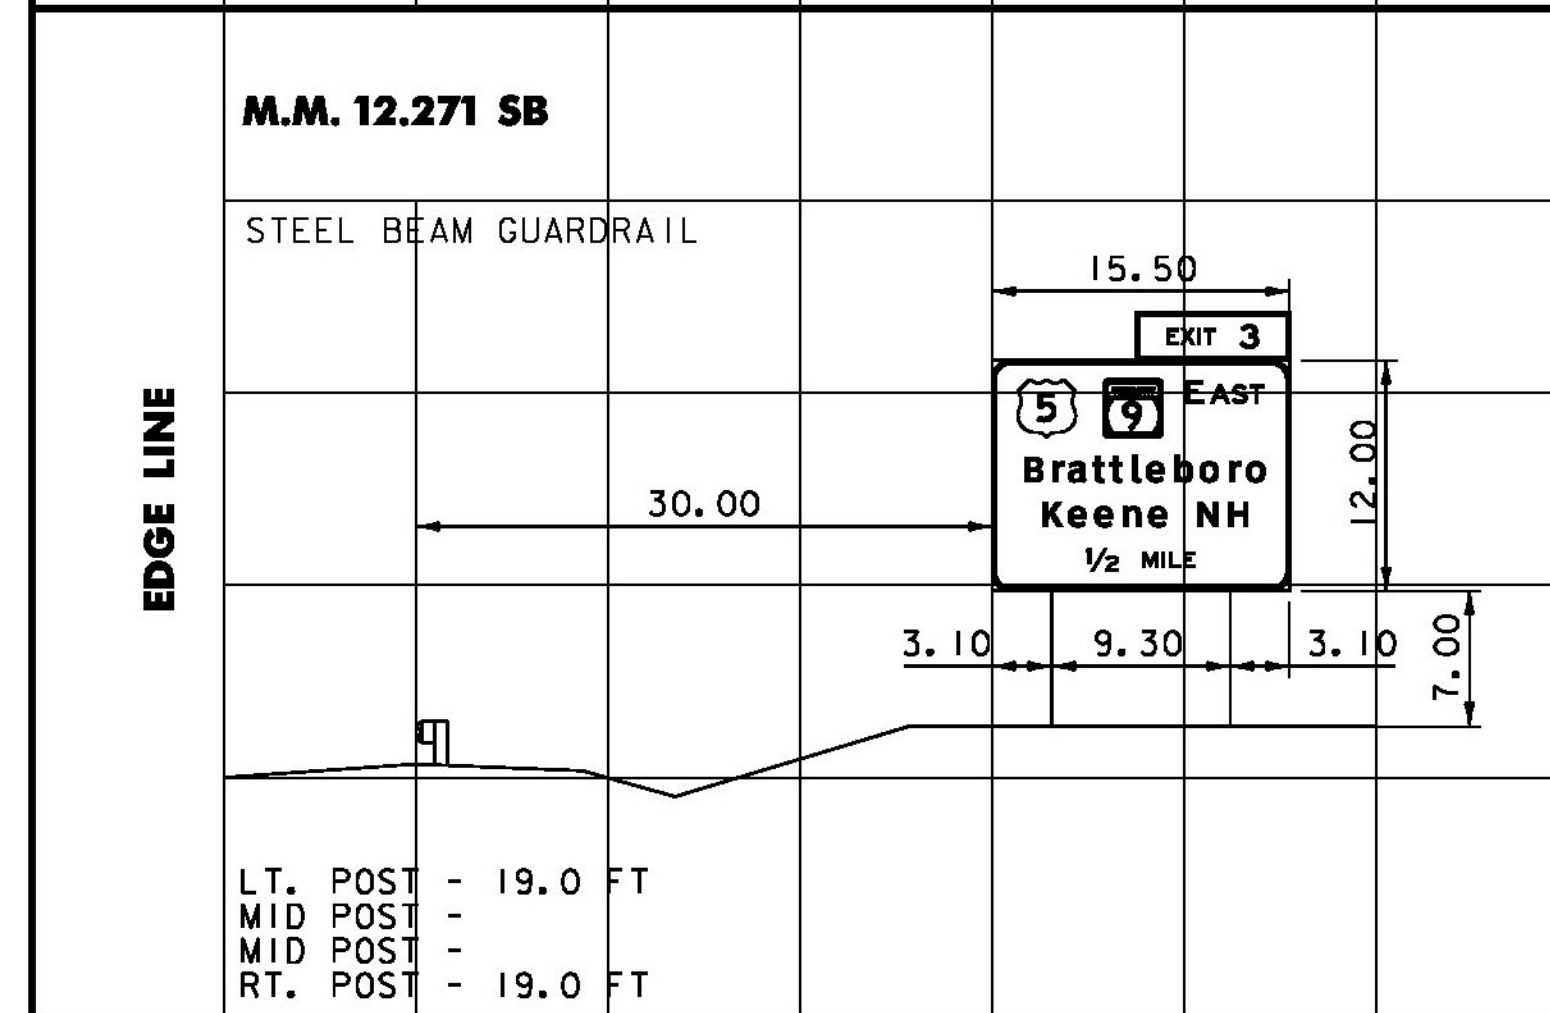
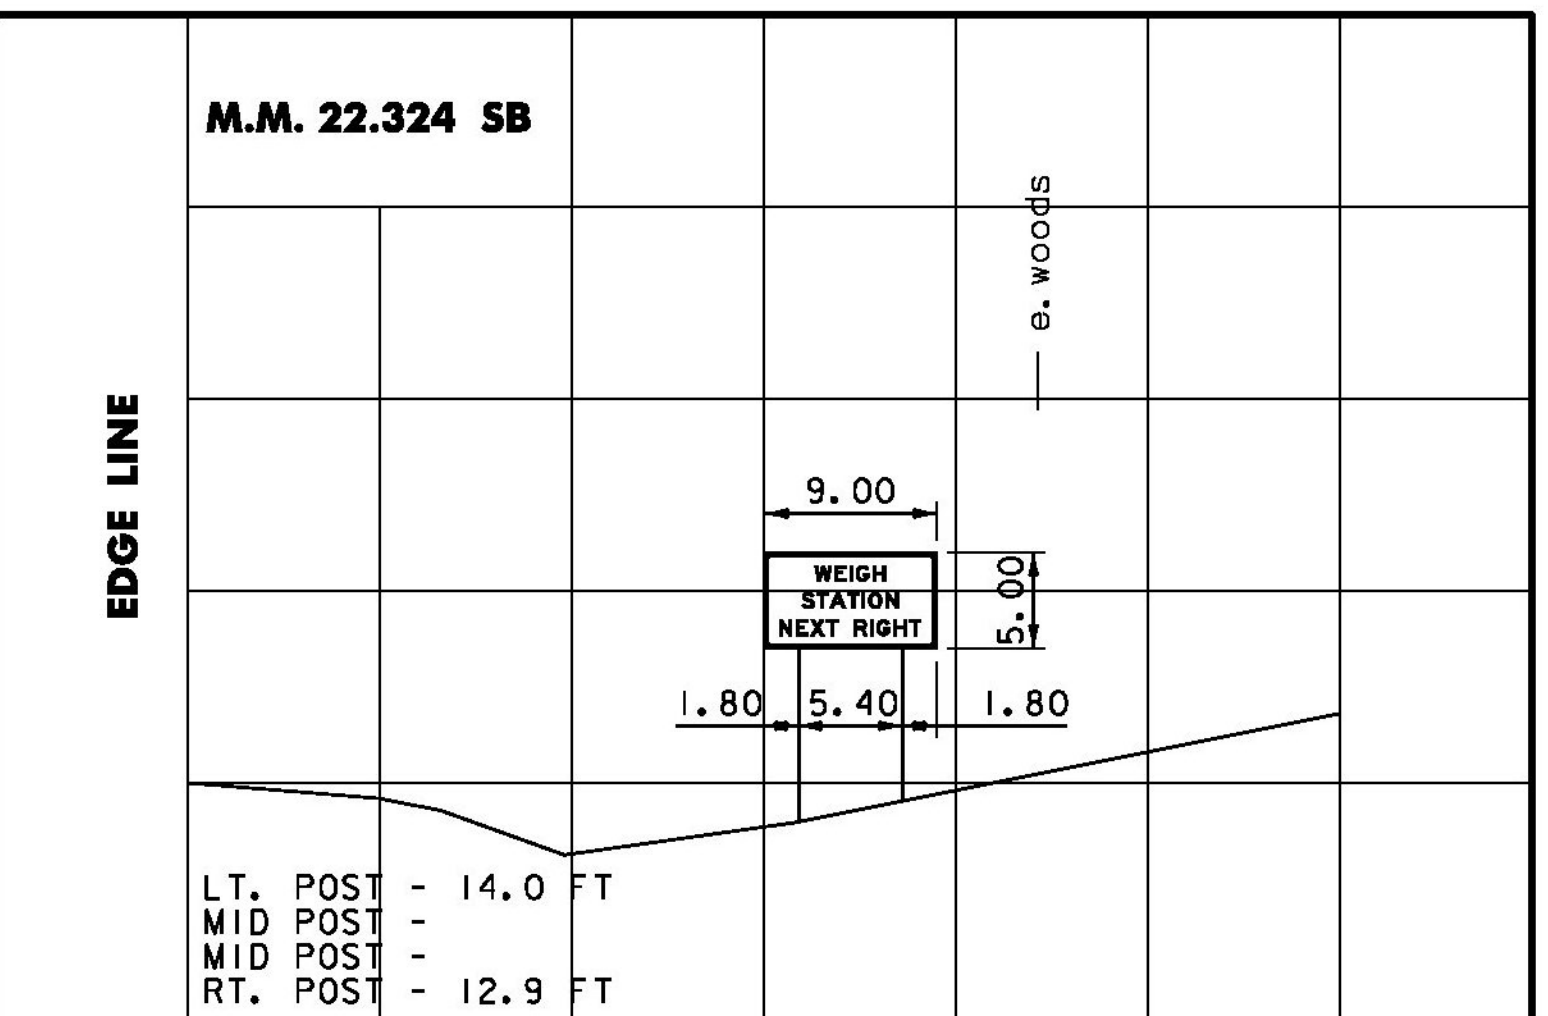
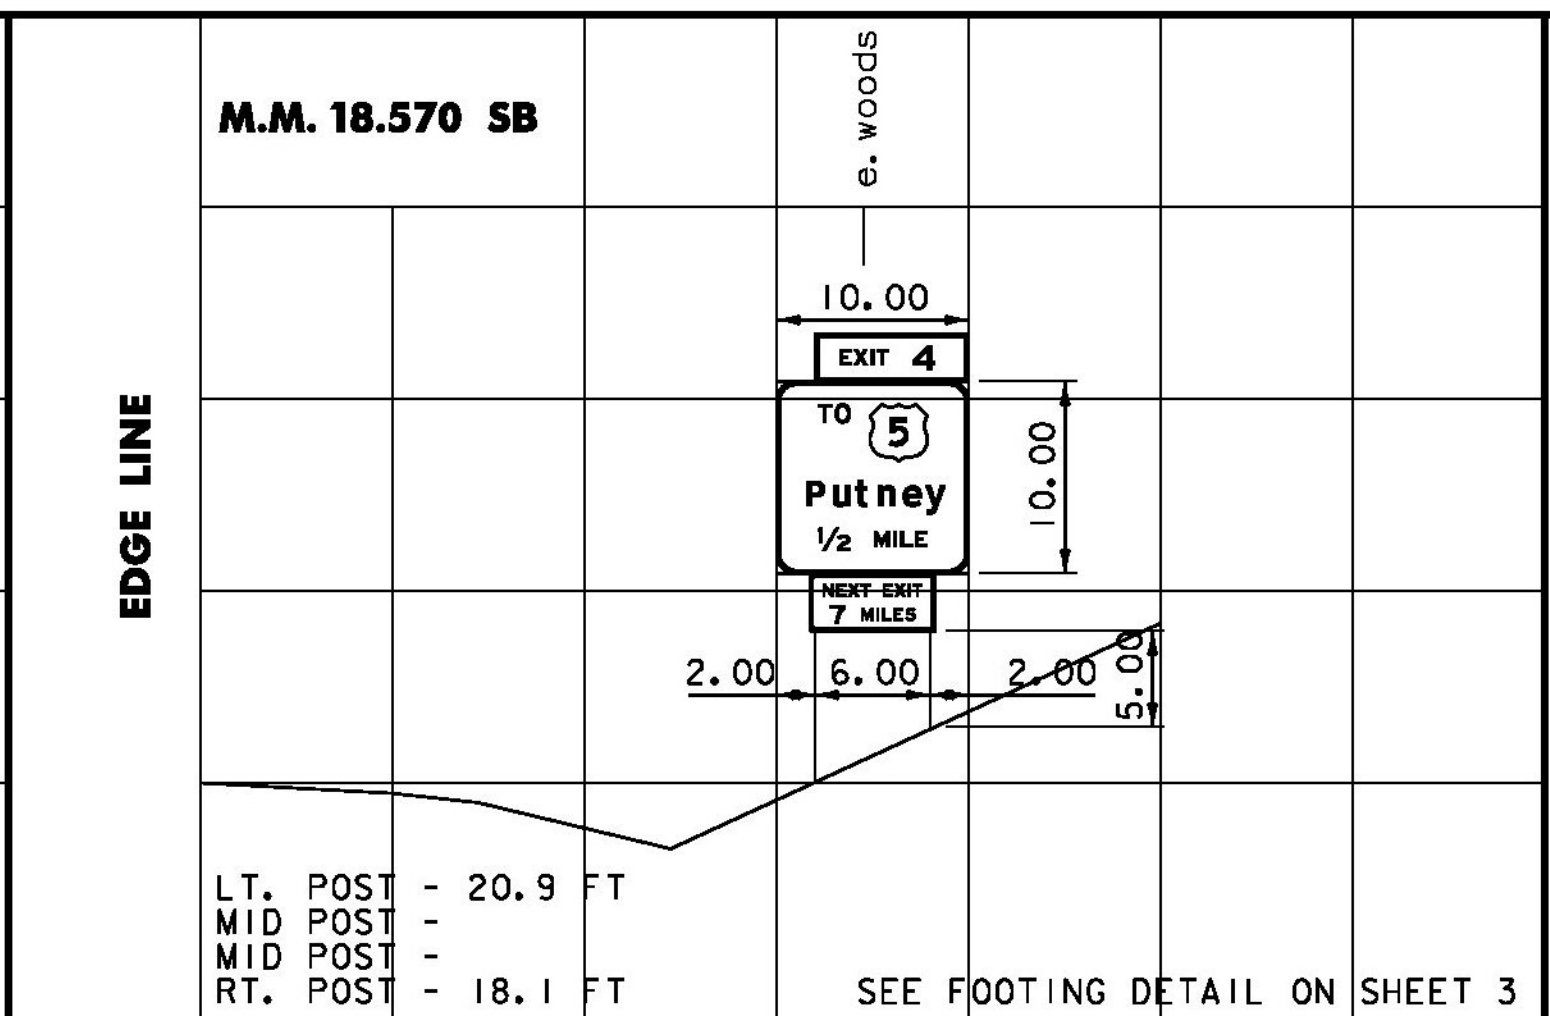
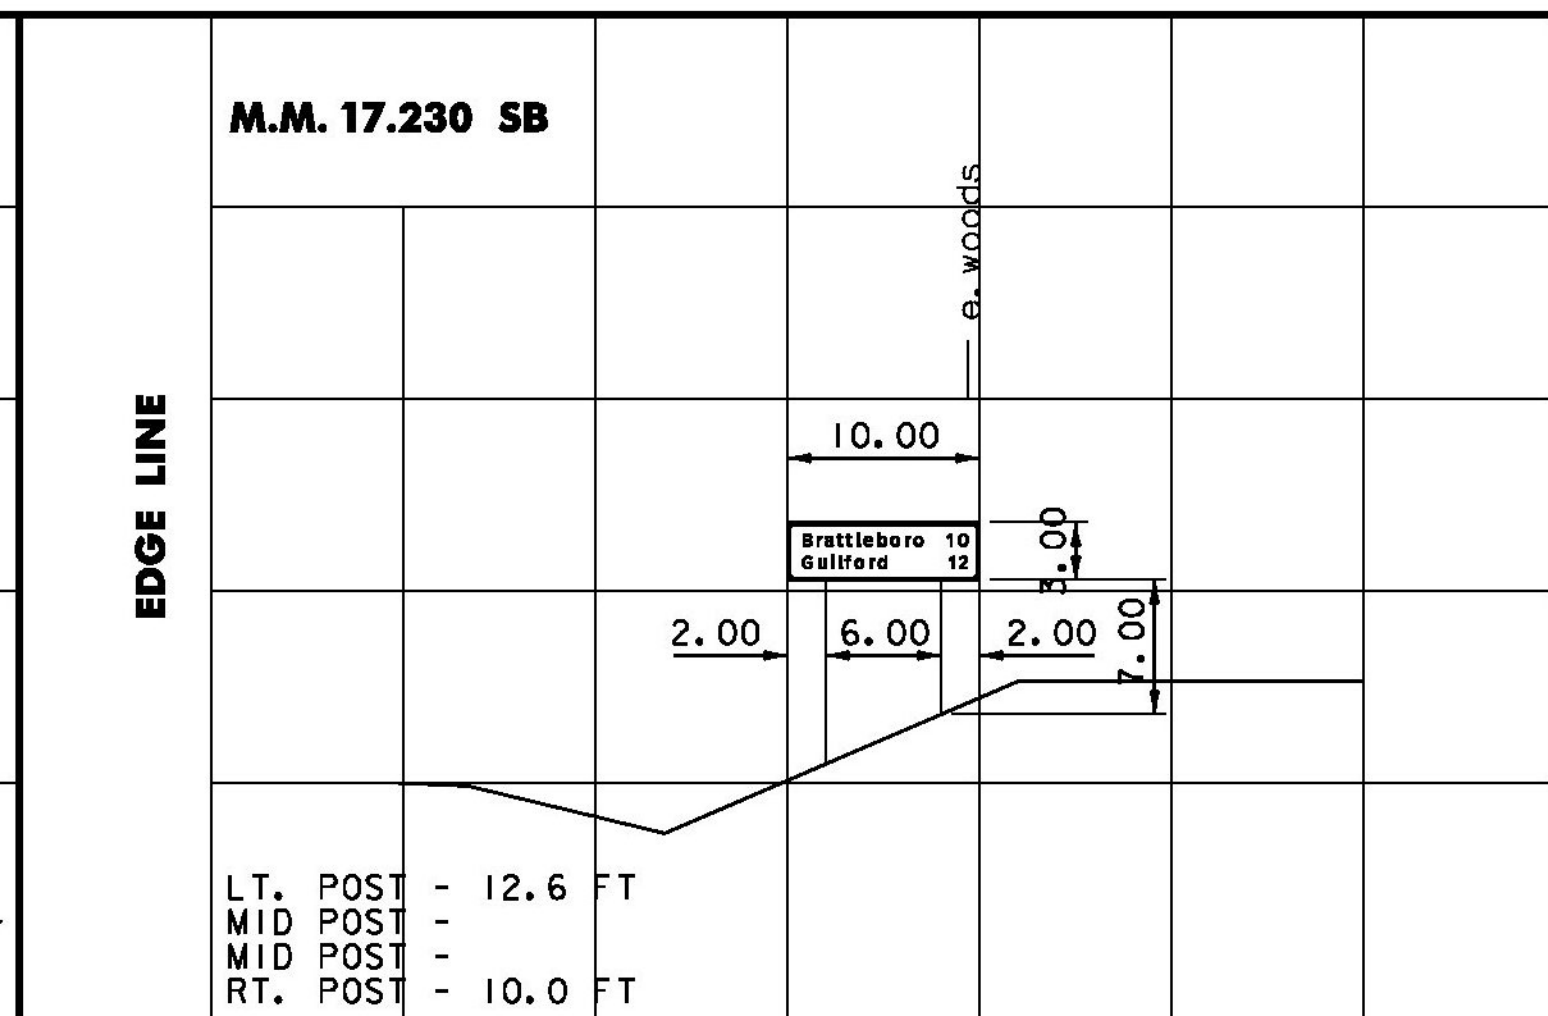


CLD 12-0350 MODEL:06

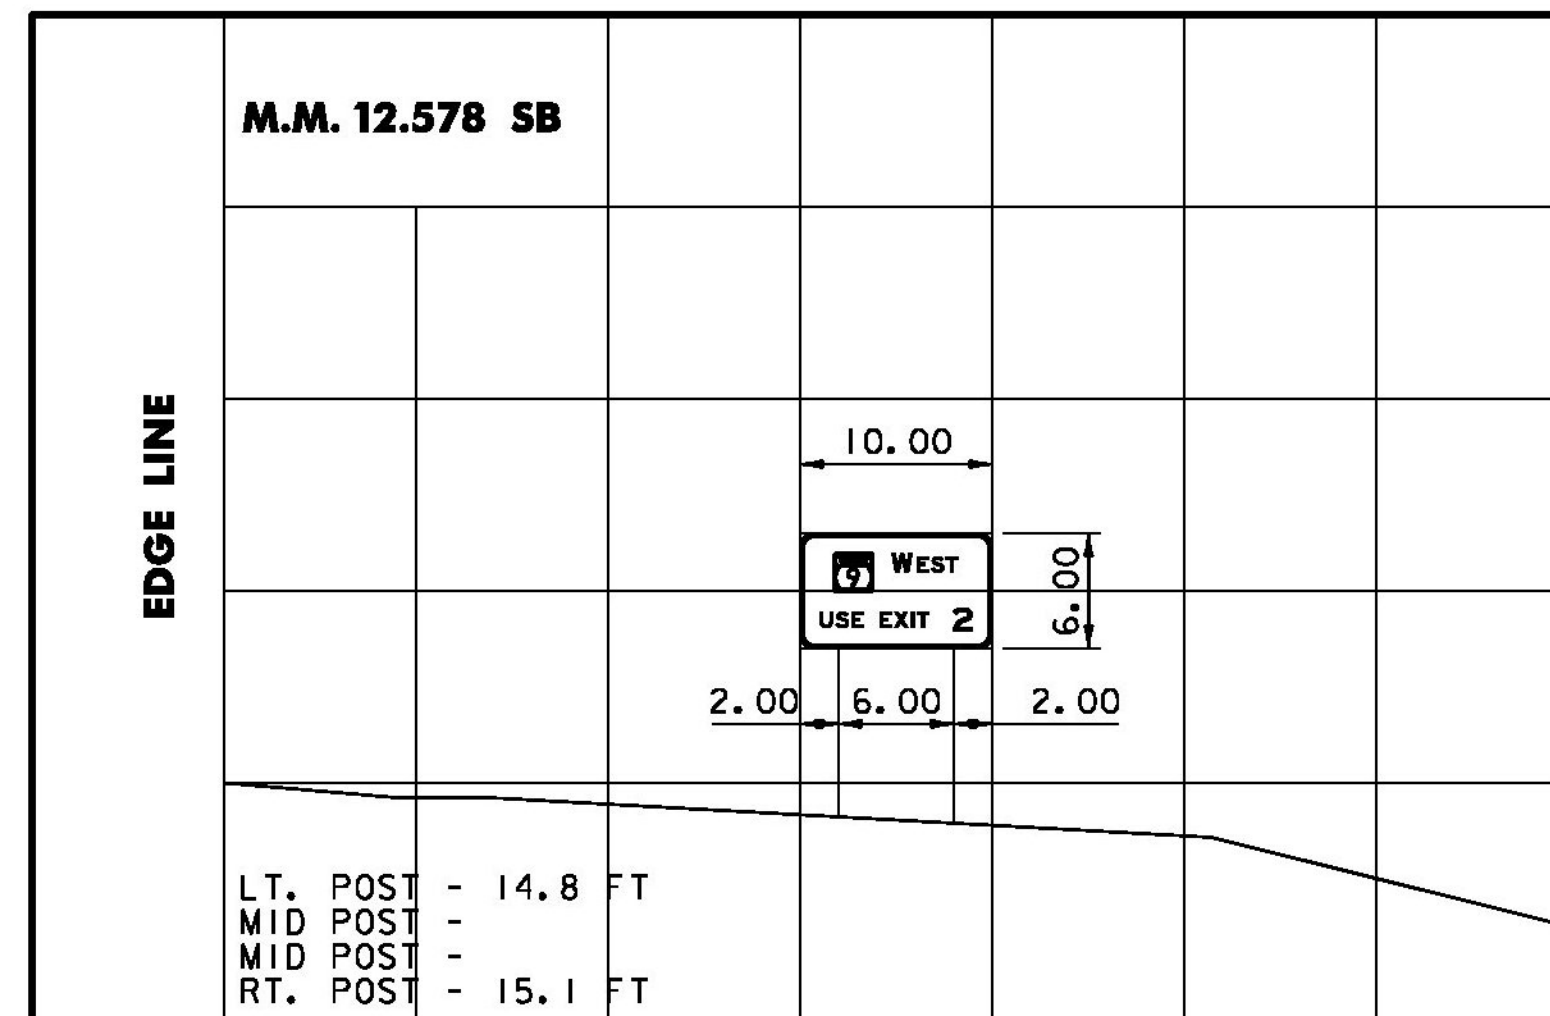

DIMENSIONS FOR CRITICAL OFFSETS OR CLEARANCES SHOWN FOR CONVENIENCE, REFER TO STANDARD SHEET E-120 FOR PLACEMENT GUIDELINES.

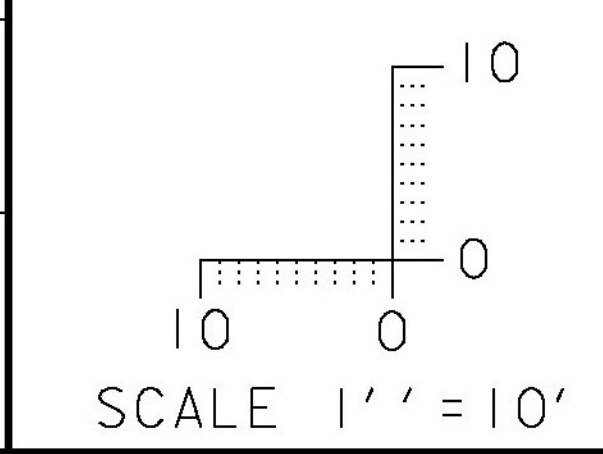

540 Commercial Street, Manchester, NH 03101
(603) 668-8223 • Fax: (603) 668-8802
cid@cldeengineers.com • www.cldeengineers.com
Maine • New Hampshire • Vermont

| | |
|-----------------------------------|----------------------|
| PROJECT NAME: GUILFORD-ROCKINGHAM | PLOT DATE: 4/17/2014 |
| PROJECT NUMBER: IMG SIGN(44) | DRAWN BY: S. GOODWIN |
| FILE NAME: z12A528xs.dgn | CHECKED BY: D. MUNRO |
| PROJECT LEADER: C. GREGORY | SHEET 156 OF 157 |
| DESIGNED BY: J. SMITH | |
| CROSS SECTION SHEET 6 | |