

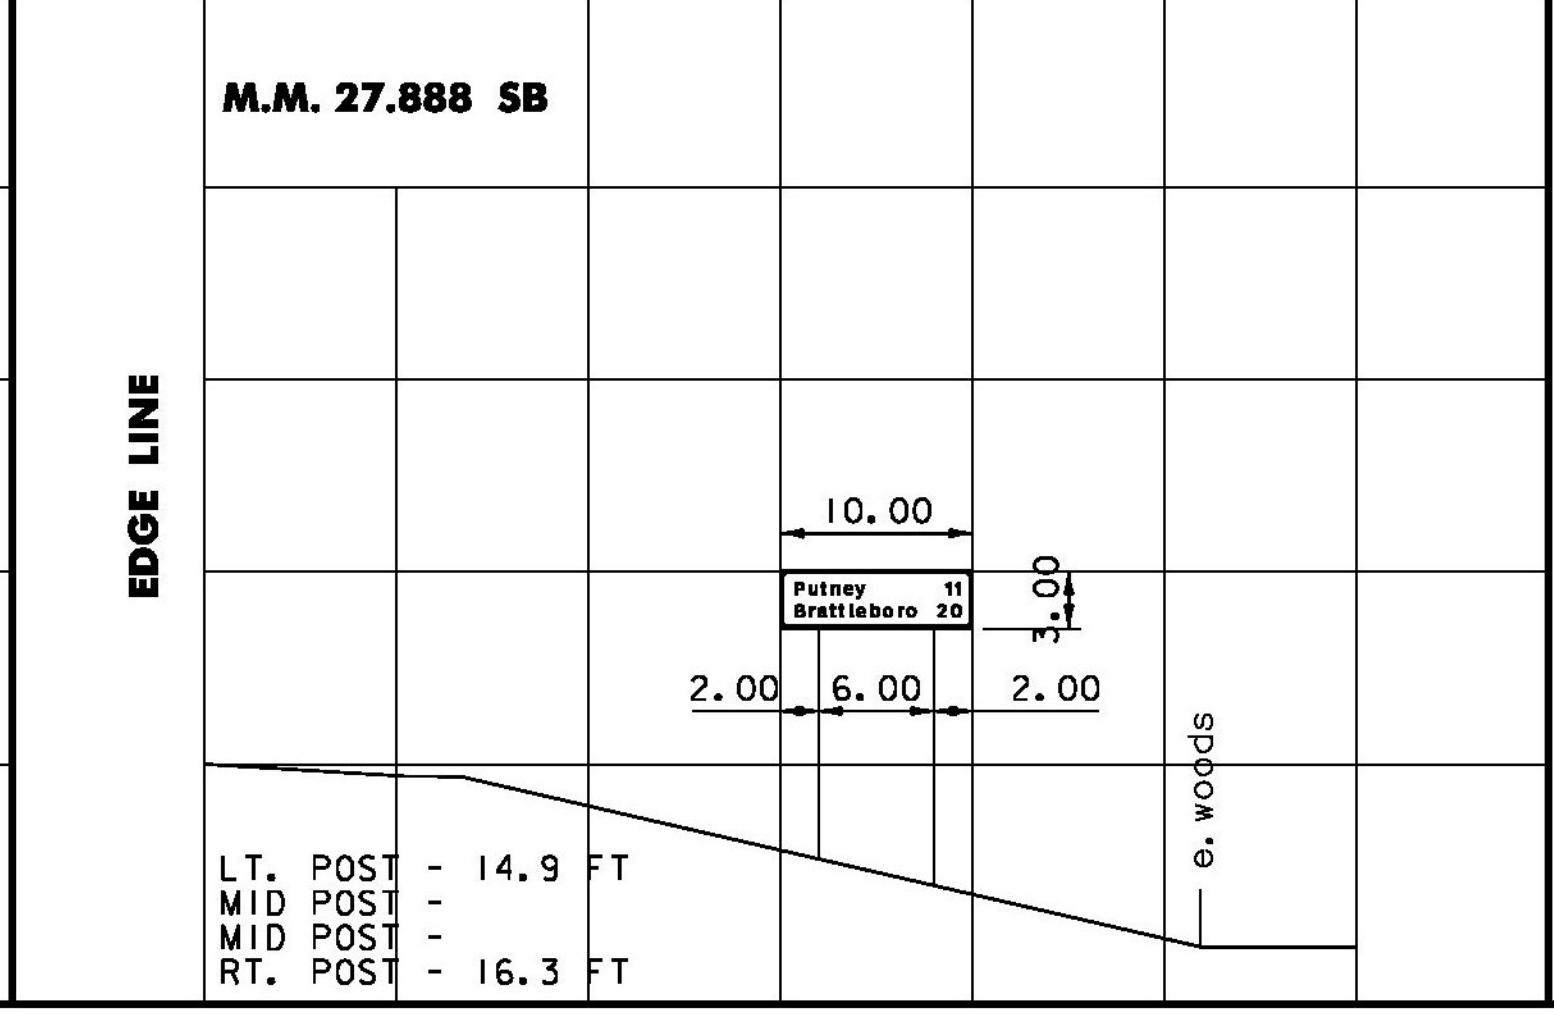
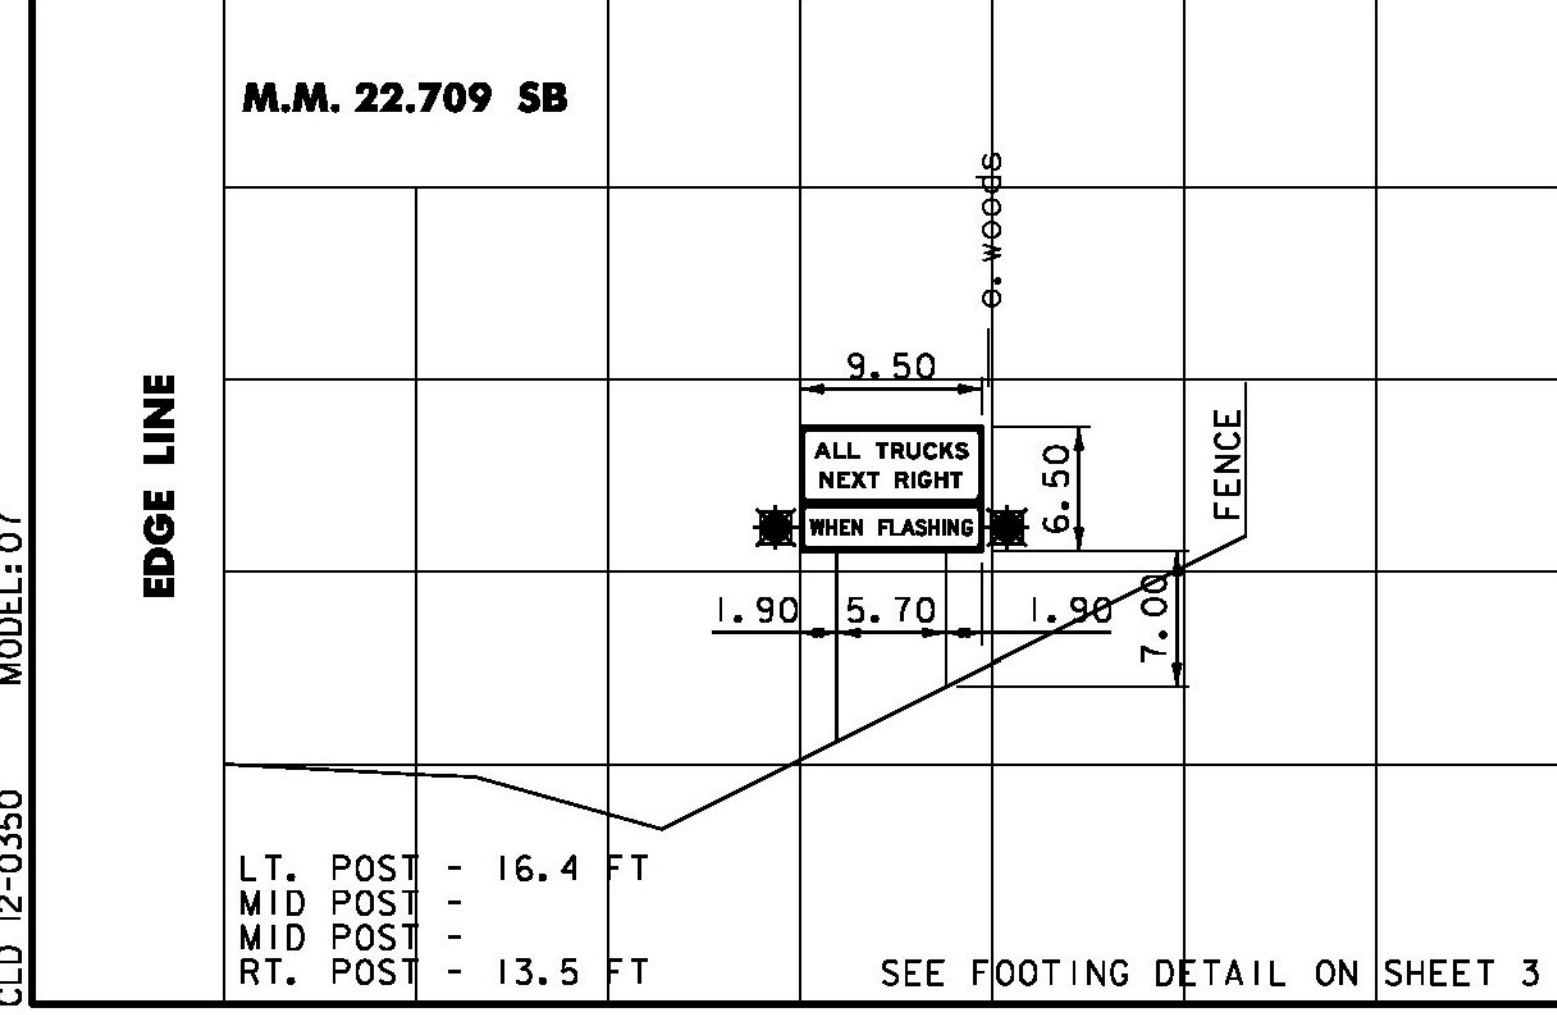
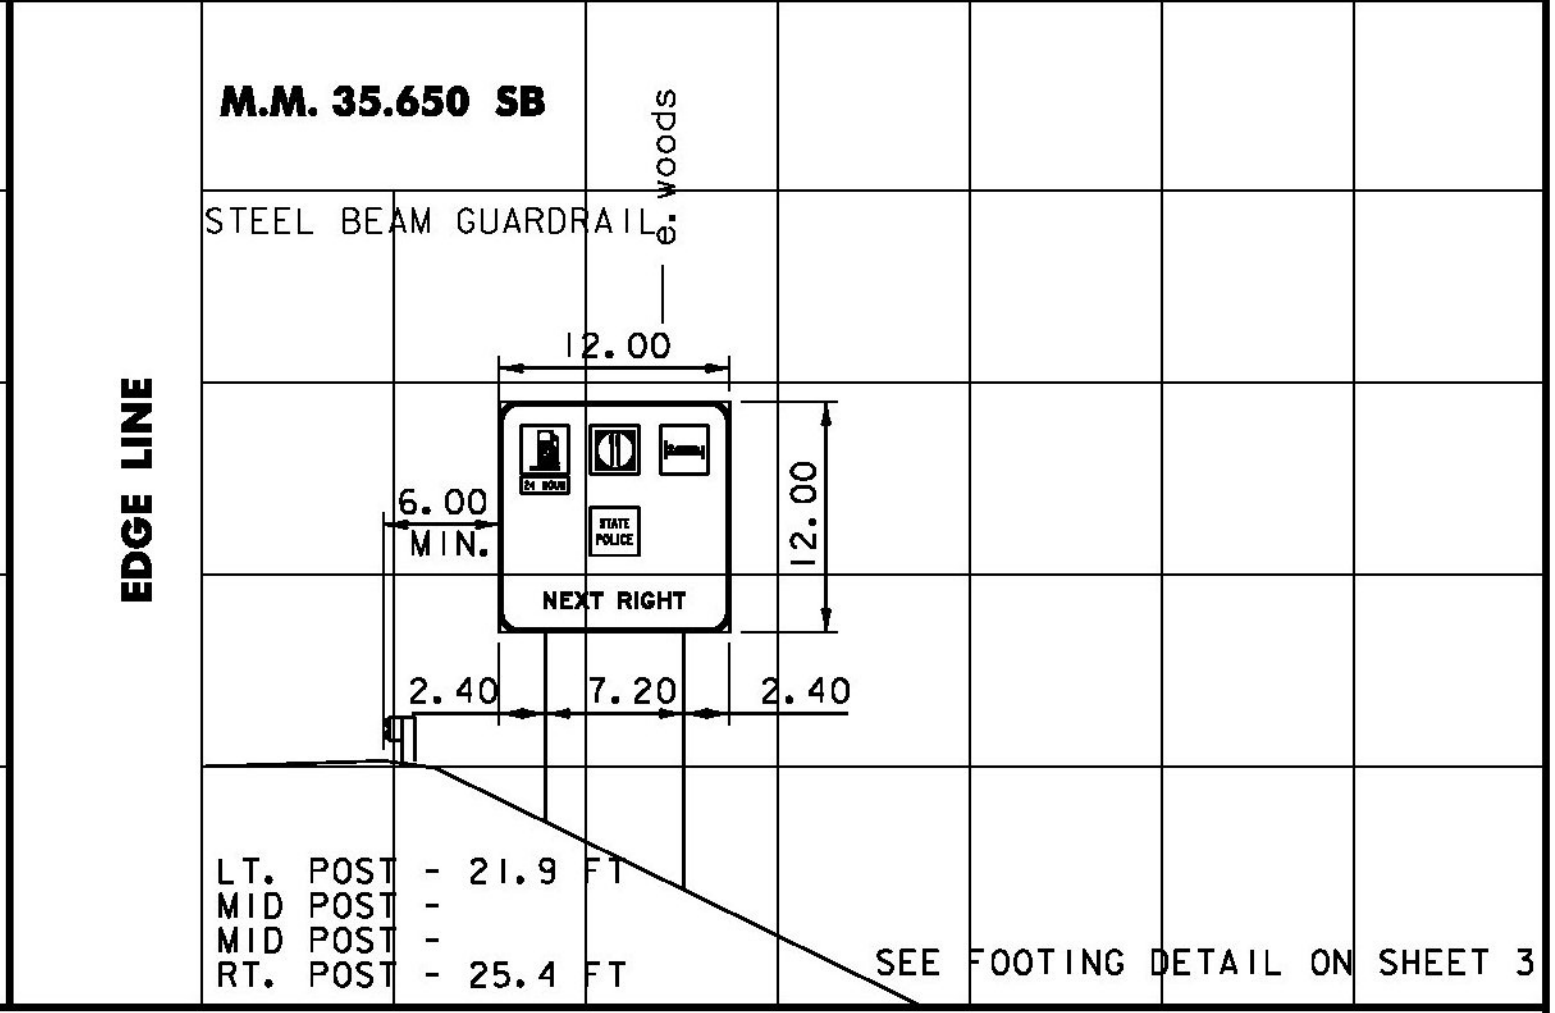
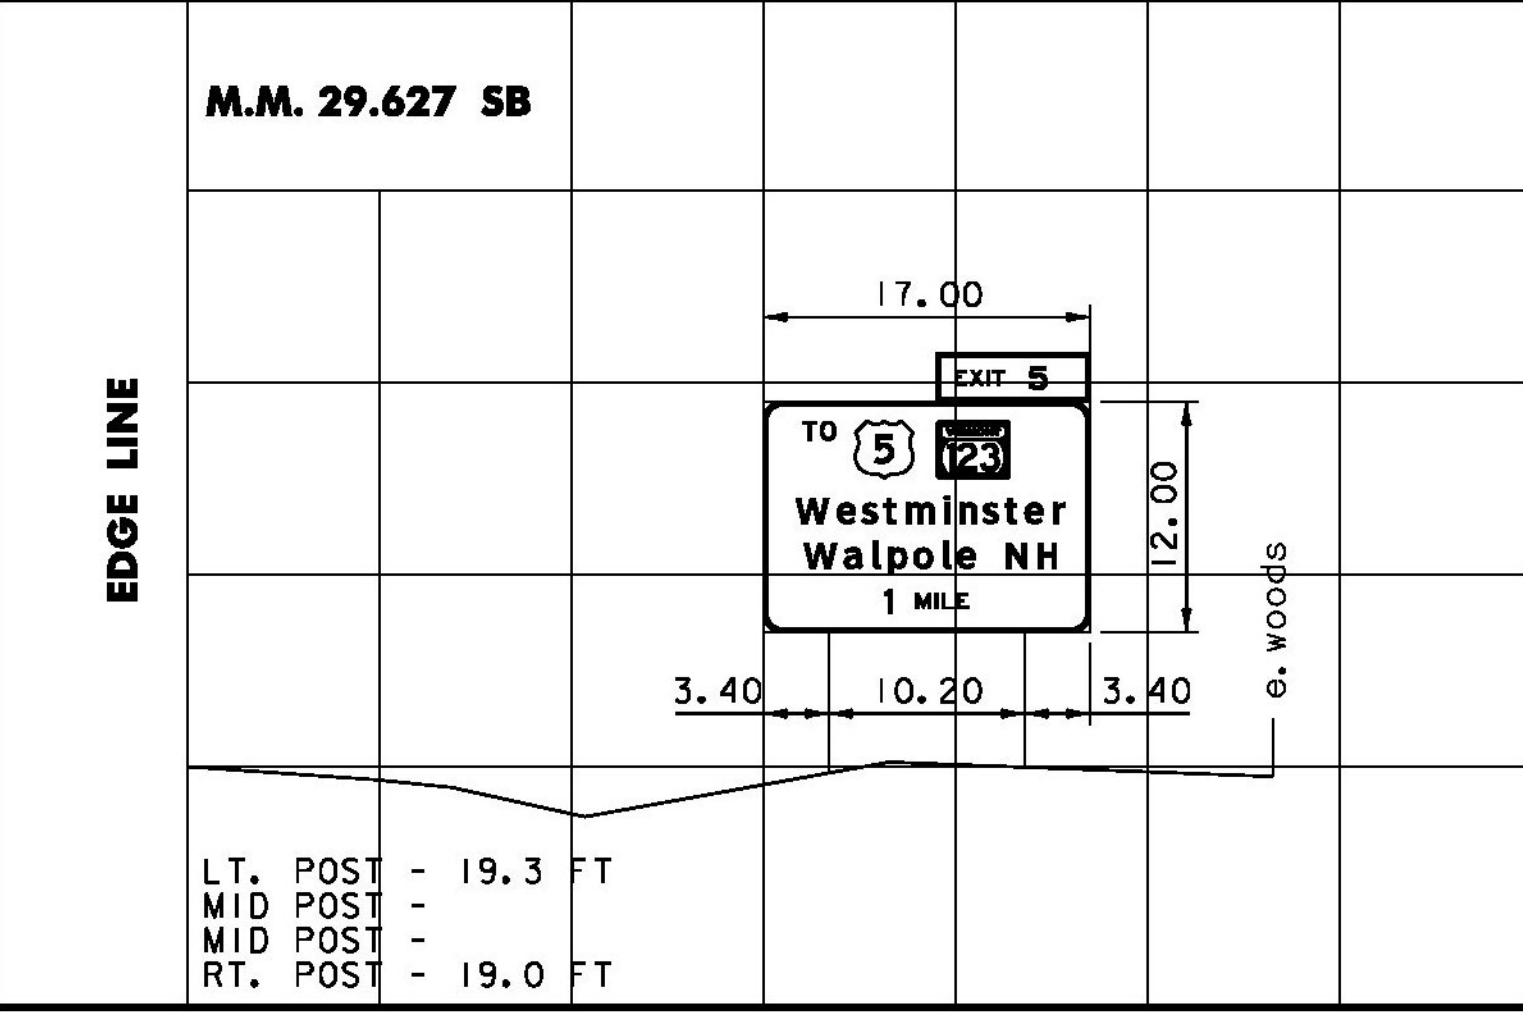
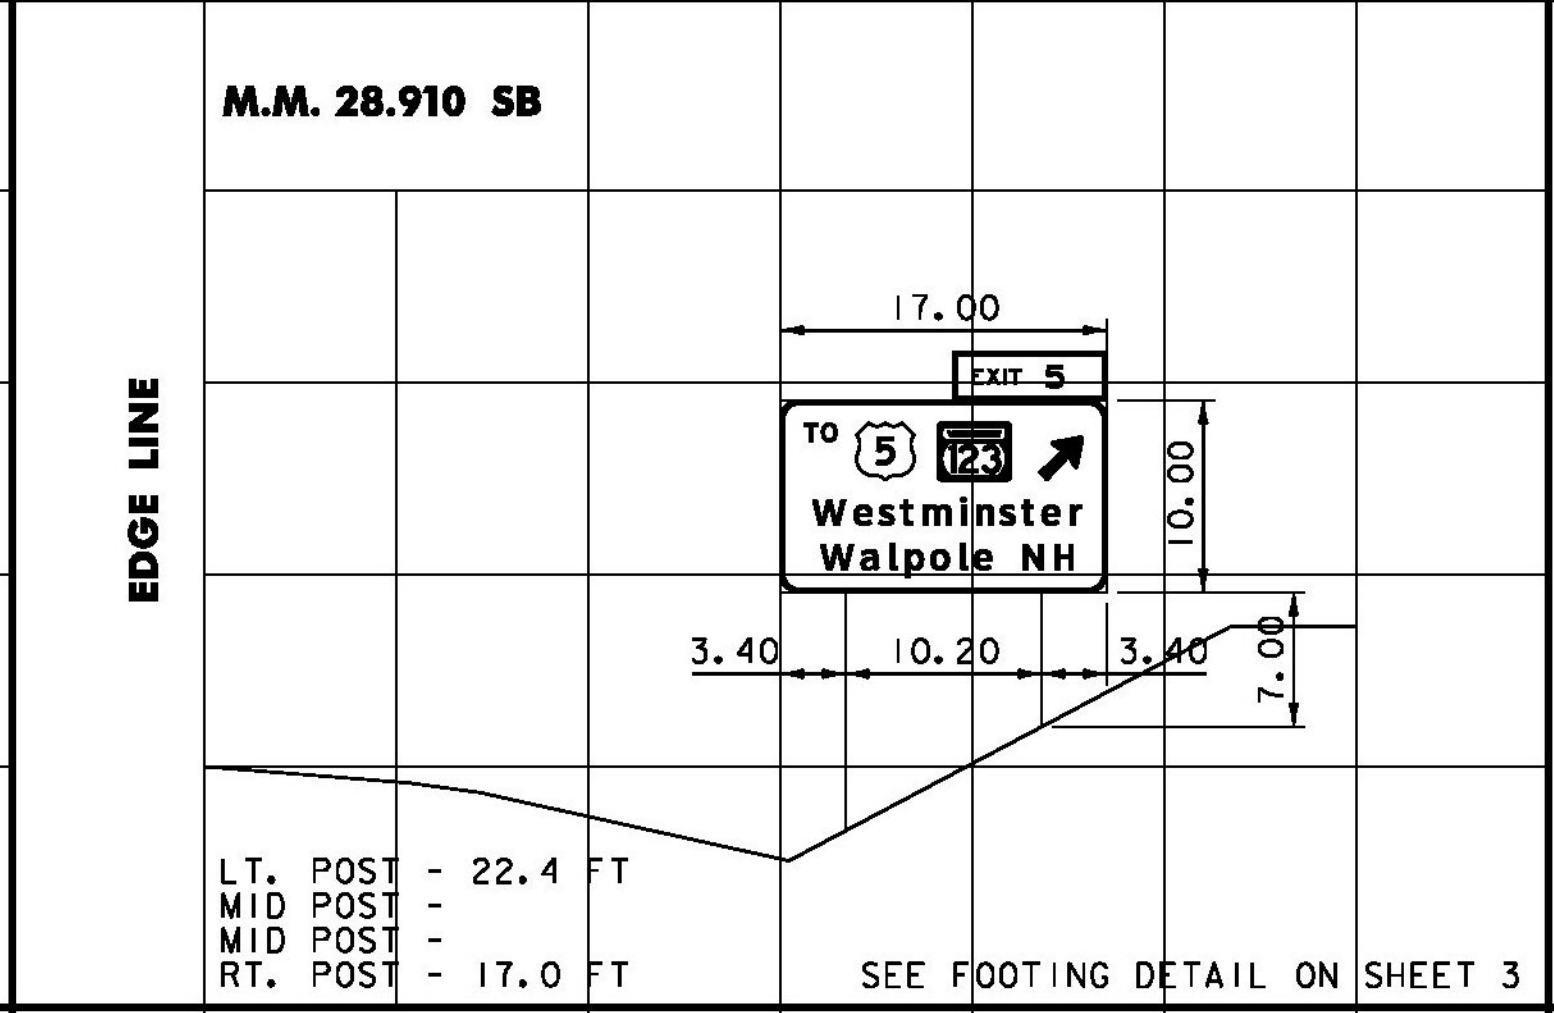
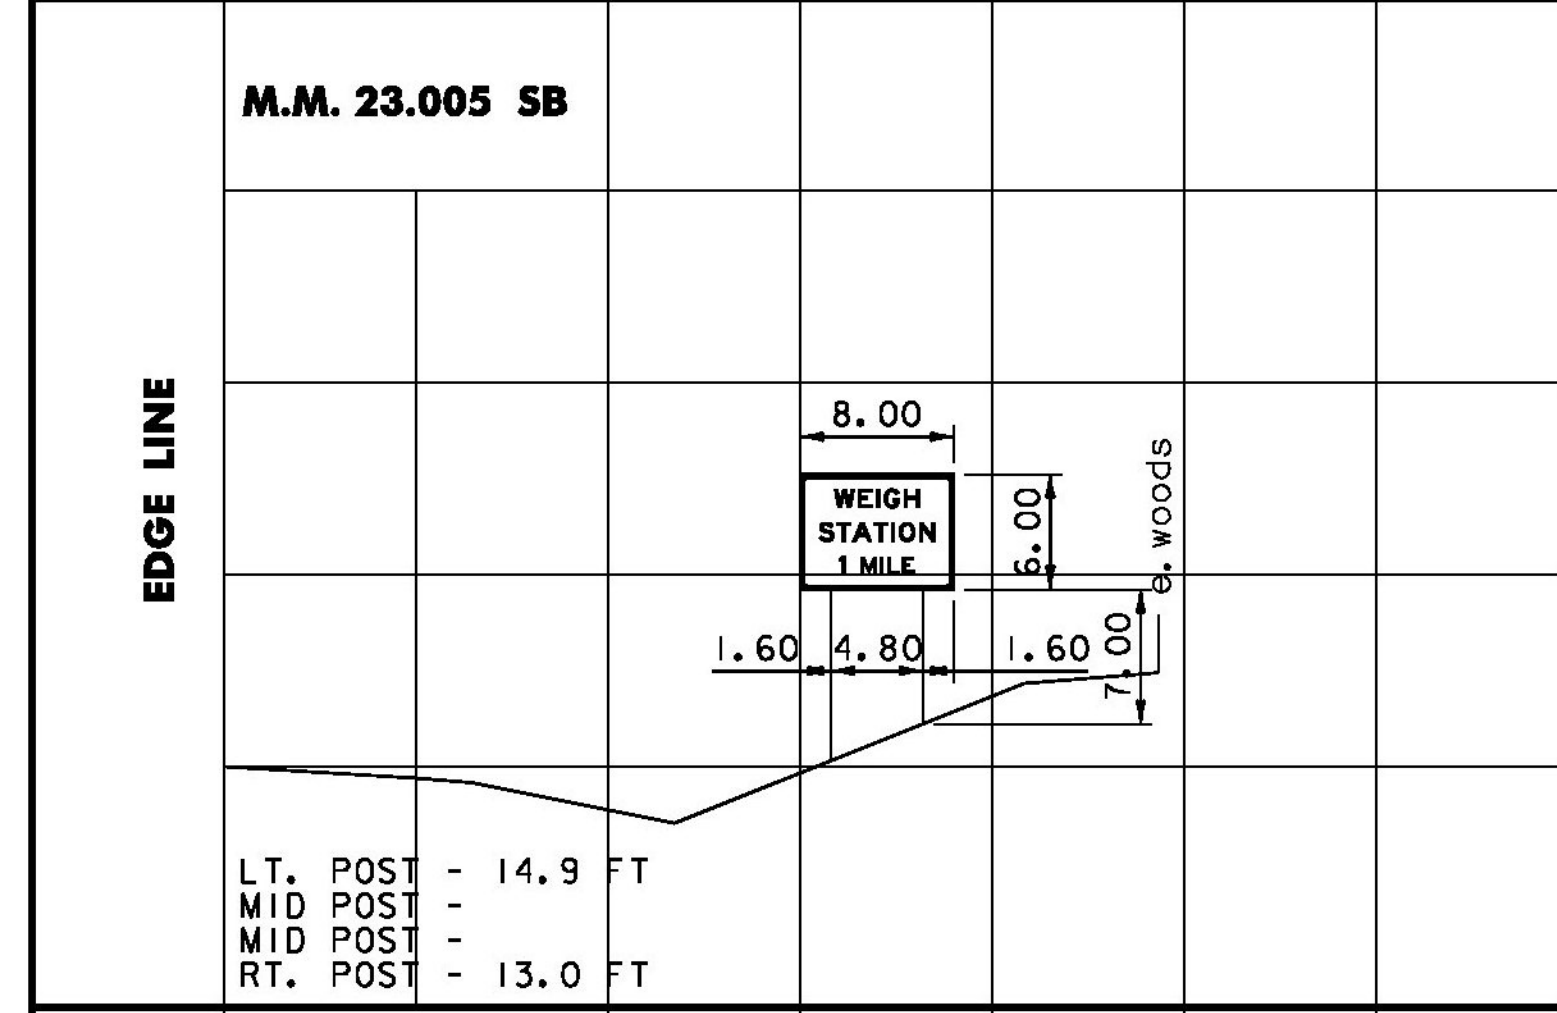
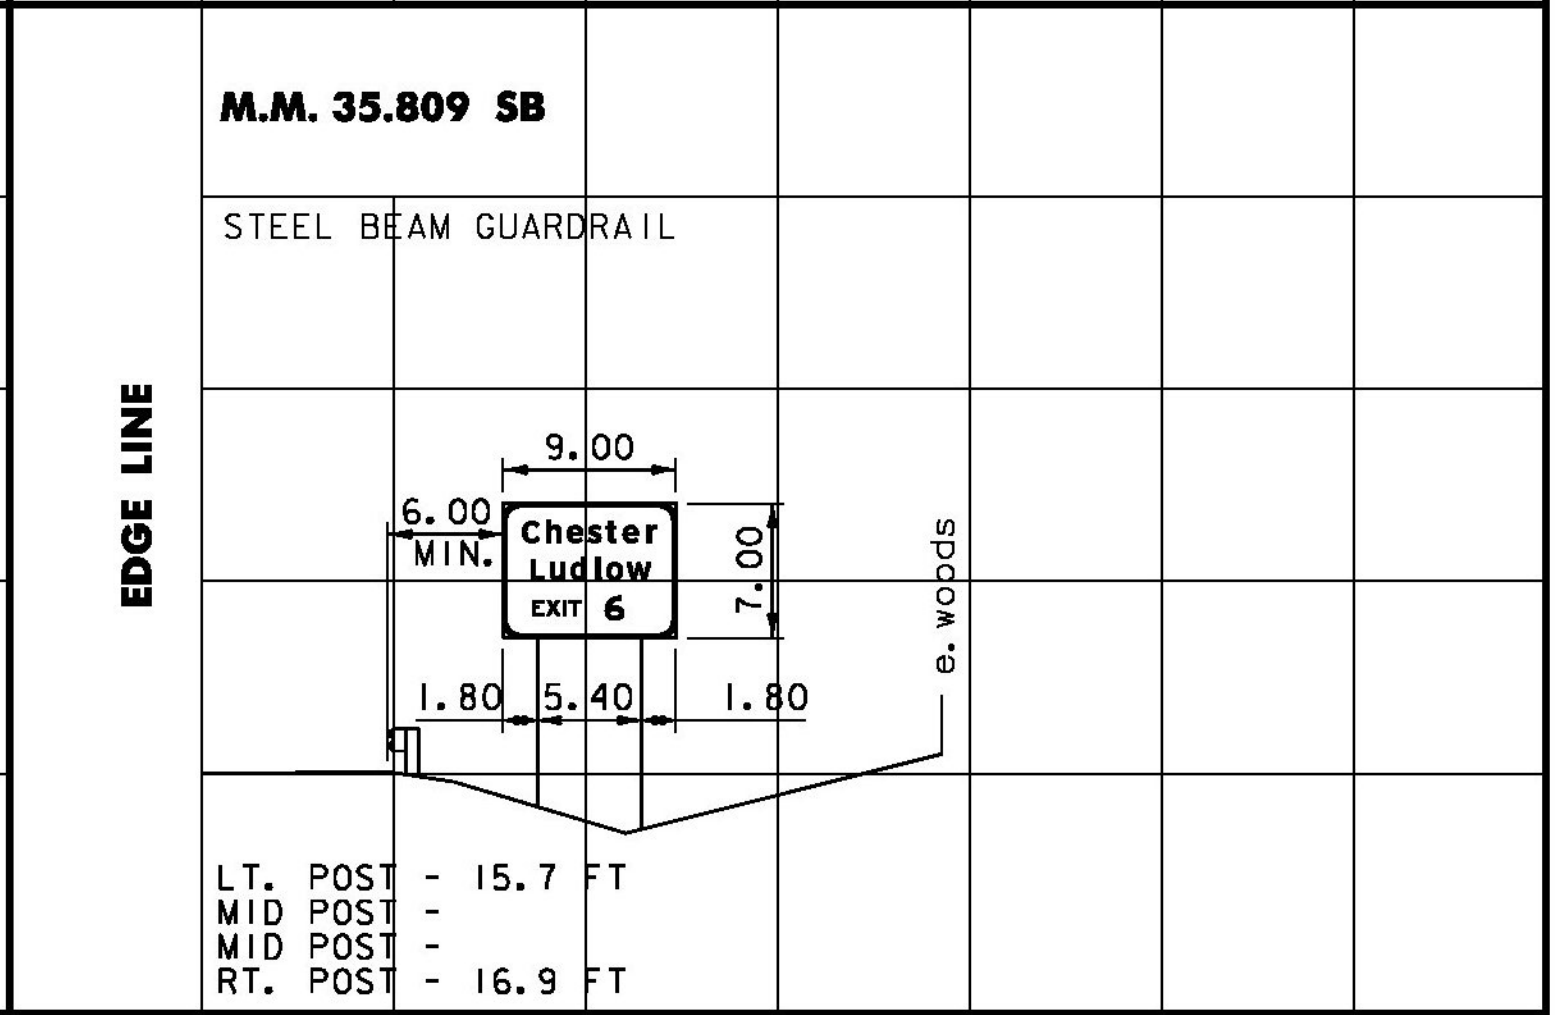
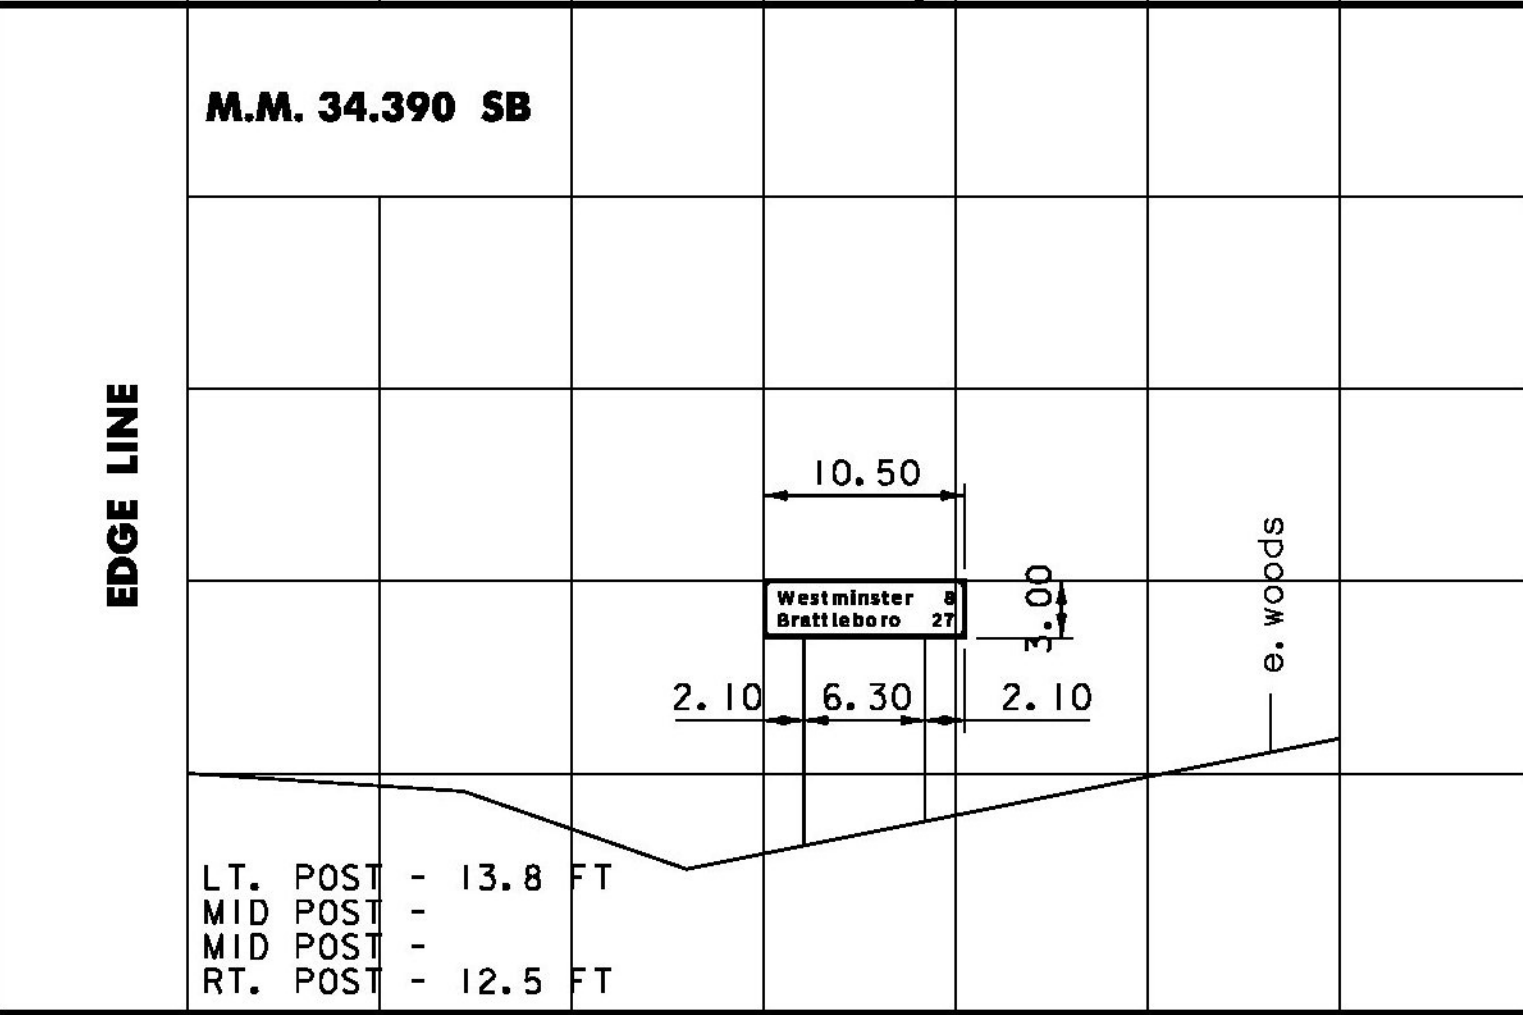
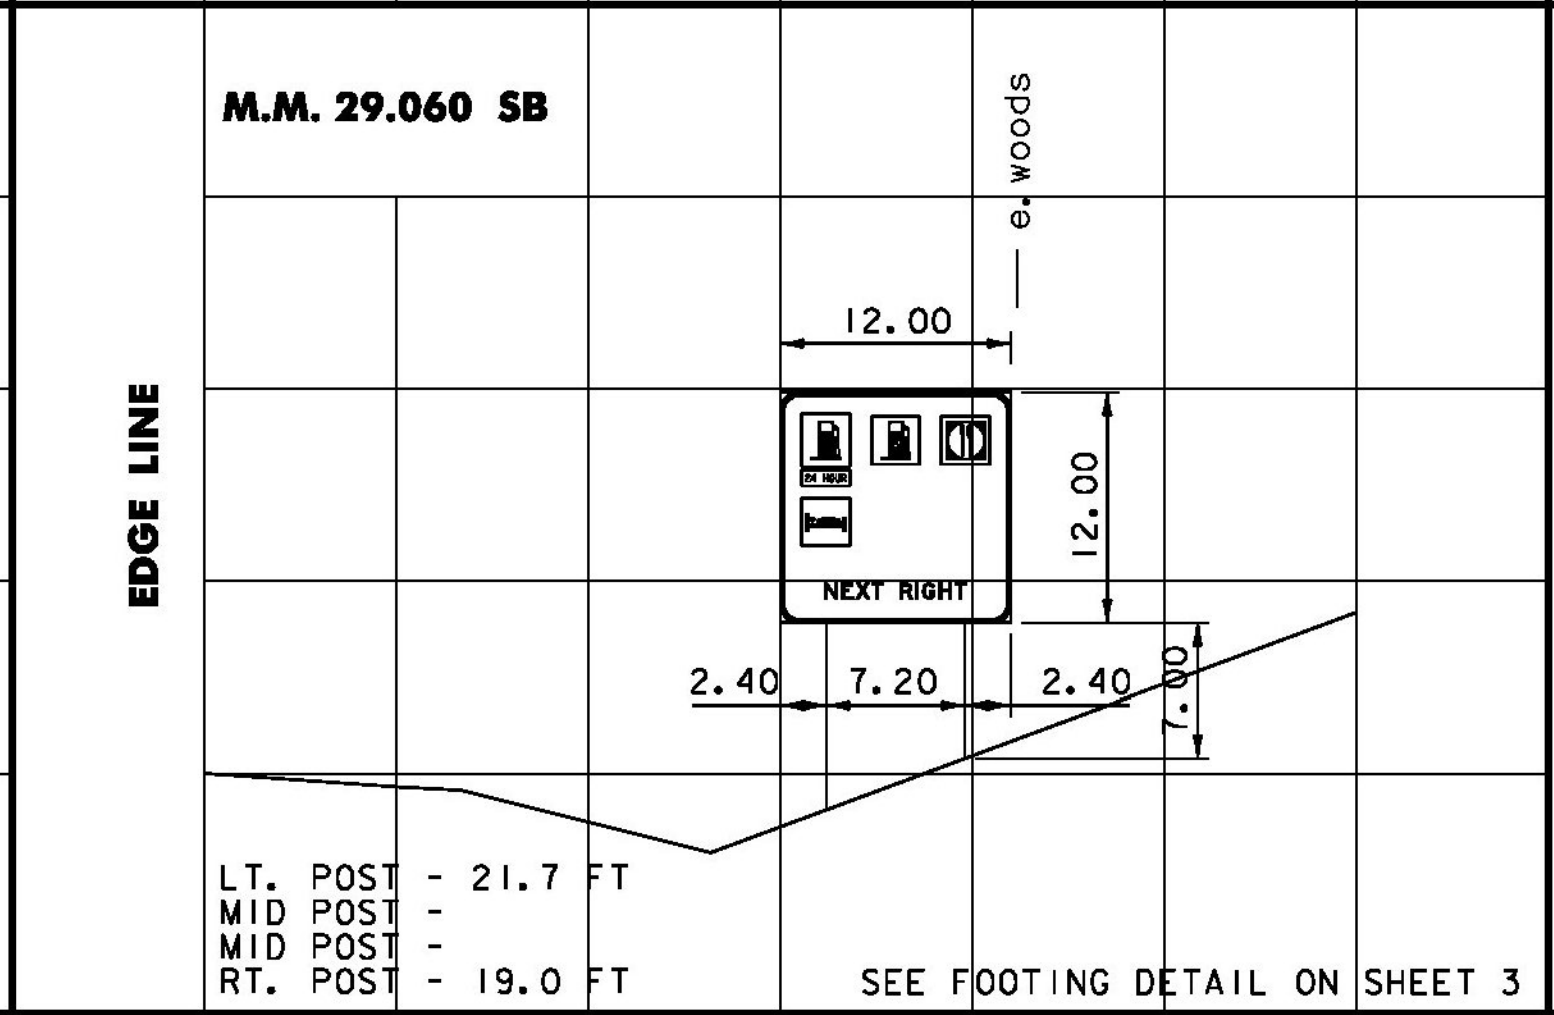
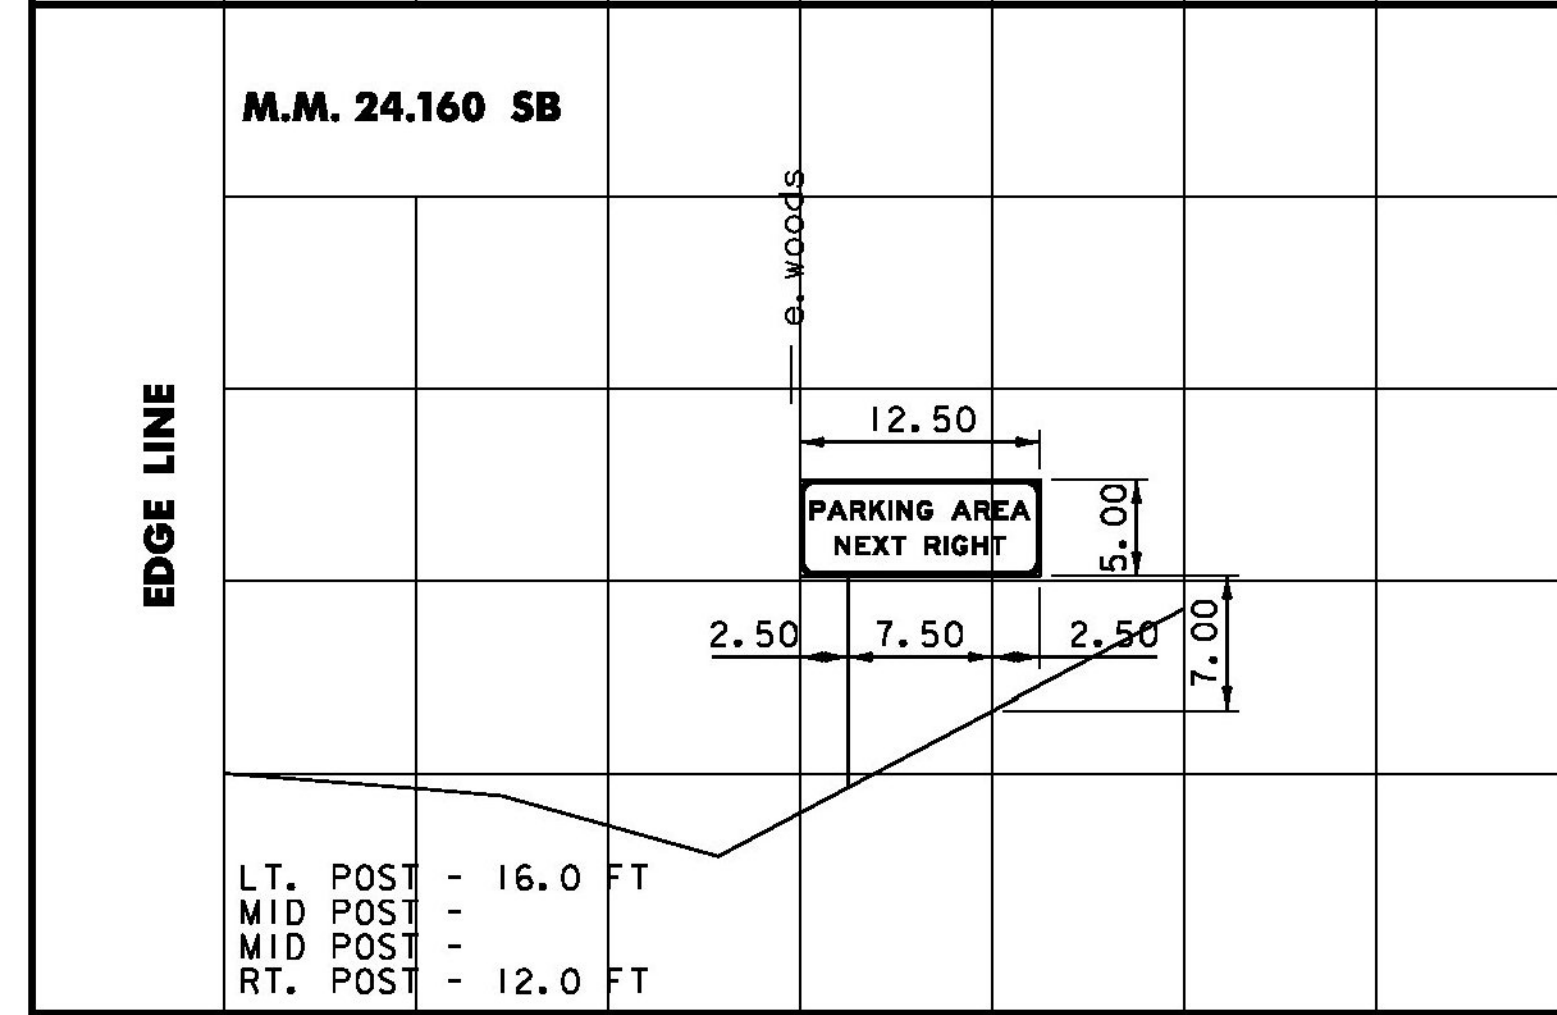
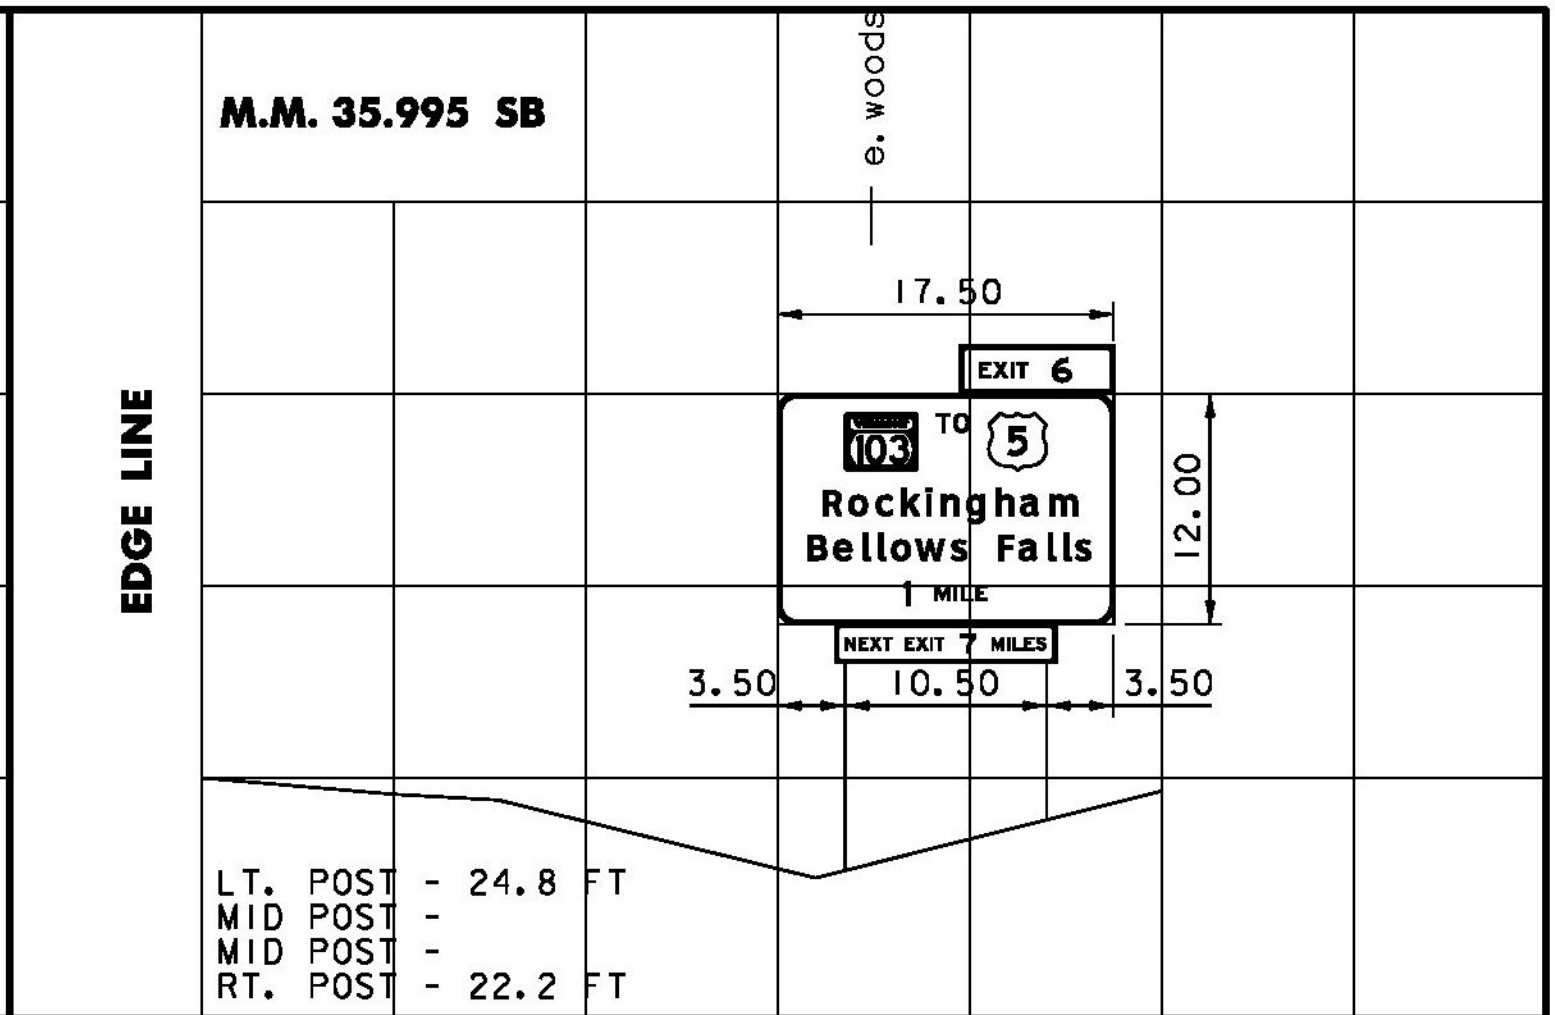
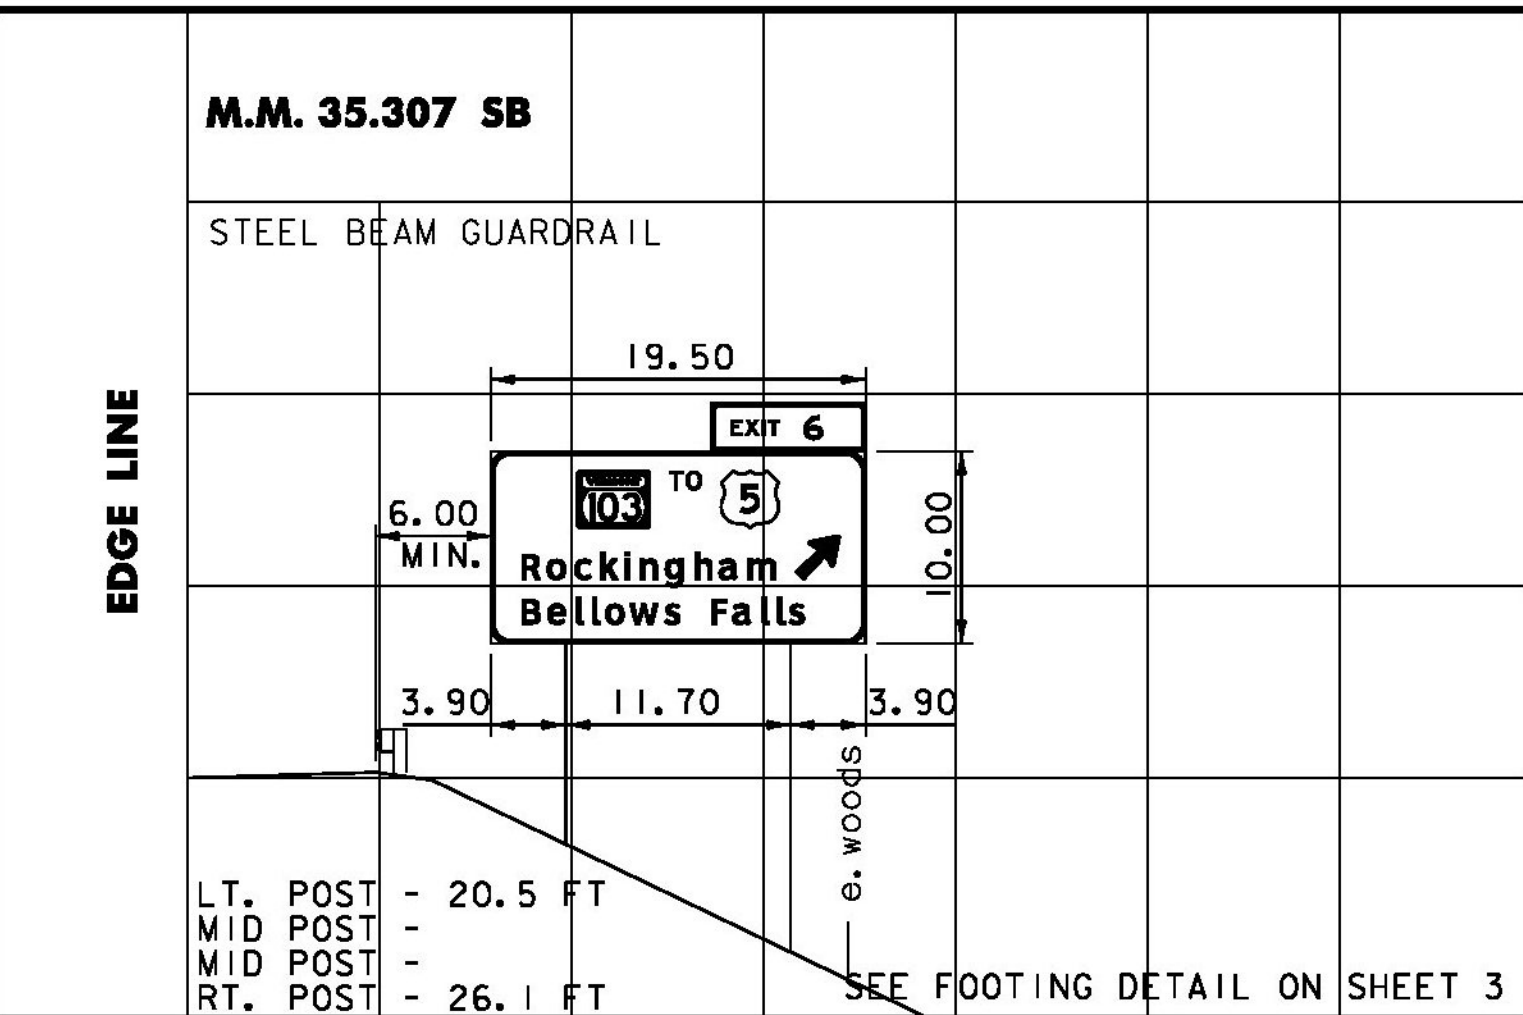
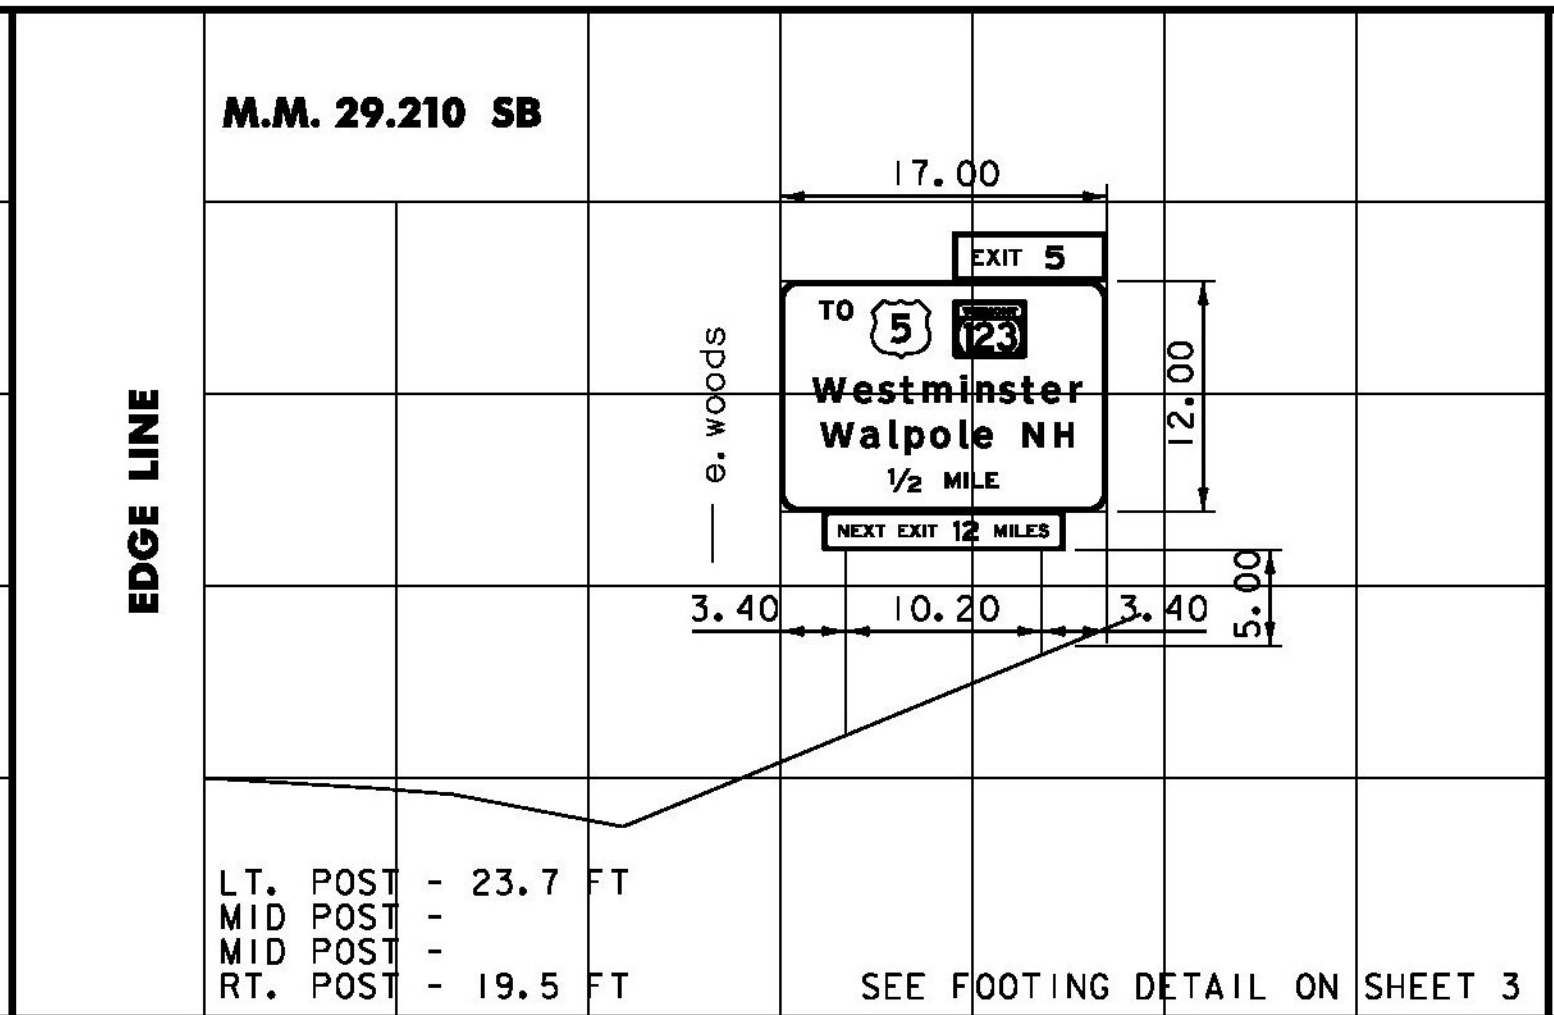


CLD 12-0350 MODEL: 07

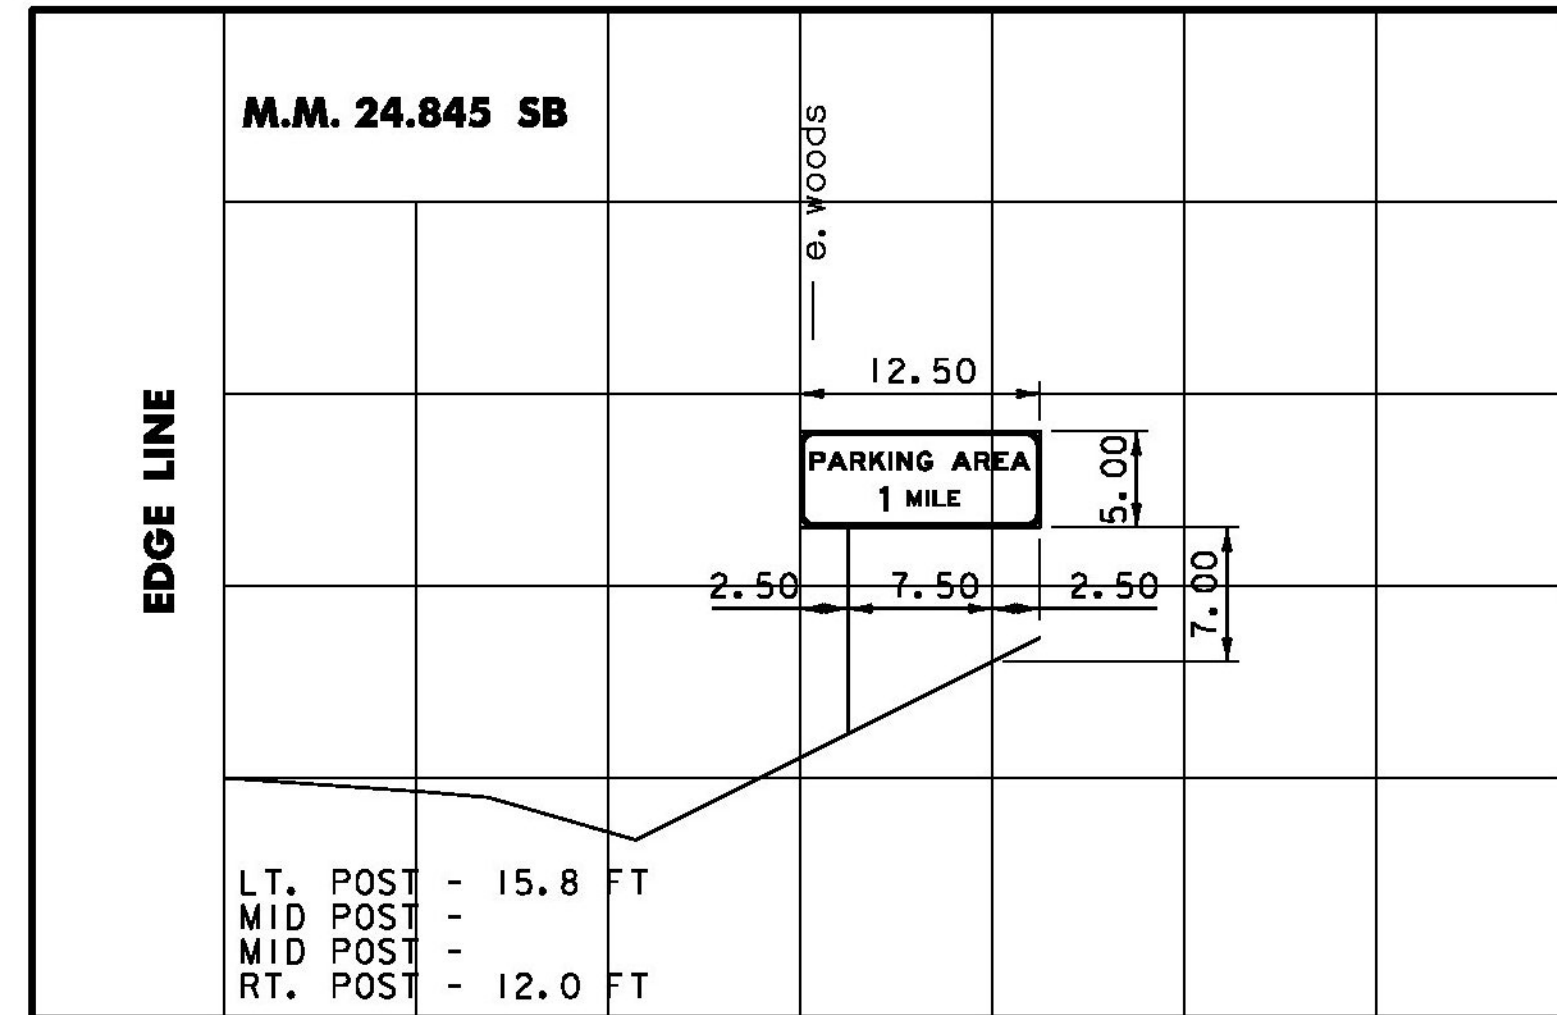

DIMENSIONS FOR CRITICAL OFFSETS OR CLEARANCES SHOWN FOR CONVENIENCE, REFER TO STANDARD SHEET E-120 FOR PLACEMENT GUIDELINES.

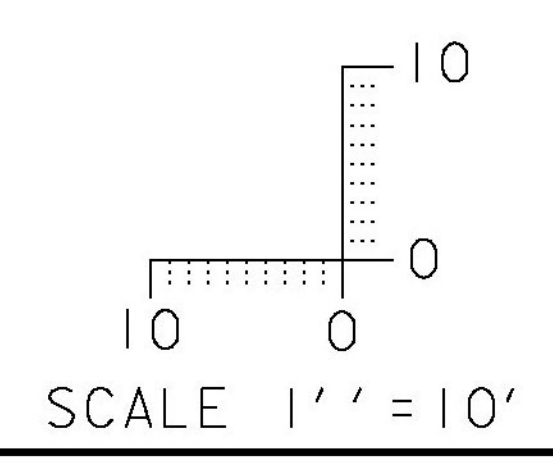

PROJECT NAME: GUILFORD-ROCKINGHAM
PROJECT NUMBER: IMG SIGN(44)

FILE NAME: z12A528xs.dgn
PROJECT LEADER: C. GREGORY
DESIGNED BY: J. SMITH
CROSS SECTION SHEET 7

PLOT DATE: 4/17/2014
DRAWN BY: S. GOODWIN
CHECKED BY: D. MUNRO
SHEET 157 OF 157