

189 SB ST. ALBANS - SWANTON

VT 105 TROY - NEWPORT

189 NB & SB COLCHESTER

VT 15 COLCHESTER - ESSEX

189 NB SO. BURLINGTON - COLCHESTER

191NB & SB DERBY

189 NB RICHMOND - SO. BURLINGTON

US 302 GROTON - RYEGATE

US 302 RYEGATE-NEWBURY (CO #001)

US 302 BARRE TOWN

VT 25 TOPSHAM - ORANGE

NORWICH STATE HIGHWAY


US 5 HARTFORD

VT 30 CASTLETON - SUDBURY

191NB SPRINGFIELD

US 7 MANCHESTER - DORSET

191NB & SB GUILFORD - BRATTLEBORO  
& GUILFORD WELCOME CENTER NOT DONE W.O. #001

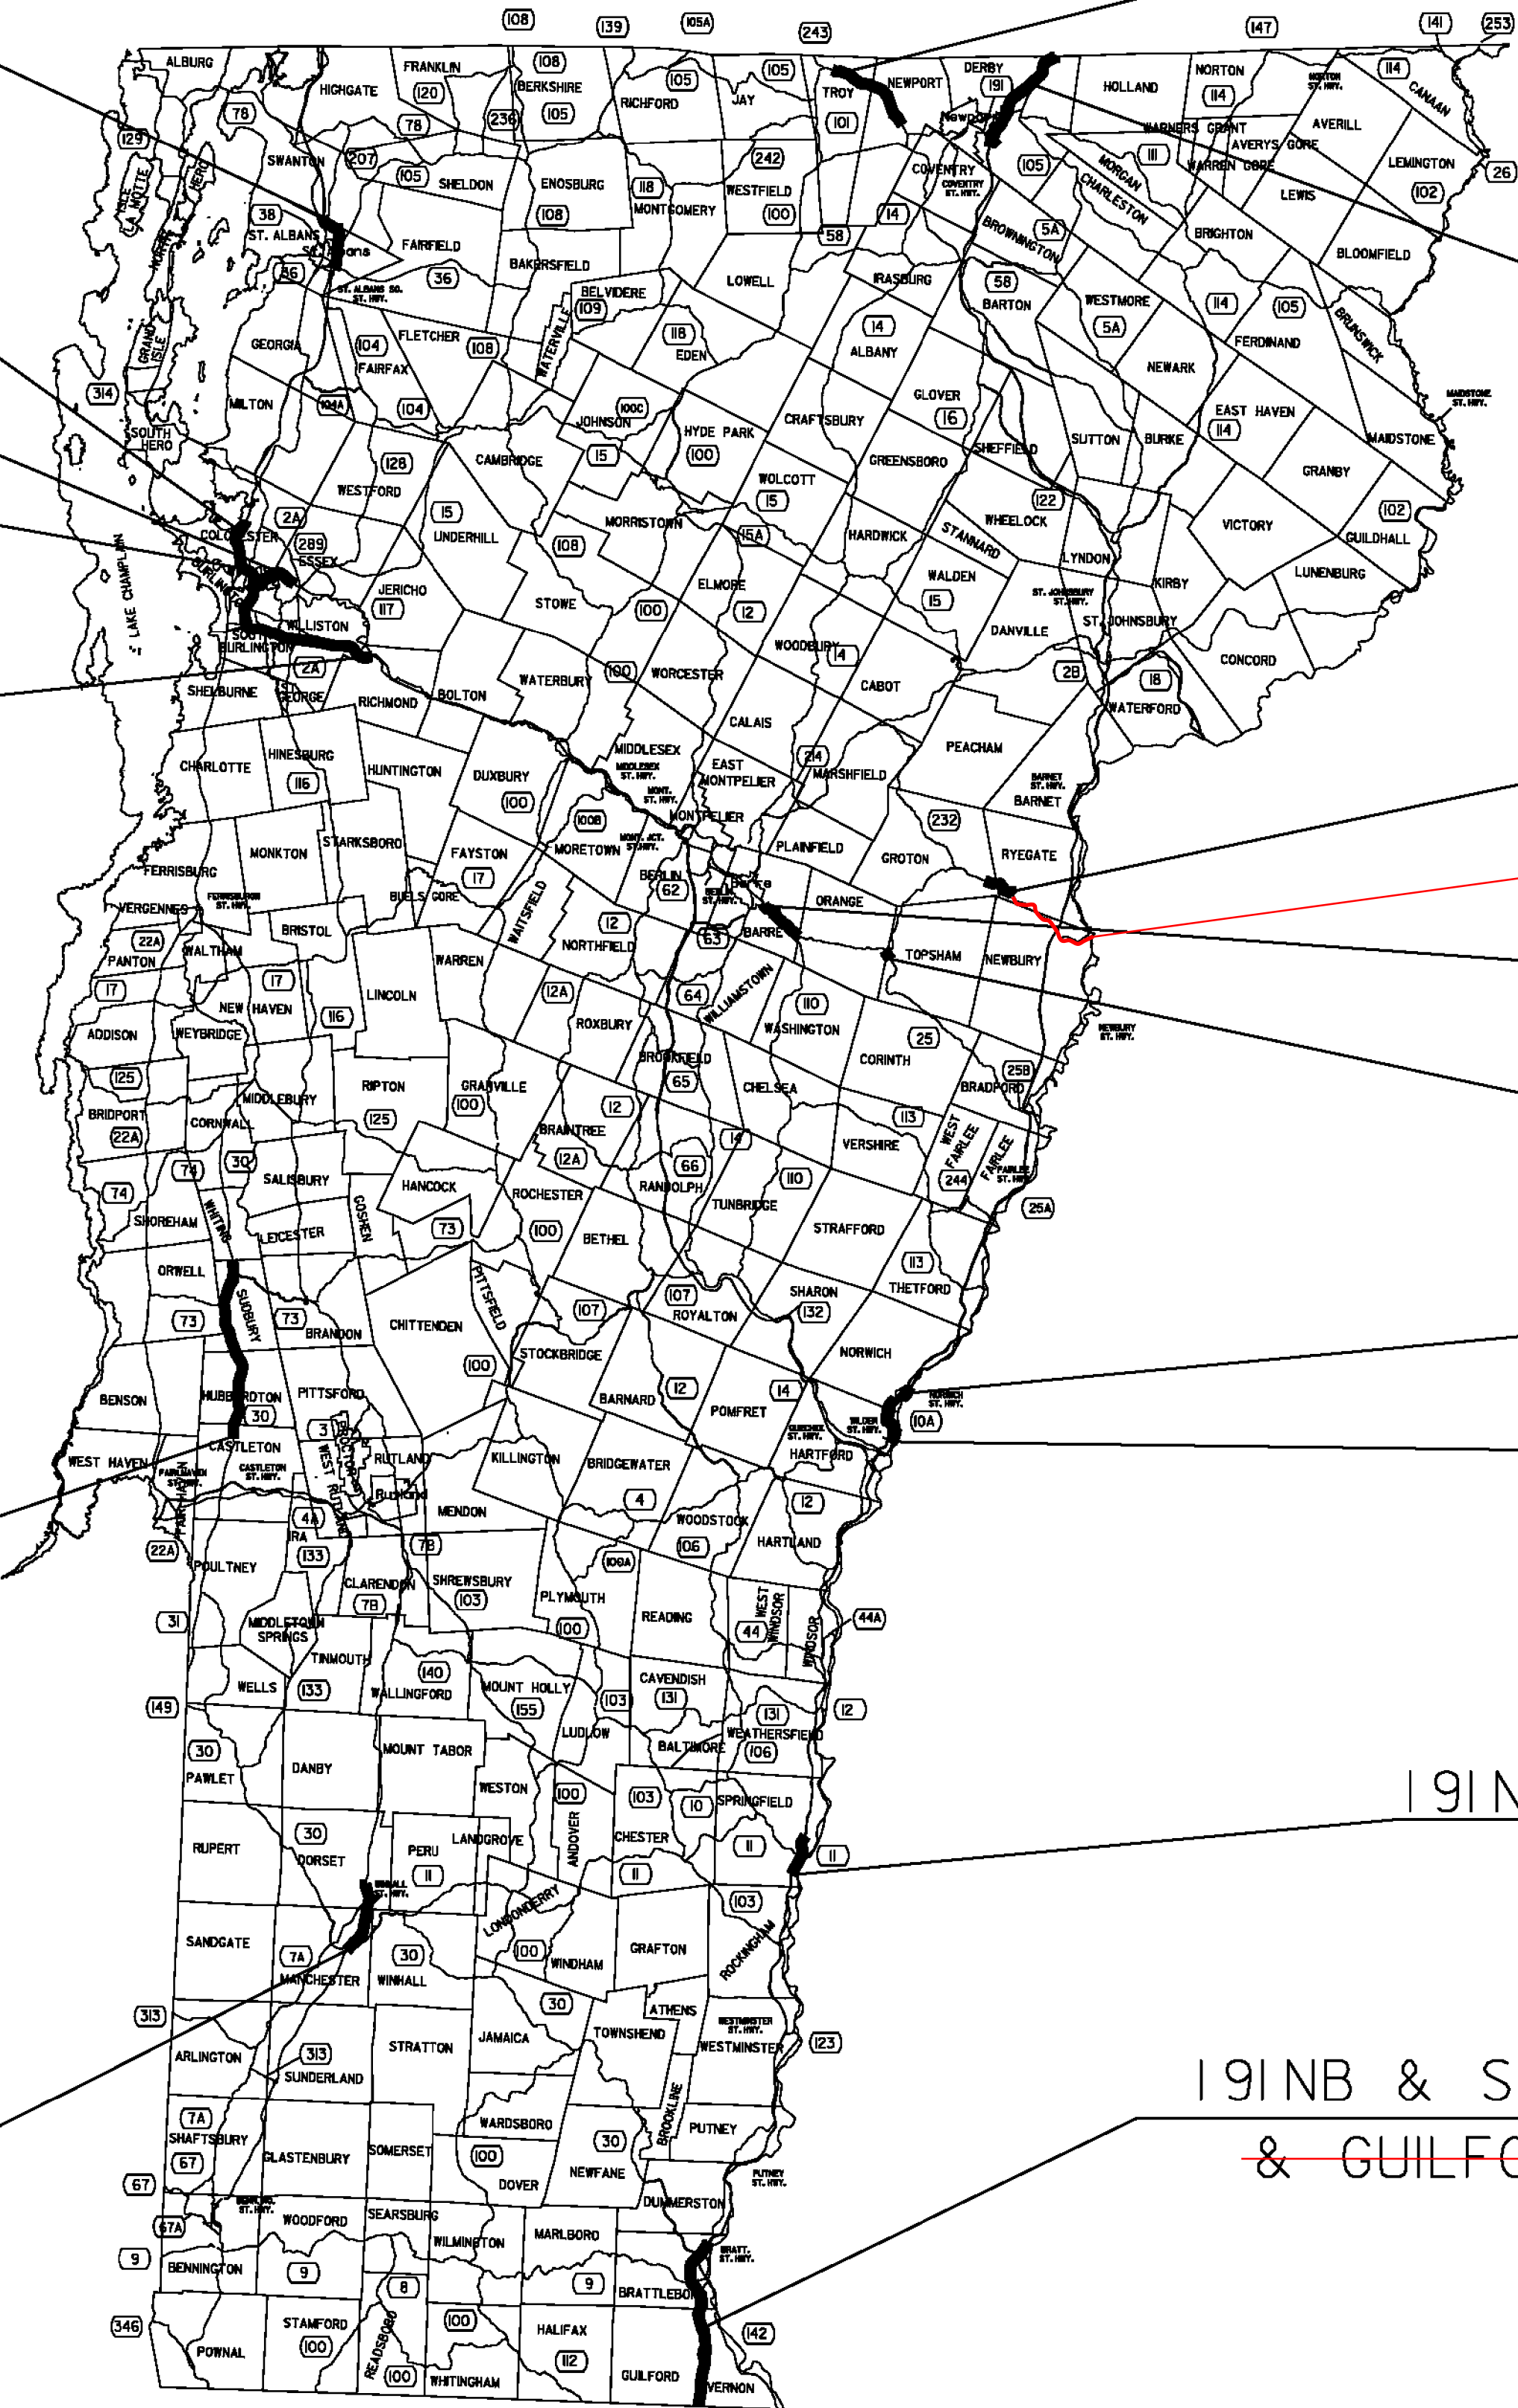

RCD  
10-31-2012

|                    |                              |                        |
|--------------------|------------------------------|------------------------|
| LOCATION<br>LAYOUT | PROJECT NAME: STATEWIDE      |                        |
|                    | PROJECT NUMBER: STP CRAK(30) |                        |
|                    | FILE NAME: p12k010.dgn       | PLOT DATE: 12-APR-2012 |
|                    | PROJECT LEADER: FOWLER       | DRAWN BY: LOCKE        |
|                    | DESIGNED BY: LOCKE           | CHECKED BY: PAVT MGMT  |
|                    | p12K010101.I                 | SHEET 4 OF 18          |