




BURLINGTON INTERCHANGE #14
I-89

NOT TO SCALE

RAMPS REQUIRING CRACK SEALING

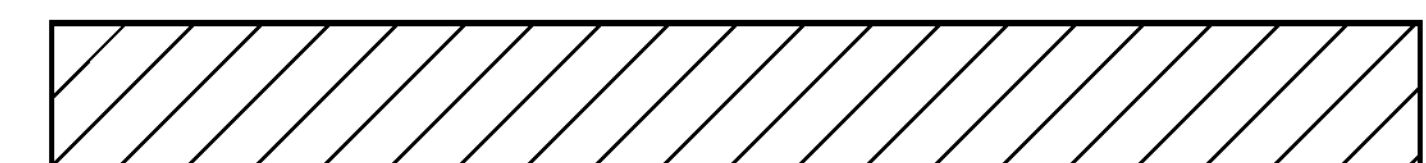

**INTERCHANGE
DETAIL
SHEET # 3**

PROJECT NAME: STATEWIDE
PROJECT NUMBER: STP CRAK(30)

FILE NAME: pl2k010.dgn
PROJECT LEADER: FOWLER
DESIGNED BY: LOCKE
pl2k010Int3.1

PLOT DATE: 12-APR-2012
DRAWN BY: LOCKE
CHECKED BY: PAVT MGMT
SHEET 8 OF 18