




COLCHESTER INTERCHANGE #17
I-89

RAMPS REQUIRING CRACK SEALING

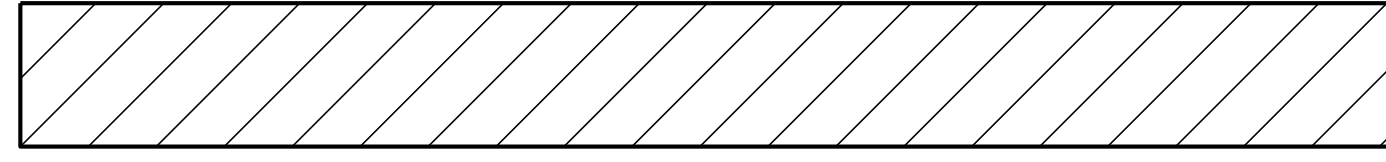

NOT TO SCALE

INTERCHANGE DETAIL SHEET # 3	PROJECT NAME: STATEWIDE	PLOT DATE: 28-FEB-2014 17:34
	PROJECT NUMBER: STP CRAK(31)	DRAWN BY: LOCKE
	FILE NAME: p12k558.dgn	CHECKED BY: HARRINGTON
	DESIGNED BY: LOCKE	SHEET 9 OF 14
	p12k558in+3.i	