


GEORGIA INTERCHANGE #18
I-89

RAMPS REQUIRING CRACK SEALING

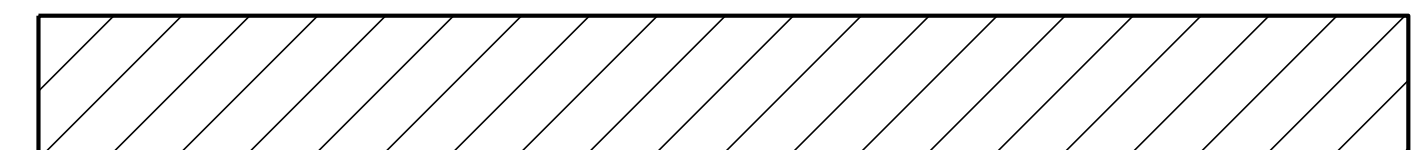

NOT TO SCALE

INTERCHANGE
DETAIL
SHEET # 4

PROJECT NAME: STATEWIDE
 PROJECT NUMBER: STP CRAK(3I)

FILE NAME: pi2k558.dgn
 PROJECT LEADER: FOWLER
 DESIGNED BY: LOCKE
 pi2k558int4.i

PLOT DATE: 28-FEB-2014 17:38
 DRAWN BY: LOCKE
 CHECKED BY: HARRINGTON
 SHEET 10 OF 14