


STATE OF VERMONT AGENCY OF TRANSPORTATION



PROPOSED IMPROVEMENT BRIDGE PROJECT WINDSOR-HARTFORD COUNTY OF WINDSOR ELEVEN BRIDGES ON I-91

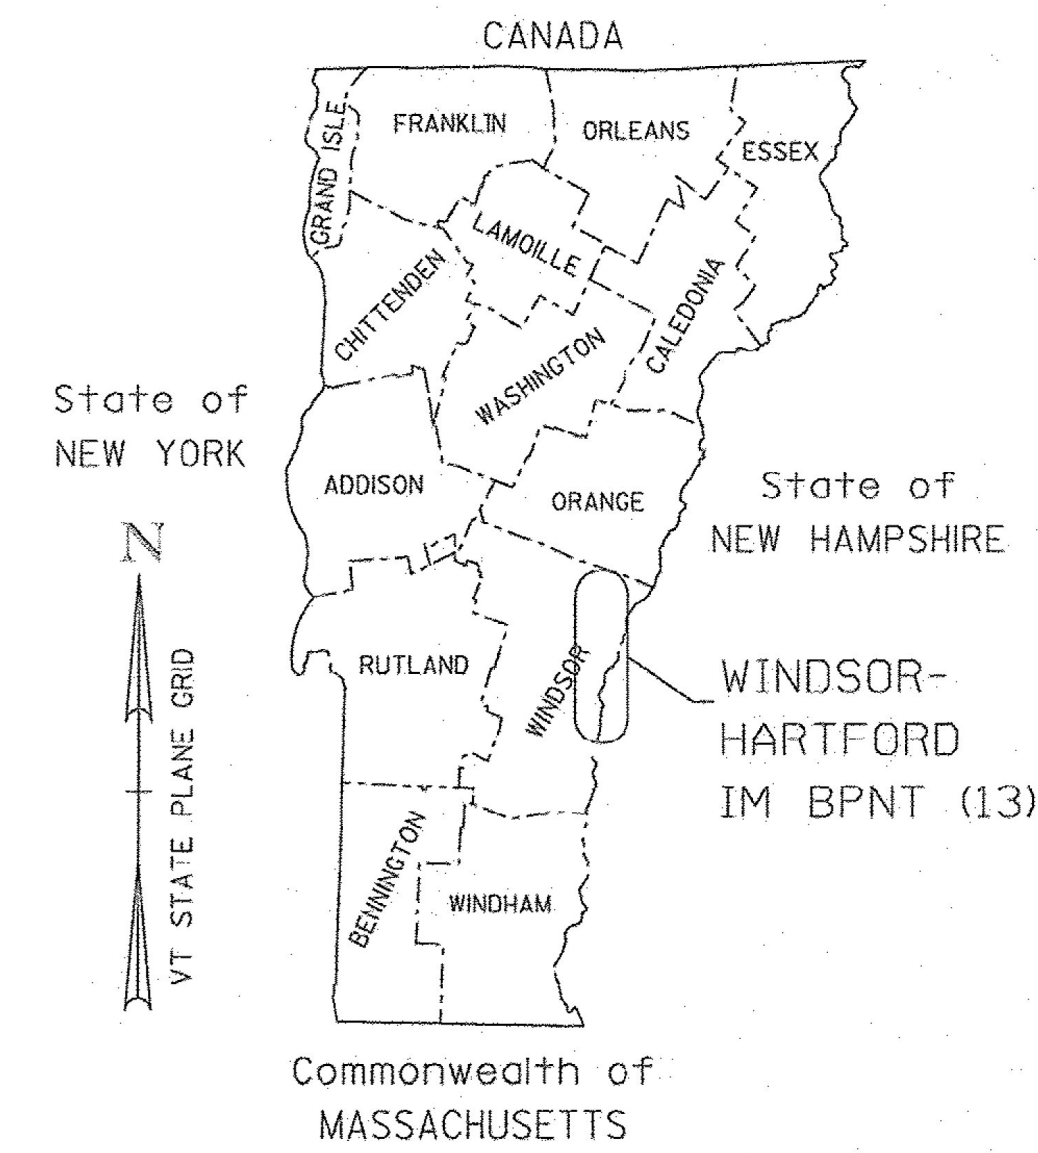

LOCATION MAP
NOT TO SCALE

INDEX OF SHEETS

1	TITLE SHEET
2	PROJECT NOTES
3-4	PROJECT STANDARD DETAILS
5-8	QUANTITY SHEETS
9-15	TRAFFIC CONTROL SHEETS
16-17	REFERENCE SHEETS BRIDGES 34N&S
18-21	REFERENCE SHEETS BRIDGES 41N&S
22-23	REFERENCE SHEETS BRIDGE 41C
24-26	REFERENCE SHEETS BRIDGES 42N&S
27-34	REFERENCE SHEETS BRIDGES 44N&S
35-36	REFERENCE SHEETS BRIDGES 45N&S

STANDARD SHEETS

T-1	08-06-2012
T-10	08-06-2012
T-11	08-06-2012
T-12	08-06-2012
T-13	08-06-2012

Record Plans

Contractor: **MONOKO, LLC**
Resident Engineer: **PAUL PERRY**
Construction Began: **AUGUST, 2, 2016**
Construction Complete: **OCTOBER 27, 2017**
Record Plans By: **PAUL PERRY & JESSE IVES**

I hereby certify that all construction required by this set of drawings has been accomplished as indicated herein.


BY: E-SIGNED by Paul Perry on 2019-02-04 16:46:50 UTC Resident Engineer

Date: February 04, 2019


NOTE: Any further information concerning final quantities, amounts or other details relative to this project may be found at Central Files in the electronic archives.

PROJECT LOCATION: WINDSOR BRIDGES 34N AND 34S (I-91 BRIDGE OVER TH NO 5)(MM 57.40), HARTFORD BRIDGES 41N AND 41S (I-91 BRIDGE OVER RAMP C I-91)(MM 69.68), HARTFORD BRIDGE 41C (I-91 RAMP C OVER I-89)(MM 69.51), HARTFORD BRIDGES 42N AND 42S (I-91 OVER I-89)(MM 69.81), HARTFORD BRIDGES 44N AND 44S (I-91 OVER US 4, VT 14, NECR, WHITE RIVER)(MM 70.94), HARTFORD BRIDGES 45N AND 45S (I-91 OVER WILDER SH)(MM 72.01).

PROJECT DESCRIPTION: THIS PROJECT INVOLVES CLEANING, LEAD PAINT REMOVAL AND REPAINTING THE EXISTING STEEL SUPERSTRUCTURE MEMBERS AND ASSOCIATED WORK.

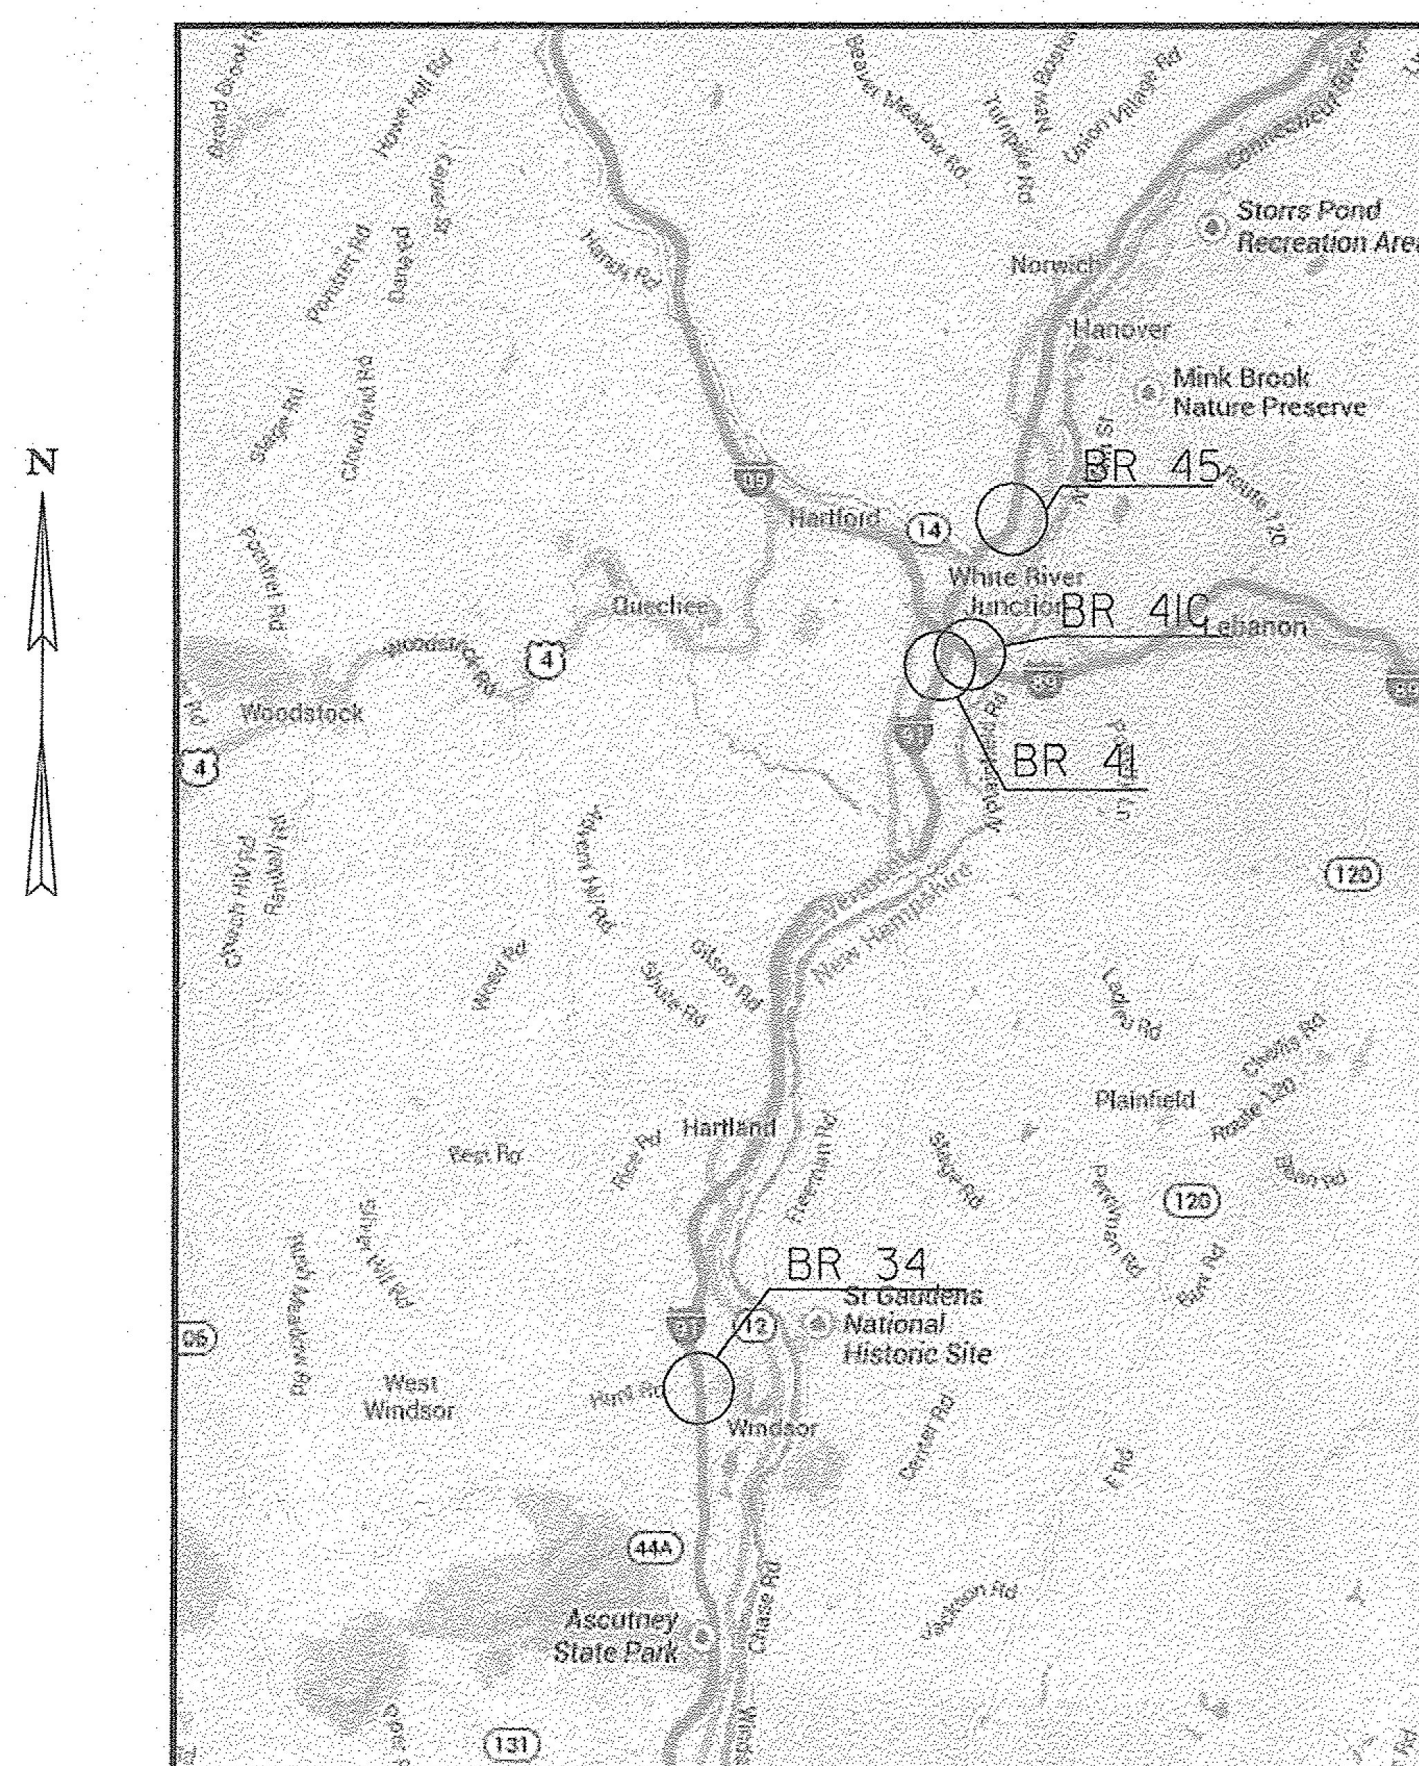

PROJECT LOCATION PLAN
NOT TO SCALE

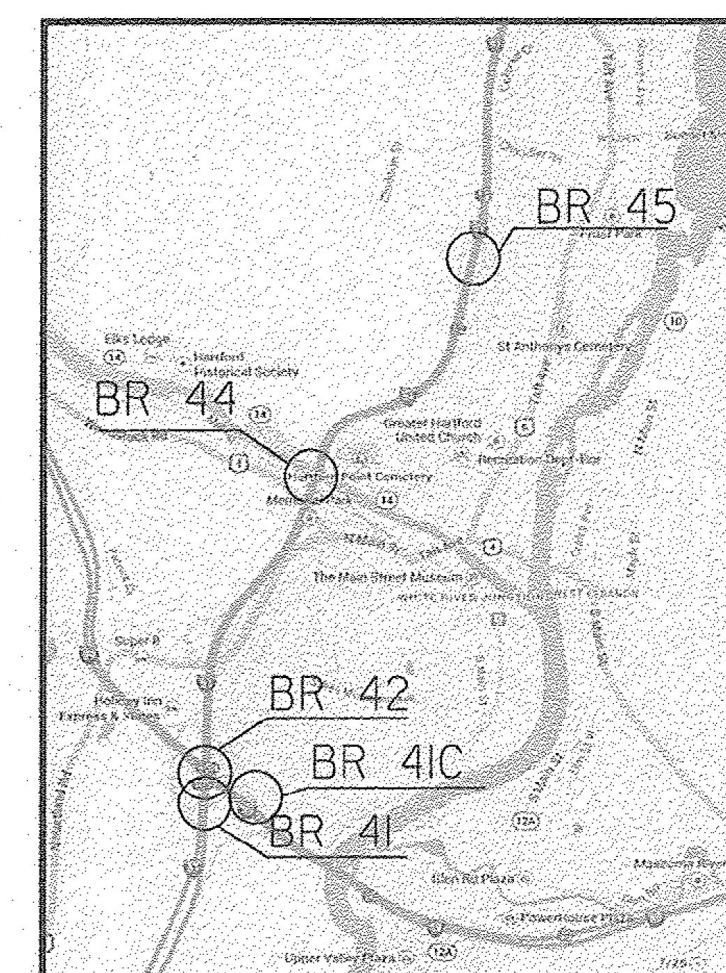


HARTFORD LOCATION PLAN
NOT TO SCALE

CONSTRUCTION IS TO BE CARRIED ON IN ACCORDANCE WITH THESE PLANS AND THE STANDARD SPECIFICATIONS FOR CONSTRUCTION DATED 2011, AS APPROVED BY THE FEDERAL HIGHWAY ADMINISTRATION ON JULY 20, 2011 FOR USE ON THIS PROJECT, INCLUDING ALL SUBSEQUENT REVISIONS AND SUCH REVISED SPECIFICATIONS AND SPECIAL PROVISIONS AS ARE INCORPORATED IN THESE PLANS.

QUALITY ASSURANCE PROGRAM : LEVEL 3	
SURVEYED BY :	N/A
SURVEYED DATE :	N/A
DATUM	
VERTICAL	N/A
HORIZONTAL	N/A

BUILT AS DESIGNED

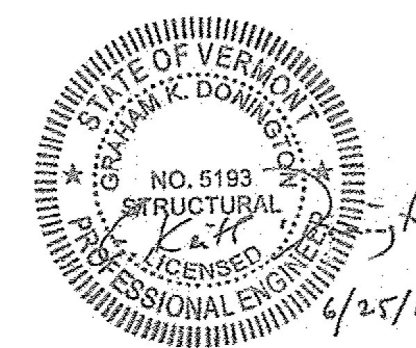

DIRECTOR OF PROJECT DELIVERY	
APPROVED: <u>Paul Perry</u>	DATE <u>7/2/2015</u>
PROJECT MANAGER : MARK SARGENT	
PROJECT NAME : WINDSOR-HARTFORD	
PROJECT NUMBER : IM BPNT (13)	
SHEET 1 OF 36 SHEETS	

