




PLAN
SCALE 1" = 10'

Note:
See Std. Dwg. G-3a For Dead
End Anchorage of Bridge Approach.
(Typical Both Ends).

Note: Bench Mark to be
set in top of curb above
Bridge Marker.

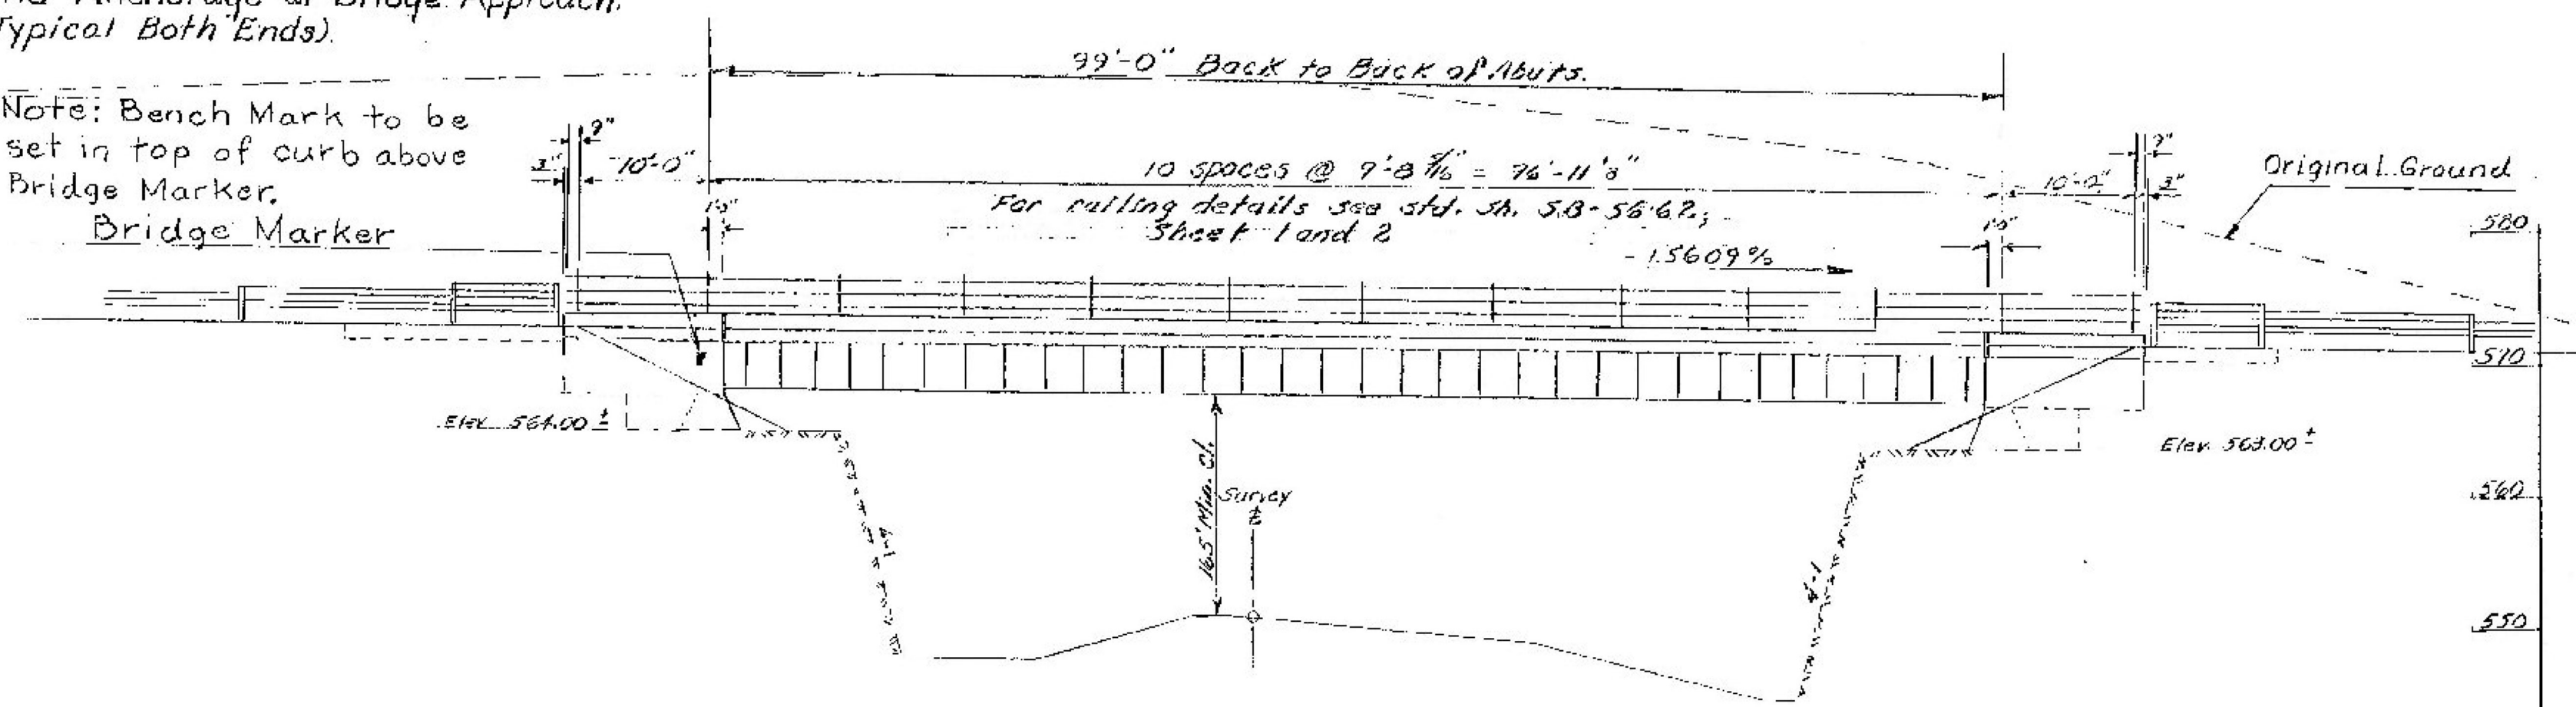

ELEVATION
SCALE 1" = 10'

Notes
1. For General Notes see Std. Sh. SCB-D1-62.
2. Bridge railing is detailed for steel
railing. Aluminum railing may be
substituted with a maximum spacing
of 7'-2" as per std. Sh. SB-5G-62, sh. #1 &
#2 Det. B.

- List of Bridge Sheets
- BR100 Preliminary Information Sheet
 - BR101 Preliminary Information Plan
 - BR102&103 Boring Logs
 - BR104 Bridge Quantity Sheet
 - BR105 Plan and Elevation Southbound
 - BR106 Superstructure Details S.B.
 - BR107 Bearing Details S.B.
 - BR108 Abutment No.1 S.B.
 - BR109 Abutment No.2 S.B.
 - BR110 Approach Slab No.1 S.B.
 - BR111 Approach Slab No.2 S.B.
 - BR112 Reinforcing Schedule S.B.
 - BR113 Plan and Elevation Northbound
 - BR114 Superstructure Details N.B.
 - BR115 Abutment No.1 N.B.
 - BR116 Abutment No.1 N.B. Details
 - BR117 Abutment No.2 N.B.
 - BR118 Abutment No.2 N.B. Details
 - BR119 Approach Slab No.1 N.B.
 - BR120 Approach Slab No.2 N.B.
 - BR121&122 Reinforcing Schedule N.B.

- Bridge Standard Sheets
- SCB-D1-62; SCB-D2-62, Det. A, B, & C; SCB-D4-62;
 - SCB-D6-62, Det. A, B, C, & D; SCB-D9-62, Det. A;
 - SCB-3A-62; SCWPG-30-62, sheets 1, 2 & 4;
 - SB-5G-62, sh. #1; SB-5G-62 sh. #2, Det. A and B; G-3a.

- Reference Sheets
- Plan and Profile: I-91 Sta. 3702. to 3718
 - Cross Sections I-91 S.B. Sta. 3701+0' to 3705+50
 - Profile Ramp C Sta. 1 to 32
 - Cross Sections Ramp C Sta. 20+50 to 21+75

WINDSOR - HARTFORD
IM BPNT (13)
PROJECT BRIDGE 41
SHEET 18 OF 36
FOR INFORMATION ONLY

Stage I & II Construction

ITEM NO.	ITEM	UNIT	NET	TOTAL	FINAL
	CHAN. EXCAV. OF EARTH	C.Y.			
	CHAN. EXCAV. OF ROCK	C.Y.			
	UNCLASS. CHAN. EXCAV.	C.Y.			
	STRUCT. EXCAV.	C.Y.			
	CONC. CLASS AA (MOD.)	C.Y.			
	CONC. CLASS B (MOD.)	C.Y.			
	REINF. STEEL	LBS.			
	ALPHALIC OIL COATING	S.Y.			
	TREATED TIMBER PILING	L.F.			
	SLICES FOR STEEL PILING	EA.			
	STEEL PILING	L.F.			
	UNTREATED TIMBER PILING	L.F.			

STATE OF VERMONT
DEPARTMENT OF HIGHWAYS

TOWNS OF Hartford

ROUTE NO. I-91 LOG STA. INTERSTATE OVER RAMP "C" (Southbound)

Plan and Elevation
SCALE 1" = 10'

SURVEYED BY JEWELL

DRAWN BY Wood CHECKED BY A.J.C.

PROJECT NO. I-91(25)631

SHEET 23 OF 205 Sheet 175 of 202