




Northbound Framing Plan
Scale 3/32" = 1'-0"

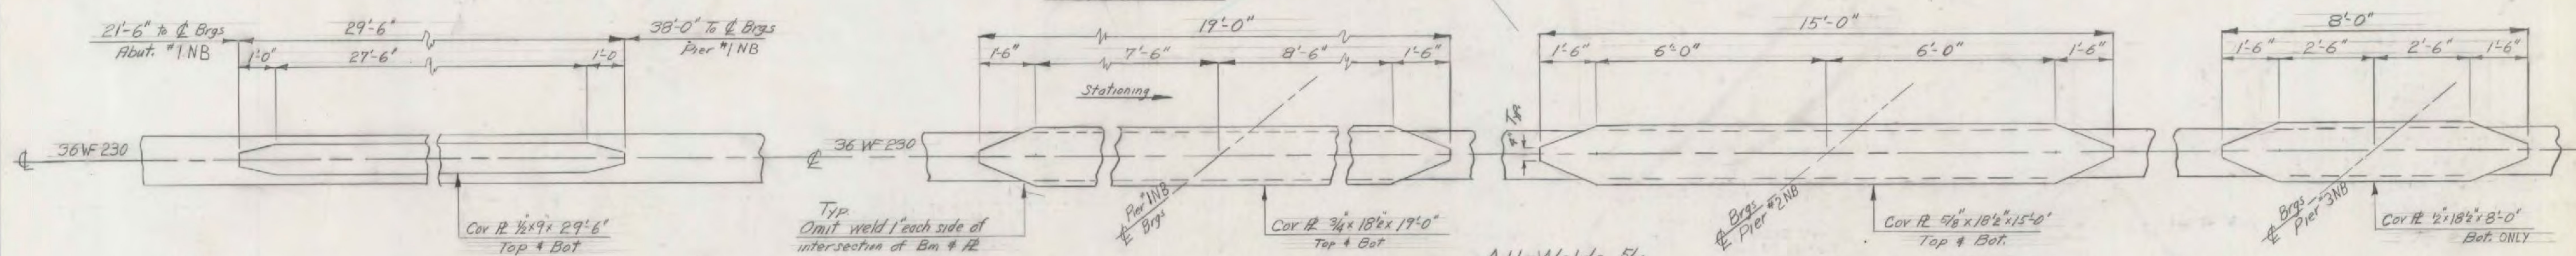


Cover Plate Details
Scale 1/2" = 1'-0"

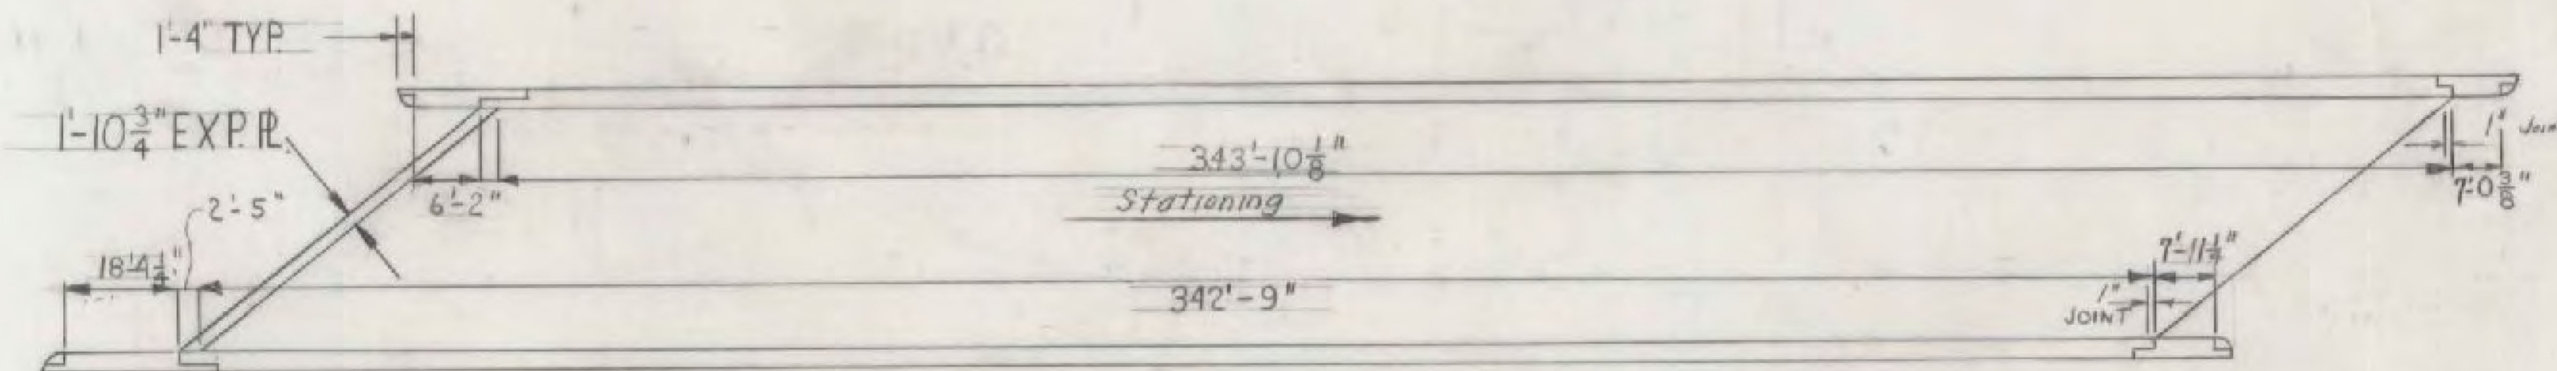

Curb Plan
Scale 1" = 30'

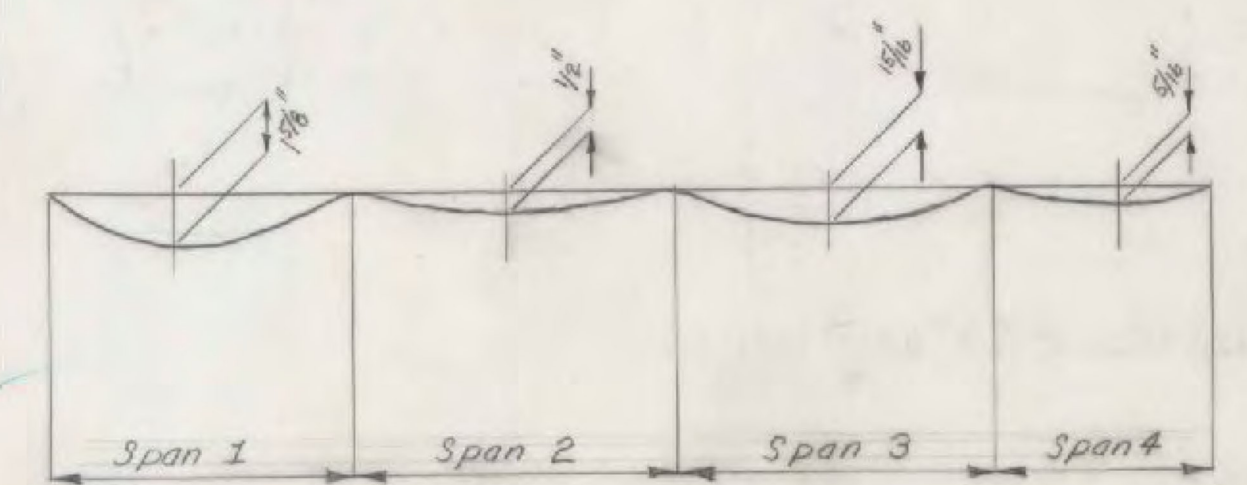

DL Deflection Diagram
N.T.S.

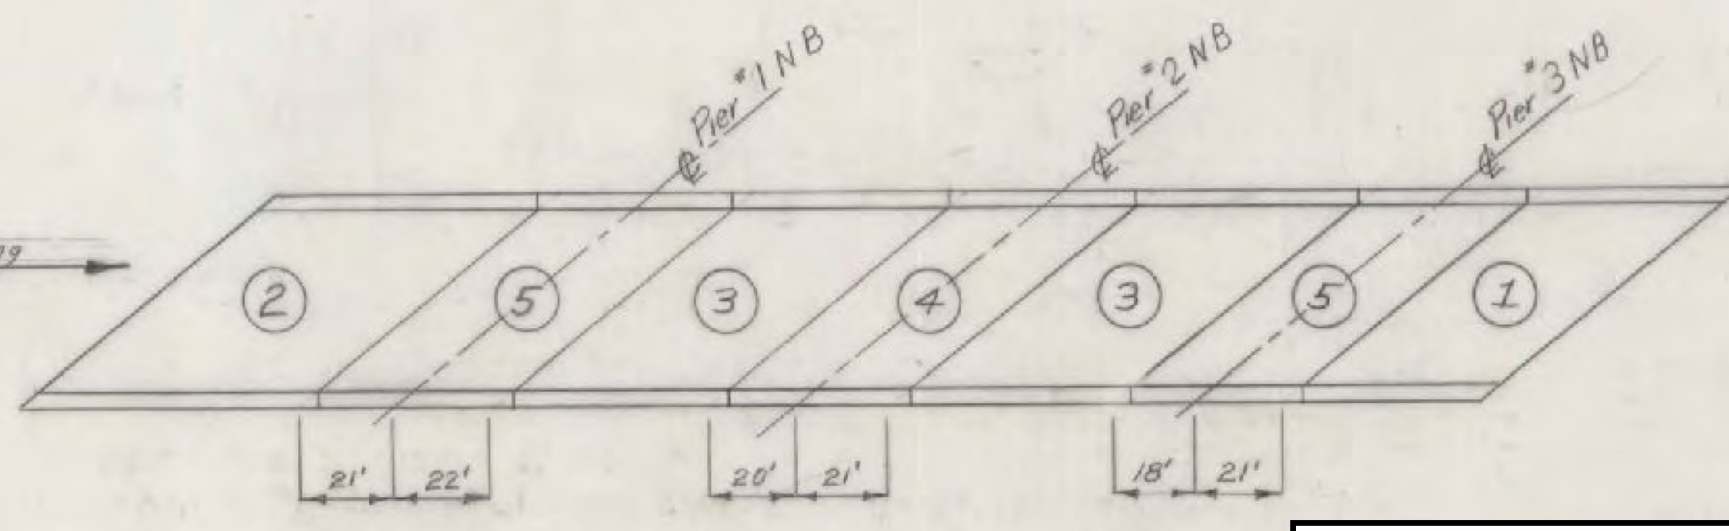

Pouring Schedule
Scale 1" = 40'

WINDSOR - HARTFORD
IM BPNT (13)
PROJECT BRIDGE 42
SHEET 26 OF 36
FOR INFORMATION ONLY

*Indicates Roadway Quantities

SUPERSTRUCTURE EST. QUANTITIES NORTHBOUND

ITEM NO.	ITEM	UNIT	TOTAL	FINAL
318	TAR EMULSION FOR BRIDGE FLOORS	GAL.		640
361-B	BIT. CONC. PAVEMENT MOD. DENSE GRADED TOP COURSE	TON		135
	UNCLASS. CHAN. EXCAV.	C.Y.		
	STRUCT. EXCAV.	C.Y.		
401-AA	CONC. CLASS AA (MOD.)	C.Y.	466	481
	CONC. CLASS B (MOD.)	C.Y.		
402	REINF. STEEL	LBS.	117,760	119,003
	ASPHALTIC-ASB. COATING	S.Y.		
	TREATED TIMBER PILING	L.F.		
	SPICES FOR STEEL PILING	EA.		
	STEEL PILING	L.F.		
	UNTREATED TIMBER PILING	L.F.		
404-A	STRUCTURAL STEEL	LBS.	627,000	658,600
556-C	GRANITE BRIDGE CURB MOD	L.F.	686	686
572	BRIDGE RAILING	L.F.	736	736
372-A	JOINT SEALER - HOT POURED	L.F.	99	
372-C	JOINT SEALER - PREFORMED	L.F.	116	

STAGE I & II CONSTRUCTION

STATE OF VERMONT
DEPARTMENT OF HIGHWAYS

TOWN OF Hartford
ROUTE No. I-91 LOG STA. I-91 over I-89
Northbound - Superstructure

SCALE as noted
SURVEYED BY
DRAWN BY C.F.H. CHECKED BY A.J.C.
PROJECT No. I-91-1(25)1001
SHEET 103 OF 265