


PLAN

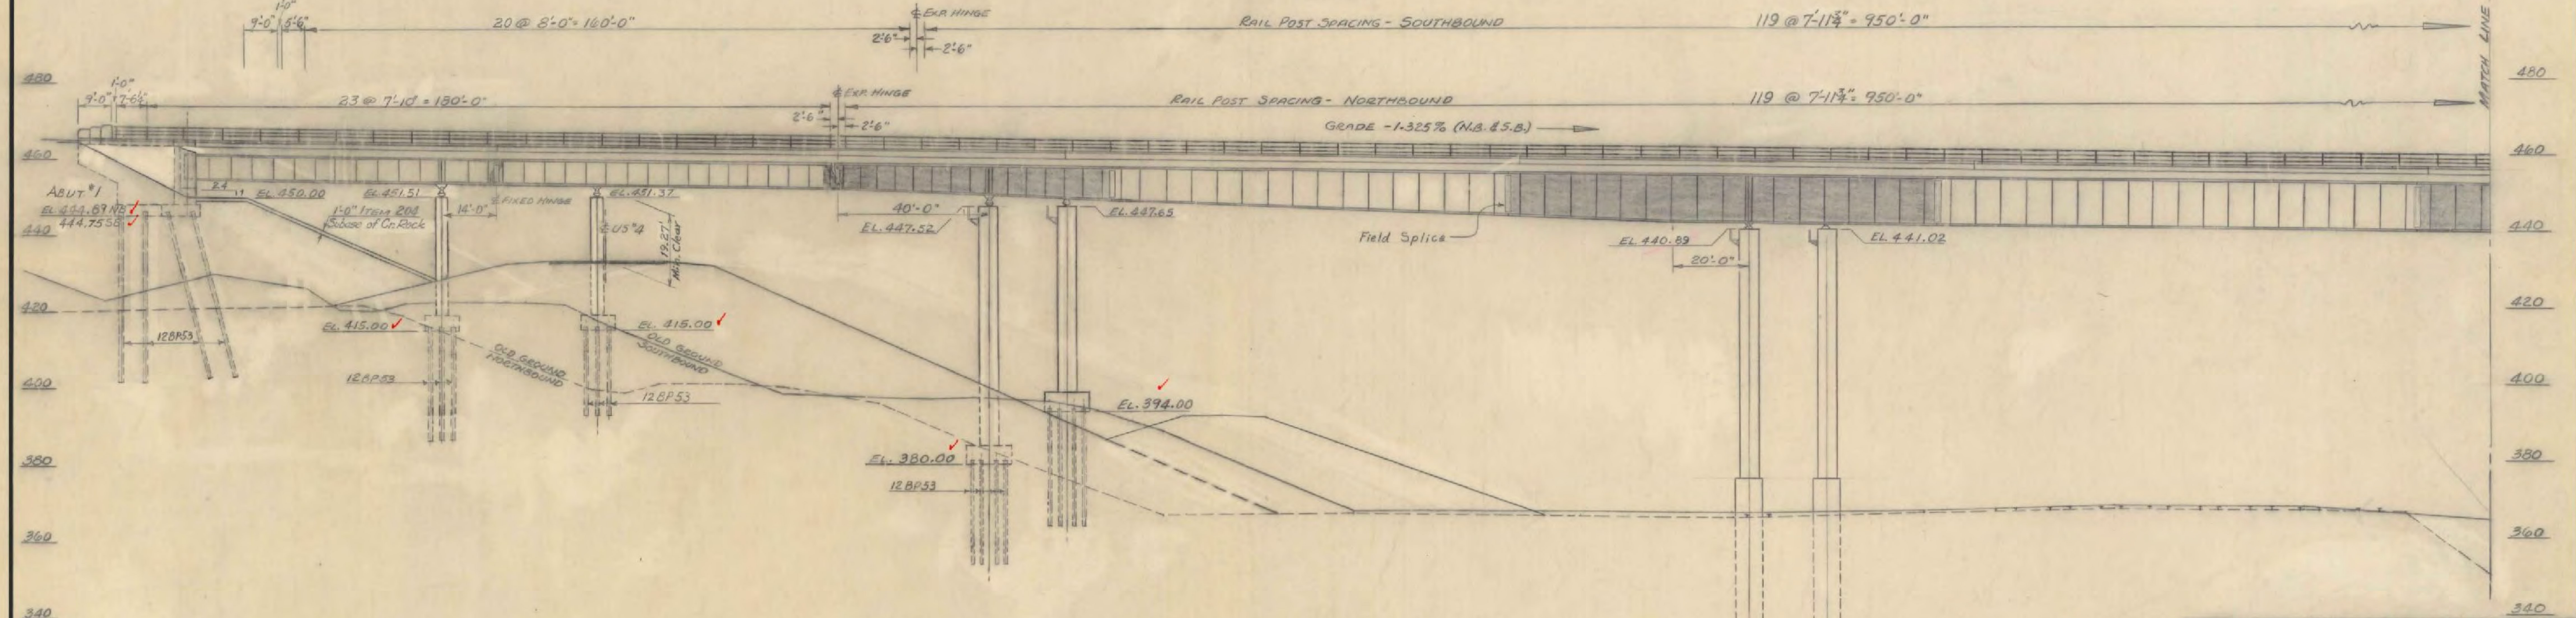

ELEVATION

STATE OF VERMONT
DEPARTMENT OF HIGHWAYS

TOWN OF HARTFORD

ROUTE No. I-91 LOG STA. ---

I-91 OVER WHITE RIVER

PLAN AND ELEVATION

SCALE 1" = 20'-0"

SURVEYED BY SCHWETT & WATSON

DRAWN BY P. T. B. JR. CHECKED BY N.B.T.

PROJECT No. I-91-2 (3) (22)

SHEET 11 OF 60 52 of 175

WINDSOR - HARTFORD
IM BPNT (13)
PROJECT BRIDGE 44
SHEET 27 OF 36
FOR INFORMATION ONLY

NOTE - Shaded areas of Girder in the elevation view indicate that Girder material is A.S.T.M. A-441 low-alloy, high strength steel. Remainder of Girder is A.S.T.M. A36 carbon steel.