
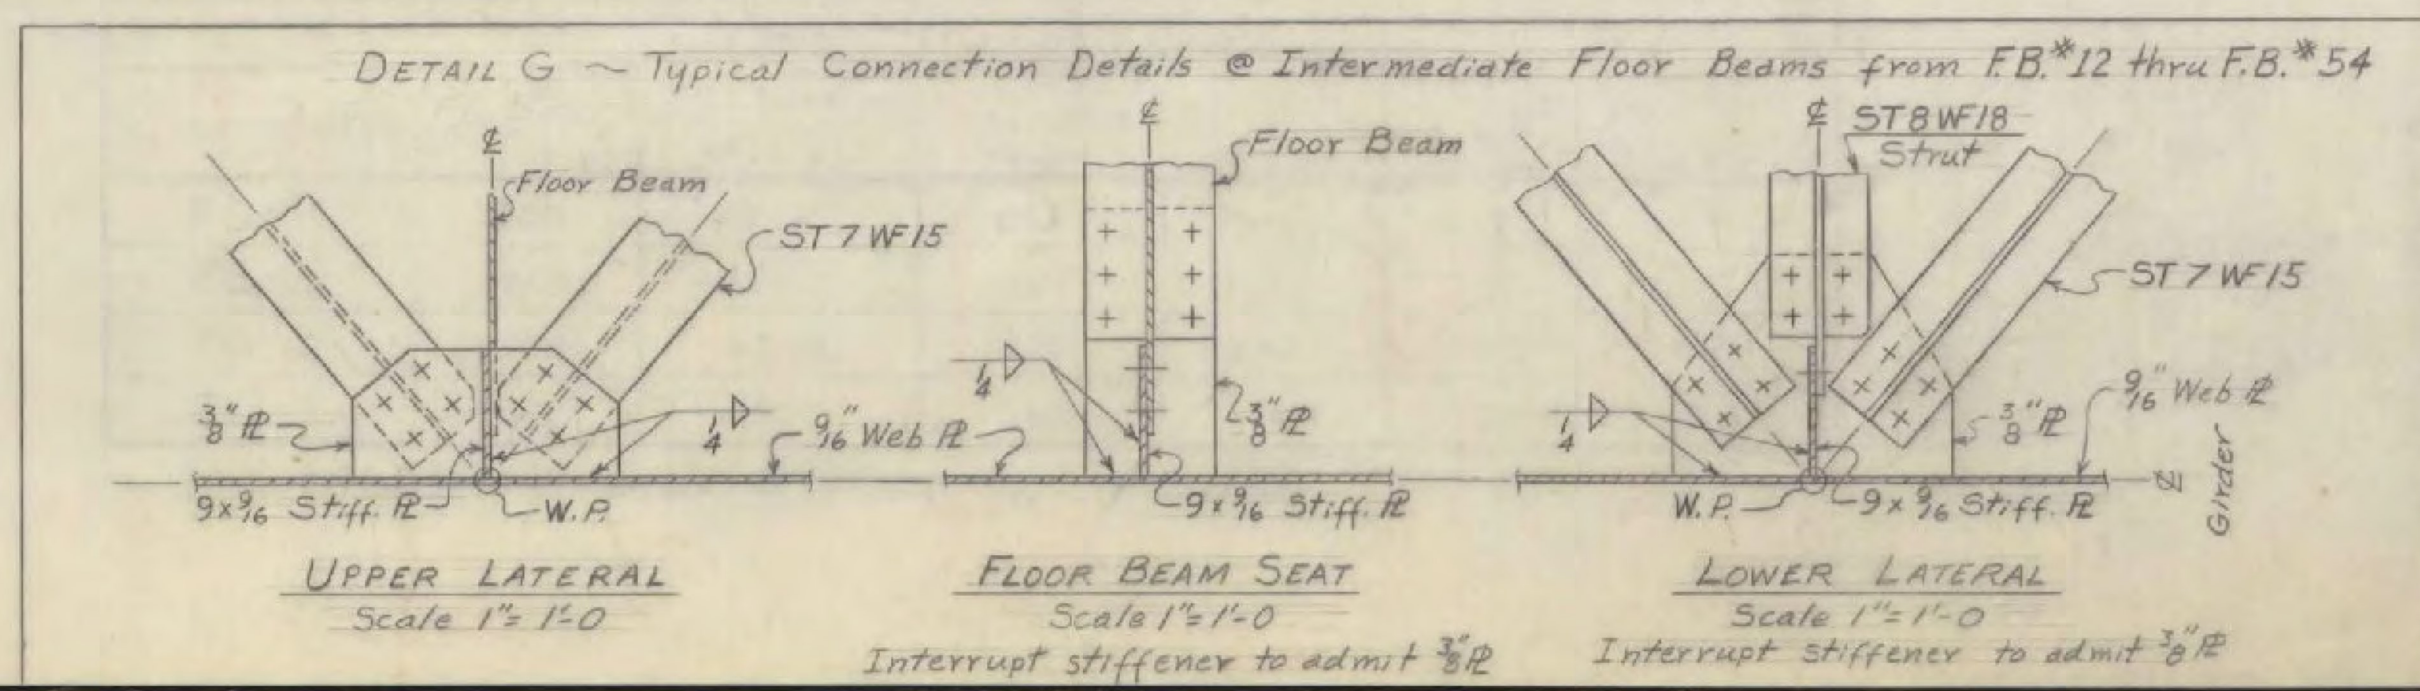
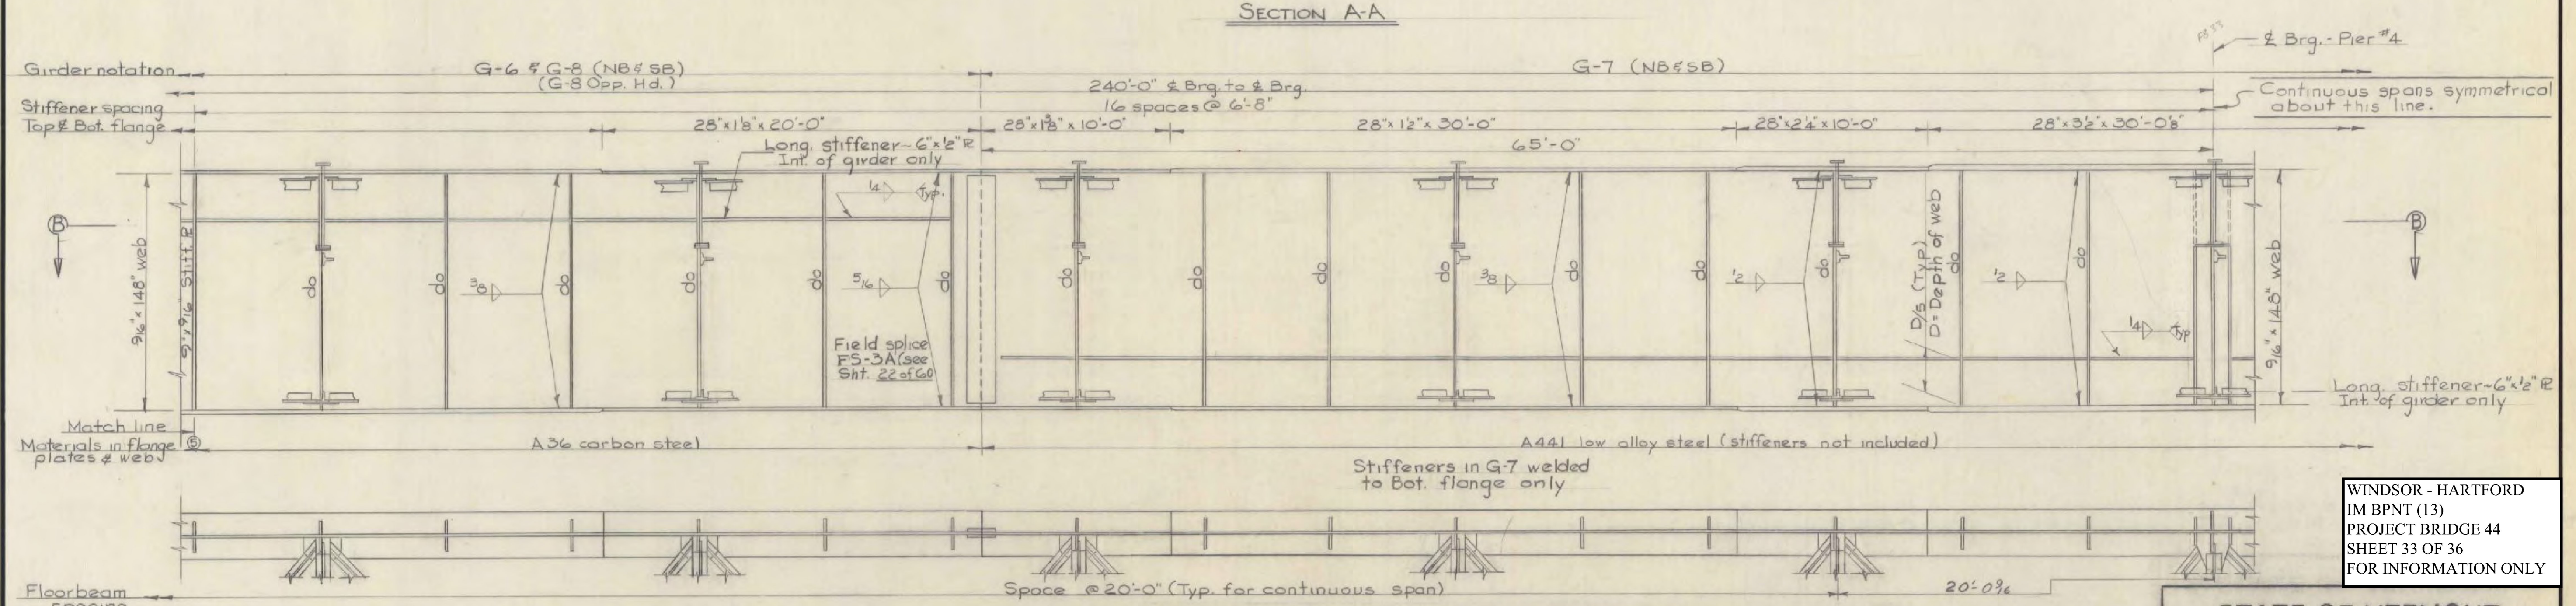


Weld sizes shown at change
in flange size

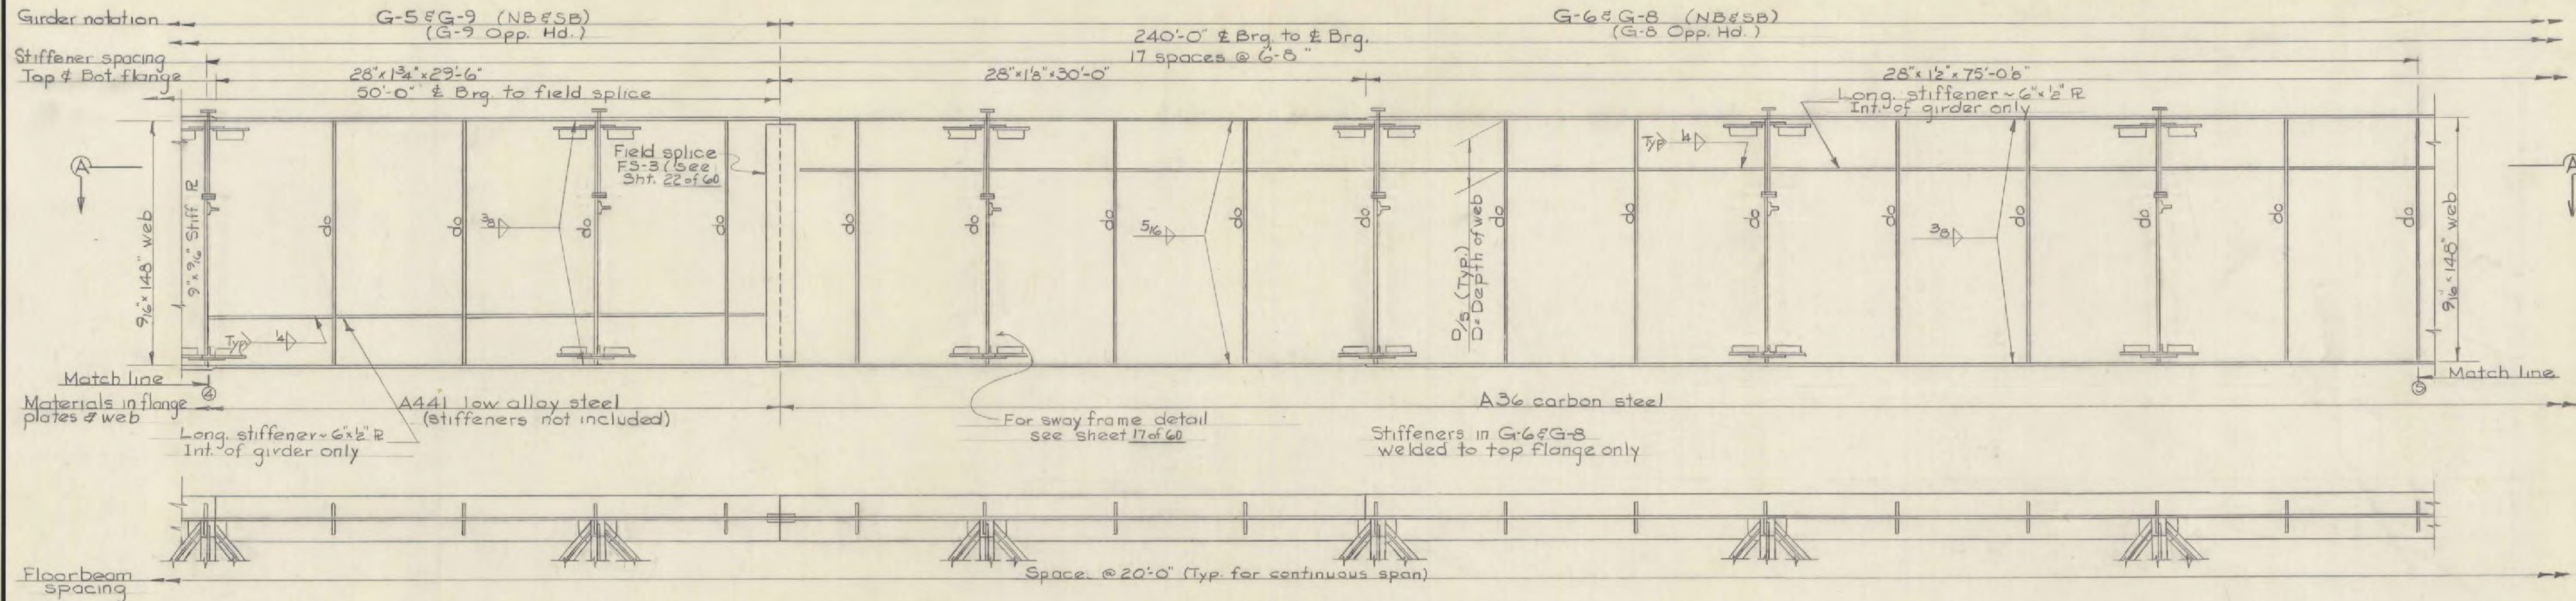

WINDSOR - HARTFORD
IM BPNT (13)
PROJECT BRIDGE 44
SHEET 33 OF 36
FOR INFORMATION ONLY

STATE OF VERMONT
DEPARTMENT OF HIGHWAYS

TOWN OF HARTFORD
ROUTE No. 1-91
GIRDER DETAILS - NB & SB
INT. OF OVER WHITE RIVER
SCALE 1/2" = 1'-0"

SURVEYED BY
DRAWN BY NBT CHECKED BY RLM 11-5-63
PROJECT No. 1-91-2(5)
SHEET 21 OF 60