
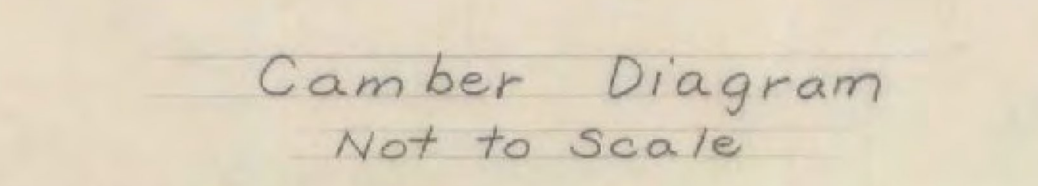


- Notes**
1. For fixed bearing details see Std. Sh. SCB-D8-65, Det. A and SCB-D9-65, Det. A.
  2. For details of diaphragms and diaphragm connections see Std. Sh. SCB-D7-65, Det. A & D.
  3. All structural steel to be A.S.T.M. A36-62T.
  4. All intermediate diaphragms to be 15U33.9. All end and pier diaphragms to be 18U42.7.
  5. \* Indicates items to be included in Roadway Quantities.
  6. For details of curtain wall at fixed abut see Std. Sh. SCB-D2-65, Detail A, and sheet BR-110. For details of expansion dam see sheet BR-107.

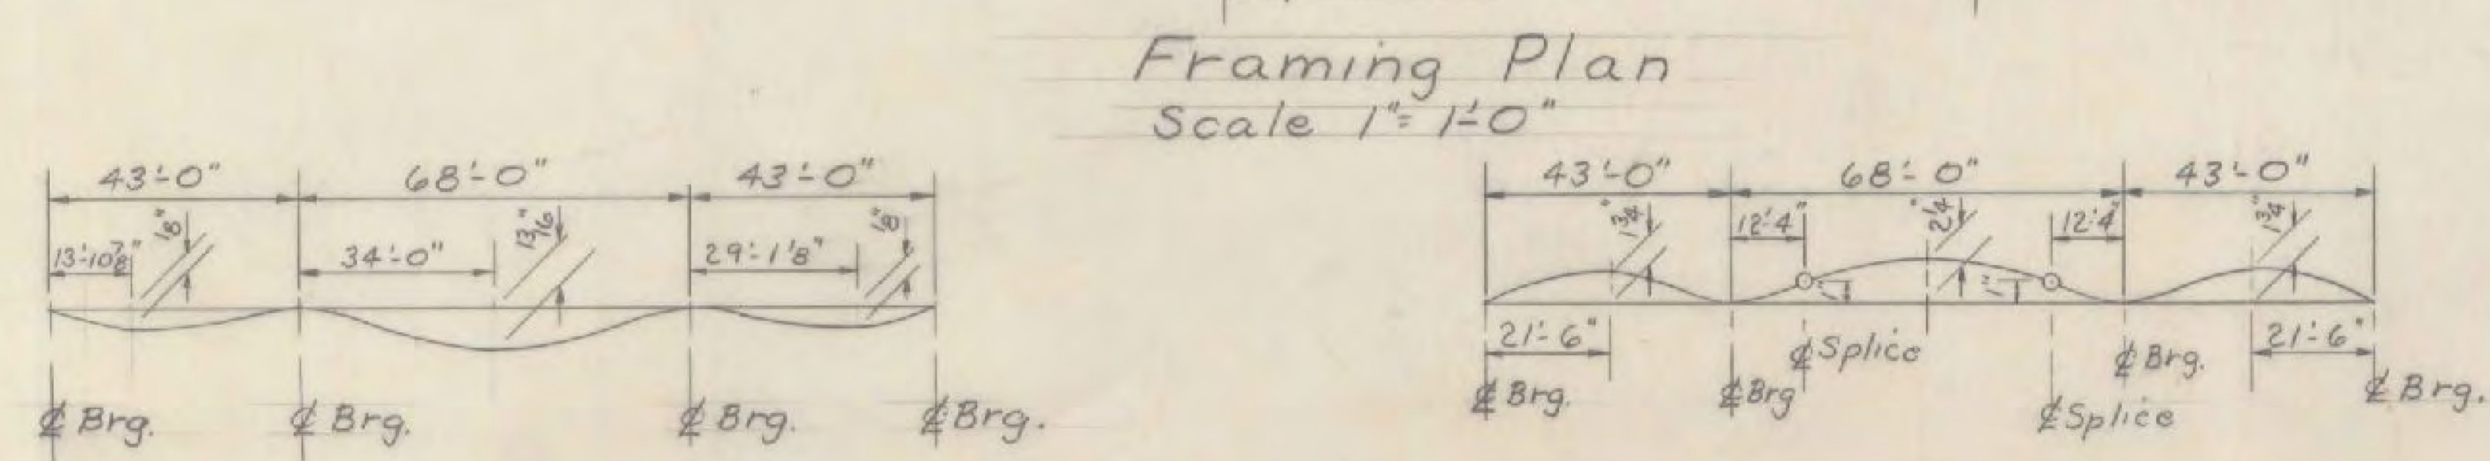

**Est. Superstructure Quantities**

ITEM NO.	ITEM	UNIT	Northbound		Southbound	
			TOTAL	FINAL	TOTAL	FINAL
* 31B	Tar Emulsion for Bridge Floors	Gal.	257		257	
* 361-B	Bituminous Concrete Pavement (Dense Graded Bottom and Top Course)	Ton	55		55	
401-AA	Concrete Class AA	C.Y.	185	189	185	191
(RB) 404-A	Structural Steel (Sta. 3827)	Lb.	134,300	134,605	132,300	134,605
440	Water Repellent	Gal.	17		17	
556-C	Grande Bridge Curb	L.F.	311	309	311	308
572	Bridge Railing (Std. 3-Rail)	L.F.	367	361	357	358
402	Reinforcing Steel	Lb.	47,900	47,930	47,900	47,930

**STATE OF VERMONT**  
DEPARTMENT OF HIGHWAYS

TOWN OF Hartford (Urban)

ROUTE NO. I 91 LOG STA. \_\_\_\_\_

Wilder Interchange

**Framing Plan**  
SCALE AS NOTED

SURVEYED BY \_\_\_\_\_

DRAWN BY A.J.C. CHECKED BY J.W.

PROJECT NO. I 91-2(4)

SHEET 28 OF 261

Revised by J.J.C. 12/14/65  
Beam designation 30WF108 added to Northbound Bridge

\* Roadway Quantities

WINDSOR - HARTFORD  
IM BPNT (13)  
PROJECT BRIDGE 45  
SHEET 36 OF 36  
FOR INFORMATION ONLY