

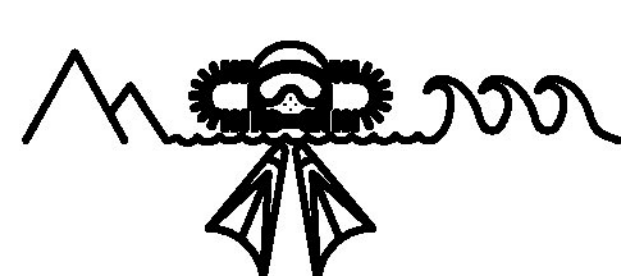
SECTION A-A

4 ~ SCUPPER TUBES ~ 9MI

HOT DIP GALV. PER  
A.S.T.M. A153  
SHOP PROVIDE 9/16" VENT  
HLS. AS REQ'D.

BRIDGE 44 NORTH & SOUTH

SHIP QTY		ASSEMBLY QTY		SECTION		FT	INCH	ASSEMBLY MARK	SHIP MARK	REMARKS	WEIGHT	Holes: 1 3/16" UNO		Saw: INITIAL DATE		Drill: INITIAL DATE		Fitter: INITIAL DATE		GCI: INITIAL DATE	
												SHOP BOLTS: A325-TC		Weld: INITIAL DATE		Prep: INITIAL DATE		Paint: INITIAL DATE		Load: INITIAL DATE	
				HSS 4x4x3/16		?	?		9MI	FIELD VERIFY		MATERIAL: W's - A992-50 HSS - A500 Grd B Pipe - A53 Grd B Bars & P & L - A36									
		4		SQ 3/8		?	?	pa9		FIELD VERIFY		ELECTRODES: E70XX/E71-T									
												E DWG REF: E2									
												ENGR DWG REF:									
												SEQ / DIV:									
												GRID LOCATION:									
												TOS ELEVATION:									
												NOTES:									

6/26/17	Per App'l & Field Conditions	
3/3/17	Per Check'g	
NO.	DATE	REVISION
 <b>RELIANCE STEEL</b> 94 SOUTH OAK CIRCLE, COLCHESTER, VT 05446 TEL 802-655-4810 FAX 802-655-9352 www.reliancesteelofvt.com		
CUSTOMER Monoko		
PROJECT Scupper Repair & Replacement Components		
DETAIL Scupper Replacement Tube		
DRAWN/CHECKED	DATE	JOB NO.
RCL	FEB 2017	7324
DWG NO.	REV	
09		