


Vermont Agency of Transportation

RECEIVED

CK'D BY Mark SargentS OK'D BY Mark Sargent

April 17, 2017

RESUBMIT No Approved AsNoted
BY Mark Sargent DATE 06/14/2017

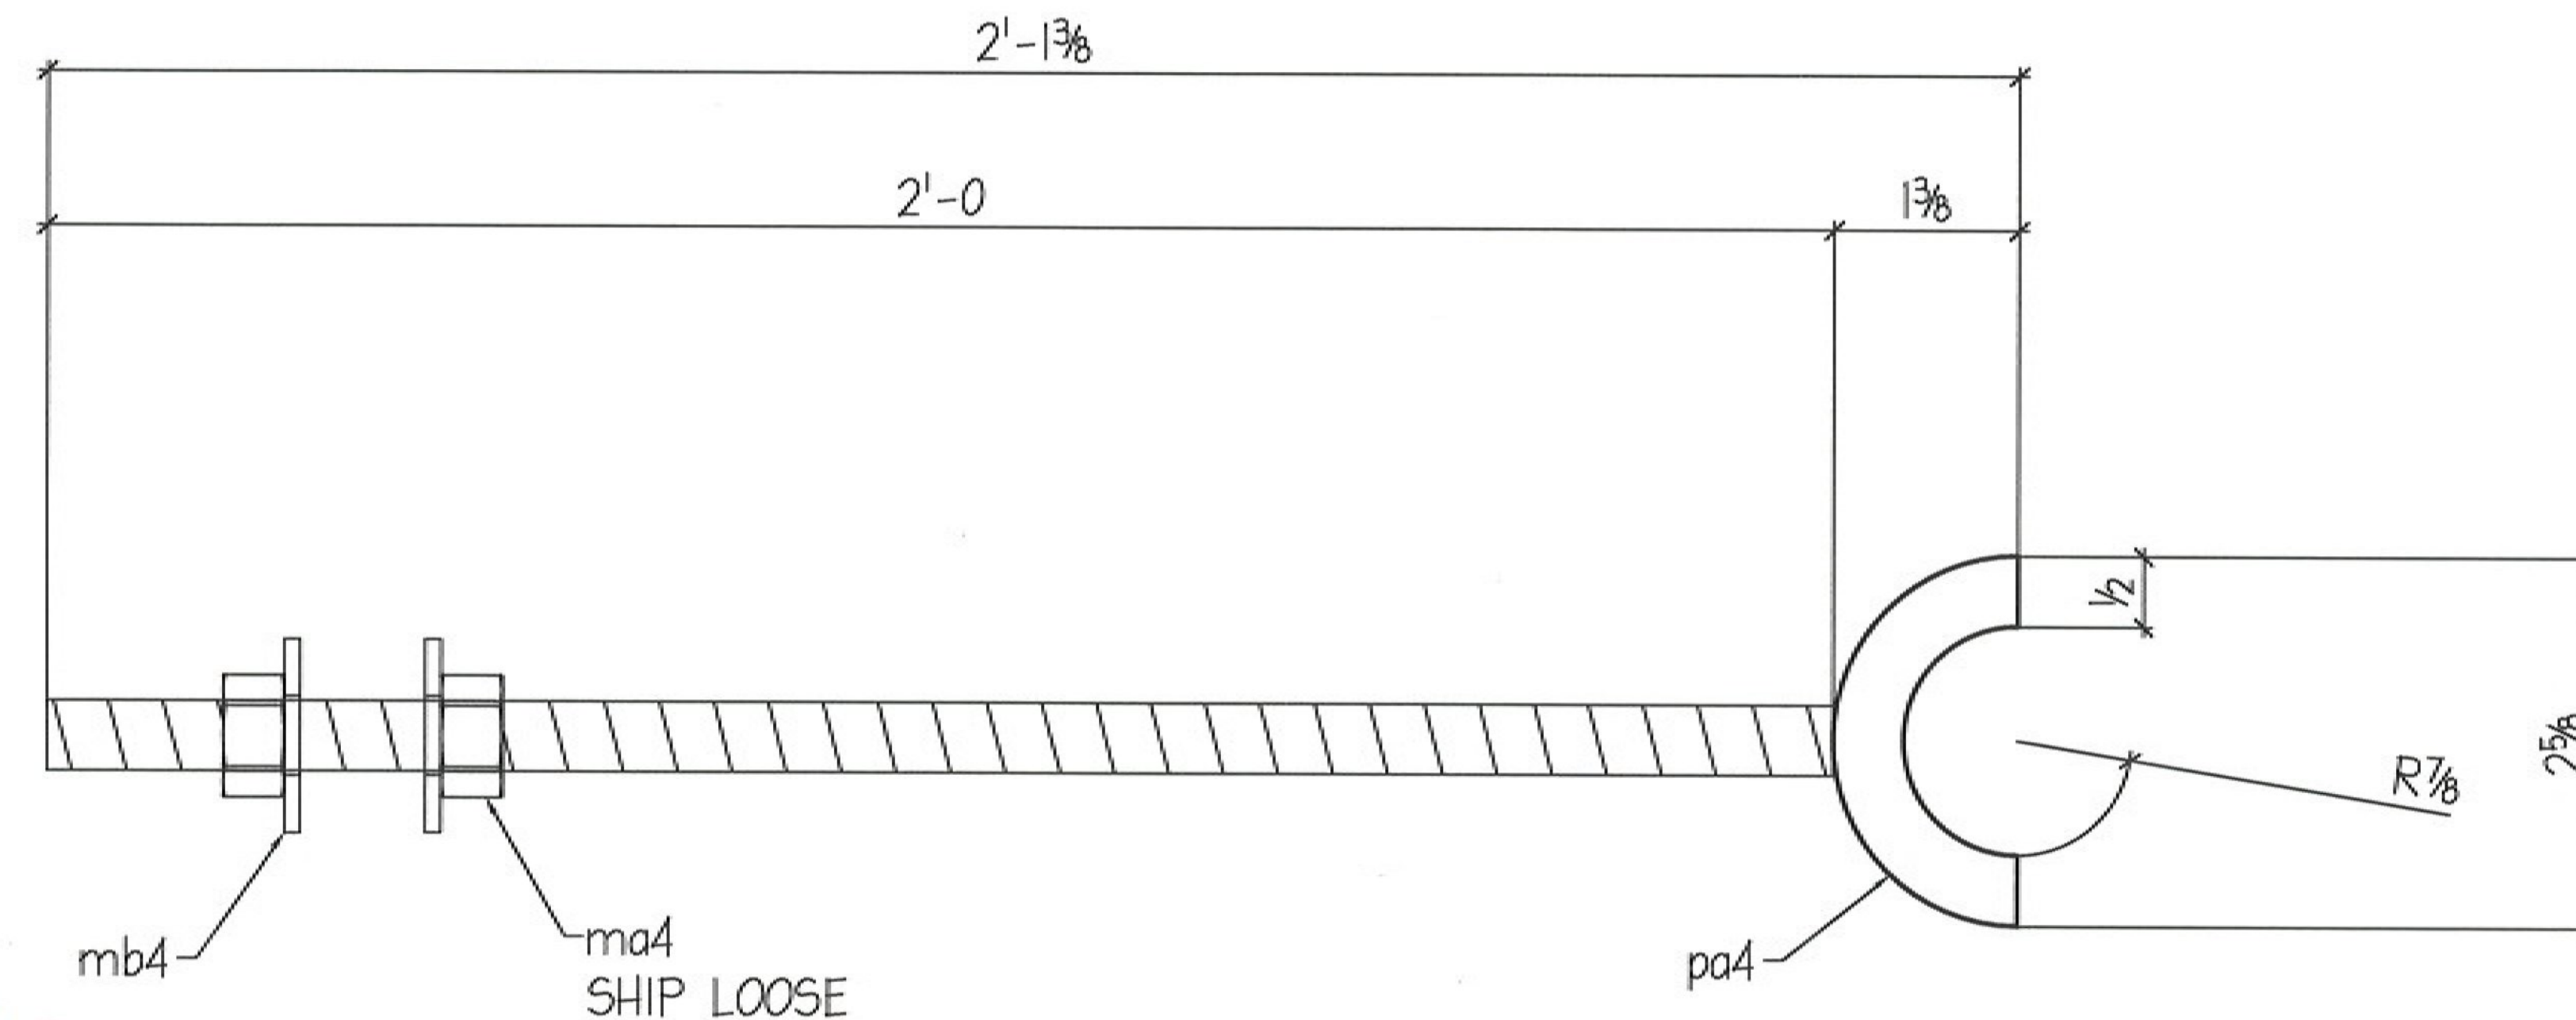

SUBMITTAL REVIEW

Review is only for general conformity to the contract drawings and specifications and shall not relieve the contractor of his entire responsibility under the contract, including among other things, dimensions to be confirmed and correlated at the job site, and information that pertains to the fabrication processes or to techniques of construction.

- NO EXCEPTIONS TAKEN
- MAKE CORRECTIONS NOTED
RESUBMITTAL NOT REQUIRED
- AMEND AND RESUBMIT
- REJECTED - SEE REMARKS

PARSONS BRINCKERHOFF, INC.

BY: Stephen L. Boyington
DATE: 5/17/17

GALVANIZE ALL MATERIAL. SEE NOTE 3 DWG E.1

~~HOT DIP GALV. PER A.S.T.M. A123~~
~~SHOP PROVIDE 3/16\"/>~~

20 ~ SUPPORTS ~ 4MI
REF: E1

BRIDGE 42 NORTH & SOUTH

| △ | 4/19/17 | Per App'l |
|-----|---------|-------------|
| △ | 3/3/17 | Per Check'g |
| NO. | DATE | REVISION |

| SHIP QTY | ASSEMBLY QTY | SECTION | FT | INCH | ASSEMBLY MARK | SHIP MARK | REMARKS | WEIGHT |
|--|--------------|-------------|----|-------|---------------|-----------|-----------------|--------|
| 20 | | THR 1/2-13 | 2 | 0 | | 4MI | | |
| | 20 | P 1/2x2 5/8 | 0 | 2 5/8 | pa4 | | SHAPE | |
| | 40 | NUT 1/2" | | | ma4 | | A563-SHIP LOOSE | |
| | 40 | FW 1/2" | | | mb4 | | F436-SHIP LOOSE | |
| SURFACE PREP: SSPC-SP2 FINISH: GALV PRIMER: N/A DFT: 1.0 HOLES: 3/16" UNO SHOP BOLTS: A325-TC MATL: W's - A992-50 HSS - A500 Grd B Pipe - A53 Grd B Bars & P & L - A36 ELECTRODES: E70XX/E71-T E DWG REF: E1 ENGR DWG REF: E1 SEQ / DIV: GRID LOCATION: TOS ELEVATION: NOTES: | | | | | | | | |

Saw: INITIAL DATE
 Drill: INITIAL DATE
 Fitter: INITIAL DATE
 GCI: INITIAL DATE
 Weld: INITIAL DATE
 Prep: INITIAL DATE
 Paint: INITIAL DATE
 Load: INITIAL DATE

RELIANCE STEEL
 94 SOUTH OAK CIRCLE, COLCHESTER, VT 05446
 TEL 802-655-4810 FAX 802-655-9352
 www.reliancesteelofvt.com

CUSTOMER Monoko
 PROJECT Bridge Downspouts & Components
 DETAIL Trough Threaded Rod Supports

| | | | | |
|---------------|----------|---------|---------|-----|
| DRAWN/CHECKED | DATE | JOB NO. | DWG NO. | REV |
| RCL | FEB 2017 | 7324 | 04 | △ |