


INDEX OF SHEETS

- 1 TITLE SHEET
- 2 PROJECT NOTES
- 3-5 PROJECT STANDARD DETAILS
- 6-9 QUANTITY SHEETS
- 10-13 TRAFFIC CONTROL SHEETS
- 14-16 REFERENCE SHEETS BRIDGE 58N & 58S
- 17-19 REFERENCE SHEETS BRIDGE 59N & 59S
- 20-22 REFERENCE SHEETS BRIDGE 62N & 62S
- 23-24 REFERENCE SHEETS BRIDGE 63N & 63S
- 25-26 REFERENCE SHEETS BRIDGE 67N & 67S

STANDARD SHEETS


- T-1 08-06-2012
- T-10 08-06-2012
- T-11 08-06-2012
- T-12 08-06-2012
- T-13 08-06-2012

# STATE OF VERMONT AGENCY OF TRANSPORTATION

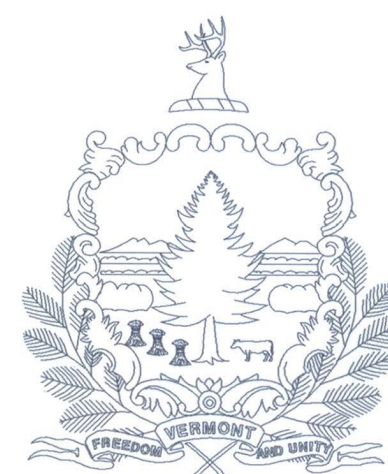

## PROPOSED IMPROVEMENT BRIDGE PROJECT

BRADFORD - NEWBURY  
COUNTY OF ORANGE  
TEN BRIDGES ON OR OVER I-91

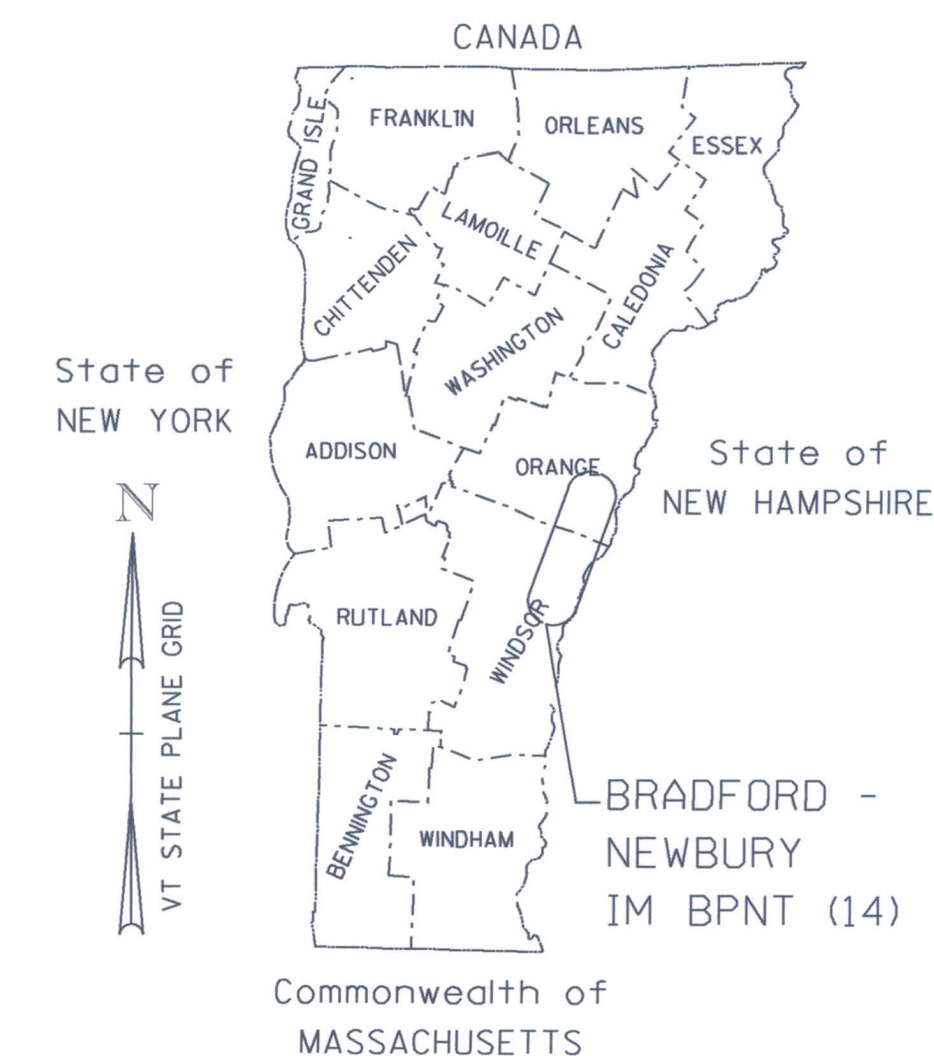


LOCATION MAP  
NOT TO SCALE

RECORD PLANS	
CONTRACTOR:	MONOKO, LLC - TARPON SPRINGS, FL
RESIDENT ENGINEER:	PETE HODGSON
CONSTRUCTION BEGAN:	MAY 11, 2015
CONSTRUCTION COMPLETE:	AUGUST 19, 2016
RECORD PLANS BY:	PETE HODGSON & JESSE IVES
I HEREBY CERTIFY THAT ALL THE CONSTRUCTION REQUIRED BY THIS SET OF DRAWINGS HAS BEEN ACCOMPLISHED AS INDICATED HEREIN.	
BY	RESIDENT ENGINEER
DATE	April 12, 2018
NOTE: Any further information concerning final quantities, amounts or other details relative to this project may be found at Central Files in the electronic archives.	

PROJECT LOCATION: BRADFORD BRIDGES 58N & 58S (I-91 OVER VT 25) (MM 97.63)  
 BRADFORD BRIDGES 59N & 59S (I-91 OVER WAITS RIVER) (MM 97.88)  
 BRADFORD BRIDGES D62N & D62S (TH NO 3 OVER I-91) (MM 100.58)  
 NEWBURY BRIDGES 63N & 63S (I-91 OVER TH NO 1) (MM 103.50)  
 NEWBURY BRIDGES 67N & 67S (I-91 OVER WELLS RIVER) (MM 110.62)

PROJECT DESCRIPTION: THIS PROJECT INVOLVES CLEANING, LEAD PAINT REMOVAL AND REPAINTING THE EXISTING STEEL SUPERSTRUCTURE MEMBERS AND ASSOCIATED WORK.

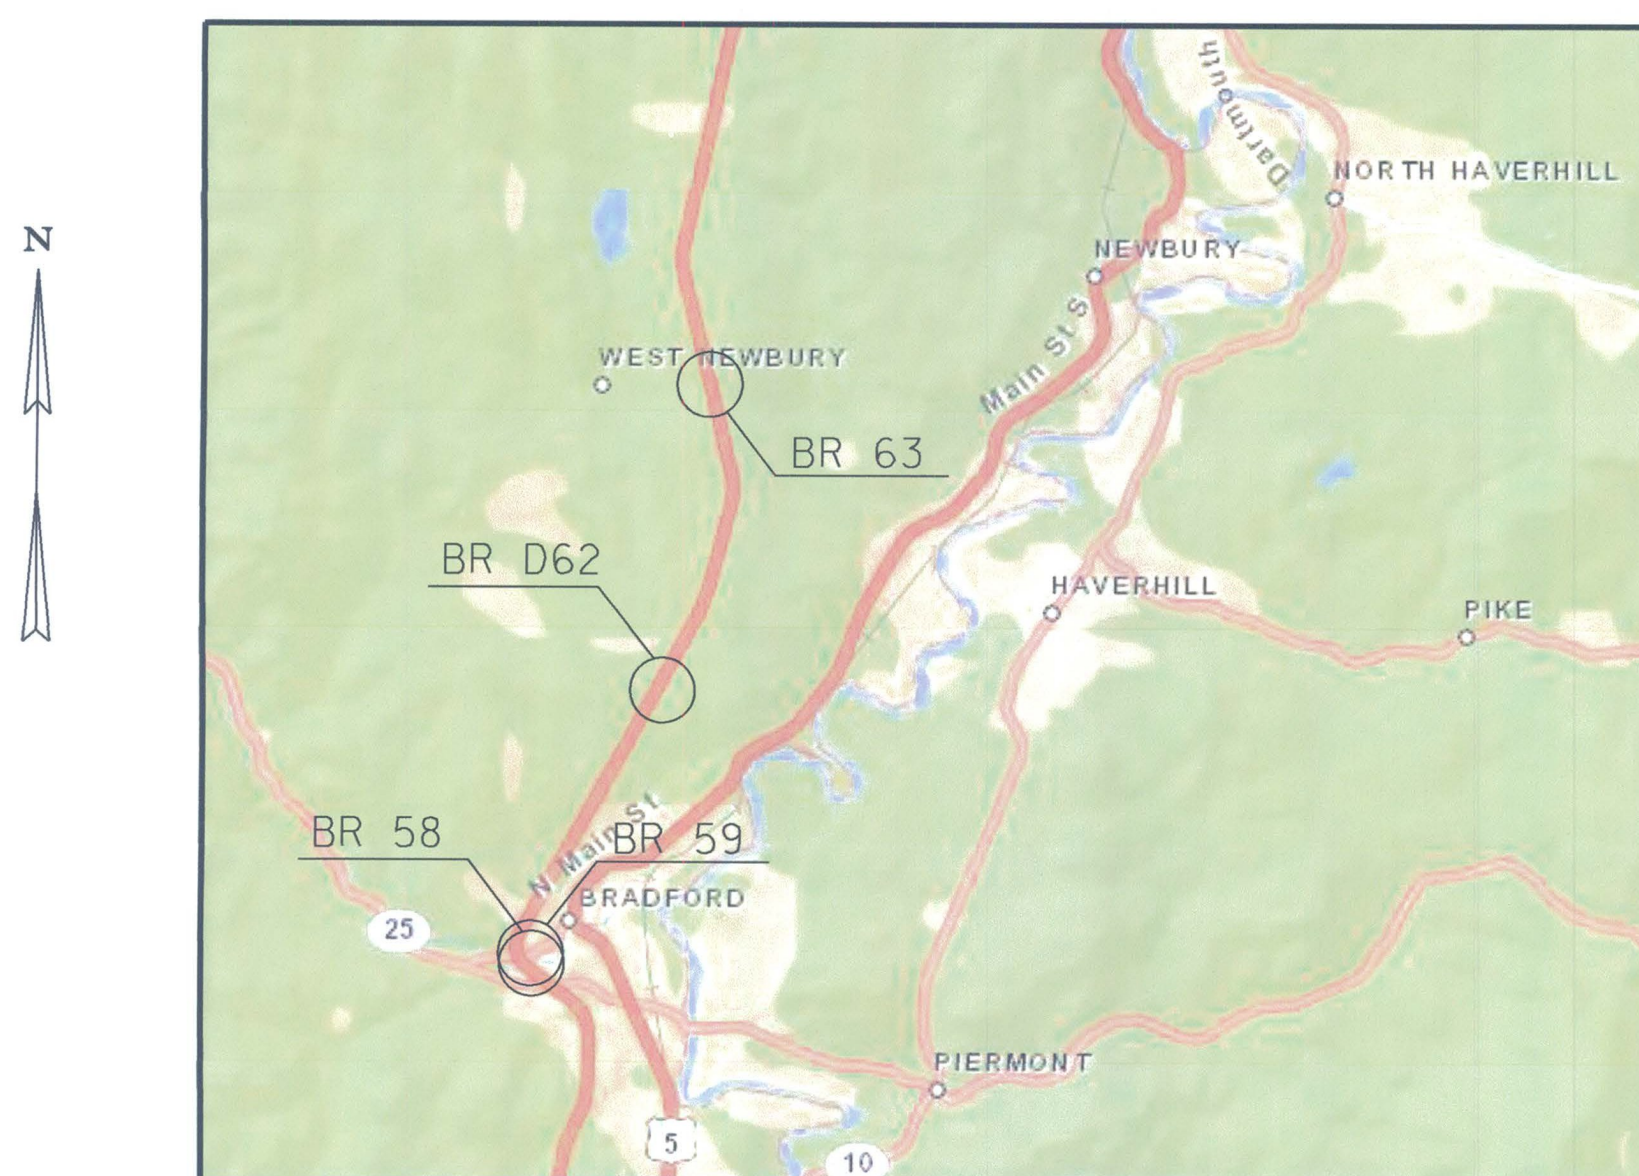

PROJECT LOCATION PLAN  
NOT TO SCALE



NEWBURY LOCATION PLAN  
NOT TO SCALE

BUILT AS DESIGNED

CONSTRUCTION IS TO BE CARRIED ON IN ACCORDANCE WITH THESE PLANS AND THE STANDARD SPECIFICATIONS FOR CONSTRUCTION DATED 2011, AS APPROVED BY THE FEDERAL HIGHWAY ADMINISTRATION ON JULY 20, 2011 FOR USE ON THIS PROJECT, INCLUDING ALL SUBSEQUENT REVISIONS AND SUCH REVISED SPECIFICATIONS AND SPECIAL PROVISIONS AS ARE INCORPORATED IN THESE PLANS.

QUALITY ASSURANCE PROGRAM : LEVEL	
SURVEYED BY :	N/A
SURVEYED DATE :	N/A
DATUM	
VERTICAL	N/A
HORIZONTAL	N/A

CHIEF ENGINEER OF THE HIGHWAY DIVISION	
APPROVED _____	DATE _____
PROJECT MANAGER : MARK SARGENT	
PROJECT NAME : BRADFORD-NEWBURY	
PROJECT NUMBER : IM BPNT (14)	
SHEET 1 OF 26 SHEETS	

