


ROADWAY TYPICAL NORMAL SECTION

ALTERNATE A


NOT TO SCALE

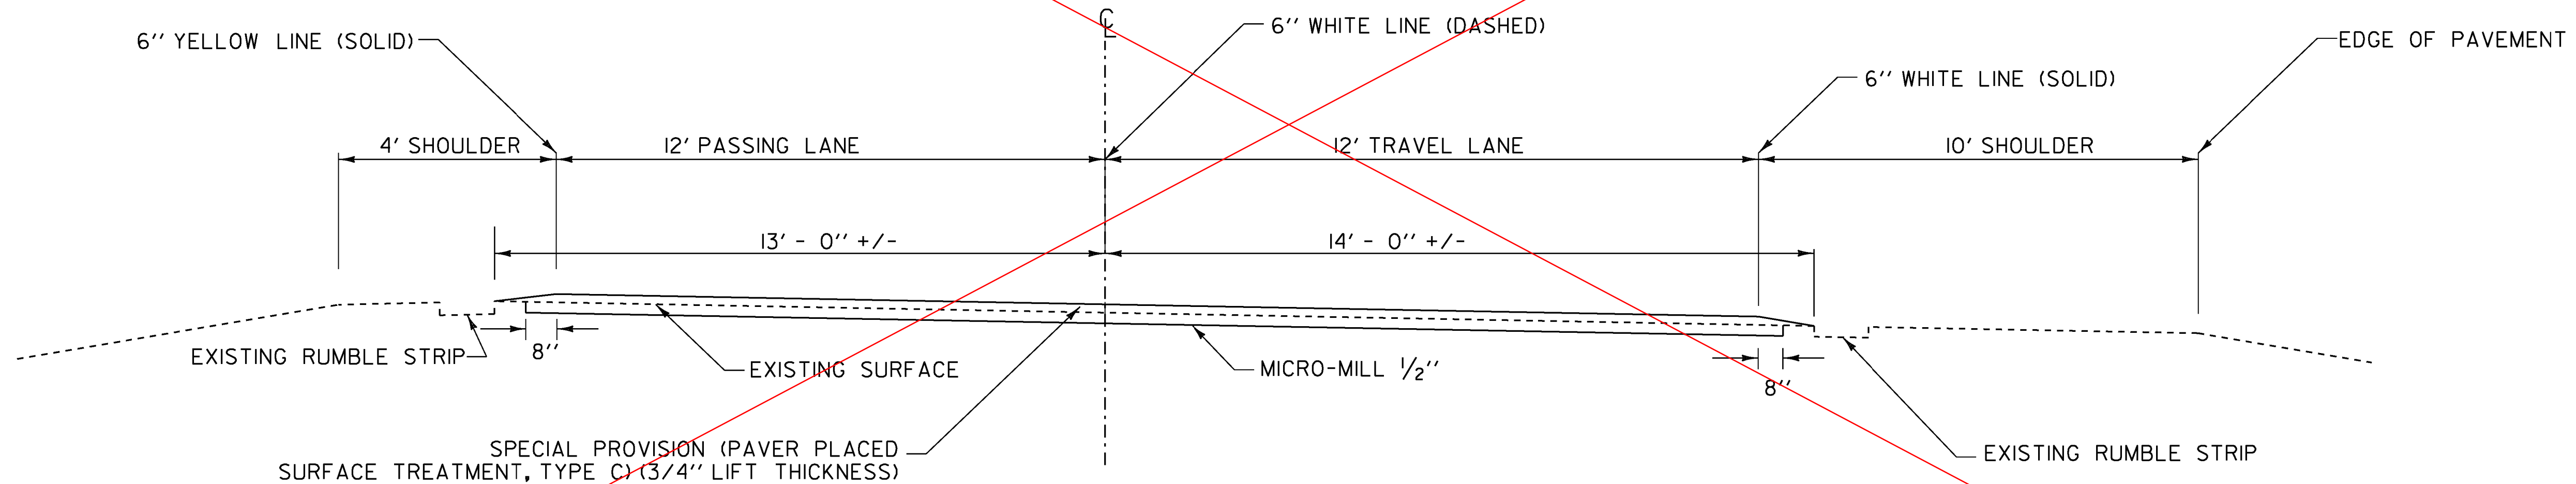

ROADWAY TYPICAL BANKED SECTION

ALTERNATE A

NOT TO SCALE

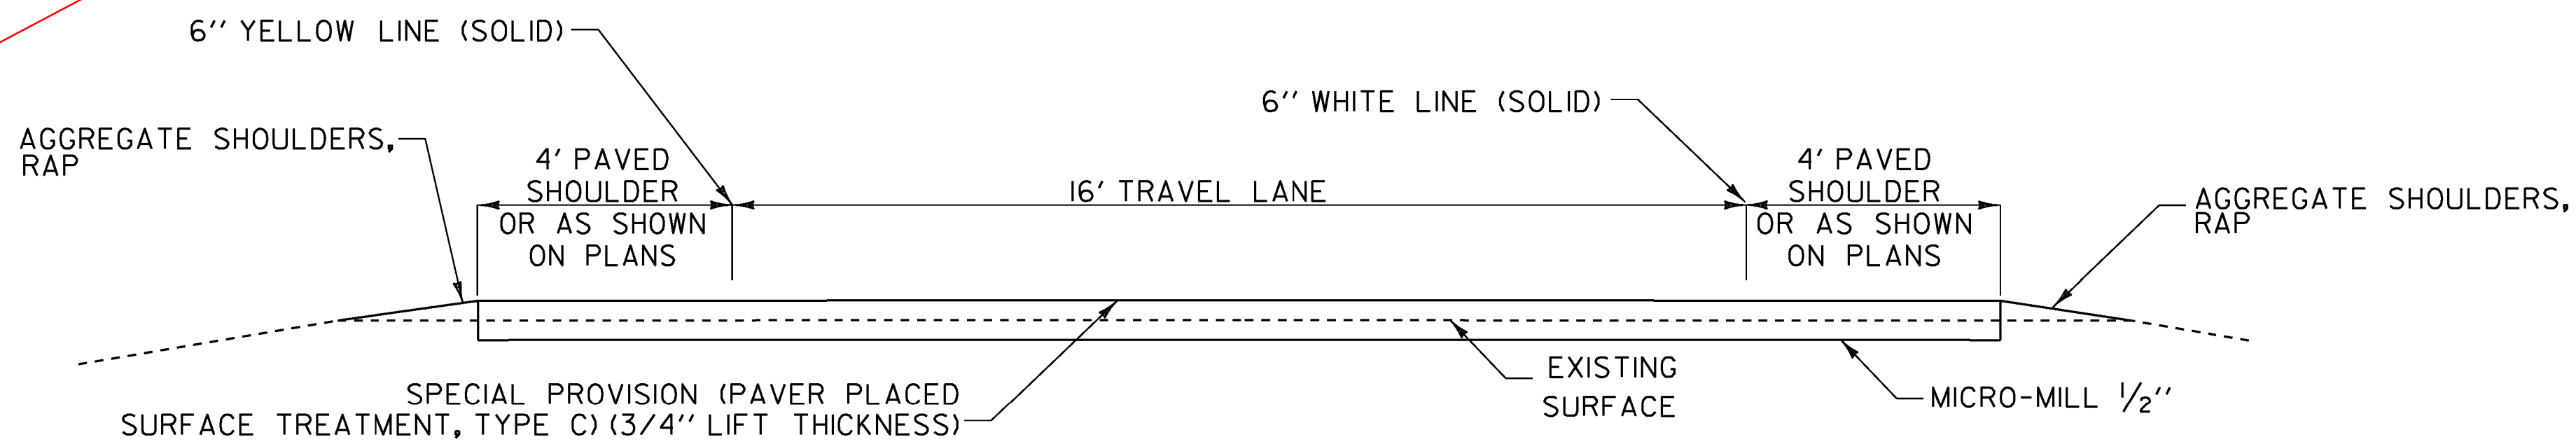

TYPICAL RAMP SECTION

ALTERNATE A

NOT TO SCALE

ROADWAY PROJECT TYPICAL SECTIONS - ALTERNATE A

I-89 NORTHBOUND RICHMOND M.M. 79.000 - COLCHESTER M.M. 91.880
I-89 SOUTHBOUND RICHMOND M.M. 79.000 - COLCHESTER M.M. 91.880

NOTES:

1. PERFORMANCE GRADED BINDER SHALL BE PG 70-28.

TYPICAL SECTION - ALTERNATE A

PROJECT NAME: RICHMOND - COLCHESTER
 PROJECT NUMBER: IM SURF (38)

FILE NAME: I3a136\pl3a136.dgn
 PROJECT LEADER: M. FOWLER
 DESIGNED BY: LOCKE
 IPARM FILE NAME: pl3a136+yp1.i

PLOT DATE: 17-JAN-2014
 DRAWN BY: LOCKE
 CHECKED BY: FOWLER
 SHEET 2 OF 41