


↑
SOUTHBOUND
DIRECTION OF TRAVEL

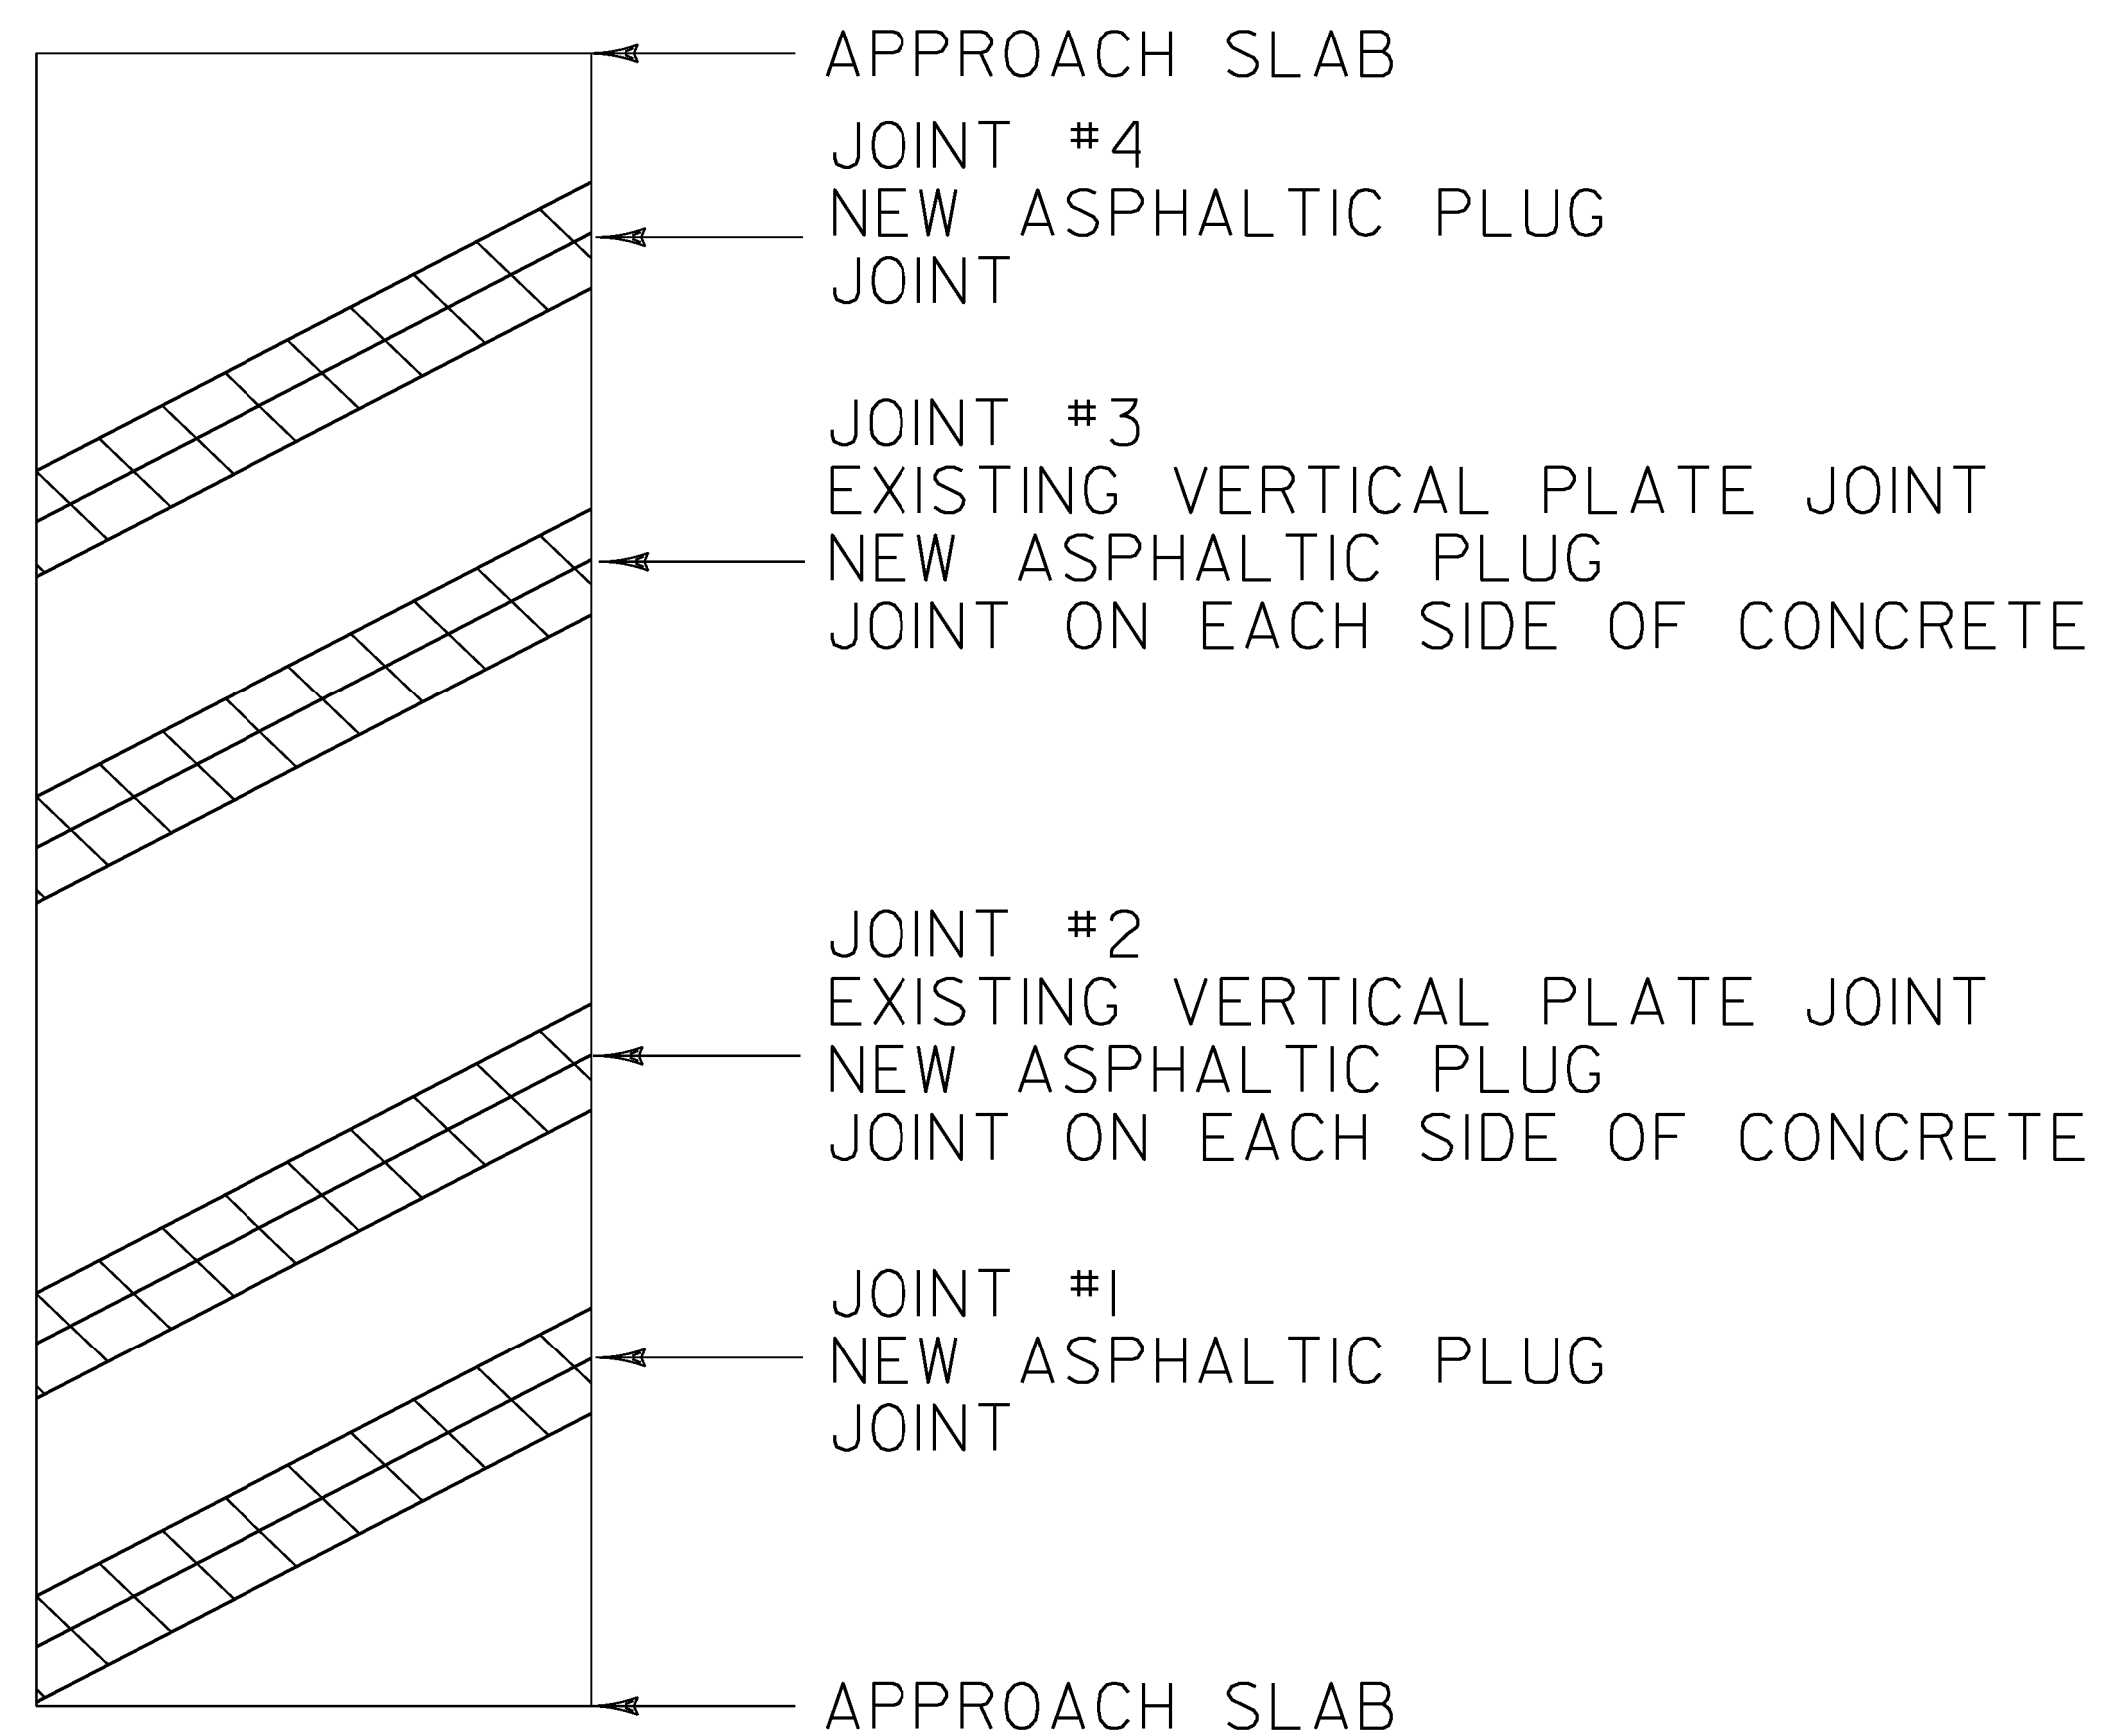

BRIDGE 74S


MM 91.488

LENGTH OF ASPHALTIC PLUG JOINTS:

JOINT #1 - 39' 30.5
 JOINT #2 30.5 39' X 2 = 78' 61
 JOINT #3 30.5 39' X 2 = 78' 61
 JOINT #4 - 39' 30.5

~~TOTAL = 234'~~

LEGEND

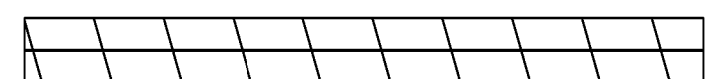

EXISTING BRIDGE JOINTS TO BE
 REPAIRED WITH ASPHALTIC PLUG JOINT.
 SEE SHEETS 12 & 13 FOR ARMORED JOINT
 DETAILS.

**BRIDGE
 DETAIL SHEET
 # 7**

PROJECT NAME: RICHMOND - COLCHESTER

PROJECT NUMBER: IM SURF (38)

FILE NAME: I3a136\p13a136.dgn
 PROJECT LEADER: M. FOWLER
 DESIGNED BY: LOCKE
 IPARM FILE NAME: p13a136bd7.i

PLOT DATE: 19-DEC-2013
 DRAWN BY: LOCKE
 CHECKED BY: FOWLER
 SHEET 11 OF 41