

TEMPORARY 6 INCH WHITE LINE, PAINT

EXIT 12
 NORTHBOUND OFF RAMP A SOLID RT EDGE LINE
 INTERSTATE 89 DOTTED RT LANE LINE
 NORTHBOUND OFF RAMP A SOLID LANE LINE
 NORTHBOUND ON RAMP D SOLID RT EDGE LINE
 INTERSTATE 89 DOTTED RT LANE LINE

TEMPORARY 6 INCH YELLOW LINE, PAINT

EXIT 12
 NORTHBOUND OFF RAMP A SOLID LT EDGE LINE
 NORTHBOUND ON RAMP D SOLID LT EDGE LINE


**INTERCHANGE #12
 (NORTHBOUND)**

TEMPORARY 24 INCH STOP BAR, PAINT

EXIT 12
 NORTHBOUND OFF RAMP A AT VT 2A

DURABLE 24 INCH STOP BAR, POLYUREA

EXIT 12
 NORTHBOUND OFF RAMP A AT VT 2A

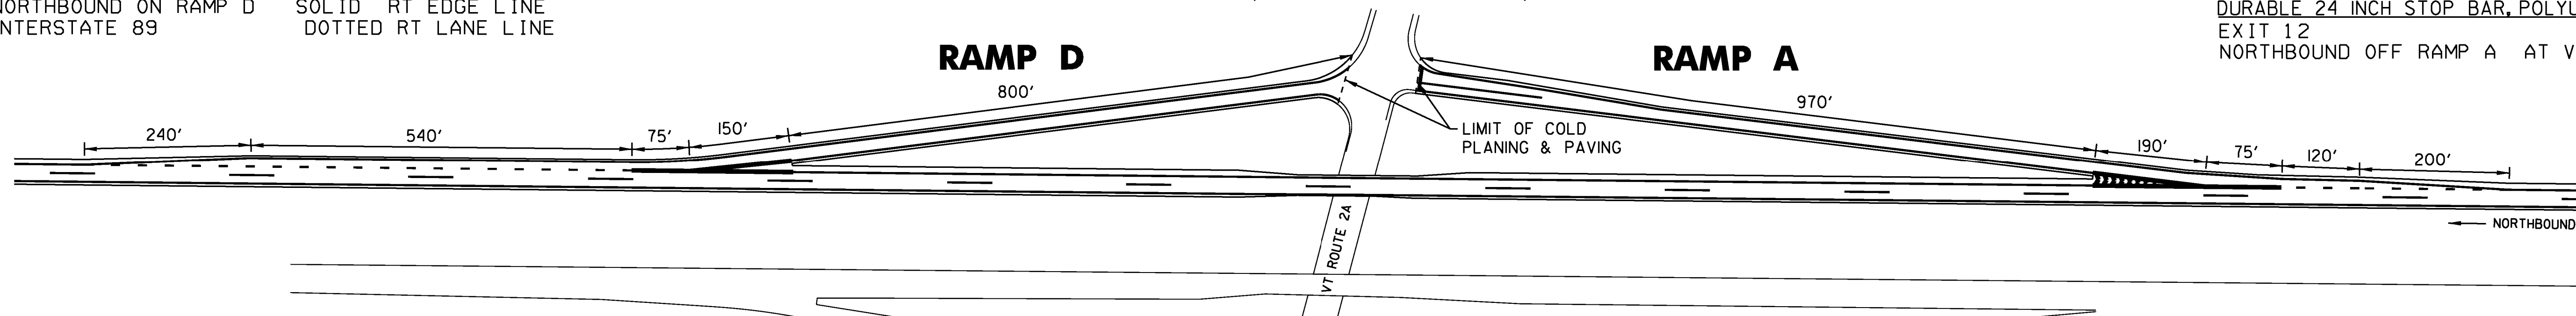

DURABLE 6 INCH WHITE LINE, POLYUREA

EXIT 12
 NORTHBOUND OFF RAMP A SOLID RT EDGE LINE
 INTERSTATE 89 DOTTED RT LANE LINE
 NORTHBOUND OFF RAMP A SOLID LANE LINE
 NORTHBOUND ON RAMP D SOLID RT EDGE LINE
 INTERSTATE 89 DOTTED RT LANE LINE

DURABLE 6 INCH YELLOW LINE, POLYUREA


EXIT 12
 NORTHBOUND OFF RAMP A SOLID LT EDGE LINE
 NORTHBOUND ON RAMP D SOLID LT EDGE LINE

TEMPORARY LETTER OR SYMBOL, PAINT

EXIT 12
 NORTHBOUND OFF RAMP A "SIGNAL"
 NORTHBOUND OFF RAMP A "AHEAD"
 NORTHBOUND OFF RAMP A [Symbol: arrow pointing right]
 NORTHBOUND OFF RAMP A "ONLY" "ONLY"
 NORTHBOUND OFF RAMP A [Symbol: two arrows pointing left]
 NORTHBOUND OFF RAMP A "ONLY" "ONLY"
 NORTHBOUND OFF RAMP A [Symbol: two arrows pointing right]

DURABLE LETTER OR SYMBOL, POLYUREA

EXIT 12
 NORTHBOUND OFF RAMP A "SIGNAL"
 NORTHBOUND OFF RAMP A "AHEAD"
 NORTHBOUND OFF RAMP A [Symbol: arrow pointing right]
 NORTHBOUND OFF RAMP A "ONLY" "ONLY"
 NORTHBOUND OFF RAMP A [Symbol: two arrows pointing left]
 NORTHBOUND OFF RAMP A "ONLY" "ONLY"
 NORTHBOUND OFF RAMP A [Symbol: two arrows pointing right]

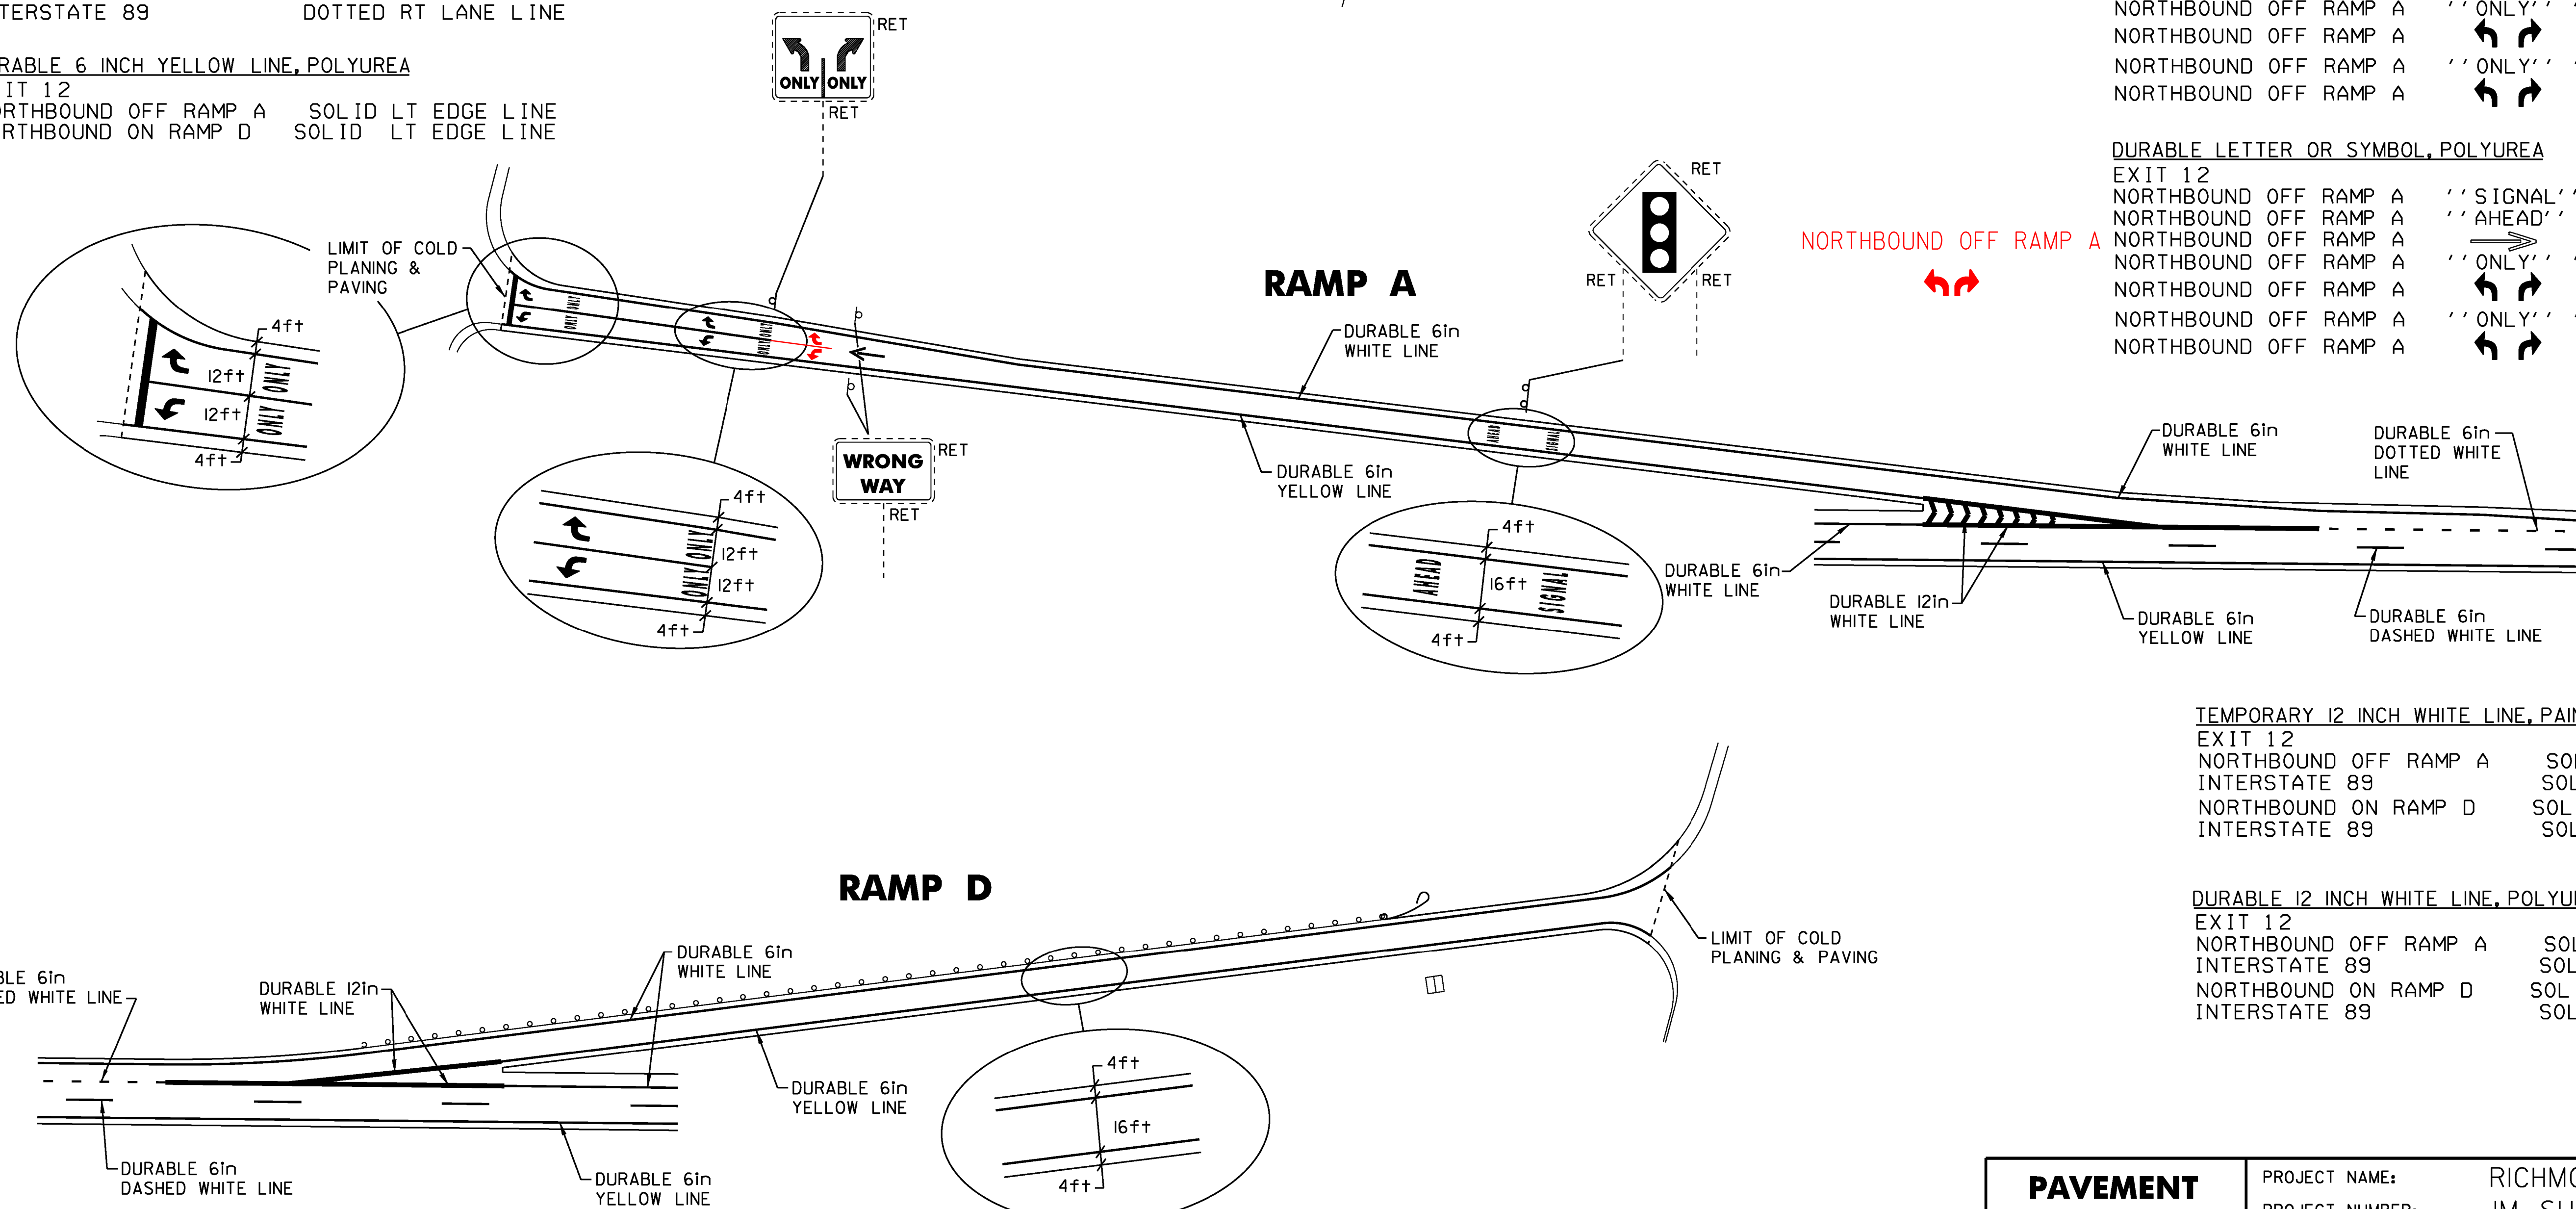

TEMPORARY 12 INCH WHITE LINE, PAINT

EXIT 12
 NORTHBOUND OFF RAMP A SOLID LT GORE AREA
 INTERSTATE 89 SOLID RT GORE AREA
 NORTHBOUND ON RAMP D SOLID LT GORE AREA
 INTERSTATE 89 SOLID RT GORE AREA

DURABLE 12 INCH WHITE LINE, POLYUREA

EXIT 12
 NORTHBOUND OFF RAMP A SOLID LT GORE AREA
 INTERSTATE 89 SOLID RT GORE AREA
 NORTHBOUND ON RAMP D SOLID LT GORE AREA
 INTERSTATE 89 SOLID RT GORE AREA

NOT TO SCALE

**PAVEMENT
 MARKING
 DETAIL SHEET 3
 EXIT 12 NB**

PROJECT NAME: RICHMOND - COLCHESTER
 PROJECT NUMBER: IM SURF (38)
 FILE NAME: pl3al36.dgn
 PROJECT LEADER: M. FOWLER
 DESIGNED BY: LOCKE
 IPARM FILE NAME: pl3al36pmd3.i
 PLOT DATE: 19-DEC-2013
 DRAWN BY: LOCKE
 CHECKED BY: FOWLER
 SHEET 19 OF 41