


INTERCHANGE #12 (SOUTHBOUND)

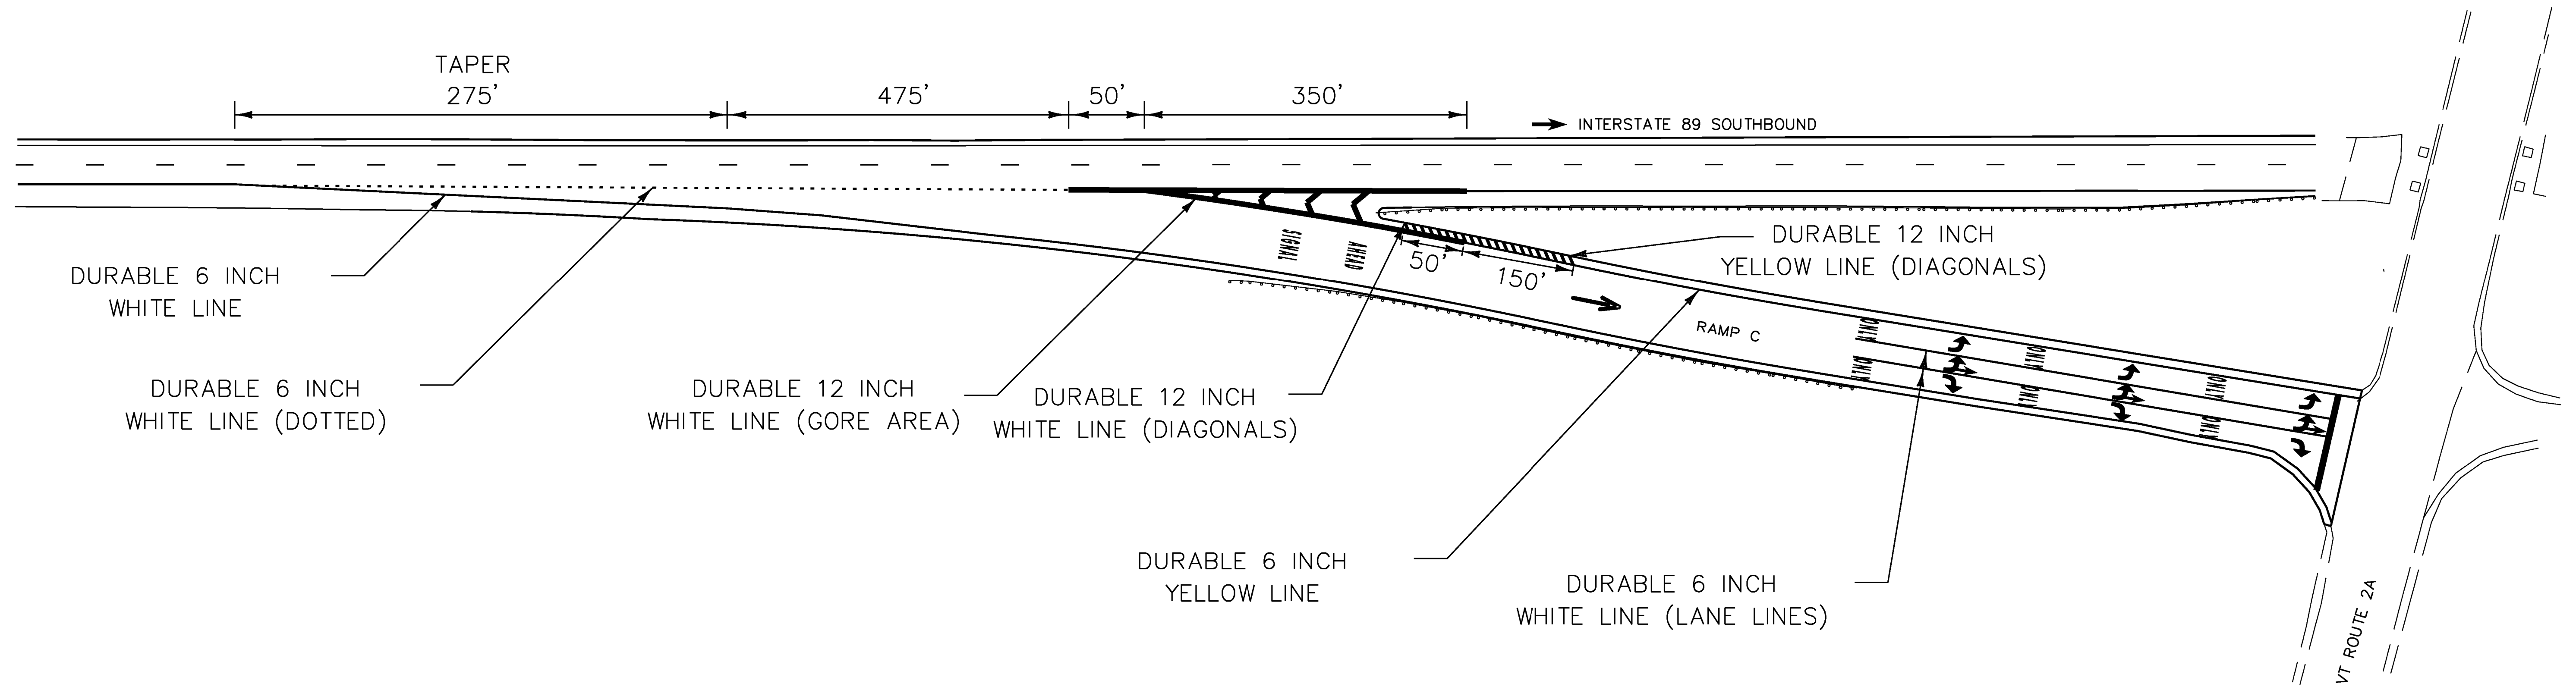

- TEMPORARY 6 INCH WHITE LINE, PAINT
- EXIT 12
- SOUTHBOUND OFF RAMP C SOLID RT EDGE LINE
- INTERSTATE 89 DOTTED LT LANE LINE
- SOUTHBOUND OFF RAMP C SOLID LANE LINES

- TEMPORARY 6 INCH YELLOW LINE, PAINT
- EXIT 12
- SOUTHBOUND OFF RAMP C SOLID LT EDGE LINE

- TEMPORARY 12 INCH WHITE LINE, PAINT
- EXIT 12
- SOUTHBOUND OFF RAMP C SOLID LT GORE AREA
- INTERSTATE 89 SOLID LT GORE AREA
- SOUTHBOUND OFF RAMP C SOLID LT DIAGONALS

- TEMPORARY 12 INCH YELLOW LINE, PAINT
- EXIT 12
- SOUTHBOUND OFF RAMP C SOLID LT DIAGONALS

- TEMPORARY LETTER OR SYMBOL, PAINT
- EXIT 12
- SOUTHBOUND OFF RAMP C " SIGNAL "
- SOUTHBOUND OFF RAMP C " AHEAD "
- SOUTHBOUND OFF RAMP C
- SOUTHBOUND OFF RAMP C " ONLY " " ONLY "
- SOUTHBOUND OFF RAMP C
- SOUTHBOUND OFF RAMP C " ONLY " " ONLY "
- SOUTHBOUND OFF RAMP C
- SOUTHBOUND OFF RAMP C " ONLY " " ONLY "
- SOUTHBOUND OFF RAMP C
- SOUTHBOUND OFF RAMP C " ONLY " " ONLY "

- TEMPORARY 24 INCH STOP BAR, PAINT
- EXIT 12
- SOUTHBOUND OFF RAMP C AT VT 2A

- DURABLE 6 INCH WHITE LINE, POLYUREA
- EXIT 12
- SOUTHBOUND OFF RAMP C SOLID RT EDGE LINE
- INTERSTATE 89 DOTTED LT LANE LINE
- SOUTHBOUND OFF RAMP C SOLID LANE LINES

- DURABLE 6 INCH YELLOW LINE, POLYUREA
- EXIT 12
- SOUTHBOUND OFF RAMP C SOLID LT EDGE LINE

- DURABLE 12 INCH WHITE LINE, POLYUREA
- EXIT 12
- SOUTHBOUND OFF RAMP C SOLID LT GORE AREA
- INTERSTATE 89 SOLID LT GORE AREA
- SOUTHBOUND OFF RAMP C SOLID LT DIAGONALS

- DURABLE 12 INCH YELLOW LINE, POLYUREA
- EXIT 12
- SOUTHBOUND OFF RAMP C SOLID LT DIAGONALS

- DURABLE LETTER OR SYMBOL, POLYUREA
- EXIT 12
- SOUTHBOUND OFF RAMP C " SIGNAL "
- SOUTHBOUND OFF RAMP C " AHEAD "
- SOUTHBOUND OFF RAMP C
- ~~SOUTHBOUND OFF RAMP C " ONLY " " ONLY "~~
- SOUTHBOUND OFF RAMP C
- SOUTHBOUND OFF RAMP C " ONLY " " ONLY "
- SOUTHBOUND OFF RAMP C
- SOUTHBOUND OFF RAMP C " ONLY " " ONLY "
- SOUTHBOUND OFF RAMP C
- SOUTHBOUND OFF RAMP C " ONLY " " ONLY "

- DURABLE 24 INCH STOP BAR, POLYUREA
- EXIT 12
- SOUTHBOUND OFF RAMP C AT VT 2A

NOT TO SCALE

PAVEMENT MARKING DETAIL SHEET 5 EXIT 12 SB	PROJECT NAME: RICHMOND - COLCHESTER
	PROJECT NUMBER: IM SURF (38)
	FILE NAME: pl3al36.dgn
PROJECT LEADER: M. FOWLER	PLOT DATE: 19-DEC-2013
DESIGNED BY: LOCKE	DRAWN BY: LOCKE
IPARM FILE NAME: pl3al36pmd5.i	CHECKED BY: FOWLER
	SHEET 21 OF 41