




# INTERCHANGE #14 (NORTHBOUND)

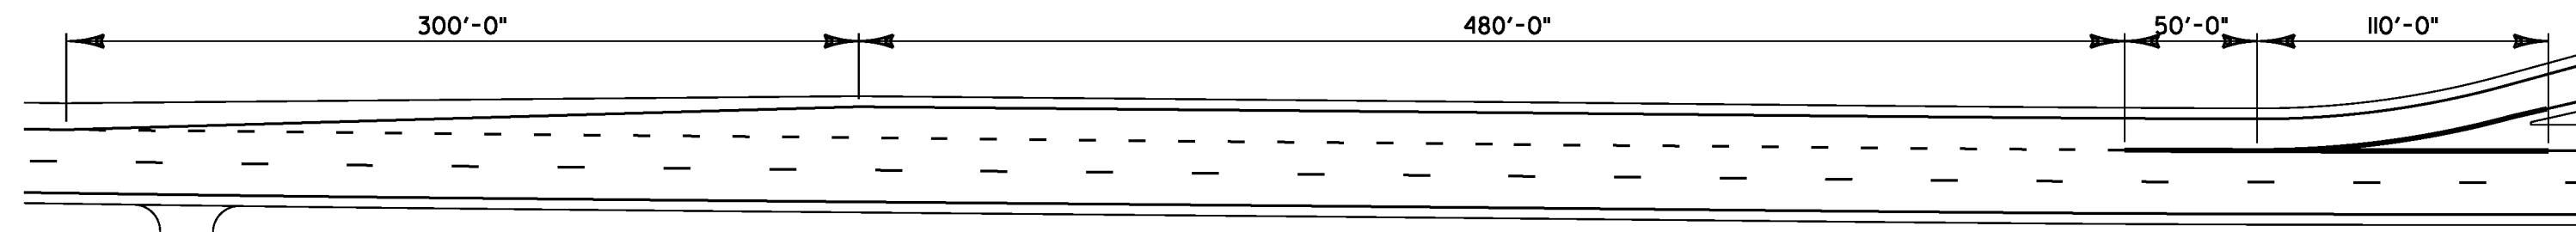

INSET A - GORE DETAIL AT EXIT 14 RAMP H

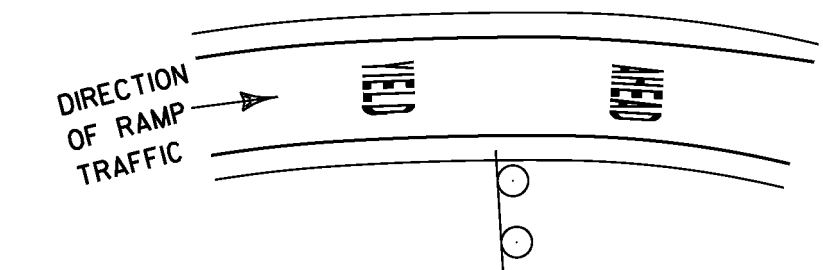

INSET B - PAVEMENT MARKING DETAIL

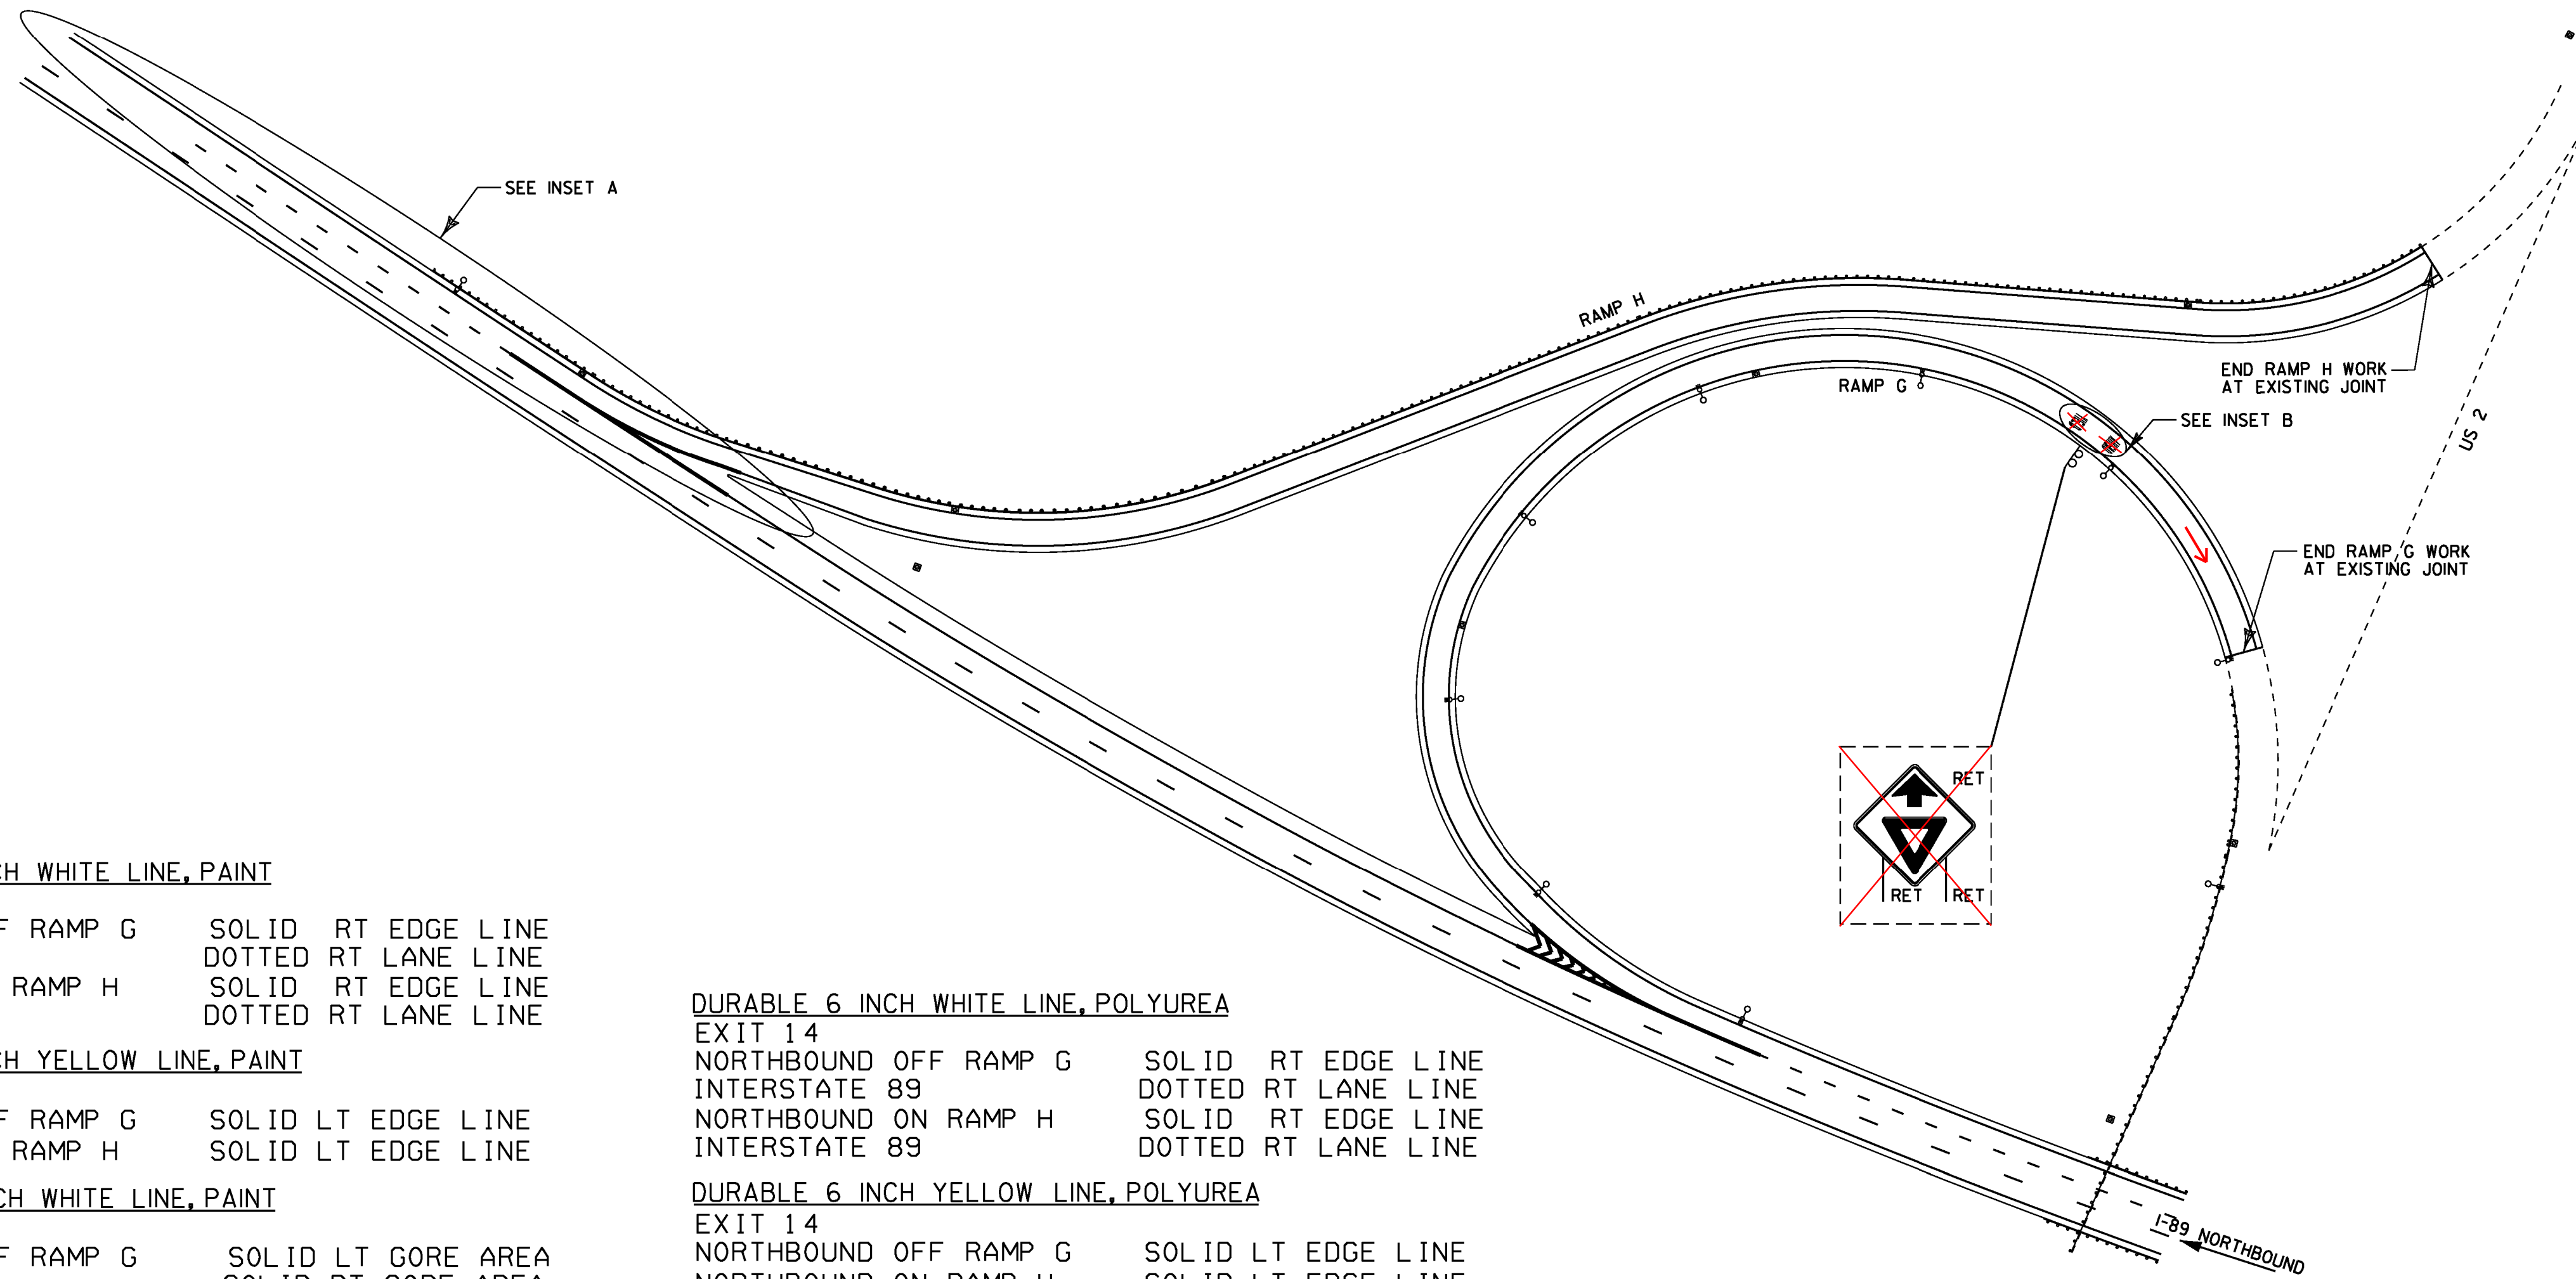

TEMPORARY 6 INCH WHITE LINE, PAINT

EXIT 14  
 NORTHBOUND OFF RAMP G SOLID RT EDGE LINE  
 INTERSTATE 89 DOTTED RT LANE LINE  
 NORTHBOUND ON RAMP H SOLID RT EDGE LINE  
 INTERSTATE 89 DOTTED RT LANE LINE

TEMPORARY 6 INCH YELLOW LINE, PAINT

EXIT 14  
 NORTHBOUND OFF RAMP G SOLID LT EDGE LINE  
 NORTHBOUND ON RAMP H SOLID LT EDGE LINE

TEMPORARY 12 INCH WHITE LINE, PAINT

EXIT 14  
 NORTHBOUND OFF RAMP G SOLID LT GORE AREA  
 INTERSTATE 89 SOLID RT GORE AREA  
 NORTHBOUND ON RAMP H SOLID LT GORE AREA  
 INTERSTATE 89 SOLID RT GORE AREA

TEMPORARY LETTER OR SYMBOL, PAINT

EXIT 14  
 NORTHBOUND OFF RAMP G "YIELD"  
 NORTHBOUND OFF RAMP G "AHEAD"  
 NORTHBOUND OFF RAMP G ➡

DURABLE 6 INCH WHITE LINE, POLYUREA

EXIT 14  
 NORTHBOUND OFF RAMP G SOLID RT EDGE LINE  
 INTERSTATE 89 DOTTED RT LANE LINE  
 NORTHBOUND ON RAMP H SOLID RT EDGE LINE  
 INTERSTATE 89 DOTTED RT LANE LINE

DURABLE 6 INCH YELLOW LINE, POLYUREA

EXIT 14  
 NORTHBOUND OFF RAMP G SOLID LT EDGE LINE  
 NORTHBOUND ON RAMP H SOLID LT EDGE LINE

TEMPORARY 12 INCH WHITE LINE, POLYUREA

EXIT 14  
 NORTHBOUND OFF RAMP G SOLID LT GORE AREA  
 INTERSTATE 89 SOLID RT GORE AREA  
 NORTHBOUND ON RAMP H SOLID LT GORE AREA  
 INTERSTATE 89 SOLID RT GORE AREA

DURABLE LETTER OR SYMBOL, POLYUREA

EXIT 14  
~~NORTHBOUND OFF RAMP G "YIELD"~~  
~~NORTHBOUND OFF RAMP G "AHEAD"~~  
 NORTHBOUND OFF RAMP G ➡

NOT TO SCALE

**PAVEMENT  
MARKING  
DETAIL SHEET 9  
EXIT 14 NB**

PROJECT NAME: RICHMOND - COLCHESTER	
PROJECT NUMBER: IM SURF (38)	
FILE NAME: pl3al36.dgn	PLOT DATE: 19-DEC-2013
PROJECT LEADER: M. FOWLER	DRAWN BY: LOCKE
DESIGNED BY: LOCKE	CHECKED BY: FOWLER
IPARM FILE NAME: pl3al36pmd9.i	SHEET 25 OF 41