


INTERCHANGE #14 (SOUTHBOUND)

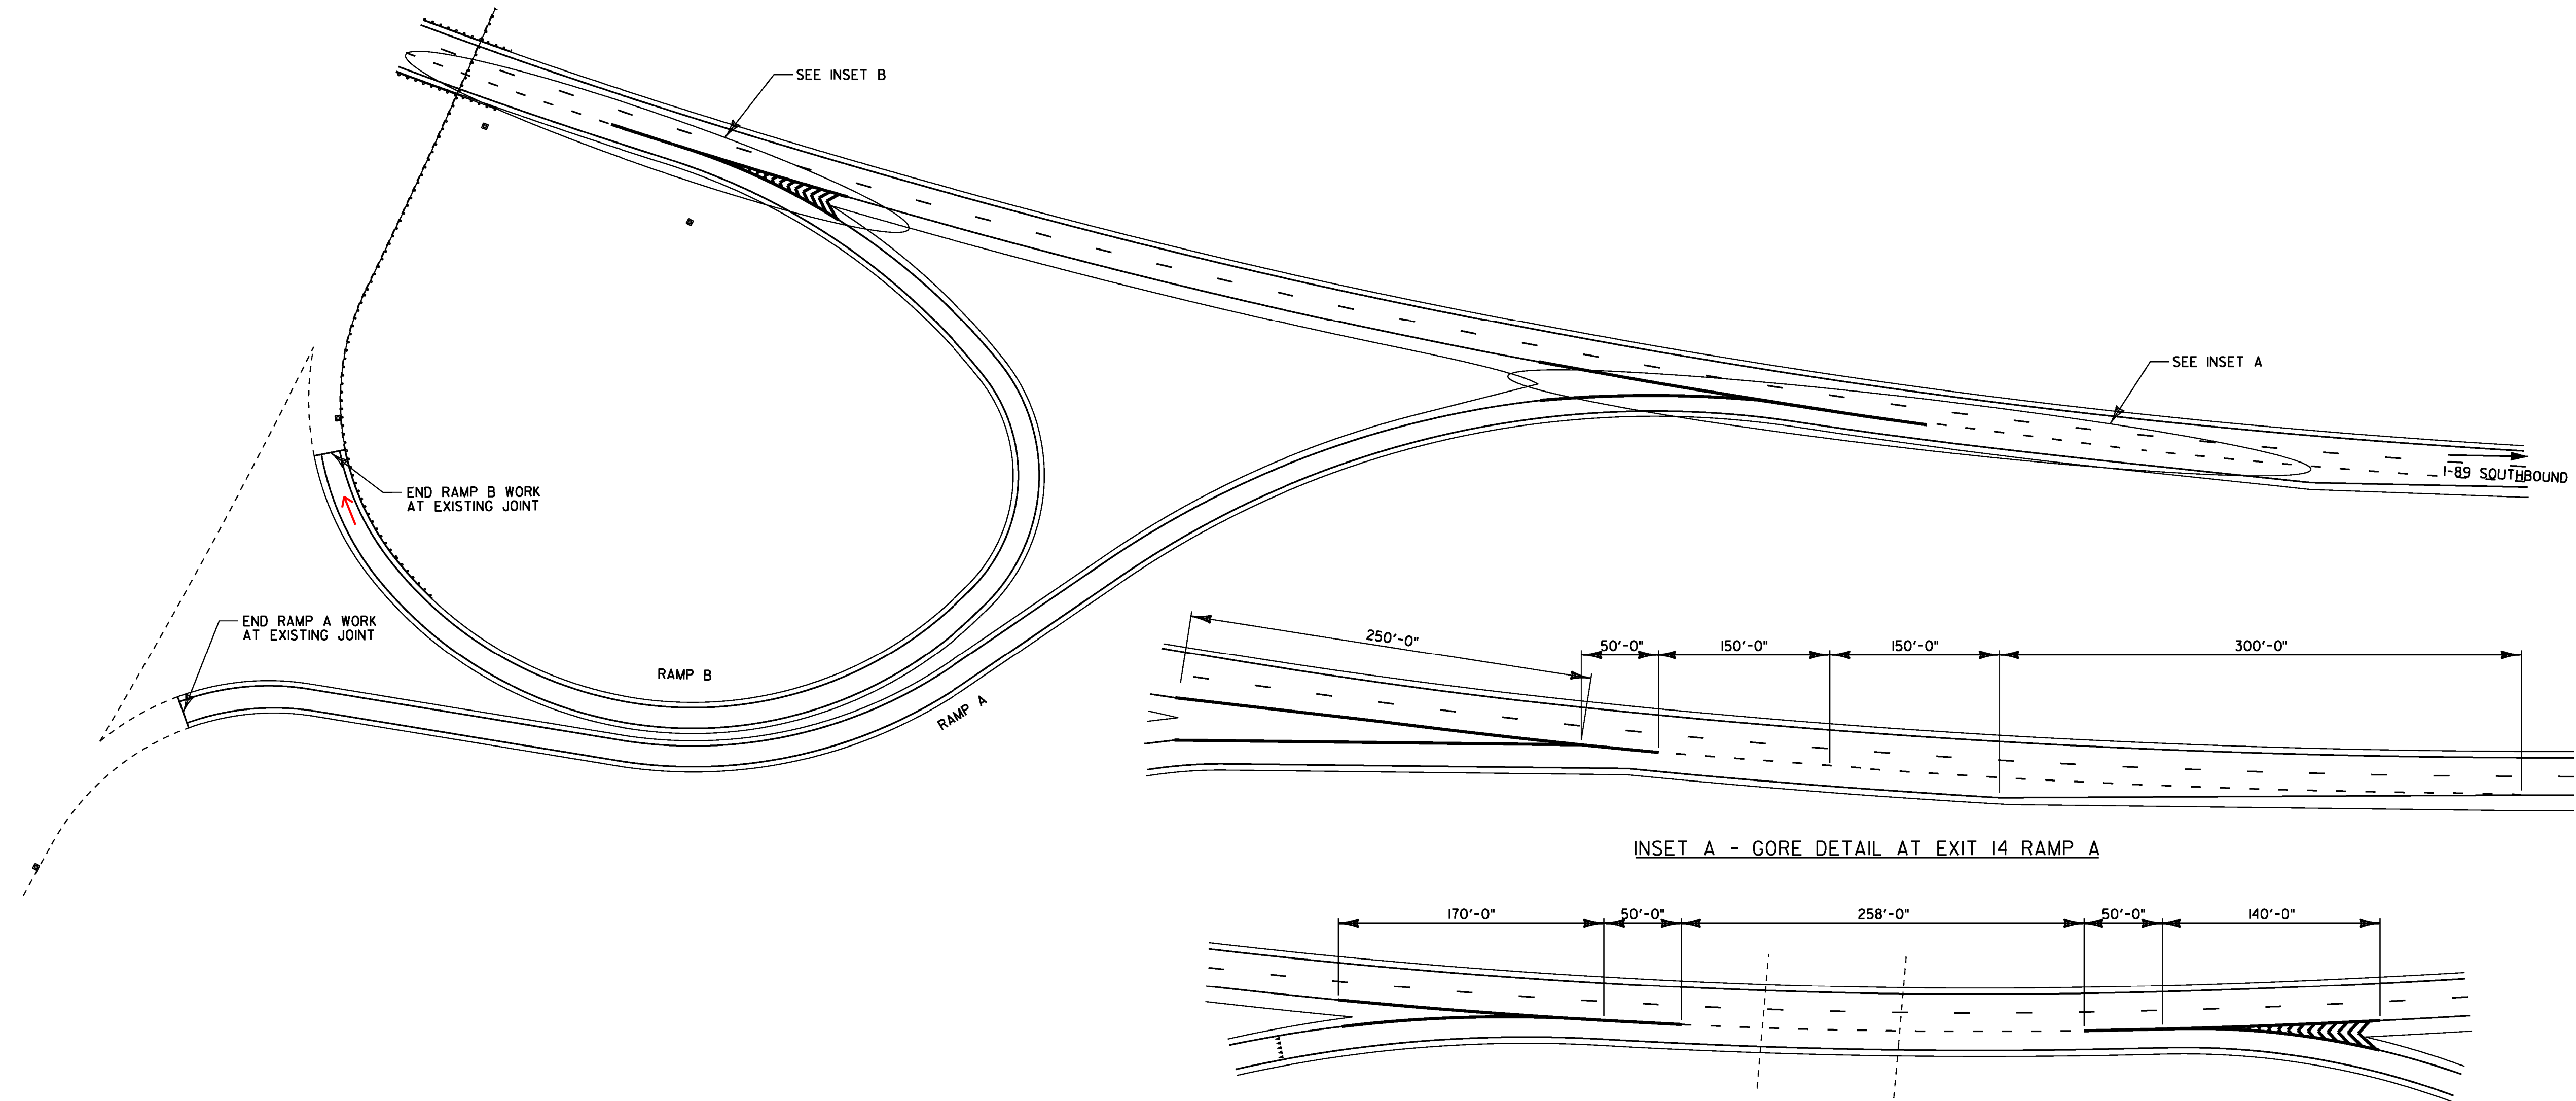

| | |
|--|---------------------|
| <u>TEMPORARY 6 INCH WHITE LINE, PAINT</u> | |
| EXIT 14 | |
| SOUTHBOUND OFF RAMP B | SOLID RT EDGE LINE |
| INTERSTATE 89 | DOTTED LT LANE LINE |
| SOUTHBOUND ON RAMP A | SOLID RT EDGE LINE |
| INTERSTATE 89 | DOTTED LT LANE LINE |
| <u>TEMPORARY 6 INCH YELLOW LINE, PAINT</u> | |
| EXIT 14 | |
| SOUTHBOUND OFF RAMP B | SOLID LT EDGE LINE |
| SOUTHBOUND ON RAMP A | SOLID LT EDGE LINE |
| <u>TEMPORARY 12 INCH WHITE LINE, PAINT</u> | |
| EXIT 14 | |
| SOUTHBOUND OFF RAMP B | SOLID LT GORE AREA |
| INTERSTATE 89 | SOLID LT GORE AREA |
| SOUTHBOUND ON RAMP A | SOLID LT GORE AREA |
| INTERSTATE 89 | SOLID LT GORE AREA |

| | |
|---|---------------------|
| <u>DURABLE 6 INCH WHITE LINE, POLYUREA</u> | |
| EXIT 14 | |
| SOUTHBOUND OFF RAMP B | SOLID RT EDGE LINE |
| INTERSTATE 89 | DOTTED LT LANE LINE |
| SOUTHBOUND ON RAMP A | SOLID RT EDGE LINE |
| INTERSTATE 89 | DOTTED LT LANE LINE |
| <u>DURABLE 6 INCH YELLOW LINE, POLYUREA</u> | |
| EXIT 14 | |
| SOUTHBOUND OFF RAMP B | SOLID LT EDGE LINE |
| SOUTHBOUND ON RAMP A | SOLID LT EDGE LINE |
| <u>DURABLE 12 INCH WHITE LINE, POLYUREA</u> | |
| EXIT 14 | |
| SOUTHBOUND OFF RAMP B | SOLID LT GORE AREA |
| INTERSTATE 89 | SOLID LT GORE AREA |
| SOUTHBOUND ON RAMP A | SOLID LT GORE AREA |
| INTERSTATE 89 | SOLID LT GORE AREA |

INSET B - GORE DETAIL AT EXIT 14 RAMP B & D

DURABLE LETTER OR SYMBOL, POLYUREA
EXIT 14
SOUTHBOUND OFF RAMP B →

**PAVEMENT
MARKING
DETAIL SHEET 11
EXIT 14 SB**

| | | |
|--------------------------------|-----------------------|------------------------|
| PROJECT NAME: | RICHMOND - COLCHESTER | |
| PROJECT NUMBER: | IM SURF (38) | |
| FILE NAME: pl3al36.dgn | DESIGNED BY: LOCKE | PLOT DATE: 19-DEC-2013 |
| PROJECT LEADER: M. FOWLER | DESIGNED BY: LOCKE | DRAWN BY: LOCKE |
| IPARM FILE NAME: pl3al36pmdl.l | DESIGNED BY: LOCKE | CHECKED BY: FOWLER |
| | | SHEET 27 OF 41 |

NOT TO SCALE