

# INTERCHANGE #16

## TEMPORARY 6 INCH WHITE LINE, PAINT

EXIT 16	
NORTHBOUND OFF RAMP D	SOLID RT EDGE LINE
NORTHBOUND OFF RAMP D	SOLID RT LANE LINE
NORTHBOUND OFF RAMP D	SOLID RT LANE LINE
INTERSTATE 89	DOTTED RT LANE LINE
SOUTHBOUND ON RAMP C	SOLID RT EDGE LINE
INTERSTATE 89	DOTTED LT LANE LINE
NORTHBOUND ON RAMP B	SOLID RT EDGE LINE
INTERSTATE 89	DOTTED RT LANE LINE
SOUTHBOUND OFF RAMP A	SOLID RT EDGE LINE
SOUTHBOUND OFF RAMP A	SOLID RT LANE LINE
INTERSTATE 89	DOTTED LT LANE LINE

## TEMPORARY 6 INCH YELLOW LINE, PAINT

EXIT 16	
NORTHBOUND OFF RAMP D	SOLID LT EDGE LINE
SOUTHBOUND ON RAMP C	SOLID LT EDGE LINE
NORTHBOUND ON RAMP B	SOLID LT EDGE LINE
SOUTHBOUND OFF RAMP A	SOLID LT EDGE LINE

## TEMPORARY 12 INCH WHITE LINE, PAINT

EXIT 16	
NORTHBOUND OFF RAMP D	SOLID LT GORE AREA
INTERSTATE 89	SOLID RT GORE AREA
SOUTHBOUND ON RAMP C	SOLID LT GORE AREA
INTERSTATE 89	SOLID LT GORE AREA
NORTHBOUND OFF RAMP B	SOLID LT GORE AREA
INTERSTATE 89	SOLID RT GORE AREA
SOUTHBOUND OFF RAMP A	SOLID LT GORE AREA
INTERSTATE 89	SOLID LT GORE AREA

## TEMPORARY LETTER OR SYMBOL, PAINT

EXIT 16	
NORTHBOUND OFF RAMP D	“ SIGNAL ”
NORTHBOUND OFF RAMP D	“ AHEAD ”
NORTHBOUND OFF RAMP D	→
NORTHBOUND OFF RAMP D	“ ONLY ” “ ONLY ” “ ONLY ”
NORTHBOUND OFF RAMP D	↔ ↔ ↔
NORTHBOUND OFF RAMP D	“ ONLY ” “ ONLY ” “ ONLY ”
NORTHBOUND OFF RAMP D	↔ ↔ ↔
NORTHBOUND OFF RAMP D	“ ONLY ” “ ONLY ” “ ONLY ”
NORTHBOUND OFF RAMP D	↔ ↔ ↔
SOUTHBOUND OFF RAMP A	“ SIGNAL ”
SOUTHBOUND OFF RAMP A	“ AHEAD ”
SOUTHBOUND OFF RAMP A	→
SOUTHBOUND OFF RAMP A	“ ONLY ”
SOUTHBOUND OFF RAMP A	↔
SOUTHBOUND OFF RAMP A	“ ONLY ”
SOUTHBOUND OFF RAMP A	↔
SOUTHBOUND OFF RAMP A	↔

## DURABLE LETTER OR SYMBOL, POLYUREA

EXIT 16	
NORTHBOUND OFF RAMP D	“ SIGNAL ”
NORTHBOUND OFF RAMP D	“ AHEAD ”
NORTHBOUND OFF RAMP D	→
NORTHBOUND OFF RAMP D	“ ONLY ” “ ONLY ” “ ONLY ”
NORTHBOUND OFF RAMP D	↔ ↔ ↔
NORTHBOUND OFF RAMP D	“ ONLY ” “ ONLY ” “ ONLY ”
NORTHBOUND OFF RAMP D	↔ ↔ ↔
NORTHBOUND OFF RAMP D	“ ONLY ” “ ONLY ” “ ONLY ”
NORTHBOUND OFF RAMP D	↔ ↔ ↔
SOUTHBOUND OFF RAMP A	“ SIGNAL ”
SOUTHBOUND OFF RAMP A	“ AHEAD ”
SOUTHBOUND OFF RAMP A	→
SOUTHBOUND OFF RAMP A	“ ONLY ”
SOUTHBOUND OFF RAMP A	↔
SOUTHBOUND OFF RAMP A	“ ONLY ”
SOUTHBOUND OFF RAMP A	↔
SOUTHBOUND OFF RAMP A	↔

## DURABLE 6 INCH WHITE LINE, POLYUREA

EXIT 16	
NORTHBOUND OFF RAMP D	SOLID RT EDGE LINE
NORTHBOUND OFF RAMP D	SOLID RT LANE LINE
NORTHBOUND OFF RAMP D	SOLID RT LANE LINE
INTERSTATE 89	DOTTED RT LANE LINE
SOUTHBOUND ON RAMP C	SOLID RT EDGE LINE
INTERSTATE 89	DOTTED LT LANE LINE
NORTHBOUND ON RAMP B	SOLID RT EDGE LINE
INTERSTATE 89	DOTTED RT LANE LINE
SOUTHBOUND OFF RAMP A	SOLID RT EDGE LINE
SOUTHBOUND OFF RAMP A	SOLID RT LANE LINE
INTERSTATE 89	DOTTED LT LANE LINE

## DURABLE 12 INCH WHITE LINE, POLYUREA

EXIT 16	
NORTHBOUND OFF RAMP D	SOLID LT GORE AREA
INTERSTATE 89	SOLID RT GORE AREA
SOUTHBOUND ON RAMP C	SOLID LT GORE AREA
INTERSTATE 89	SOLID LT GORE AREA
NORTHBOUND OFF RAMP B	SOLID LT GORE AREA
INTERSTATE 89	SOLID RT GORE AREA
SOUTHBOUND OFF RAMP A	SOLID LT GORE AREA
INTERSTATE 89	SOLID LT GORE AREA

## TEMPORARY 24 INCH STOP BAR, PAINT


EXIT 16	
NORTHBOUND OFF RAMP D AT US 7	
SOUTHBOUND OFF RAMP A AT US 7	

## DURABLE 24 INCH STOP BAR, POLYUREA

EXIT 16	
NORTHBOUND OFF RAMP D AT US 7	
SOUTHBOUND OFF RAMP A AT US 7	

## DURABLE 6 INCH YELLOW LINE, POLYUREA

EXIT 16	
NORTHBOUND OFF RAMP D	SOLID LT EDGE LINE
SOUTHBOUND ON RAMP C	SOLID LT EDGE LINE
NORTHBOUND ON RAMP B	SOLID LT EDGE LINE
SOUTHBOUND OFF RAMP A	SOLID LT EDGE LINE

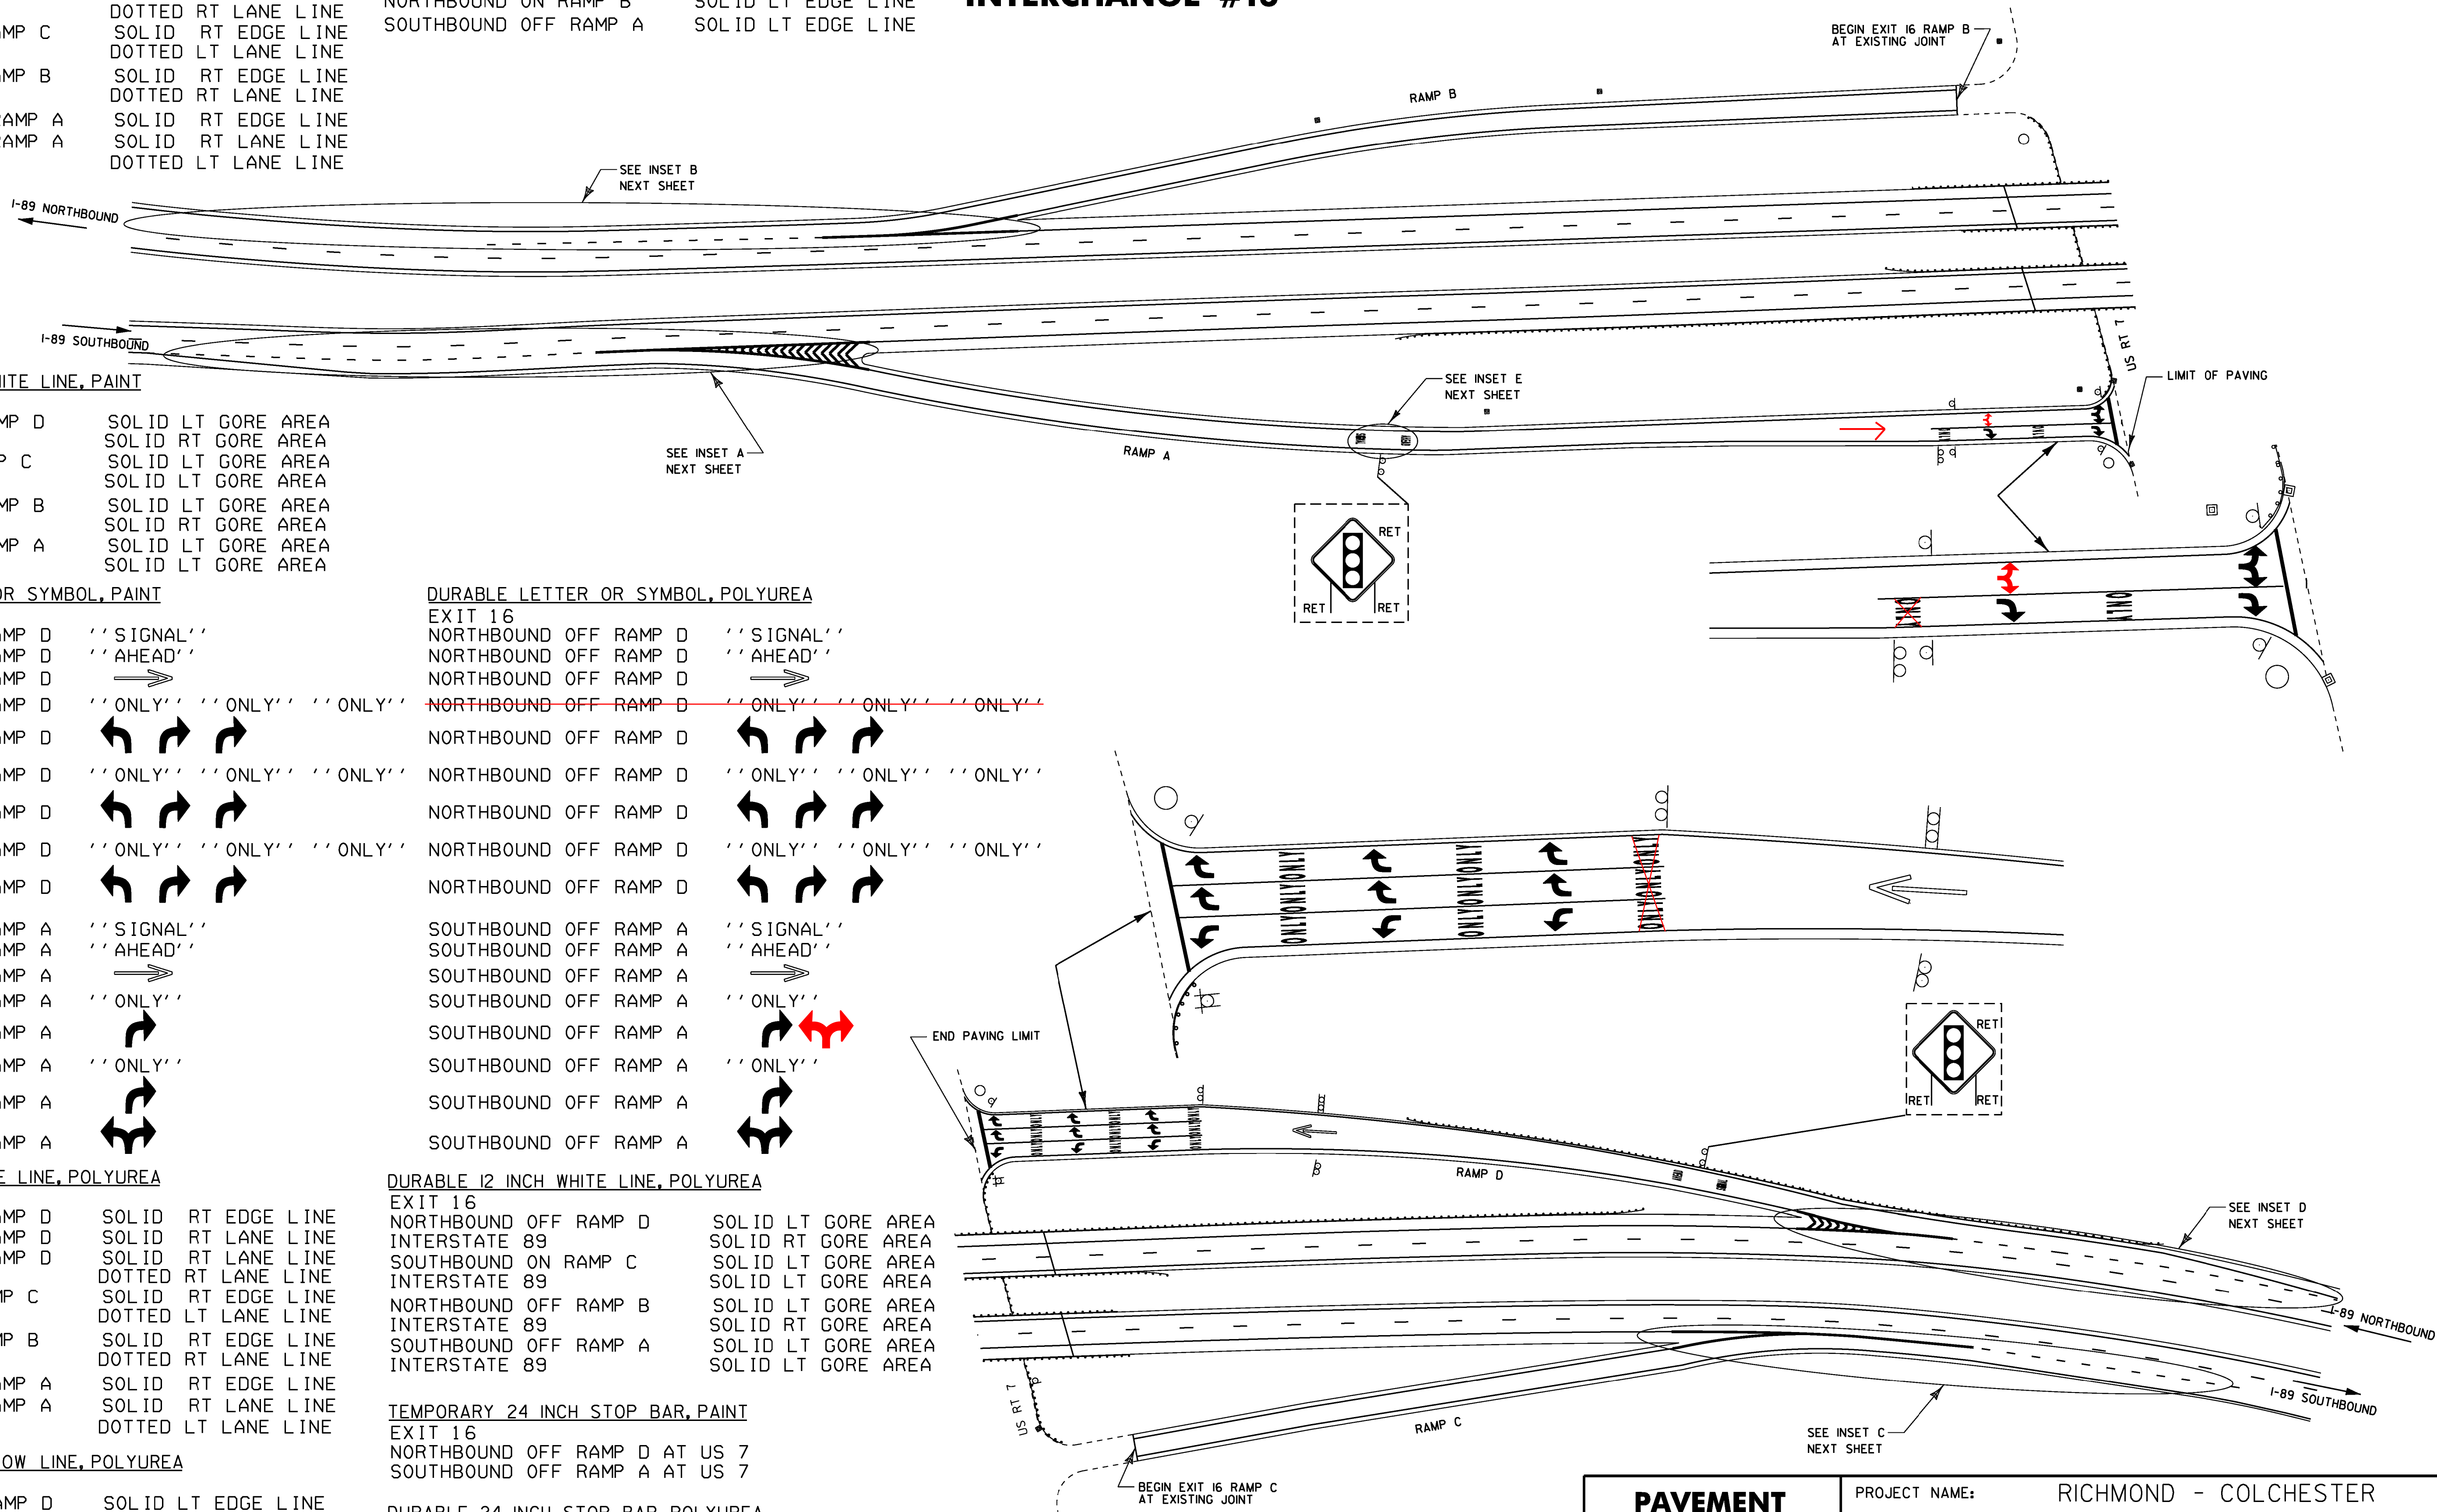

<b>PAVEMENT MARKING DETAIL SHEET 13 EXIT 16</b>	PROJECT NAME: RICHMOND - COLCHESTER
	PROJECT NUMBER: IM SURF (38)
	FILE NAME: pl3al36.dgn
	DESIGNED BY: LOCKE
IPARM FILE NAME: pl3al36pmd13.i	PLOT DATE: 19-DEC-2013
	DRAWN BY: LOCKE
	CHECKED BY: FOWLER
	SHEET 29 OF 41

NOT TO SCALE