



ROADWAY TYPICAL NORMAL SECTION
ALTERNATE A
 NOT TO SCALE

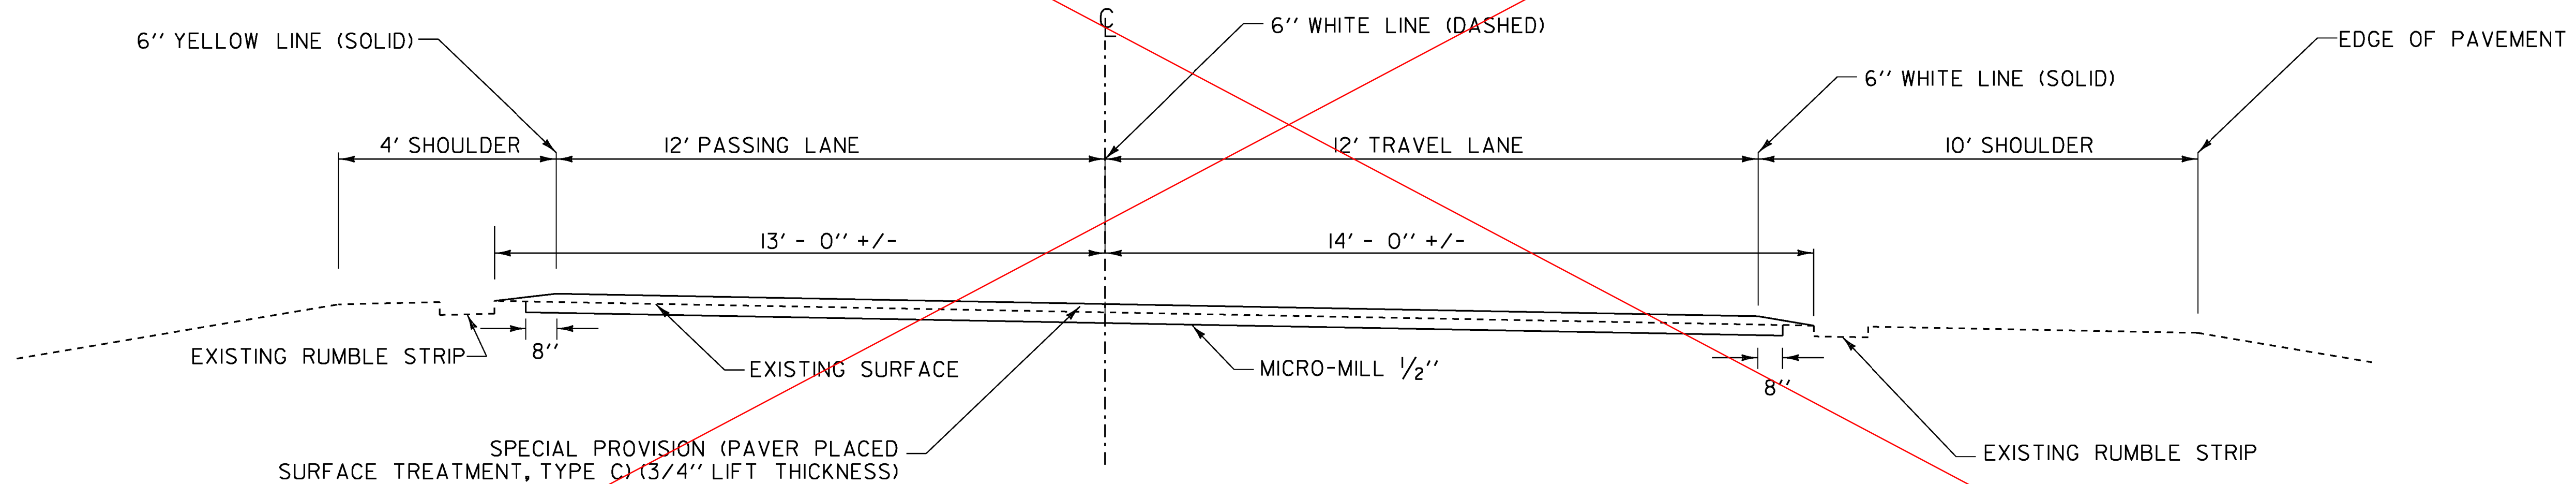

ROADWAY TYPICAL BANKED SECTION
ALTERNATE A
 NOT TO SCALE

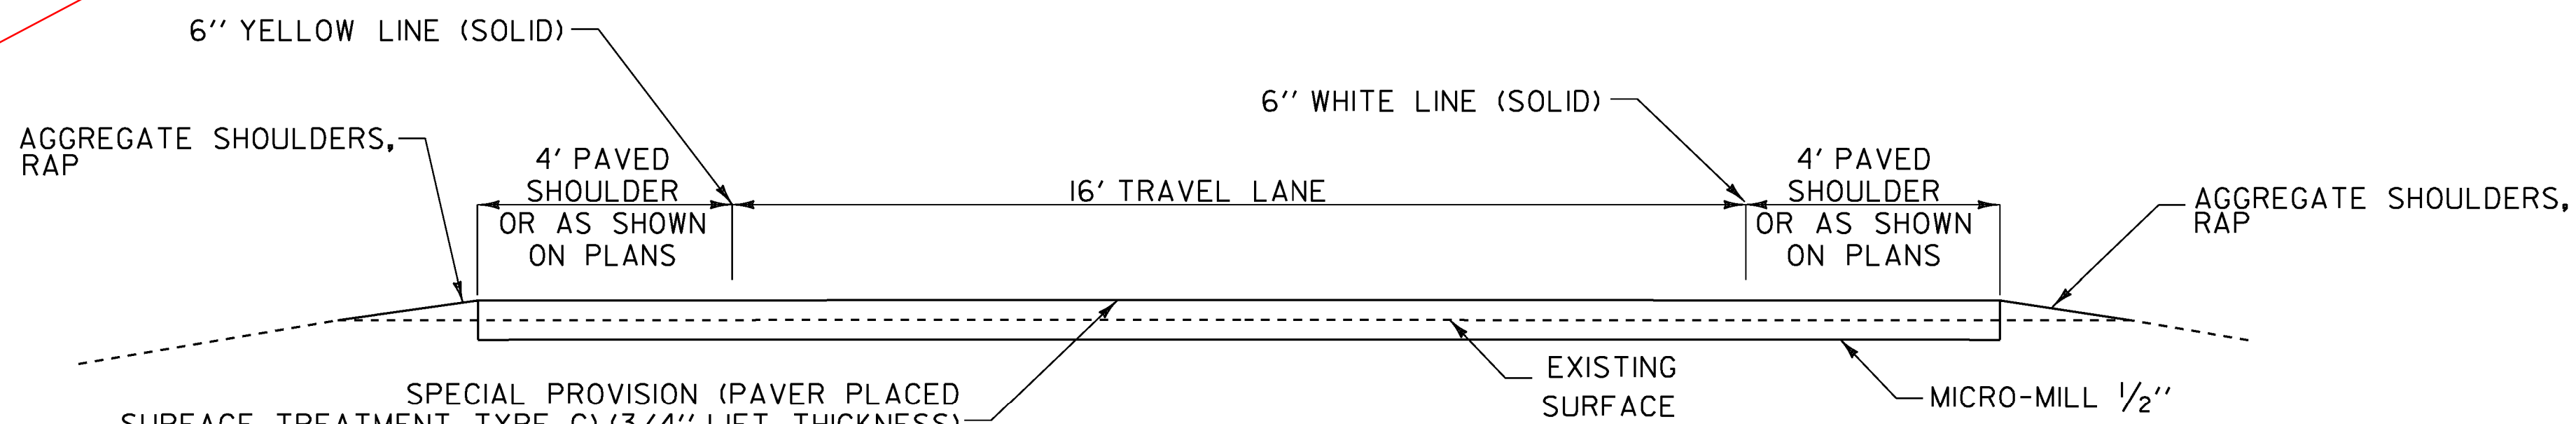

TYPICAL RAMP SECTION
ALTERNATE A
 NOT TO SCALE

ROADWAY PROJECT TYPICAL SECTIONS - ALTERNATE A

I-89 NORTHBOUND RICHMOND M.M. 79.000 - COLCHESTER M.M. 91.880
I-89 SOUTHBOUND RICHMOND M.M. 79.000 - COLCHESTER M.M. 91.880

NOTES:

1. PERFORMANCE GRADED BINDER SHALL BE PG 70-28.

TYPICAL SECTION - ALTERNATE A

PROJECT NAME: RICHMOND - COLCHESTER

PROJECT NUMBER: IM SURF (38)

FILE NAME: I3a136\p13a136.dgn

PROJECT LEADER: M. FOWLER

DESIGNED BY: LOCKE

IPARM FILE NAME: p13a136+yp1.i

PLOT DATE: 17-JAN-2014

DRAWN BY: LOCKE

CHECKED BY: FOWLER

SHEET 2 OF 41