

TEMPORARY 6 INCH WHITE LINE, PAINT

EXIT 12
 NORTHBOUND OFF RAMP A SOLID RT EDGE LINE
 INTERSTATE 89 DOTTED RT LANE LINE
 NORTHBOUND OFF RAMP A SOLID LANE LINE
 NORTHBOUND ON RAMP D SOLID RT EDGE LINE
 INTERSTATE 89 DOTTED RT LANE LINE

TEMPORARY 6 INCH YELLOW LINE, PAINT

EXIT 12
 NORTHBOUND OFF RAMP A SOLID LT EDGE LINE
 NORTHBOUND ON RAMP D SOLID LT EDGE LINE


**INTERCHANGE #12
 (NORTHBOUND)**

TEMPORARY 24 INCH STOP BAR, PAINT

EXIT 12
 NORTHBOUND OFF RAMP A AT VT 2A

DURABLE 24 INCH STOP BAR, POLYUREA

EXIT 12
 NORTHBOUND OFF RAMP A AT VT 2A

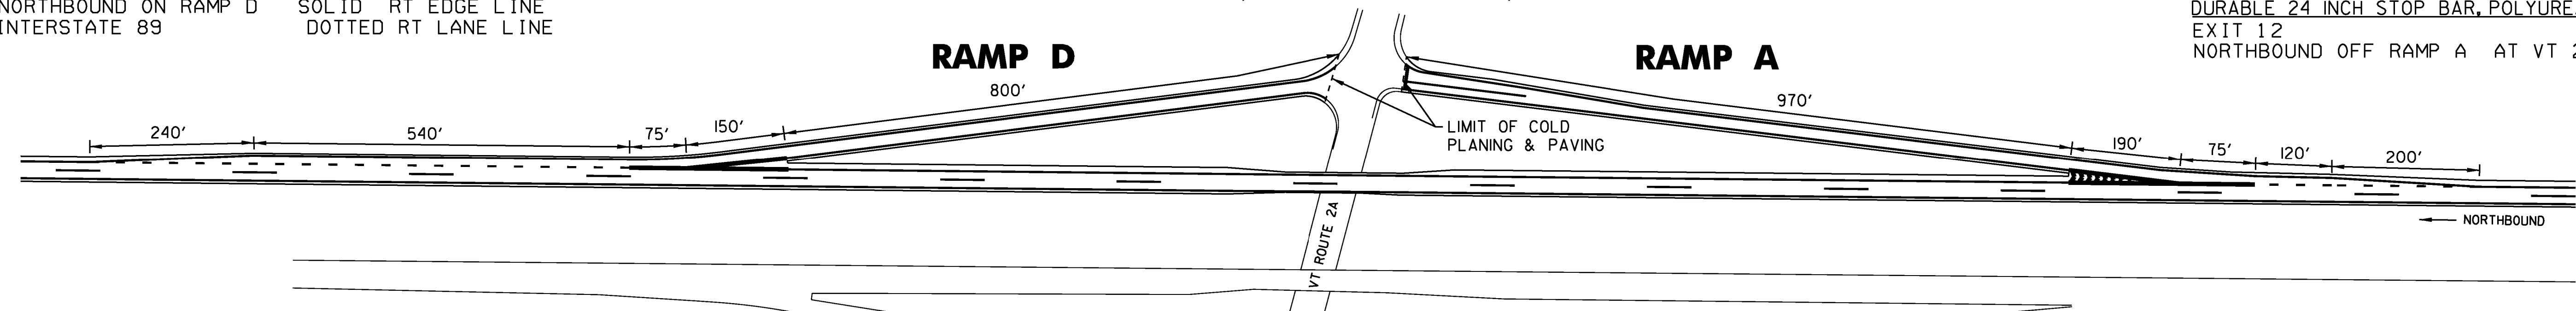

DURABLE 6 INCH WHITE LINE, POLYUREA

EXIT 12
 NORTHBOUND OFF RAMP A SOLID RT EDGE LINE
 INTERSTATE 89 DOTTED RT LANE LINE
 NORTHBOUND OFF RAMP A SOLID LANE LINE
 NORTHBOUND ON RAMP D SOLID RT EDGE LINE
 INTERSTATE 89 DOTTED RT LANE LINE

DURABLE 6 INCH YELLOW LINE, POLYUREA


EXIT 12
 NORTHBOUND OFF RAMP A SOLID LT EDGE LINE
 NORTHBOUND ON RAMP D SOLID LT EDGE LINE

TEMPORARY LETTER OR SYMBOL, PAINT

EXIT 12
 NORTHBOUND OFF RAMP A "SIGNAL"
 NORTHBOUND OFF RAMP A "AHEAD"
 NORTHBOUND OFF RAMP A [arrow symbol]
 NORTHBOUND OFF RAMP A "ONLY" "ONLY"
 NORTHBOUND OFF RAMP A [left/right arrows symbol]
 NORTHBOUND OFF RAMP A "ONLY" "ONLY"
 NORTHBOUND OFF RAMP A [left/right arrows symbol]

DURABLE LETTER OR SYMBOL, POLYUREA

EXIT 12
 NORTHBOUND OFF RAMP A "SIGNAL"
 NORTHBOUND OFF RAMP A "AHEAD"
 NORTHBOUND OFF RAMP A [arrow symbol]
 NORTHBOUND OFF RAMP A "ONLY" "ONLY"
 NORTHBOUND OFF RAMP A [left/right arrows symbol]
 NORTHBOUND OFF RAMP A "ONLY" "ONLY"
 NORTHBOUND OFF RAMP A [left/right arrows symbol]

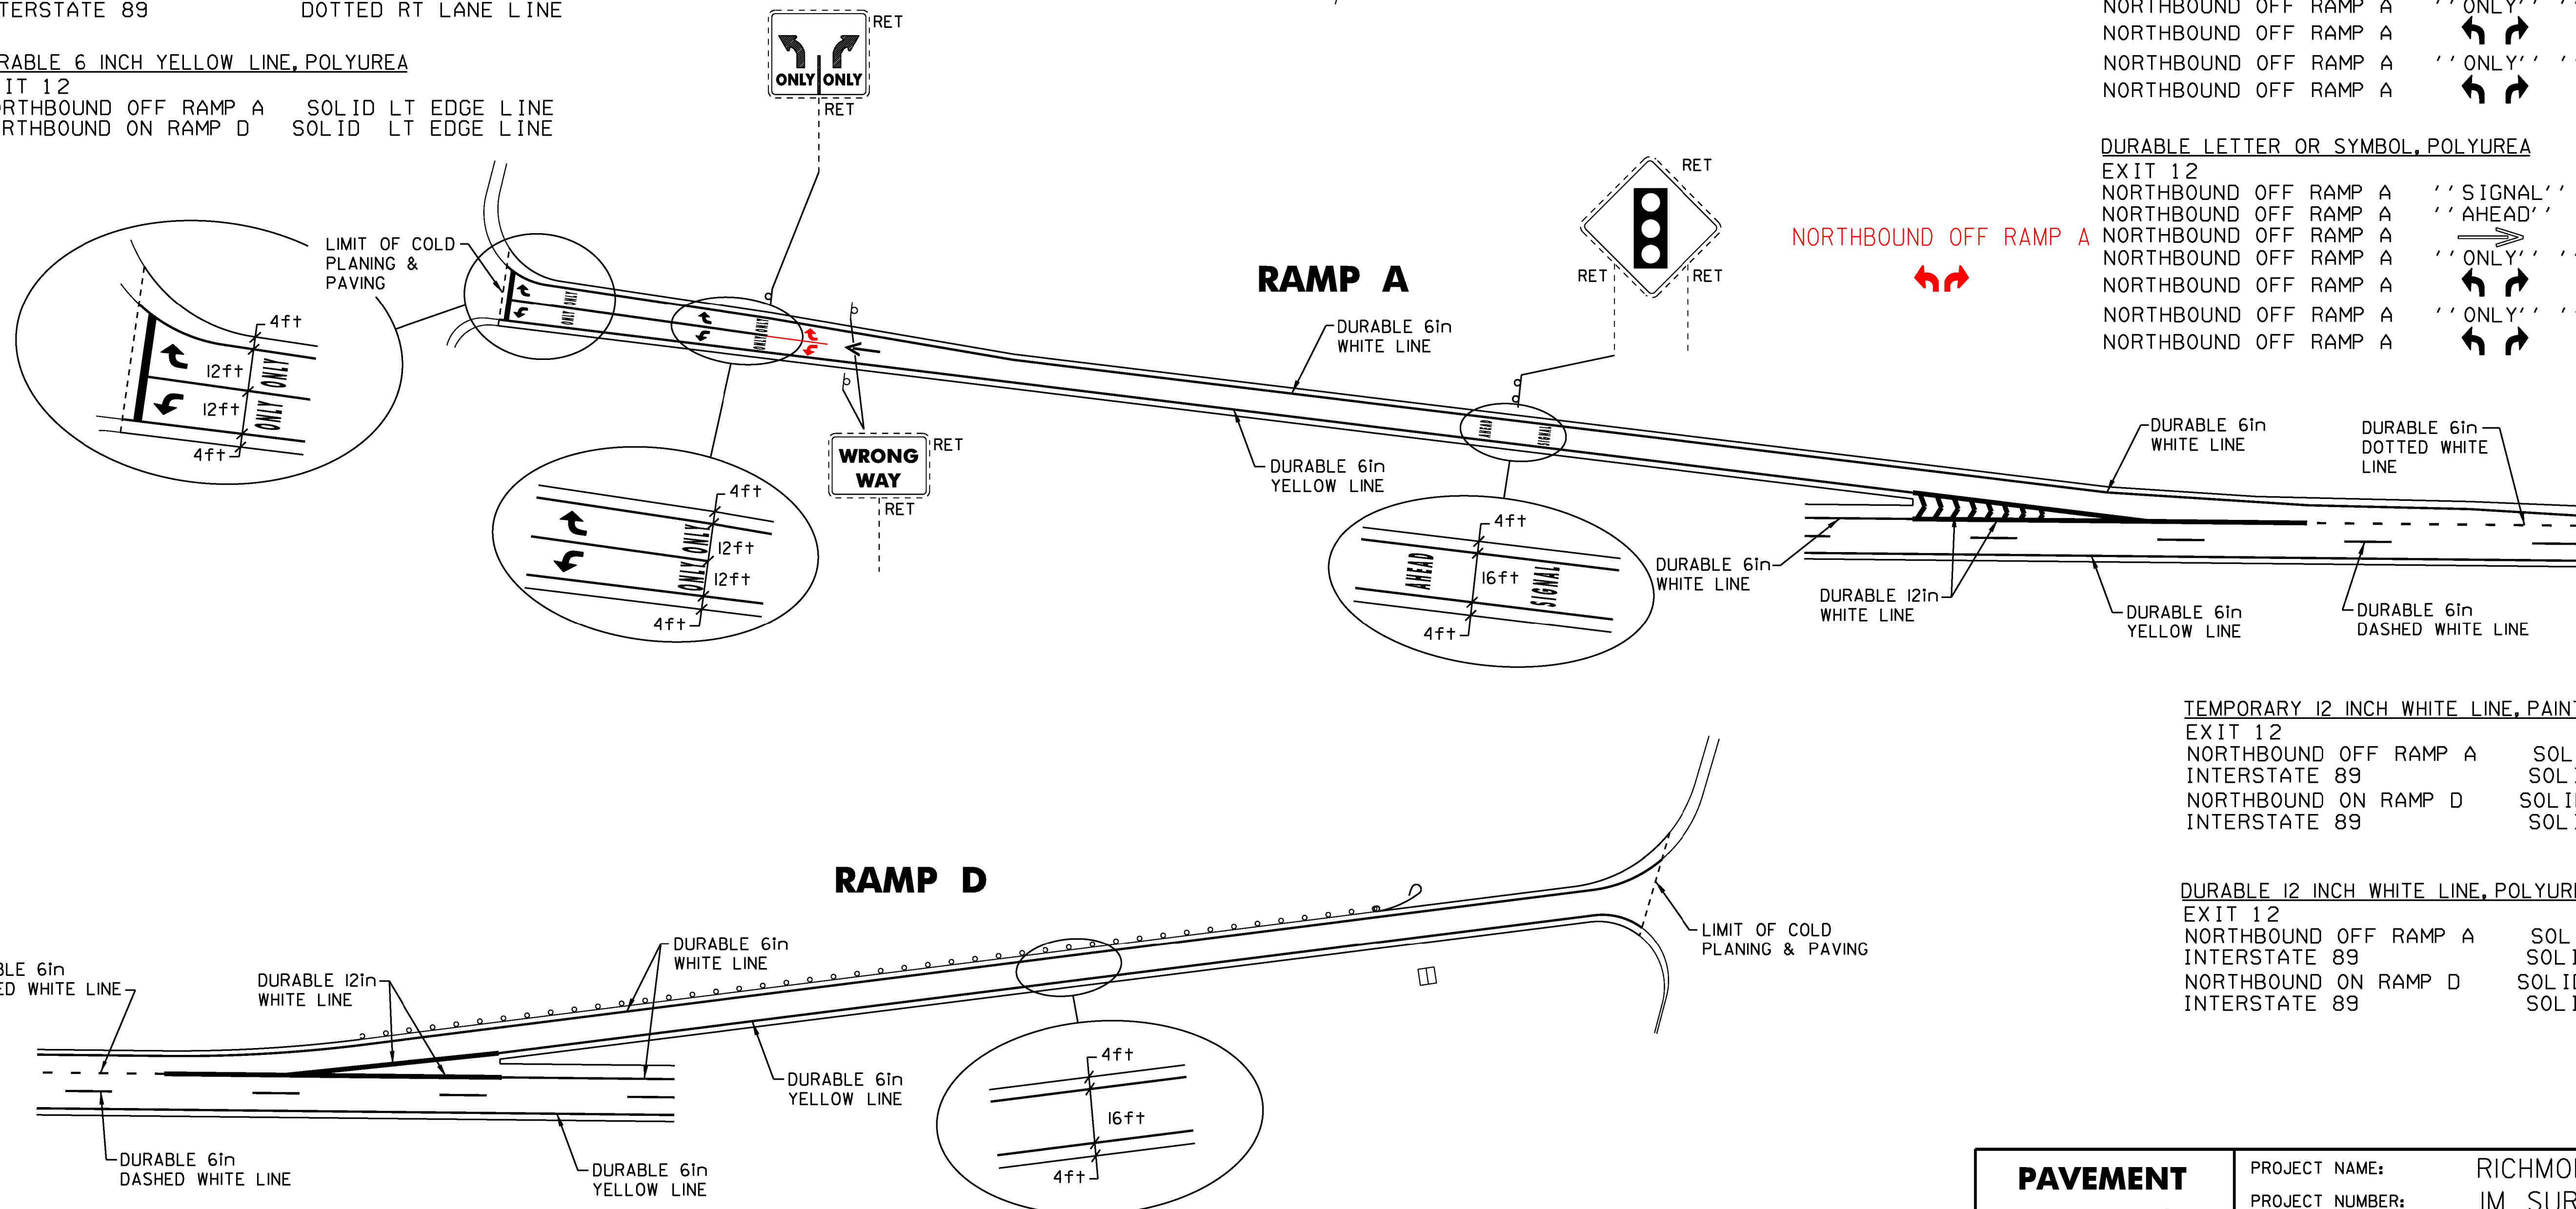

TEMPORARY 12 INCH WHITE LINE, PAINT

EXIT 12
 NORTHBOUND OFF RAMP A SOLID LT GORE AREA
 INTERSTATE 89 SOLID RT GORE AREA
 NORTHBOUND ON RAMP D SOLID LT GORE AREA
 INTERSTATE 89 SOLID RT GORE AREA

DURABLE 12 INCH WHITE LINE, POLYUREA

EXIT 12
 NORTHBOUND OFF RAMP A SOLID LT GORE AREA
 INTERSTATE 89 SOLID RT GORE AREA
 NORTHBOUND ON RAMP D SOLID LT GORE AREA
 INTERSTATE 89 SOLID RT GORE AREA

NOT TO SCALE

PAVEMENT MARKING DETAIL SHEET 3 EXIT 12 NB	PROJECT NAME:	RICHMOND - COLCHESTER
	PROJECT NUMBER:	IM SURF (38)
	FILE NAME:	pl3al36.dgn
	IPARM FILE NAME:	pl3al36pmd3.i
	PROJECT LEADER:	M. FOWLER
	DESIGNED BY:	LOCKE
	PLOT DATE:	19-DEC-2013
	DRAWN BY:	LOCKE
	CHECKED BY:	FOWLER
	SHEET	19 OF 41