




INTERCHANGE #14 (NORTHBOUND)

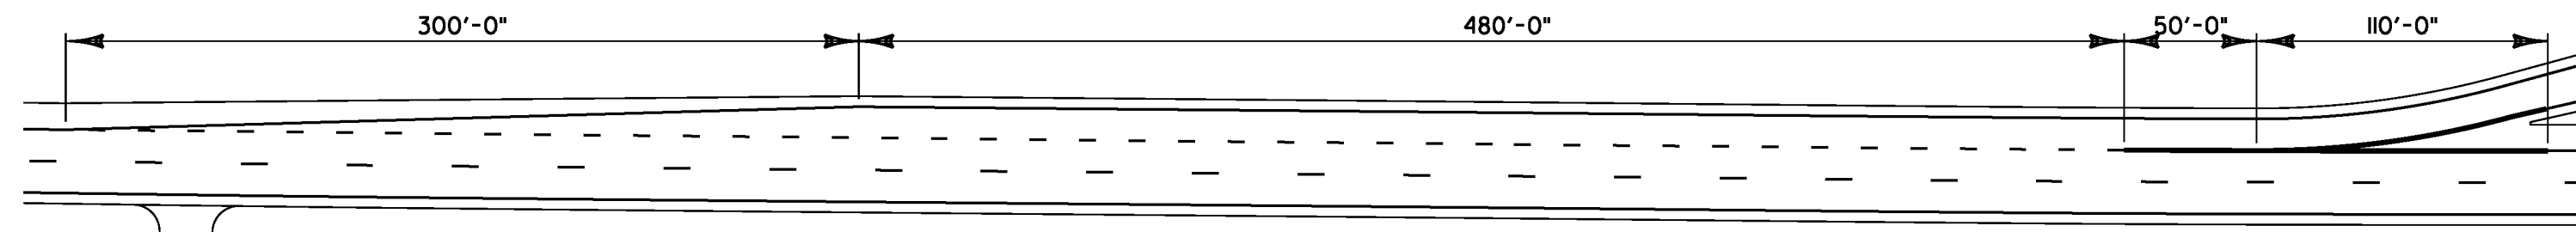

INSET A - GORE DETAIL AT EXIT 14 RAMP H

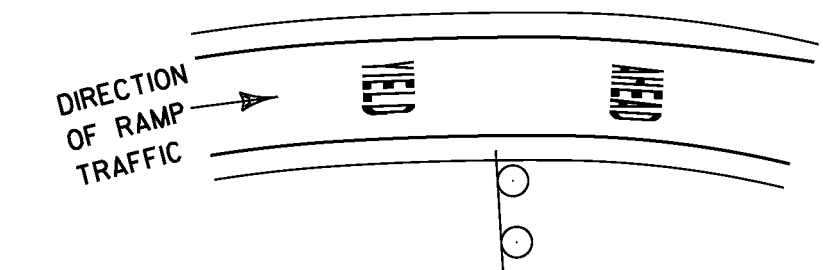

INSET B - PAVEMENT MARKING DETAIL

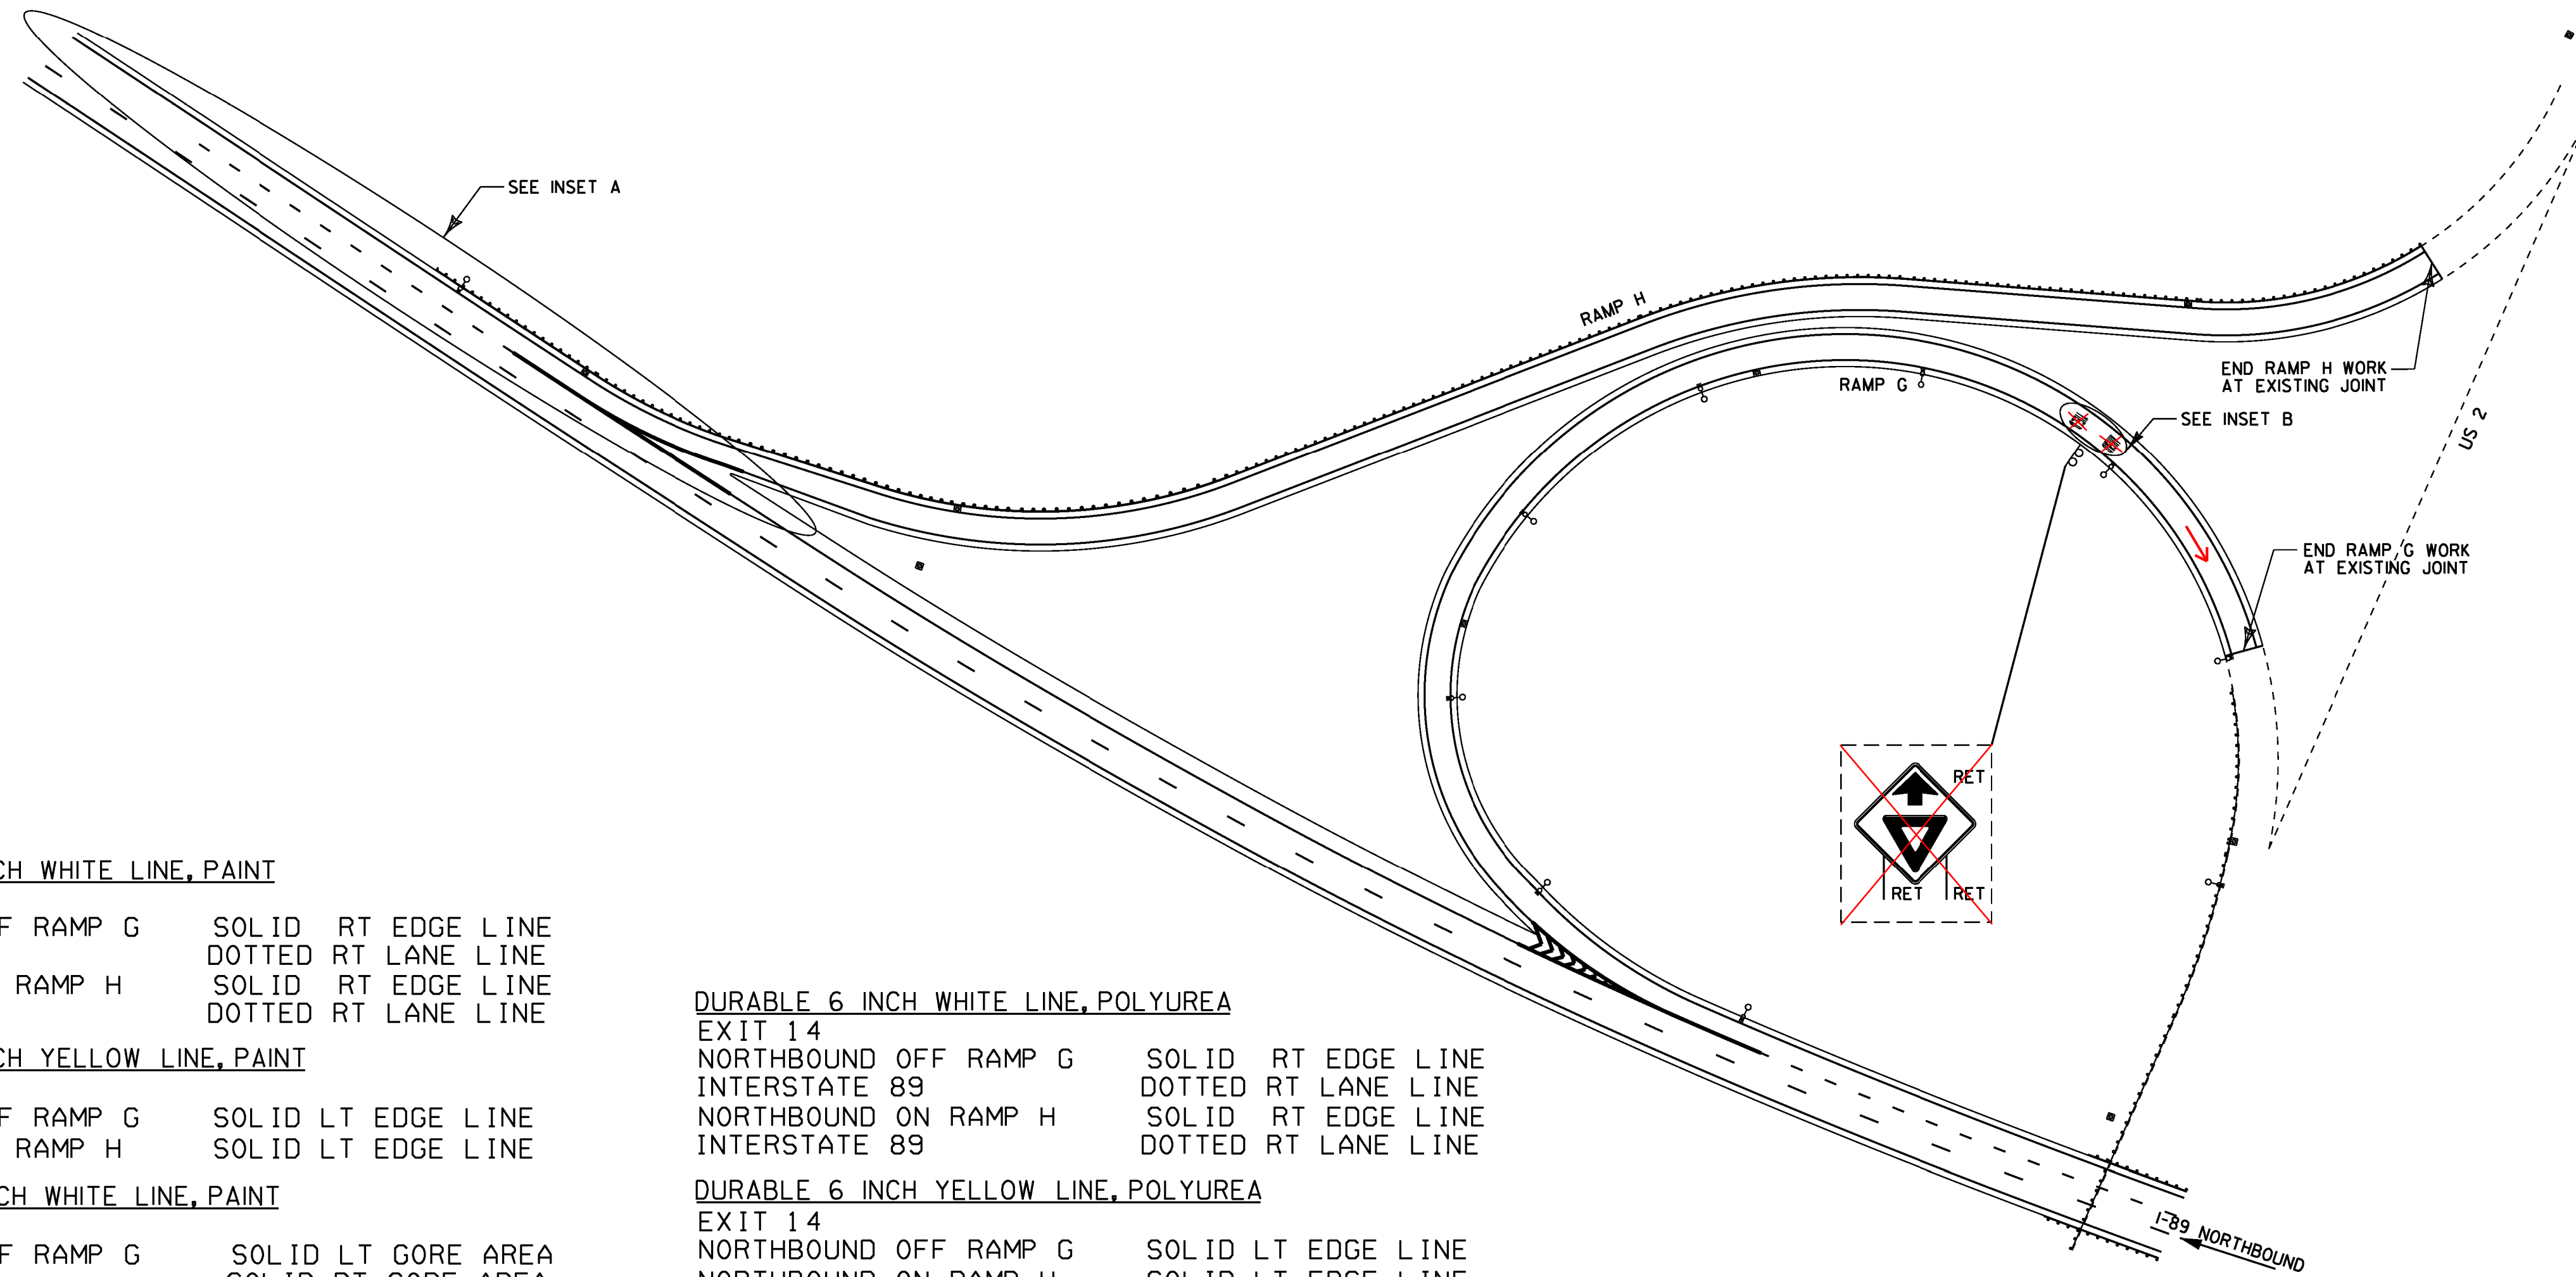

TEMPORARY 6 INCH WHITE LINE, PAINT

EXIT 14
 NORTHBOUND OFF RAMP G SOLID RT EDGE LINE
 INTERSTATE 89 DOTTED RT LANE LINE
 NORTHBOUND ON RAMP H SOLID RT EDGE LINE
 INTERSTATE 89 DOTTED RT LANE LINE

TEMPORARY 6 INCH YELLOW LINE, PAINT

EXIT 14
 NORTHBOUND OFF RAMP G SOLID LT EDGE LINE
 NORTHBOUND ON RAMP H SOLID LT EDGE LINE

TEMPORARY 12 INCH WHITE LINE, PAINT

EXIT 14
 NORTHBOUND OFF RAMP G SOLID LT GORE AREA
 INTERSTATE 89 SOLID RT GORE AREA
 NORTHBOUND ON RAMP H SOLID LT GORE AREA
 INTERSTATE 89 SOLID RT GORE AREA

TEMPORARY LETTER OR SYMBOL, PAINT

EXIT 14
 NORTHBOUND OFF RAMP G "YIELD"
 NORTHBOUND OFF RAMP G "AHEAD"
 NORTHBOUND OFF RAMP G →

DURABLE 6 INCH WHITE LINE, POLYUREA

EXIT 14
 NORTHBOUND OFF RAMP G SOLID RT EDGE LINE
 INTERSTATE 89 DOTTED RT LANE LINE
 NORTHBOUND ON RAMP H SOLID RT EDGE LINE
 INTERSTATE 89 DOTTED RT LANE LINE

DURABLE 6 INCH YELLOW LINE, POLYUREA

EXIT 14
 NORTHBOUND OFF RAMP G SOLID LT EDGE LINE
 NORTHBOUND ON RAMP H SOLID LT EDGE LINE

TEMPORARY 12 INCH WHITE LINE, POLYUREA

EXIT 14
 NORTHBOUND OFF RAMP G SOLID LT GORE AREA
 INTERSTATE 89 SOLID RT GORE AREA
 NORTHBOUND ON RAMP H SOLID LT GORE AREA
 INTERSTATE 89 SOLID RT GORE AREA

DURABLE LETTER OR SYMBOL, POLYUREA

EXIT 14
~~NORTHBOUND OFF RAMP G "YIELD"~~
~~NORTHBOUND OFF RAMP G "AHEAD"~~
 NORTHBOUND OFF RAMP G →

NOT TO SCALE

**PAVEMENT
MARKING
DETAIL SHEET 9
EXIT 14 NB**

PROJECT NAME:	RICHMOND - COLCHESTER
PROJECT NUMBER:	IM SURF (38)
FILE NAME: pl3al36.dgn	PLOT DATE: 19-DEC-2013
PROJECT LEADER: M. FOWLER	DRAWN BY: LOCKE
DESIGNED BY: LOCKE	CHECKED BY: FOWLER
IPARM FILE NAME: pl3al36pmd9.i	SHEET 25 OF 41