

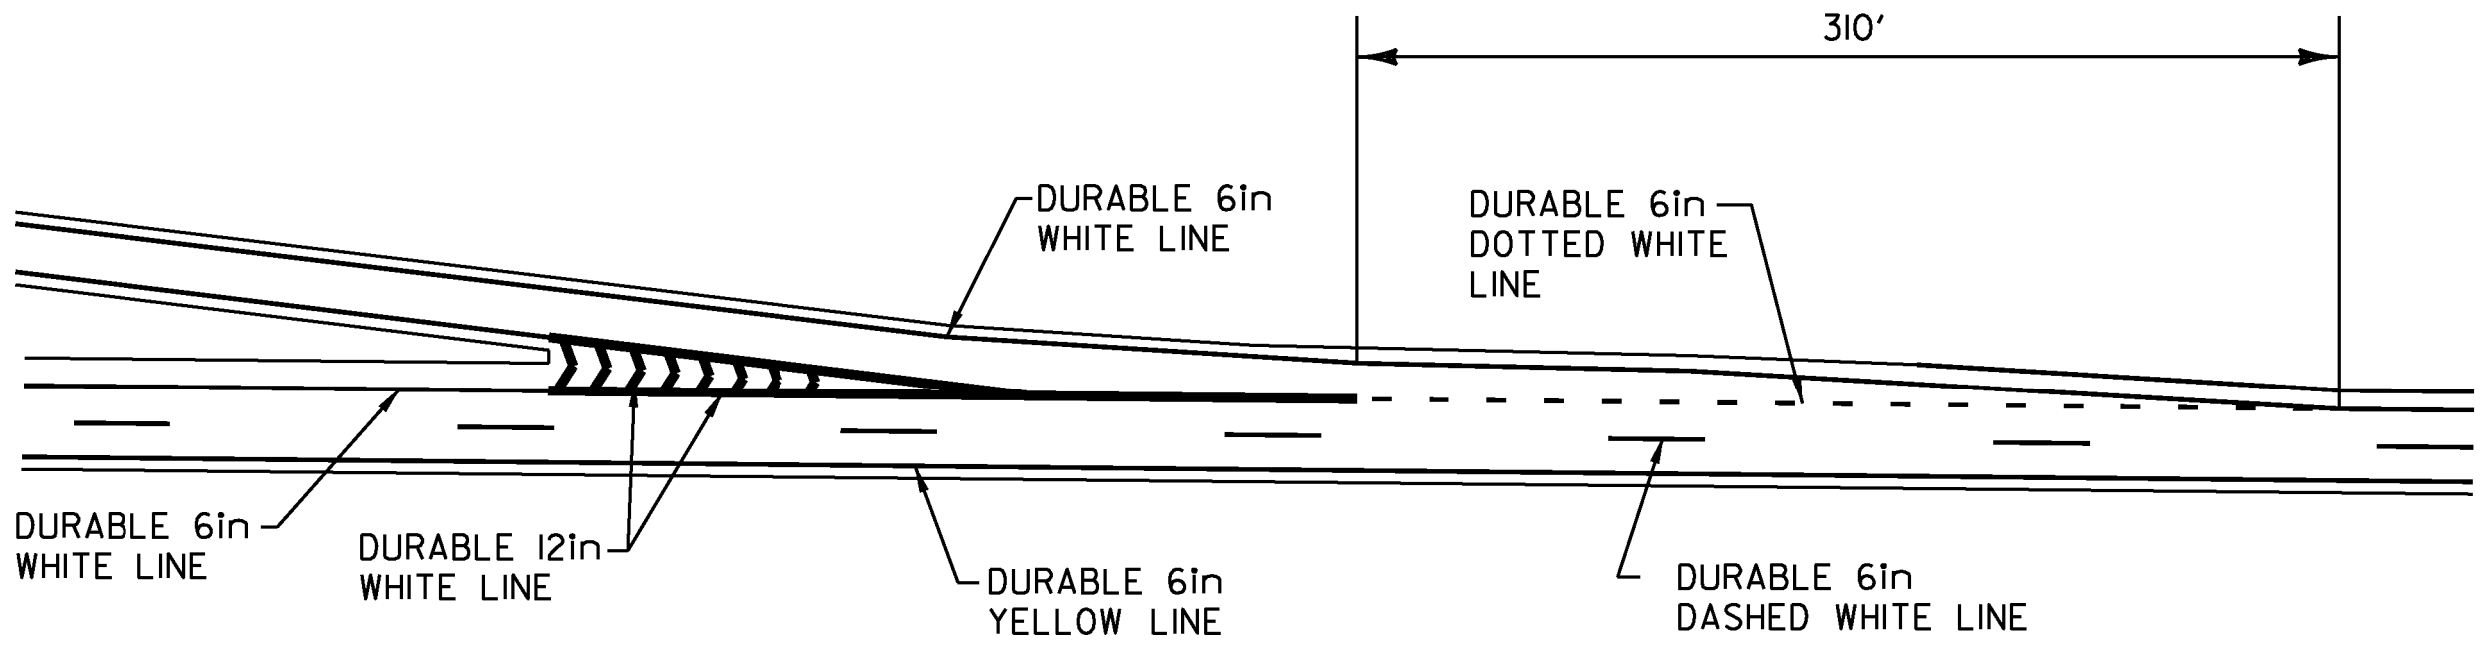


INTERCHANGE #14 (SOUTHBOUND)

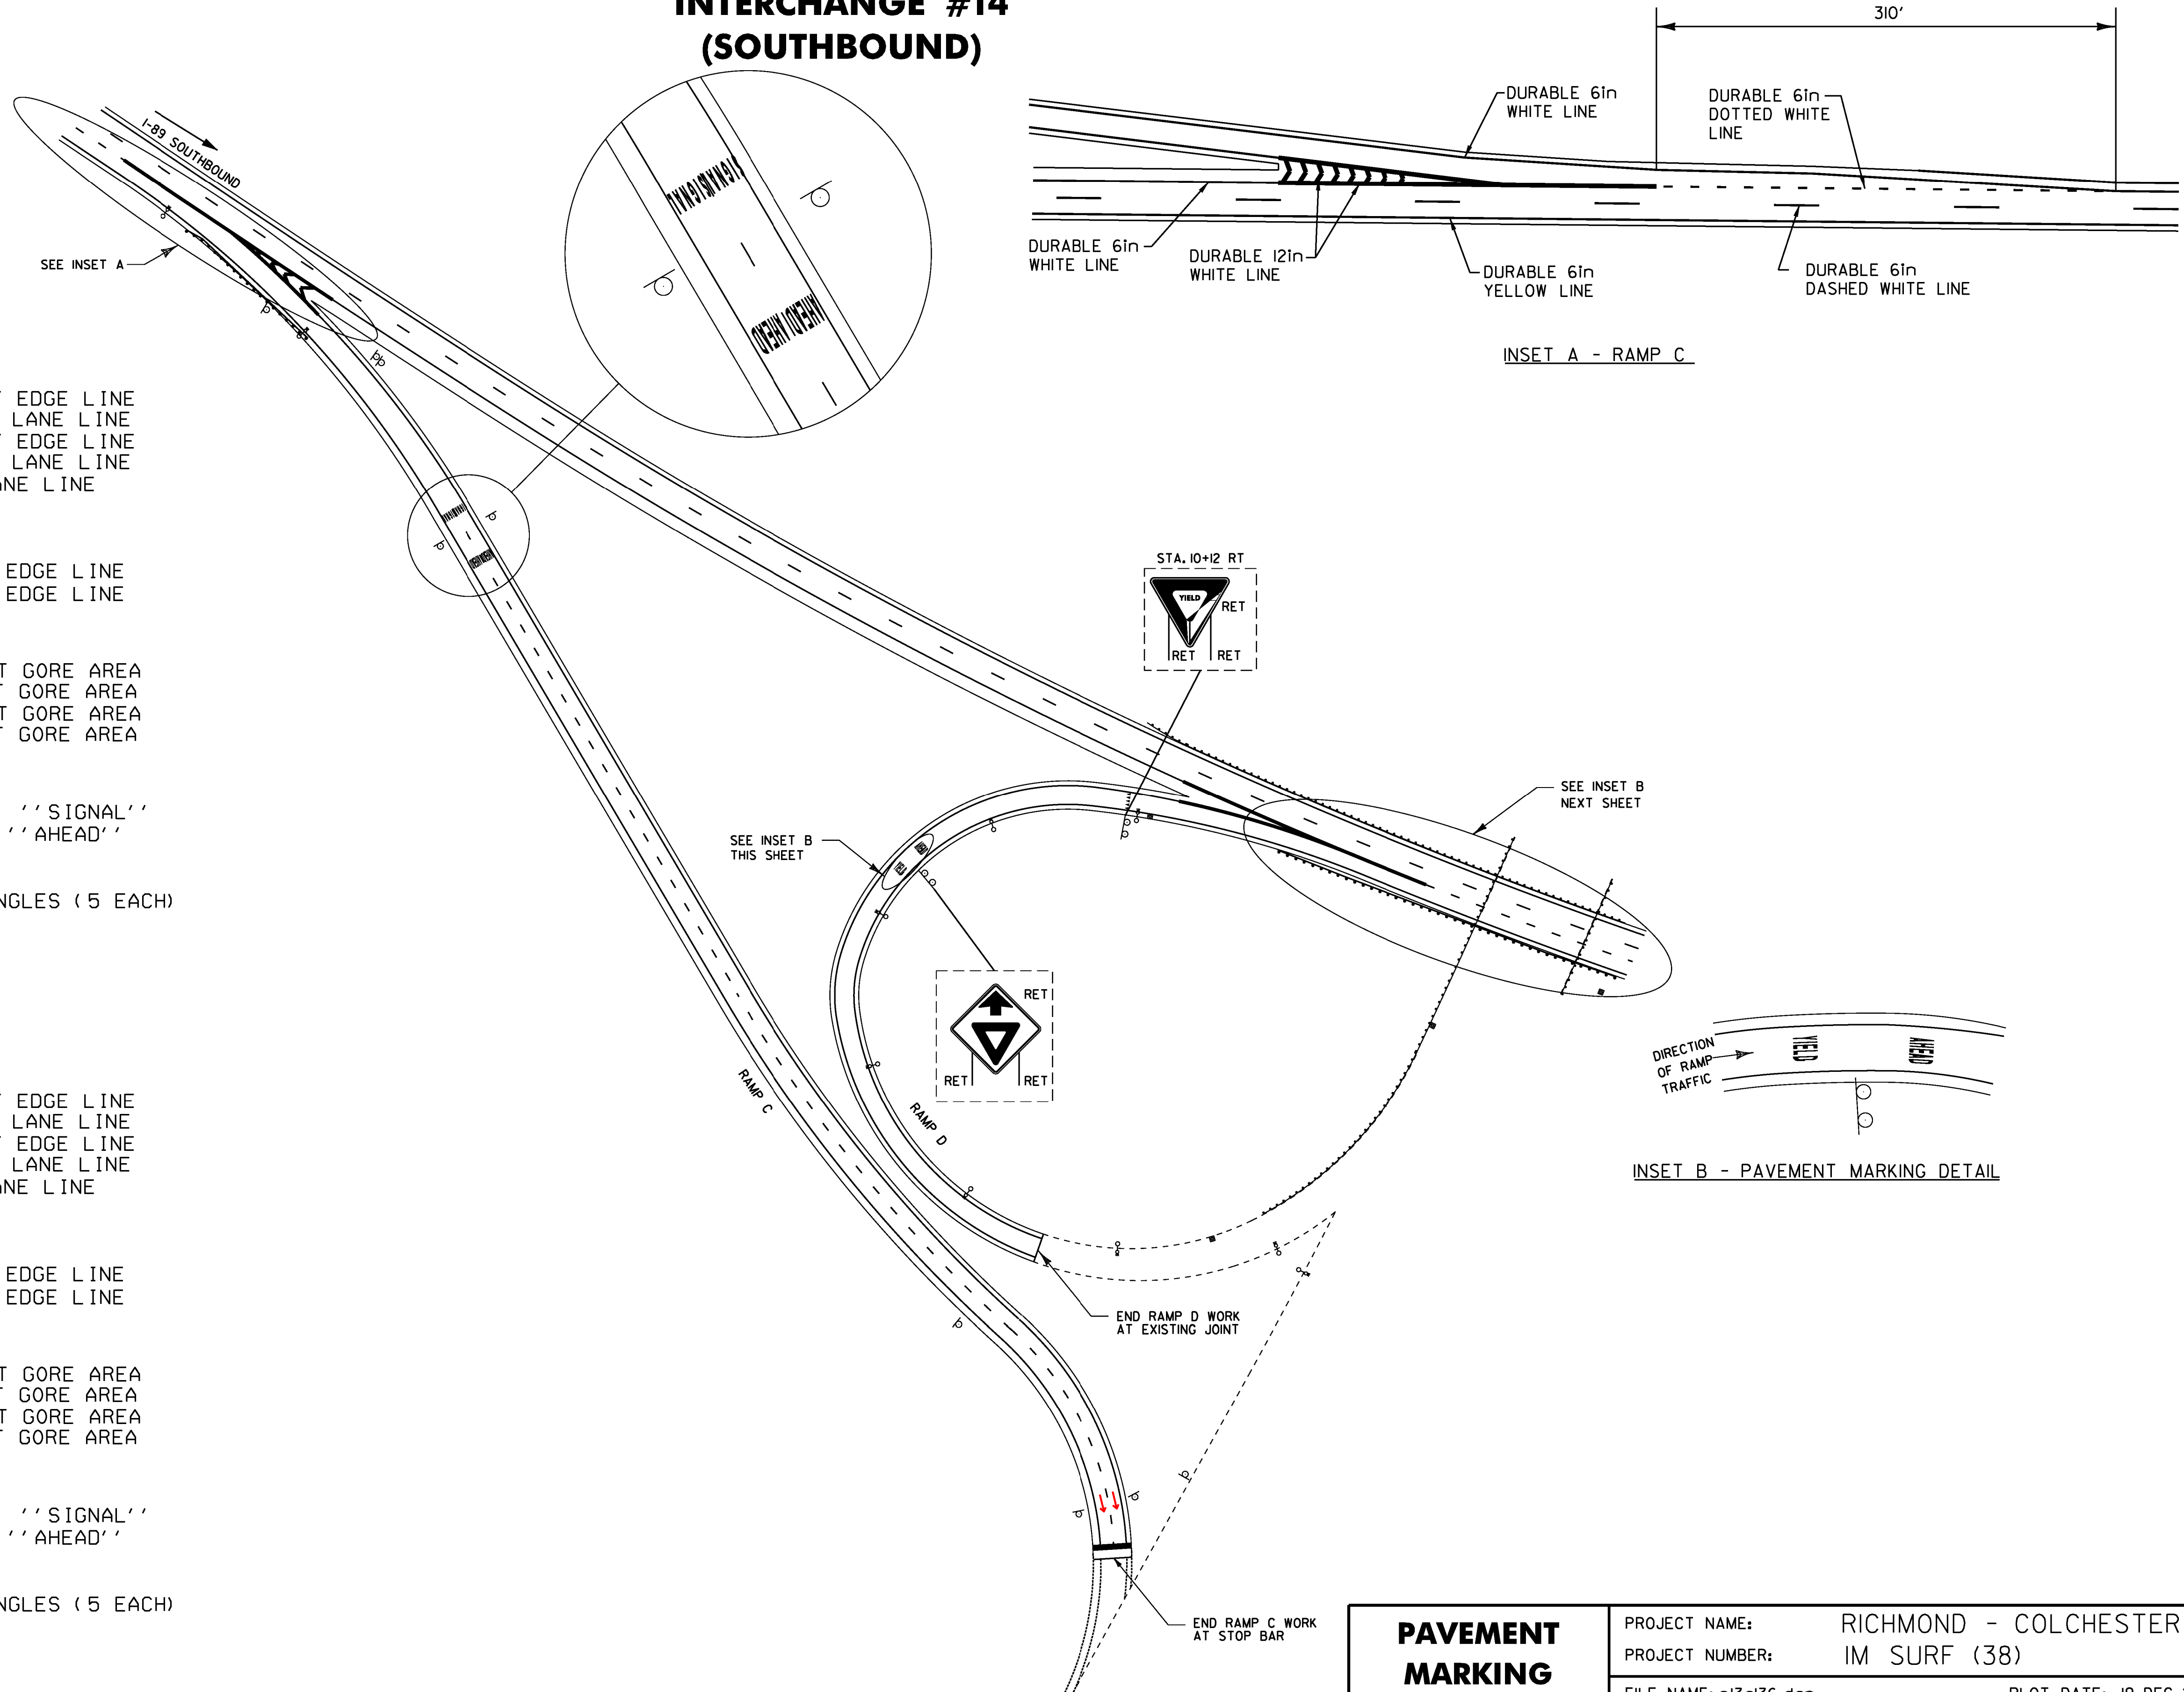

INSET A - RAMP C

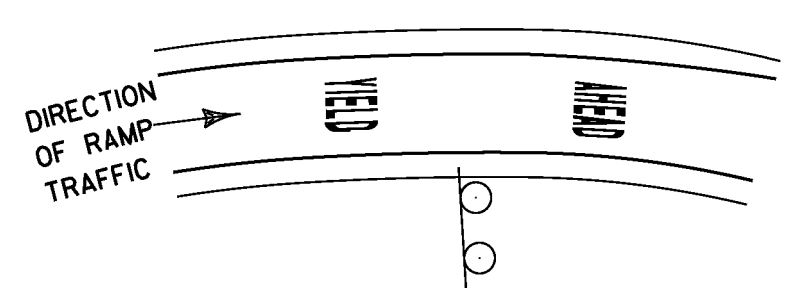

INSET B - PAVEMENT MARKING DETAIL

TEMPORARY 6 INCH WHITE LINE, PAINT

EXIT 14

SOUTHBOUND OFF RAMP C	SOLID RT EDGE LINE
INTERSTATE 89	DOTTED LT LANE LINE
SOUTHBOUND ON RAMP D	SOLID RT EDGE LINE
INTERSTATE 89	DOTTED LT LANE LINE
SOUTHBOUND OFF RAMP C	DASHED LANE LINE

TEMPORARY 6 INCH YELLOW LINE, PAINT

EXIT 14

SOUTHBOUND OFF RAMP C	SOLID LT EDGE LINE
SOUTHBOUND ON RAMP D	SOLID LT EDGE LINE

TEMPORARY 12 INCH WHITE LINE, PAINT

EXIT 14

SOUTHBOUND OFF RAMP C	SOLID LT GORE AREA
INTERSTATE 89	SOLID LT GORE AREA
SOUTHBOUND ON RAMP D	SOLID LT GORE AREA
INTERSTATE 89	SOLID LT GORE AREA

TEMPORARY LETTER OR SYMBOL, PAINT

EXIT 14

SOUTHBOUND OFF RAMP C	'' SIGNAL'' '' SIGNAL''
SOUTHBOUND OFF RAMP C	'' AHEAD'' '' AHEAD''
SOUTHBOUND ON RAMP D	'' YIELD''
SOUTHBOUND ON RAMP D	'' AHEAD''
SOUTHBOUND ON RAMP D	YIELD TRIANGLES (5 EACH)

TEMPORARY 24 INCH STOP BAR, PAINT

EXIT 14

SOUTHBOUND OFF RAMP C	AT US 2
-----------------------	---------

DURABLE 6 INCH WHITE LINE, POLYUREA

EXIT 14

SOUTHBOUND OFF RAMP C	SOLID RT EDGE LINE
INTERSTATE 89	DOTTED LT LANE LINE
SOUTHBOUND ON RAMP D	SOLID RT EDGE LINE
INTERSTATE 89	DOTTED LT LANE LINE
SOUTHBOUND OFF RAMP C	DASHED LANE LINE

DURABLE 6 INCH YELLOW LINE, POLYUREA

EXIT 14

SOUTHBOUND OFF RAMP C	SOLID LT EDGE LINE
SOUTHBOUND ON RAMP D	SOLID LT EDGE LINE

DURABLE 12 INCH WHITE LINE, POLYUREA

EXIT 14

SOUTHBOUND OFF RAMP C	SOLID LT GORE AREA
INTERSTATE 89	SOLID LT GORE AREA
SOUTHBOUND ON RAMP D	SOLID LT GORE AREA
INTERSTATE 89	SOLID LT GORE AREA

DURABLE LETTER OR SYMBOL, POLYUREA

EXIT 14

SOUTHBOUND OFF RAMP C	'' SIGNAL'' '' SIGNAL''
SOUTHBOUND OFF RAMP C	'' AHEAD'' '' AHEAD''
SOUTHBOUND ON RAMP D	'' YIELD''
SOUTHBOUND ON RAMP D	'' AHEAD''
SOUTHBOUND ON RAMP D	YIELD TRIANGLES (5 EACH)

DURABLE 24 INCH STOP BAR, POLYUREA

EXIT 14

SOUTHBOUND OFF RAMP C	AT US 2
-----------------------	---------

**PAVEMENT MARKING
DETAIL SHEET 10
EXIT 14 SB**

NOT TO SCALE

PROJECT NAME:	RICHMOND - COLCHESTER
PROJECT NUMBER:	IM SURF (38)
FILE NAME:	pl3al36.dgn
PROJECT LEADER:	M. FOWLER
DESIGNED BY:	LOCKE
IPARM FILE NAME:	pl3al36pmd10.i
PLOT DATE:	19-DEC-2013
DRAWN BY:	LOCKE
CHECKED BY:	FOWLER
SHEET	26 OF 41