


INTERCHANGE #14 (SOUTHBOUND)

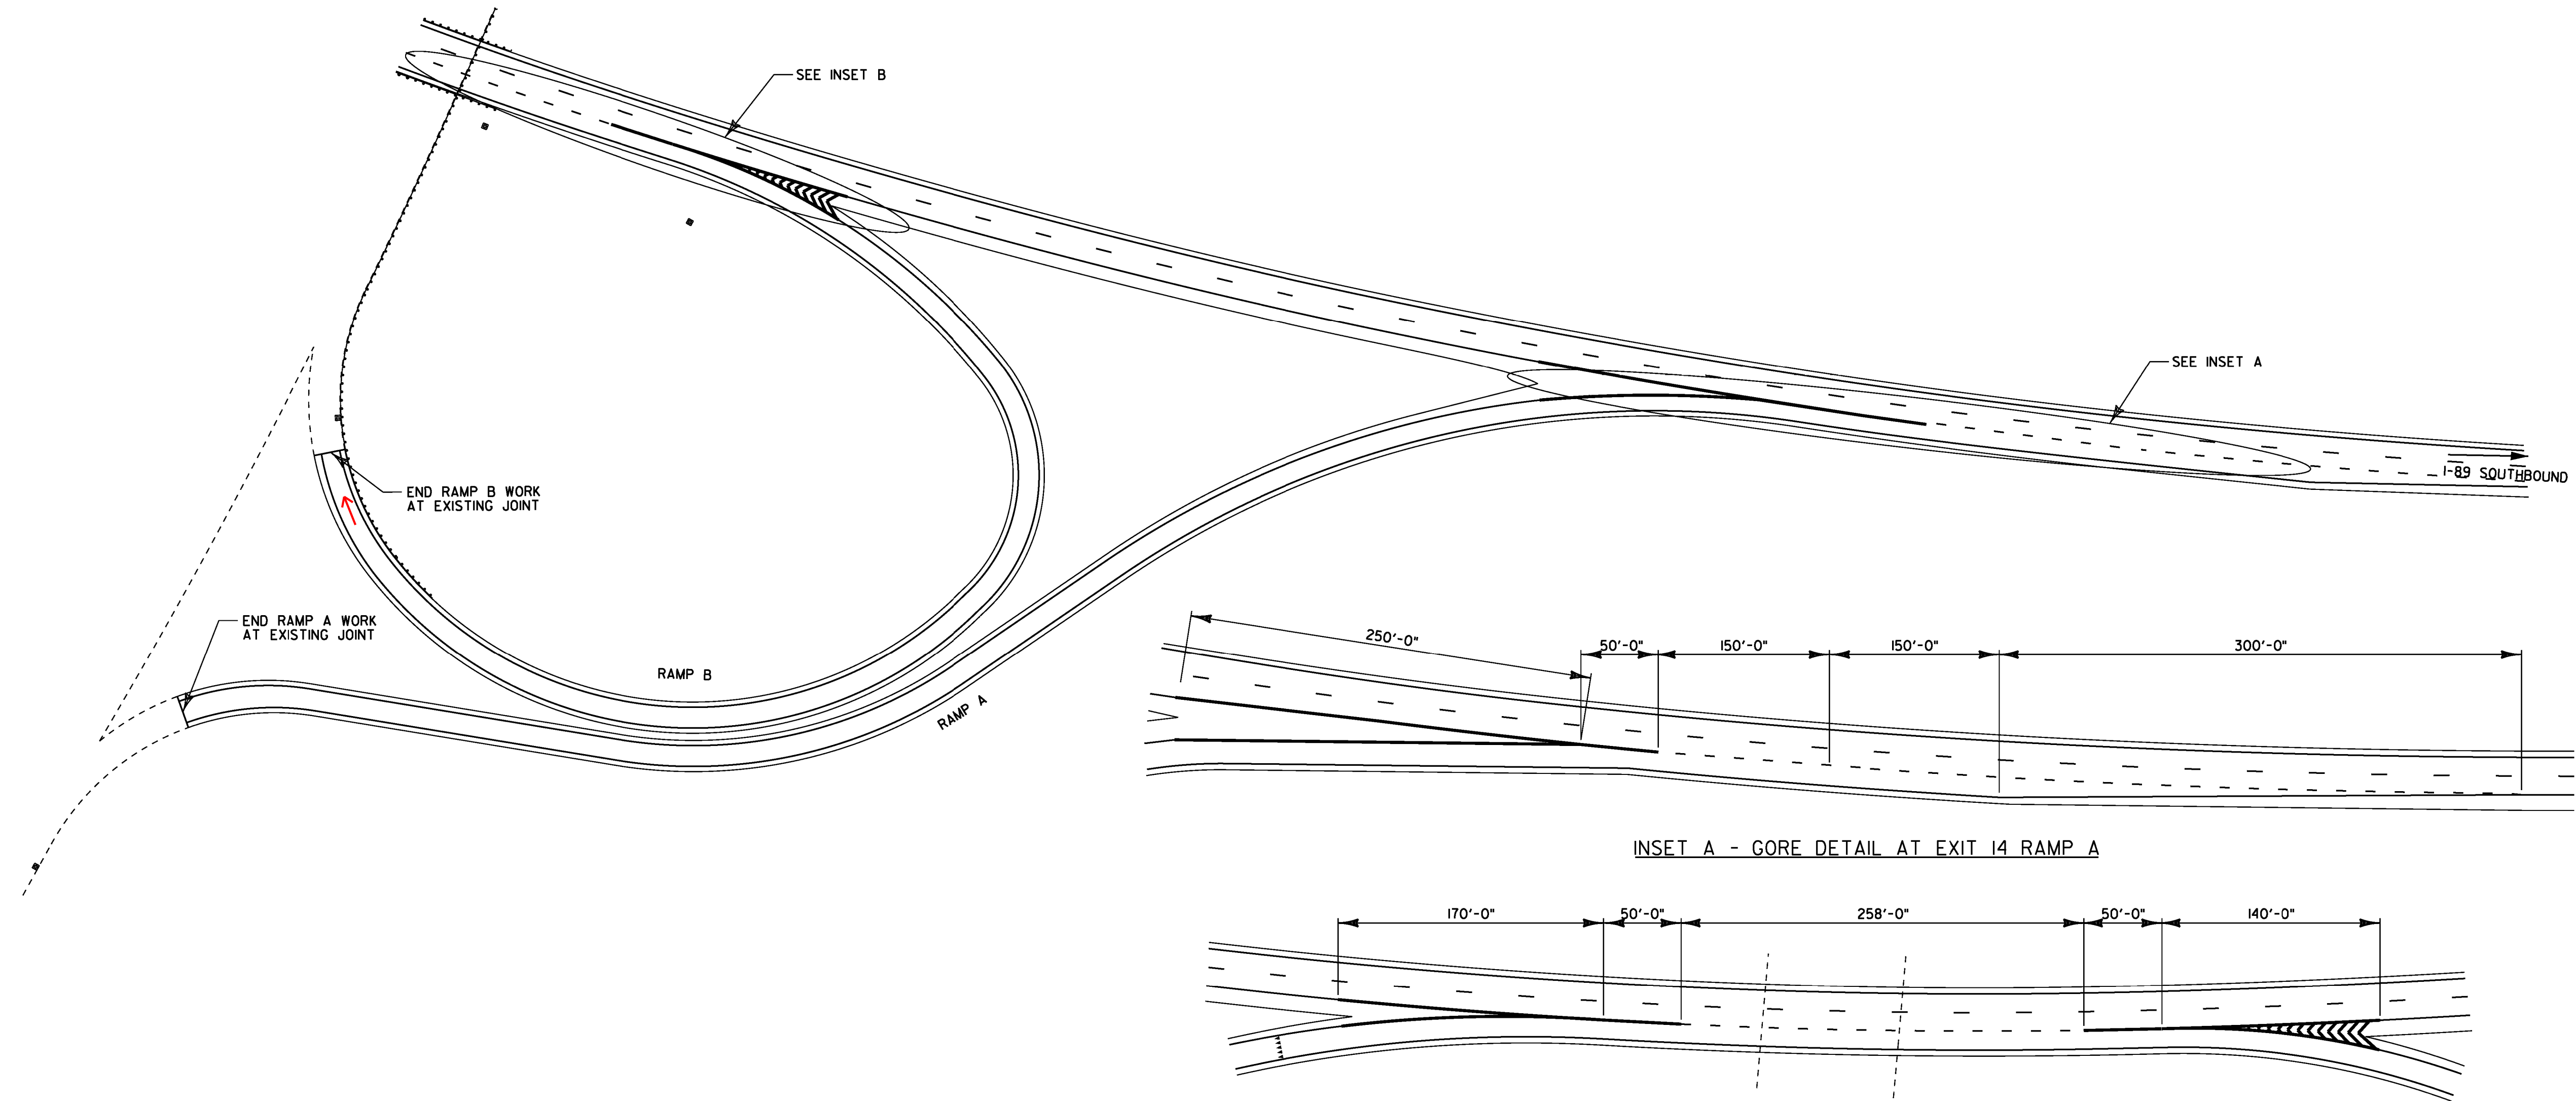

TEMPORARY 6 INCH WHITE LINE, PAINT
EXIT 14
SOUTHBOUND OFF RAMP B SOLID RT EDGE LINE
INTERSTATE 89 DOTTED LT LANE LINE
SOUTHBOUND ON RAMP A SOLID RT EDGE LINE
INTERSTATE 89 DOTTED LT LANE LINE

TEMPORARY 6 INCH YELLOW LINE, PAINT
EXIT 14
SOUTHBOUND OFF RAMP B SOLID LT EDGE LINE
SOUTHBOUND ON RAMP A SOLID LT EDGE LINE

TEMPORARY 12 INCH WHITE LINE, PAINT
EXIT 14
SOUTHBOUND OFF RAMP B SOLID LT GORE AREA
INTERSTATE 89 SOLID LT GORE AREA
SOUTHBOUND ON RAMP A SOLID LT GORE AREA
INTERSTATE 89 SOLID LT GORE AREA

DURABLE 6 INCH WHITE LINE, POLYUREA
EXIT 14
SOUTHBOUND OFF RAMP B SOLID RT EDGE LINE
INTERSTATE 89 DOTTED LT LANE LINE
SOUTHBOUND ON RAMP A SOLID RT EDGE LINE
INTERSTATE 89 DOTTED LT LANE LINE

DURABLE 6 INCH YELLOW LINE, POLYUREA
EXIT 14
SOUTHBOUND OFF RAMP B SOLID LT EDGE LINE
SOUTHBOUND ON RAMP A SOLID LT EDGE LINE

DURABLE 12 INCH WHITE LINE, POLYUREA
EXIT 14
SOUTHBOUND OFF RAMP B SOLID LT GORE AREA
INTERSTATE 89 SOLID LT GORE AREA
SOUTHBOUND ON RAMP A SOLID LT GORE AREA
INTERSTATE 89 SOLID LT GORE AREA

INSET B - GORE DETAIL AT EXIT 14 RAMP B & D

DURABLE LETTER OR SYMBOL, POLYUREA
EXIT 14
SOUTHBOUND OFF RAMP B →

**PAVEMENT
MARKING
DETAIL SHEET 11
EXIT 14 SB**

PROJECT NAME:	RICHMOND - COLCHESTER	
PROJECT NUMBER:	IM SURF (38)	
FILE NAME: pl3al36.dgn	DESIGNED BY: LOCKE	PLOT DATE: 19-DEC-2013
PROJECT LEADER: M. FOWLER	CHECKED BY: FOWLER	DRAWN BY: LOCKE
IPARM FILE NAME: pl3al36pmdl.l		SHEET 27 OF 41

NOT TO SCALE