

INTERCHANGE #16

TEMPORARY 6 INCH WHITE LINE, PAINT

EXIT 16	
NORTHBOUND OFF RAMP D	SOLID RT EDGE LINE
NORTHBOUND OFF RAMP D	SOLID RT LANE LINE
NORTHBOUND OFF RAMP D	SOLID RT LANE LINE
INTERSTATE 89	DOTTED RT LANE LINE
SOUTHBOUND ON RAMP C	SOLID RT EDGE LINE
INTERSTATE 89	DOTTED LT LANE LINE
NORTHBOUND ON RAMP B	SOLID RT EDGE LINE
INTERSTATE 89	DOTTED RT LANE LINE
SOUTHBOUND OFF RAMP A	SOLID RT EDGE LINE
SOUTHBOUND OFF RAMP A	SOLID RT LANE LINE
INTERSTATE 89	DOTTED LT LANE LINE

TEMPORARY 6 INCH YELLOW LINE, PAINT

EXIT 16	
NORTHBOUND OFF RAMP D	SOLID LT EDGE LINE
SOUTHBOUND ON RAMP C	SOLID LT EDGE LINE
NORTHBOUND ON RAMP B	SOLID LT EDGE LINE
SOUTHBOUND OFF RAMP A	SOLID LT EDGE LINE

TEMPORARY 12 INCH WHITE LINE, PAINT

EXIT 16	
NORTHBOUND OFF RAMP D	SOLID LT GORE AREA
INTERSTATE 89	SOLID RT GORE AREA
SOUTHBOUND ON RAMP C	SOLID LT GORE AREA
INTERSTATE 89	SOLID LT GORE AREA
NORTHBOUND OFF RAMP B	SOLID LT GORE AREA
INTERSTATE 89	SOLID RT GORE AREA
SOUTHBOUND OFF RAMP A	SOLID LT GORE AREA
INTERSTATE 89	SOLID LT GORE AREA

TEMPORARY LETTER OR SYMBOL, PAINT

EXIT 16	
NORTHBOUND OFF RAMP D	“ SIGNAL ”
NORTHBOUND OFF RAMP D	“ AHEAD ”
NORTHBOUND OFF RAMP D	→
NORTHBOUND OFF RAMP D	“ ONLY ” “ ONLY ” “ ONLY ”
NORTHBOUND OFF RAMP D	↩ ↪ ↪
NORTHBOUND OFF RAMP D	“ ONLY ” “ ONLY ” “ ONLY ”
NORTHBOUND OFF RAMP D	↩ ↪ ↪
NORTHBOUND OFF RAMP D	“ ONLY ” “ ONLY ” “ ONLY ”
NORTHBOUND OFF RAMP D	↩ ↪ ↪
SOUTHBOUND OFF RAMP A	“ SIGNAL ”
SOUTHBOUND OFF RAMP A	“ AHEAD ”
SOUTHBOUND OFF RAMP A	→
SOUTHBOUND OFF RAMP A	“ ONLY ”
SOUTHBOUND OFF RAMP A	↩ ↪ ↪
SOUTHBOUND OFF RAMP A	“ ONLY ”
SOUTHBOUND OFF RAMP A	↩ ↪ ↪
SOUTHBOUND OFF RAMP A	↩ ↪ ↪

DURABLE LETTER OR SYMBOL, POLYUREA

EXIT 16	
NORTHBOUND OFF RAMP D	“ SIGNAL ”
NORTHBOUND OFF RAMP D	“ AHEAD ”
NORTHBOUND OFF RAMP D	→
NORTHBOUND OFF RAMP D	“ ONLY ” “ ONLY ” “ ONLY ”
NORTHBOUND OFF RAMP D	↩ ↪ ↪
NORTHBOUND OFF RAMP D	“ ONLY ” “ ONLY ” “ ONLY ”
NORTHBOUND OFF RAMP D	↩ ↪ ↪
NORTHBOUND OFF RAMP D	“ ONLY ” “ ONLY ” “ ONLY ”
NORTHBOUND OFF RAMP D	↩ ↪ ↪
SOUTHBOUND OFF RAMP A	“ SIGNAL ”
SOUTHBOUND OFF RAMP A	“ AHEAD ”
SOUTHBOUND OFF RAMP A	→
SOUTHBOUND OFF RAMP A	“ ONLY ”
SOUTHBOUND OFF RAMP A	↩ ↪ ↪
SOUTHBOUND OFF RAMP A	“ ONLY ”
SOUTHBOUND OFF RAMP A	↩ ↪ ↪
SOUTHBOUND OFF RAMP A	↩ ↪ ↪

DURABLE 6 INCH WHITE LINE, POLYUREA

EXIT 16	
NORTHBOUND OFF RAMP D	SOLID RT EDGE LINE
NORTHBOUND OFF RAMP D	SOLID RT LANE LINE
NORTHBOUND OFF RAMP D	SOLID RT LANE LINE
INTERSTATE 89	DOTTED RT LANE LINE
SOUTHBOUND ON RAMP C	SOLID RT EDGE LINE
INTERSTATE 89	DOTTED LT LANE LINE
NORTHBOUND ON RAMP B	SOLID RT EDGE LINE
INTERSTATE 89	DOTTED RT LANE LINE
SOUTHBOUND OFF RAMP A	SOLID RT EDGE LINE
SOUTHBOUND OFF RAMP A	SOLID RT LANE LINE
INTERSTATE 89	DOTTED LT LANE LINE

DURABLE 12 INCH WHITE LINE, POLYUREA

EXIT 16	
NORTHBOUND OFF RAMP D	SOLID LT GORE AREA
INTERSTATE 89	SOLID RT GORE AREA
SOUTHBOUND ON RAMP C	SOLID LT GORE AREA
INTERSTATE 89	SOLID LT GORE AREA
NORTHBOUND OFF RAMP B	SOLID LT GORE AREA
INTERSTATE 89	SOLID RT GORE AREA
SOUTHBOUND OFF RAMP A	SOLID LT GORE AREA
INTERSTATE 89	SOLID LT GORE AREA

TEMPORARY 24 INCH STOP BAR, PAINT


EXIT 16	
NORTHBOUND OFF RAMP D AT US 7	
SOUTHBOUND OFF RAMP A AT US 7	

DURABLE 24 INCH STOP BAR, POLYUREA

EXIT 16	
NORTHBOUND OFF RAMP D AT US 7	
SOUTHBOUND OFF RAMP A AT US 7	

DURABLE 6 INCH YELLOW LINE, POLYUREA

EXIT 16	
NORTHBOUND OFF RAMP D	SOLID LT EDGE LINE
SOUTHBOUND ON RAMP C	SOLID LT EDGE LINE
NORTHBOUND ON RAMP B	SOLID LT EDGE LINE
SOUTHBOUND OFF RAMP A	SOLID LT EDGE LINE

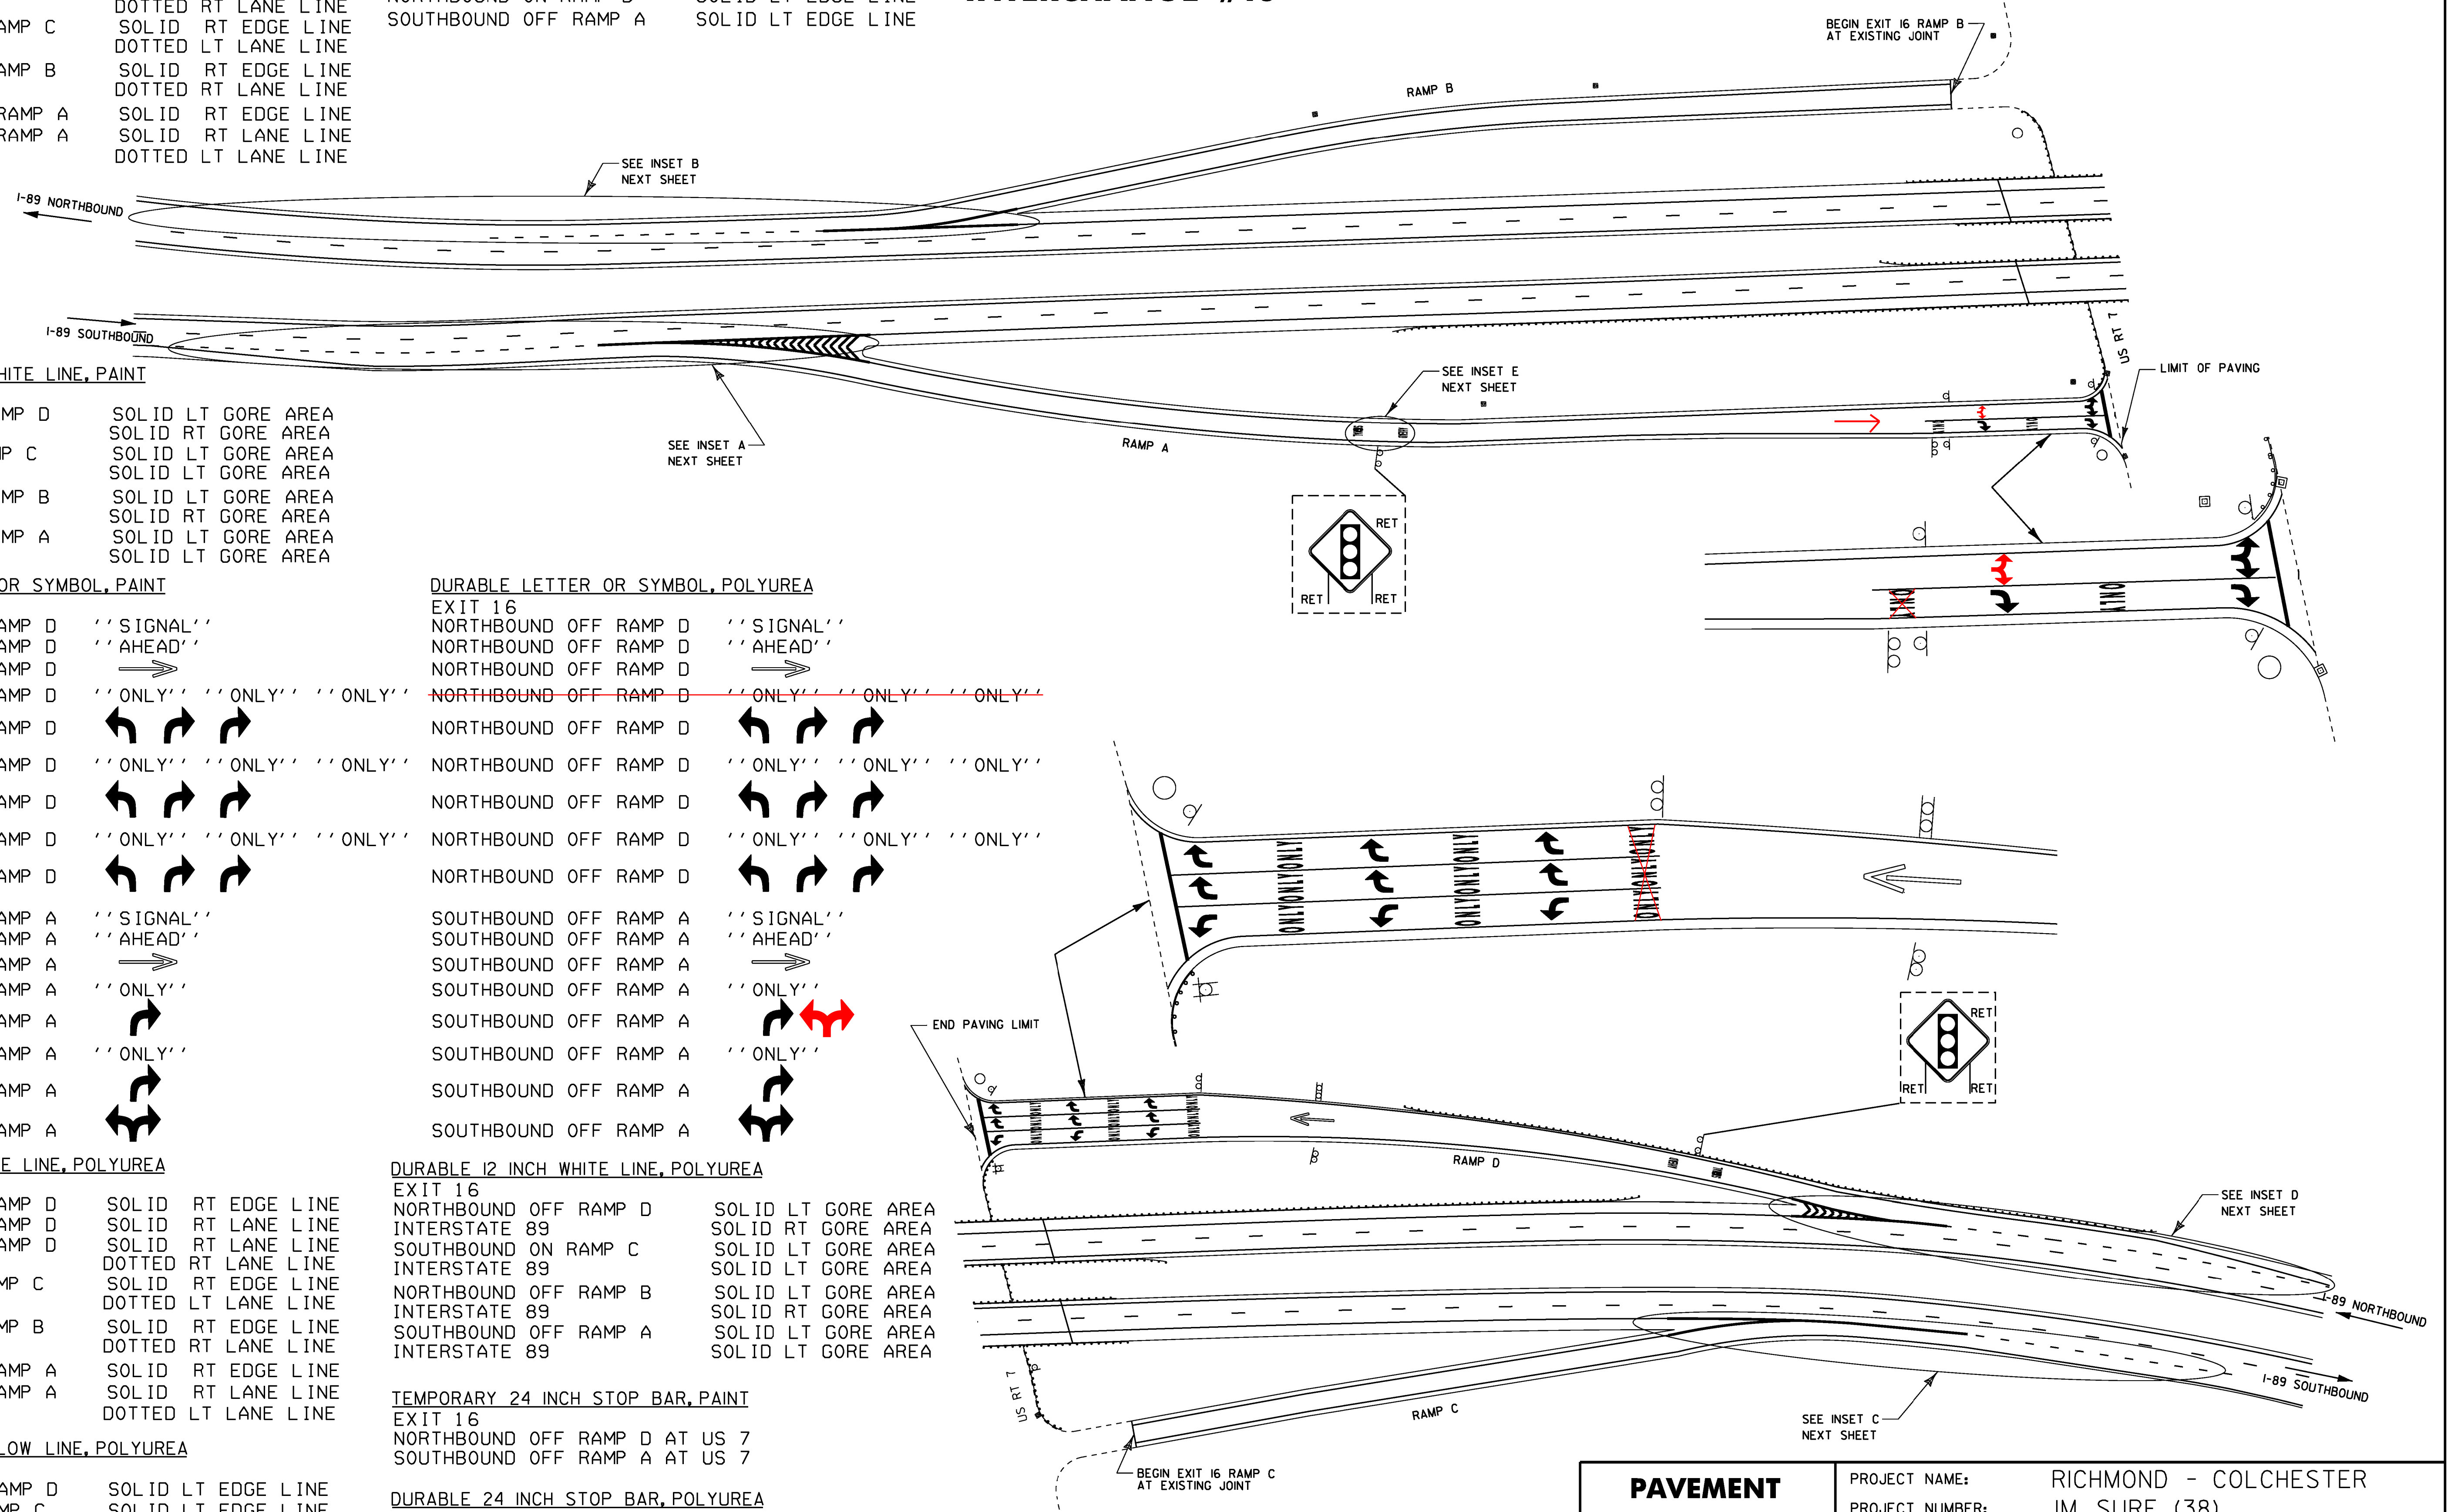

PAVEMENT MARKING DETAIL SHEET 13 EXIT 16	PROJECT NAME: RICHMOND - COLCHESTER
	PROJECT NUMBER: IM SURF (38)
	FILE NAME: pl3al36.dgn
	DESIGNED BY: LOCKE
IPARM FILE NAME: pl3al36pmd13.1	PLOT DATE: 19-DEC-2013 DRAWN BY: LOCKE CHECKED BY: FOWLER SHEET 29 OF 41

NOT TO SCALE