


**EXPANSION JOINT - ASPHALTIC PLUG DETAIL
PLAN VIEW
(FINGER PLATE JOINT)**

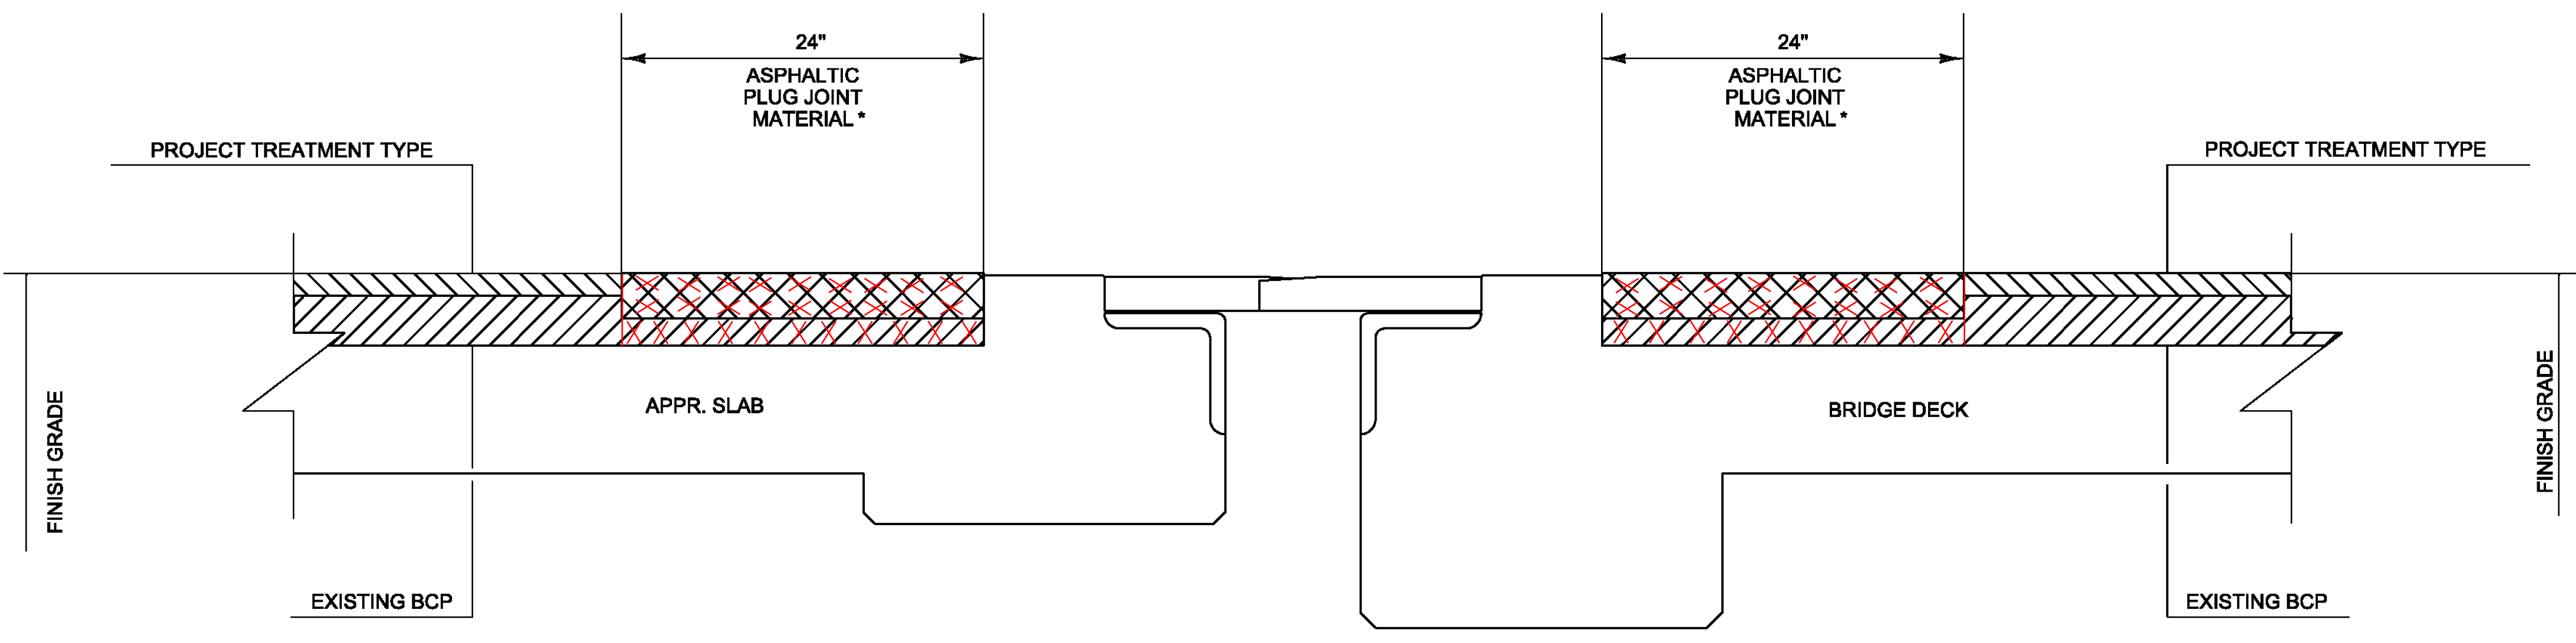

* 2" MAXIMUM DEPTH UNLESS OTHERWISE DIRECTED BY THE ENGINEER

**EXPANSION JOINT - ASPHALTIC PLUG DETAIL
CROSS SECTION VIEW
(FINGER PLATE JOINT)**

NOT TO SCALE

BRIDGE DETAIL SHEET # 5	PROJECT NAME: FAIRLEE - NEWBURY	
	PROJECT NUMBER: IM SURF (40)	
	FILE NAME: i3a236\pl3a236.dgn	PLOT DATE: 20-FEB-2014
	PROJECT LEADER: M. FOWLER	DRAWN BY: LOCKE
DESIGNED BY: LOCKE	CHECKED BY: FOWLER	
IPARM FILE NAME: pl3a236_09.i	SHEET 9	OF 27