


**EXPANSION JOINT - ASPHALTIC PLUG DETAIL
PLAN VIEW
(VERMONT OR VERTICAL PLATE JOINT)**

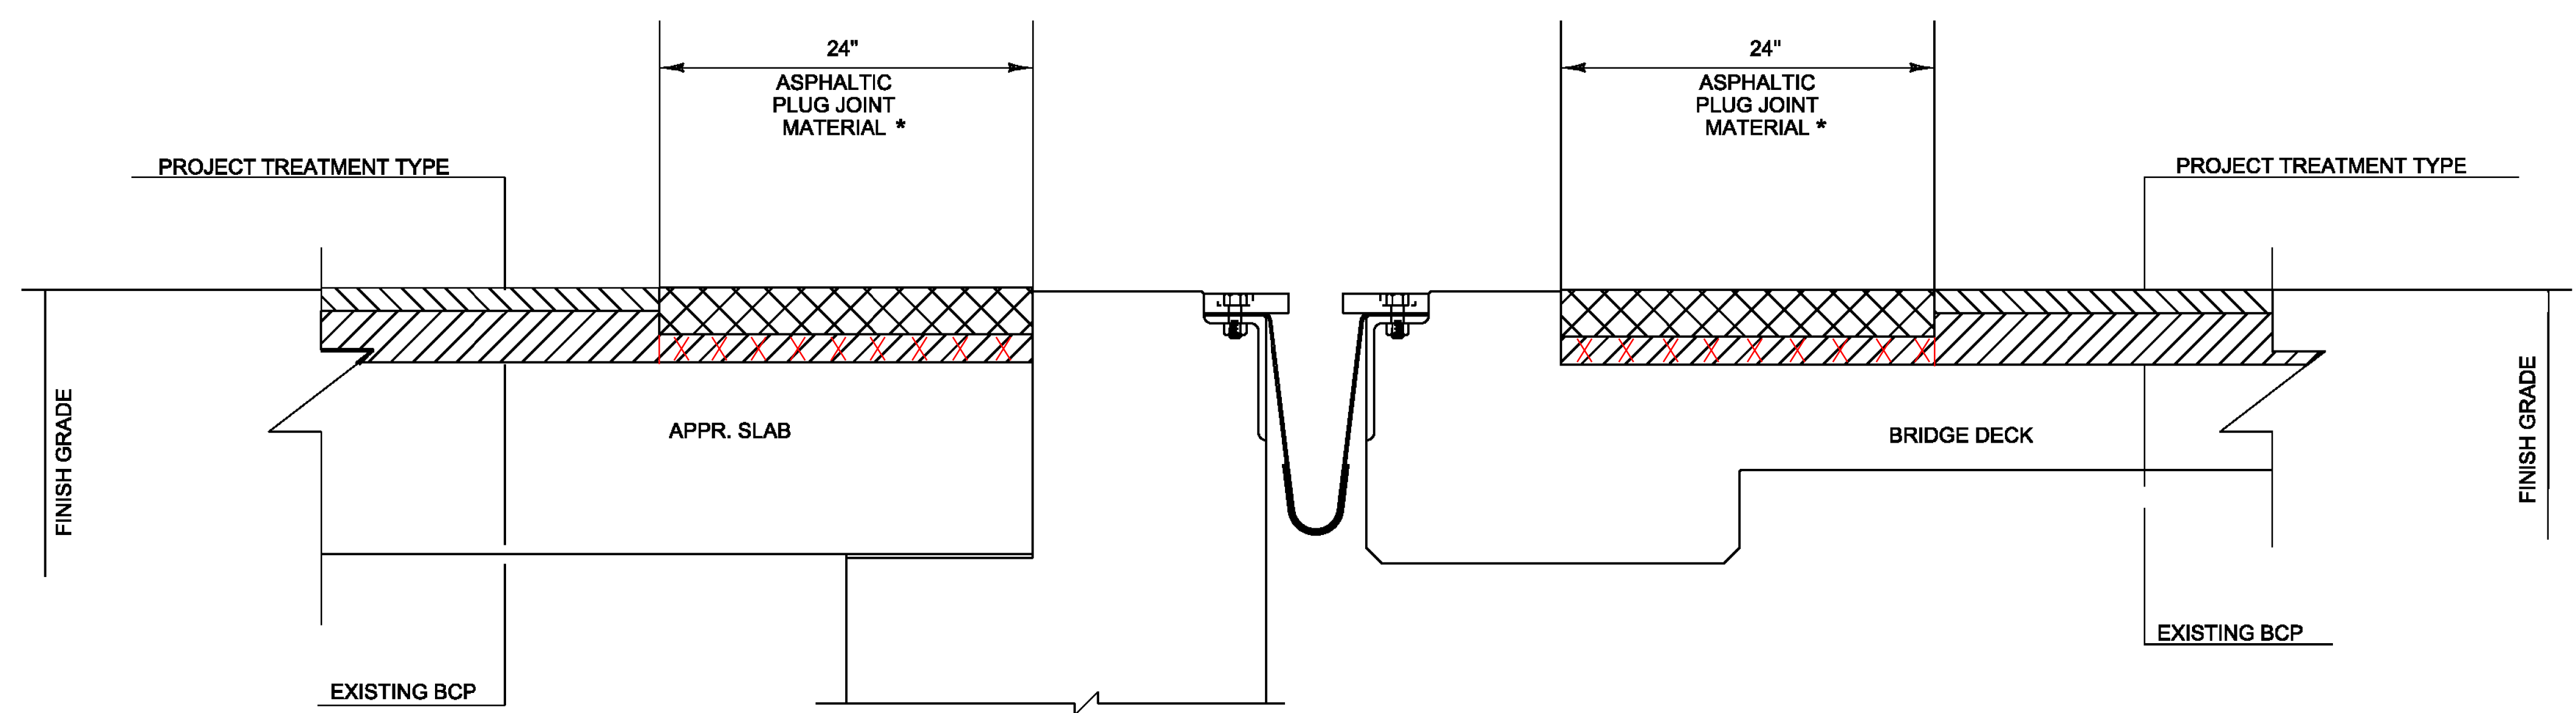

* 2" MAXIMUM DEPTH UNLESS OTHERWISE DIRECTED BY THE ENGINEER

**EXPANSION JOINT - ASPHALTIC PLUG DETAIL
CROSS SECTION VIEW
(VERMONT OR VERTICAL PLATE JOINT)**

NOT TO SCALE

BRIDGE DETAIL SHEET # 6	PROJECT NAME: FAIRLEE - NEWBURY
	PROJECT NUMBER: IM SURF (40)
	FILE NAME: I3a236\pl3a236.dgn
PROJECT LEADER: M. FOWLER	PLOT DATE: 20-FEB-2014
DESIGNED BY: LOCKE	DRAWN BY: LOCKE
IPARM FILE NAME: pl3a236_I0.I	CHECKED BY: FOWLER
	SHEET 10 OF 27