
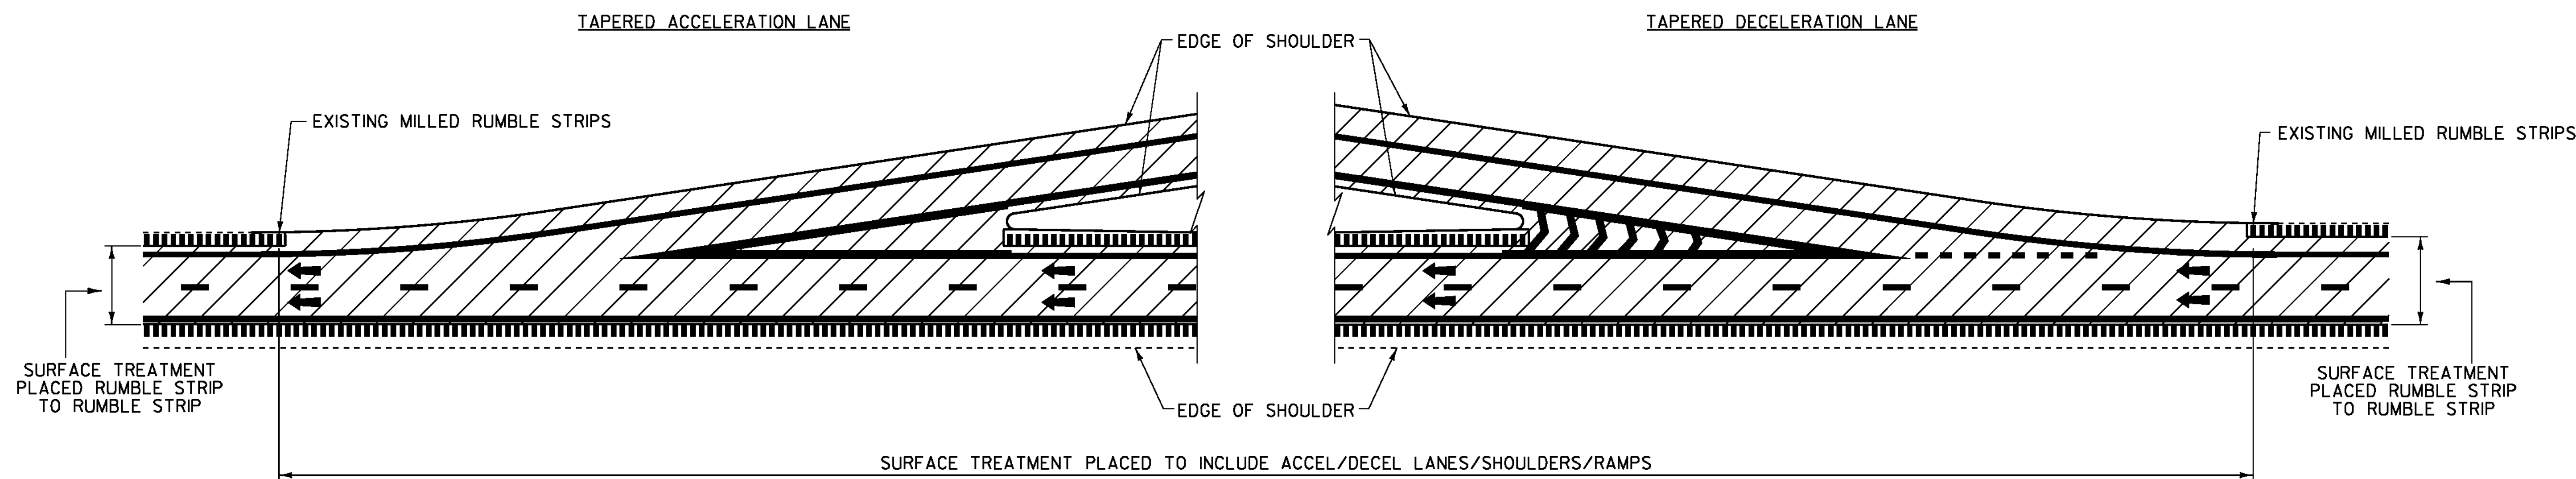


TYPICAL INTERCHANGE CONSTRUCTION DETAILS # 1

NOT TO SCALE

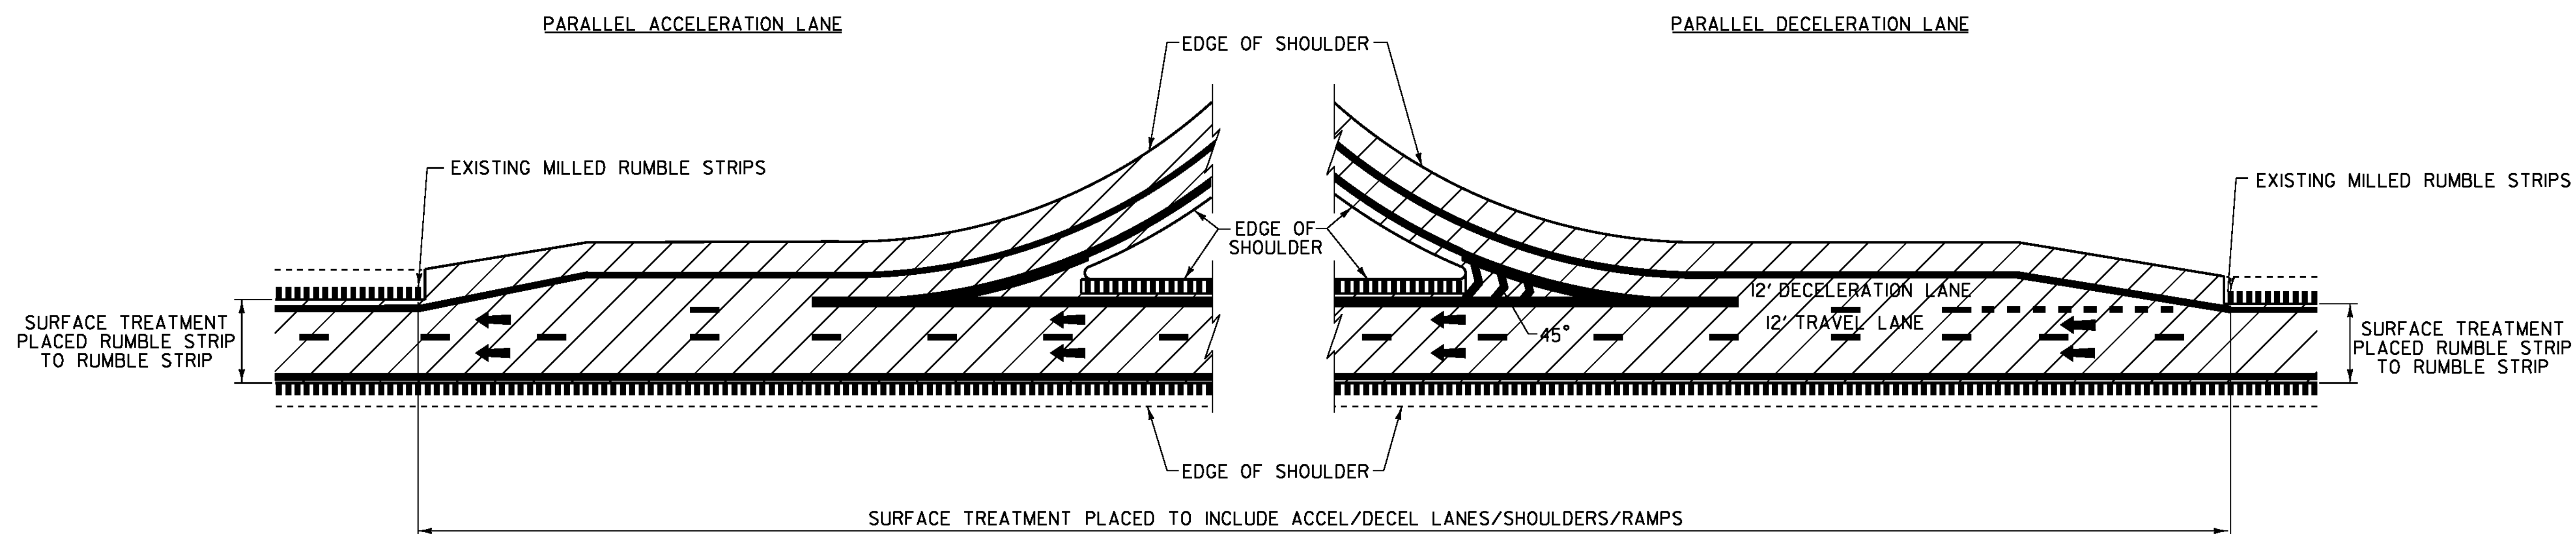

NOTES:
1. LINE STRIPING SHOWN FOR REFERENCE ONLY.

LEGEND



SURFACE TREATMENT



DIRECTION OF TRAFFIC FLOW



EXISTING MILLED RUMBLE STRIPS

TYPICAL INTERCHANGE CONSTRUCTION DETAILS # 1

PROJECT NAME: FAIRLEE - NEWBURY
PROJECT NUMBER: IM SURF (40)

FILE NAME: I3a236\pl3a236.dgn
PROJECT LEADER: M. FOWLER
DESIGNED BY: LOCKE
IPARM FILE NAME: pl3a236_1L1

PLOT DATE: 20-FEB-2014
DRAWN BY: LOCKE
CHECKED BY: FOWLER
SHEET 11 OF 27