


MM 98.000
SEE PREVIOUS SHEET

MM 103.000
SEE BELOW

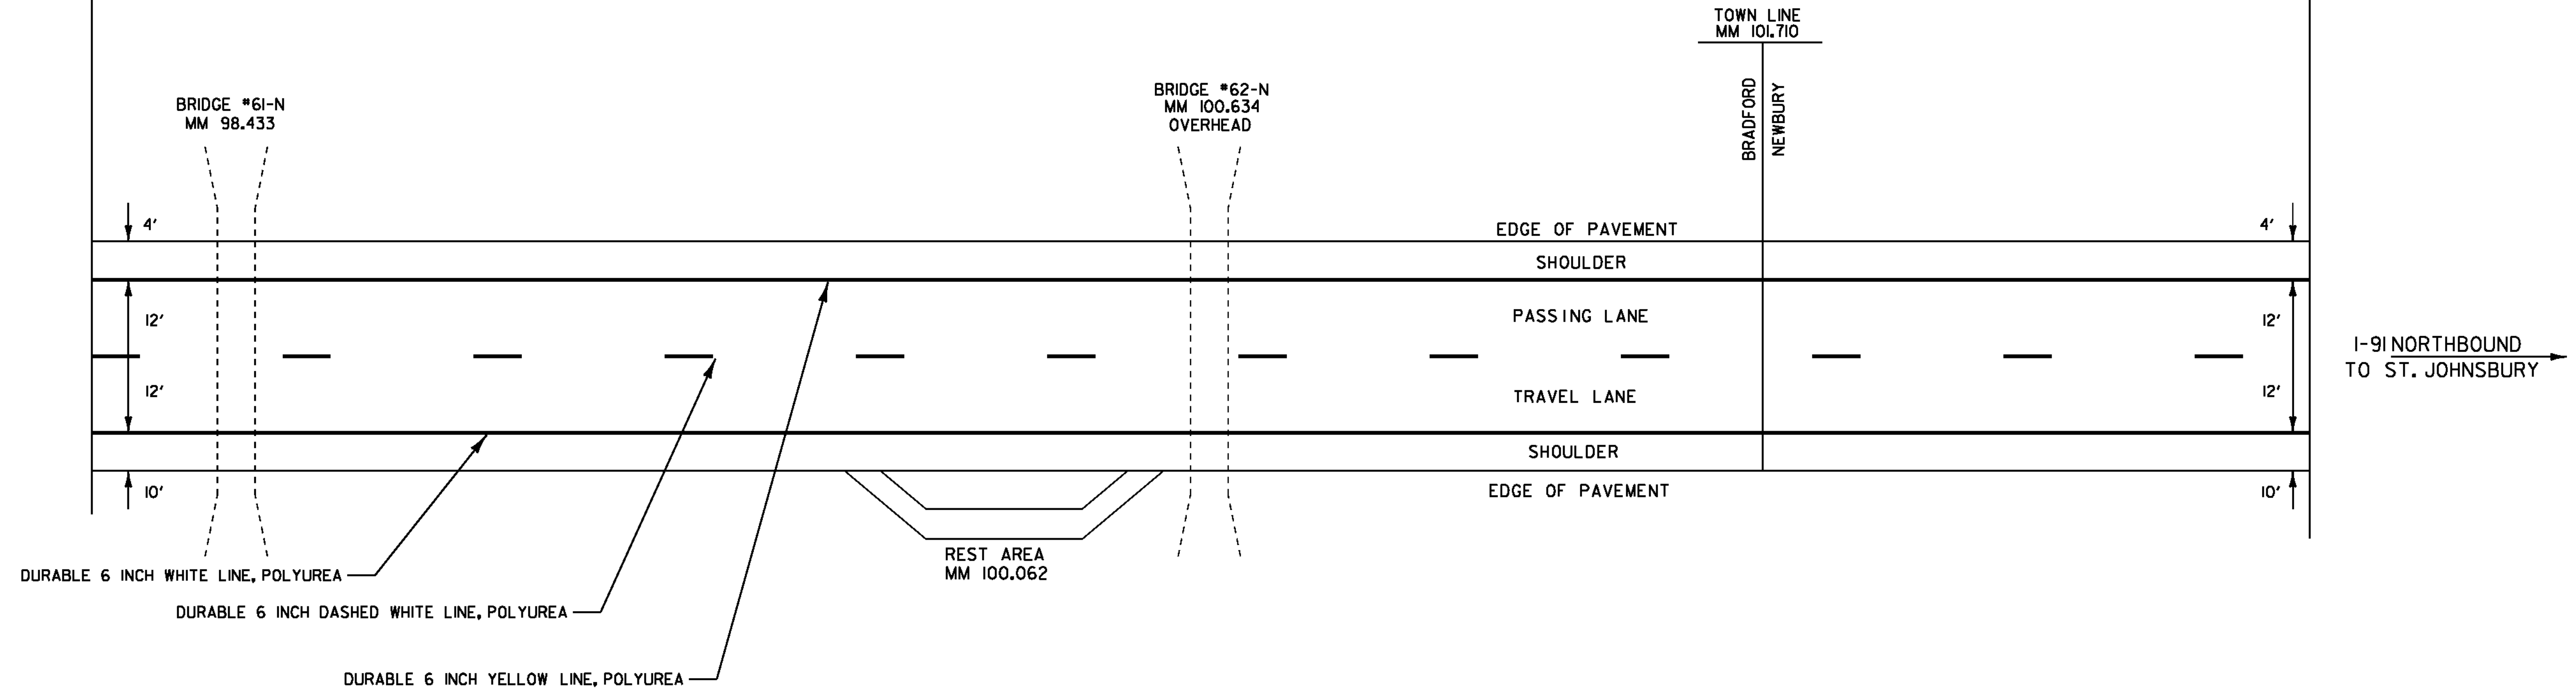

TEMPORARY 6 INCH WHITE LINE, PAINT
MM 98.000 - MM 105.030 NB (SOLID RT)
MM 98.000 - MM 105.030 NB (DASHED CL)


TEMPORARY 6 INCH YELLOW LINE, PAINT
MM 98.000 - MM 105.030 NB (SOLID LT)

DURABLE 6 INCH WHITE LINE, POLYUREA
MM 98.000 - MM 105.030 NB (SOLID RT)
MM 98.000 - MM 105.030 NB (DASHED CL)

DURABLE 6 INCH YELLOW LINE, POLYUREA
MM 98.000 - MM 105.030 NB (SOLID LT)

MM 103.000
SEE ABOVE

INTERSTATE ROUTE 91
NORTHBOUND
MM 105.030
END PROJECT IM SURF(40)

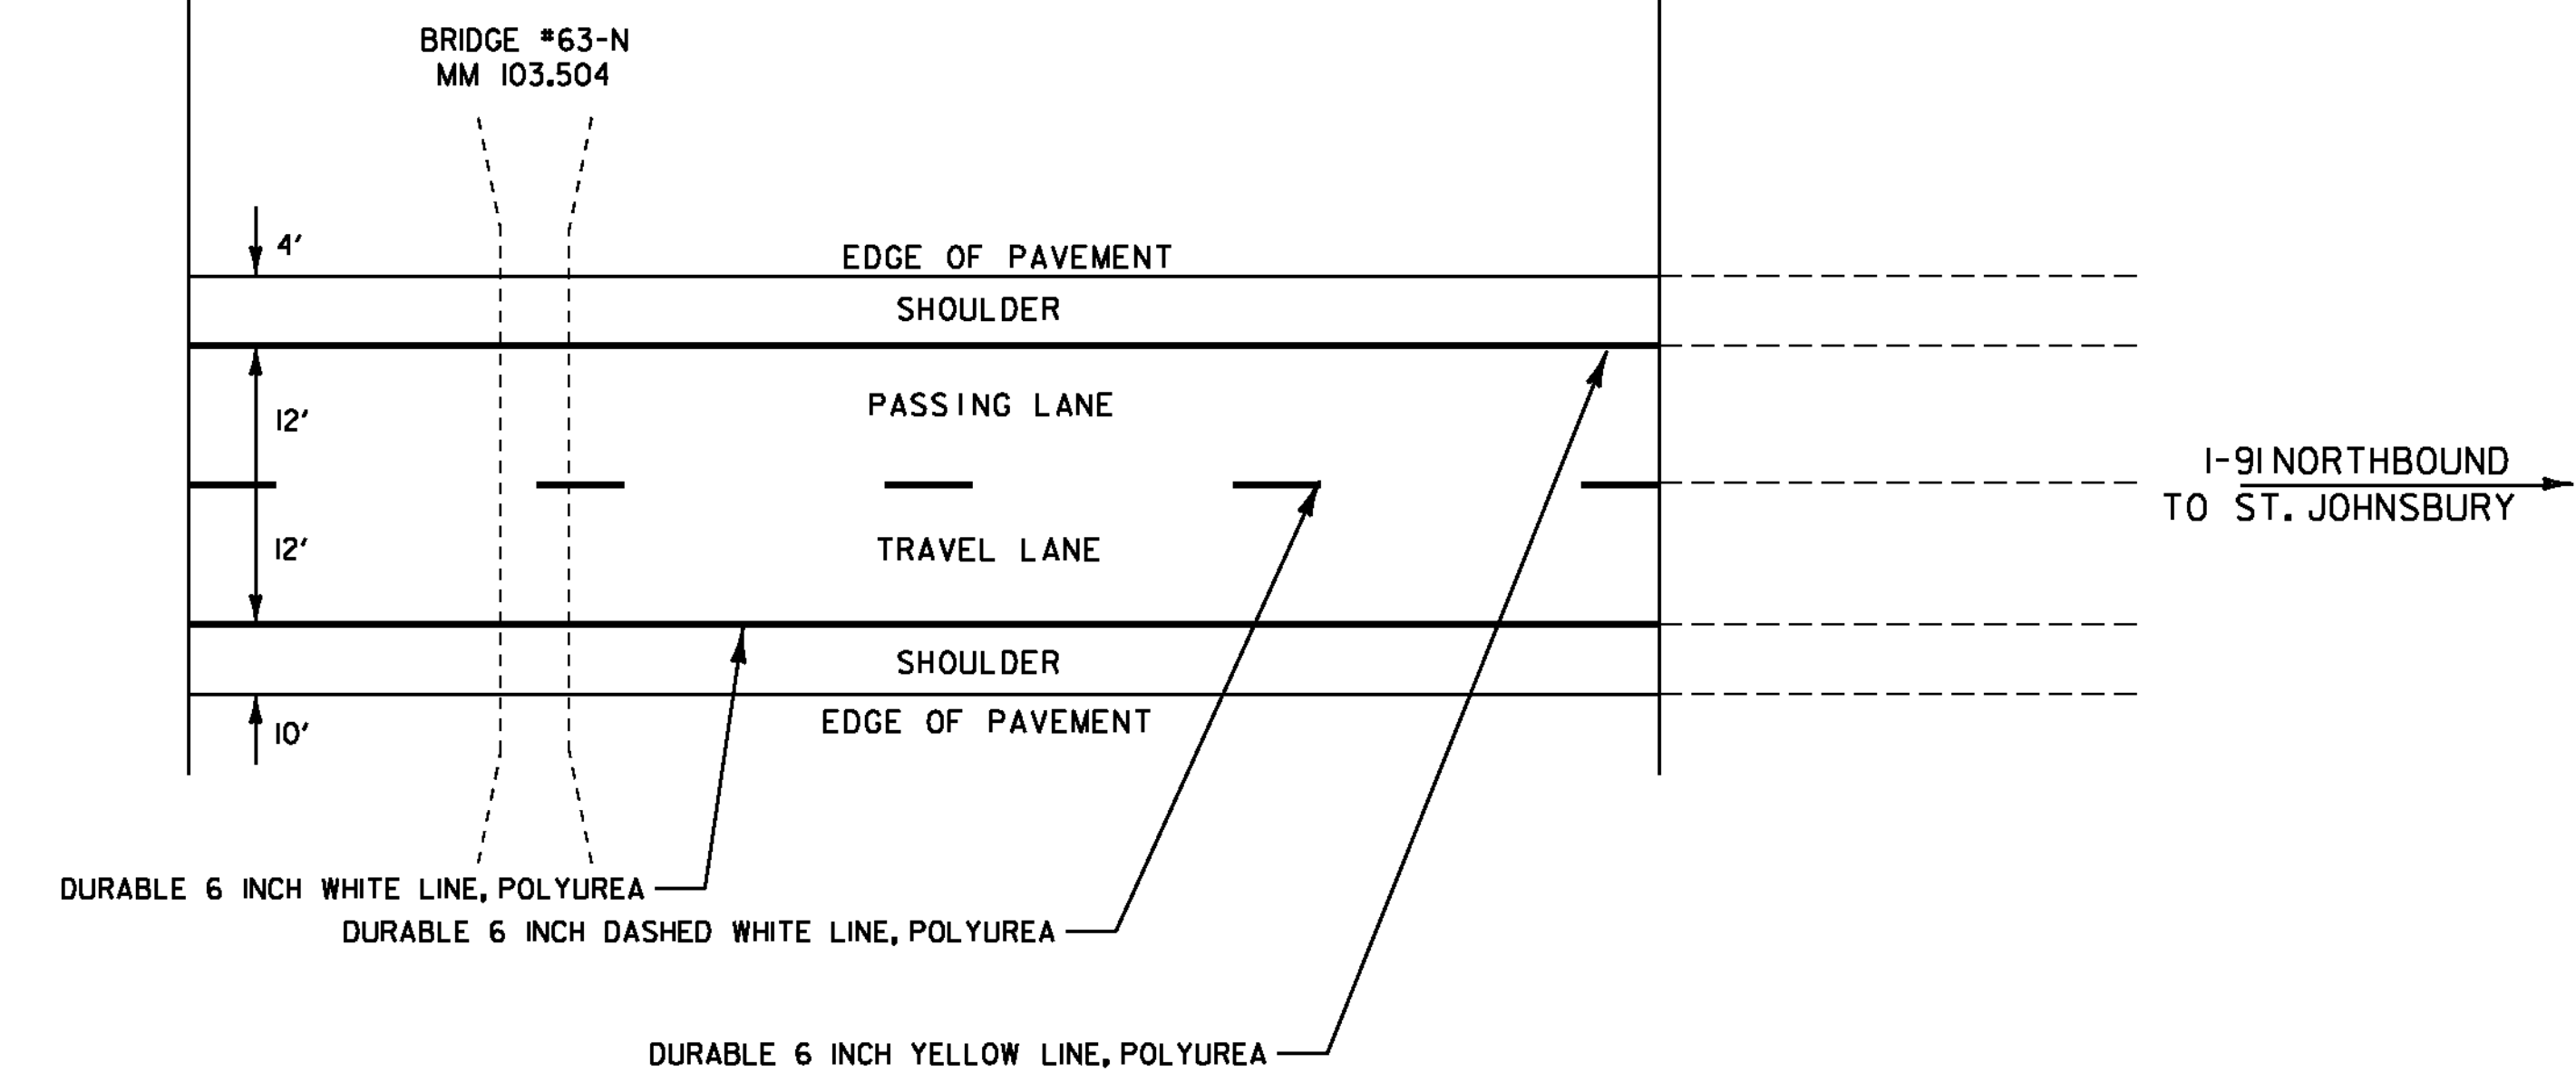

NOT TO SCALE

PAVEMENT MARKING DETAIL SHEET 2 MAINLINE	PROJECT NAME: FAIRLEE - NEWBURY
	PROJECT NUMBER: IM SURF (40)
	FILE NAME: I3a236\pl3a236.dgn PROJECT LEADER: M. FOWLER DESIGNED BY: LOCKE IPARM FILE NAME: pl3a236_i5.t