
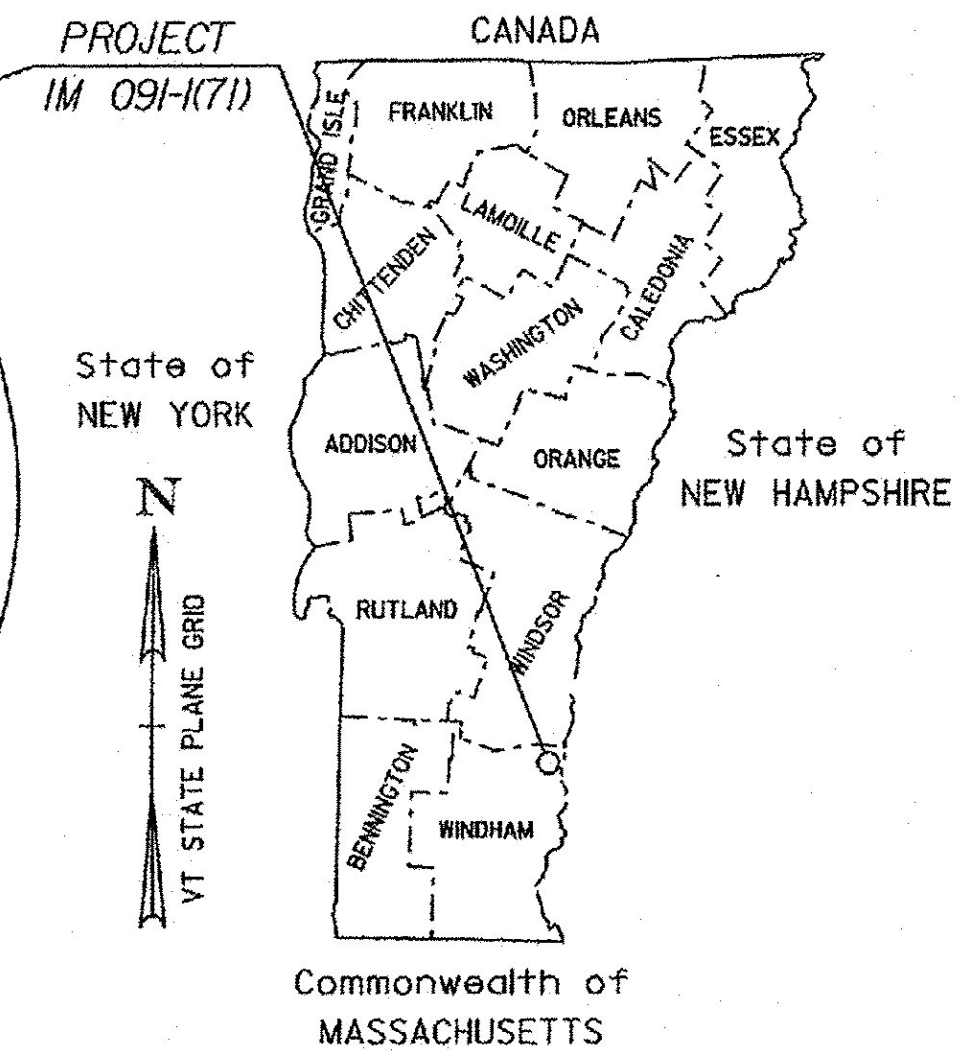
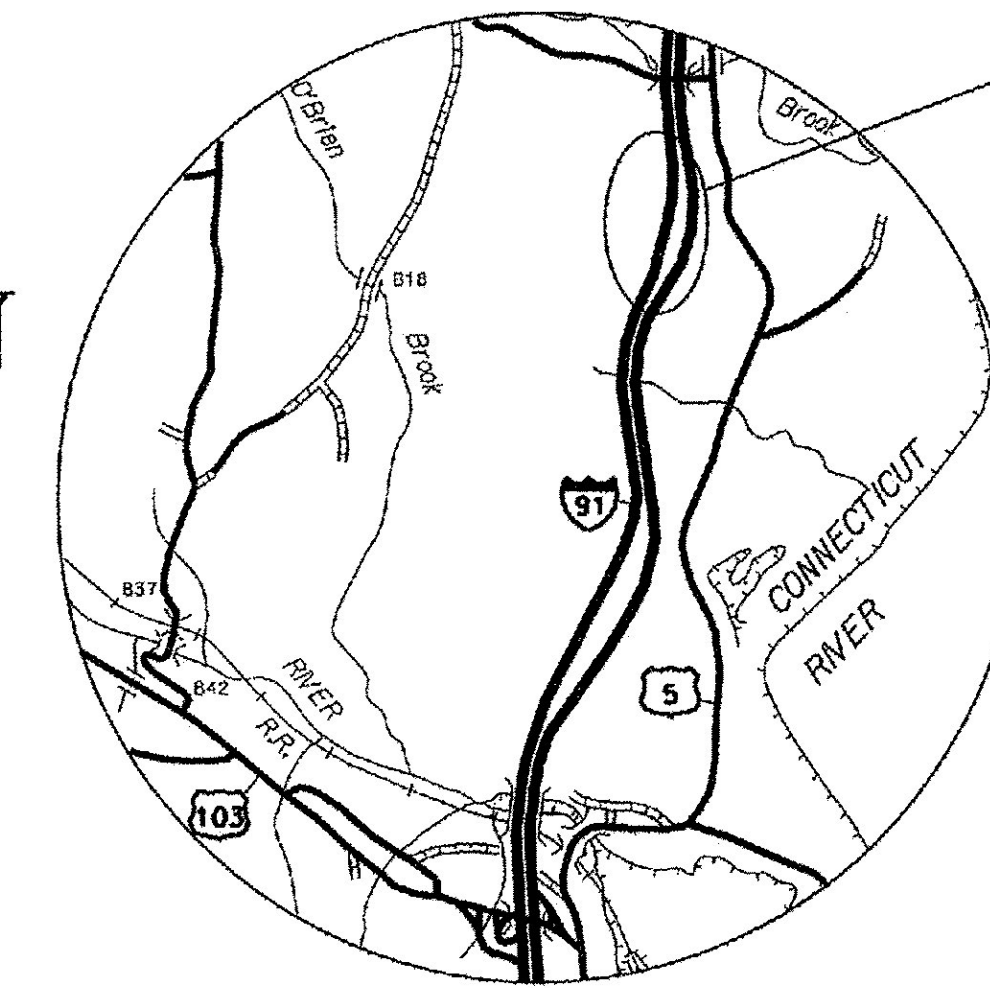


STATE OF VERMONT AGENCY OF TRANSPORTATION

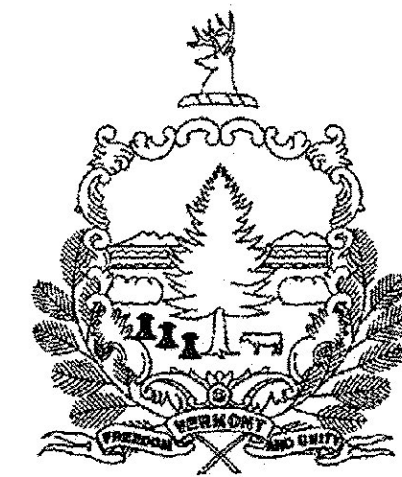

RECORD PLANS	
CONTRACTOR:	BAZIN BROTHERS, INC. - WESTMINSTER, VT
RESIDENT ENGINEER:	DARYL BASSETT
CONSTRUCTION BEGAN:	APRIL 28, 2016
CONSTRUCTION COMPLETE:	OCTOBER 1, 2016
RECORD PLANS BY:	DARYL BASSETT & KEVIN KING
I HEREBY CERTIFY THAT ALL THE CONSTRUCTION REQUIRED BY THIS SET OF DRAWINGS HAS BEEN ACCOMPLISHED AS INDICATED HEREIN.	
BY	RESIDENT ENGINEER
DATE	5/8/17
NOTE: Any further information concerning final quantities, amounts or other details relative to this project may be found at Central Files in the electronic archives.	


PROPOSED IMPROVEMENT TOWN OF ROCKINGHAM COUNTY OF WINDHAM

INTERSTATE 91 (PRINCIPAL ARTERIAL-INTERSTATE)(NHS)

PROJECT LOCATION: BEGINNING IN THE TOWN OF ROCKINGHAM ON INTERSTATE 91 SOUTHBOUND AT STATION 1982+50.00 (MM 37.547) AND EXTENDING NORTHERLY 750.00 FEET (0.142 MILES) TO STATION 1990+00.00 (MM 37.689)

PROJECT DESCRIPTION: WORK TO BE PERFORMED UNDER THIS PROJECT INCLUDES THE CONSTRUCTION OF A ROADSIDE CATCHMENT DITCH, LEDGE REMOVAL, AND OTHER HIGHWAY RELATED ITEMS.


LENGTH OF PROJECT: 750.00 FEET = 0.142 MILES

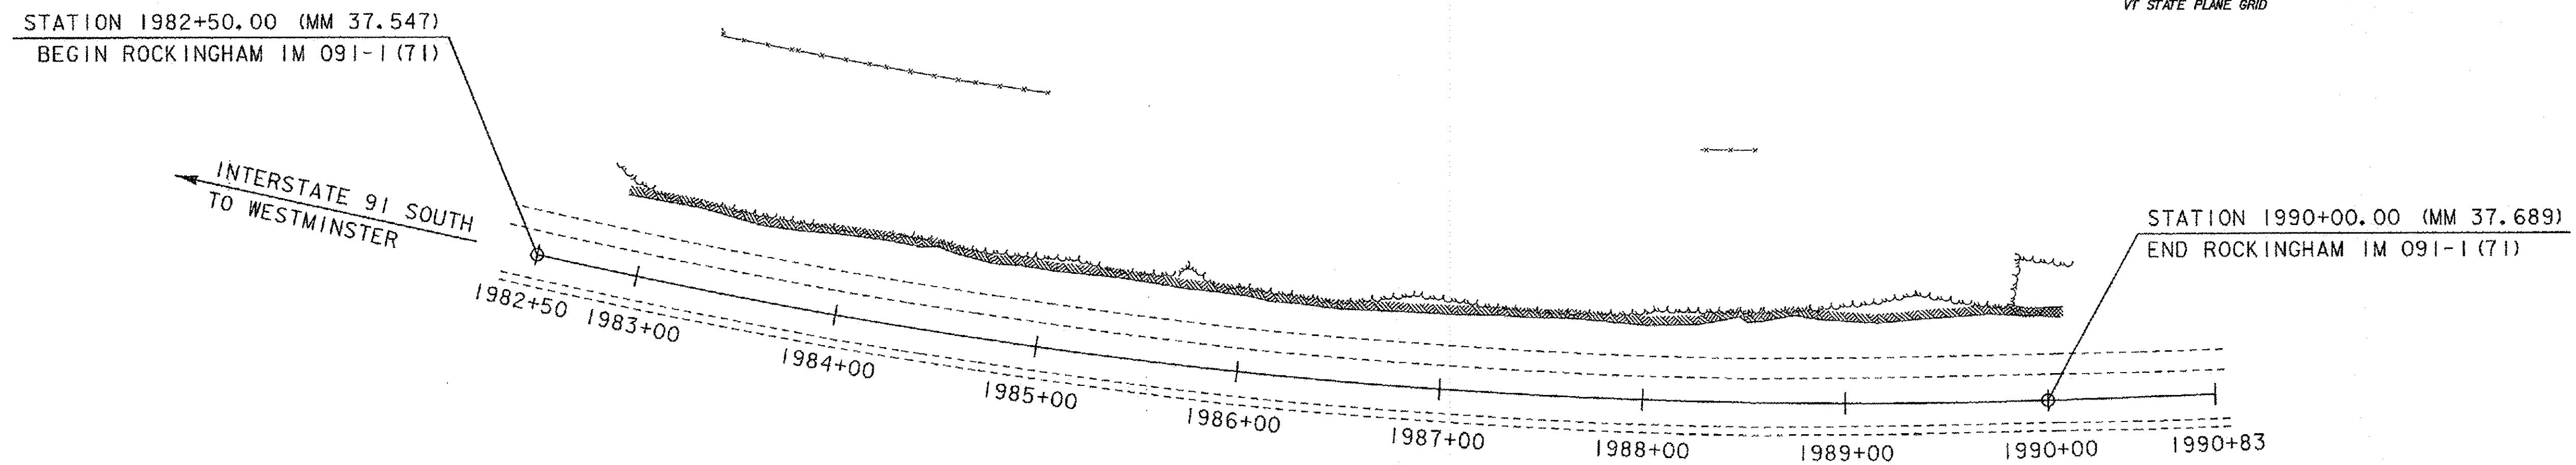

CONSTRUCTION IS TO BE CARRIED ON IN ACCORDANCE WITH THESE PLANS AND THE STANDARD SPECIFICATIONS FOR CONSTRUCTION DATED 2011, AS APPROVED BY THE FEDERAL HIGHWAY ADMINISTRATION ON JULY 20, 2011 FOR USE ON THIS PROJECT, INCLUDING ALL SUBSEQUENT REVISIONS AND SUCH REVISED SPECIFICATIONS AND SPECIAL PROVISIONS AS ARE INCORPORATED IN THESE PLANS.

QUALITY ASSURANCE PROGRAM : LEVEL 1	
SURVEYED BY :	VTRANS
SURVEYED DATE :	02/2014
DATUM	
VERTICAL	NAVD88
HORIZONTAL	NAD83(2011)

TRAFFIC DATA						
YEAR	AADT	DHV	ADTT	% T	% D	
2015	6900	1400	1500	14.6	100	
2035	7100	1500	2200	21.3	100	
18 kip ESAL for flexible pavement from 2015 to 2035: 7,522,000						
18 kip ESAL for flexible pavement from 2035 to 2055: 16,579,000						
Design speed: 65 MPH						

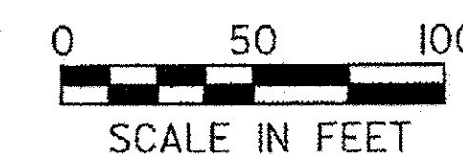

DIRECTOR OF PROJECT DELIVERY	
APPROVED	DATE 12/22/2015
PROJECT MANAGER : BRUCE MARTIN, P.E.	
PROJECT NAME : ROCKINGHAM	
PROJECT NUMBER : IM 091-I(71)	
SHEET 1 OF 35 SHEETS	