


CLEARING AND GRUBBING, INCLUDING
INDIVIDUAL TREES AND STUMPS
STA 1987+00 LT - STA 1990+00 LT

COMMON EXCAVATION (OVERBURDEN REMOVAL)
STA 1987+00 LT - STA 1990+00 LT

SOLID ROCK EXCAVATION
STA 1987+00 LT - STA 1990+00 LT

DELINEATOR WITH STEEL POST
STA 1987+85 LT

REMOVAL OF EXISTING DELINEATOR
STA 1987+85 LT

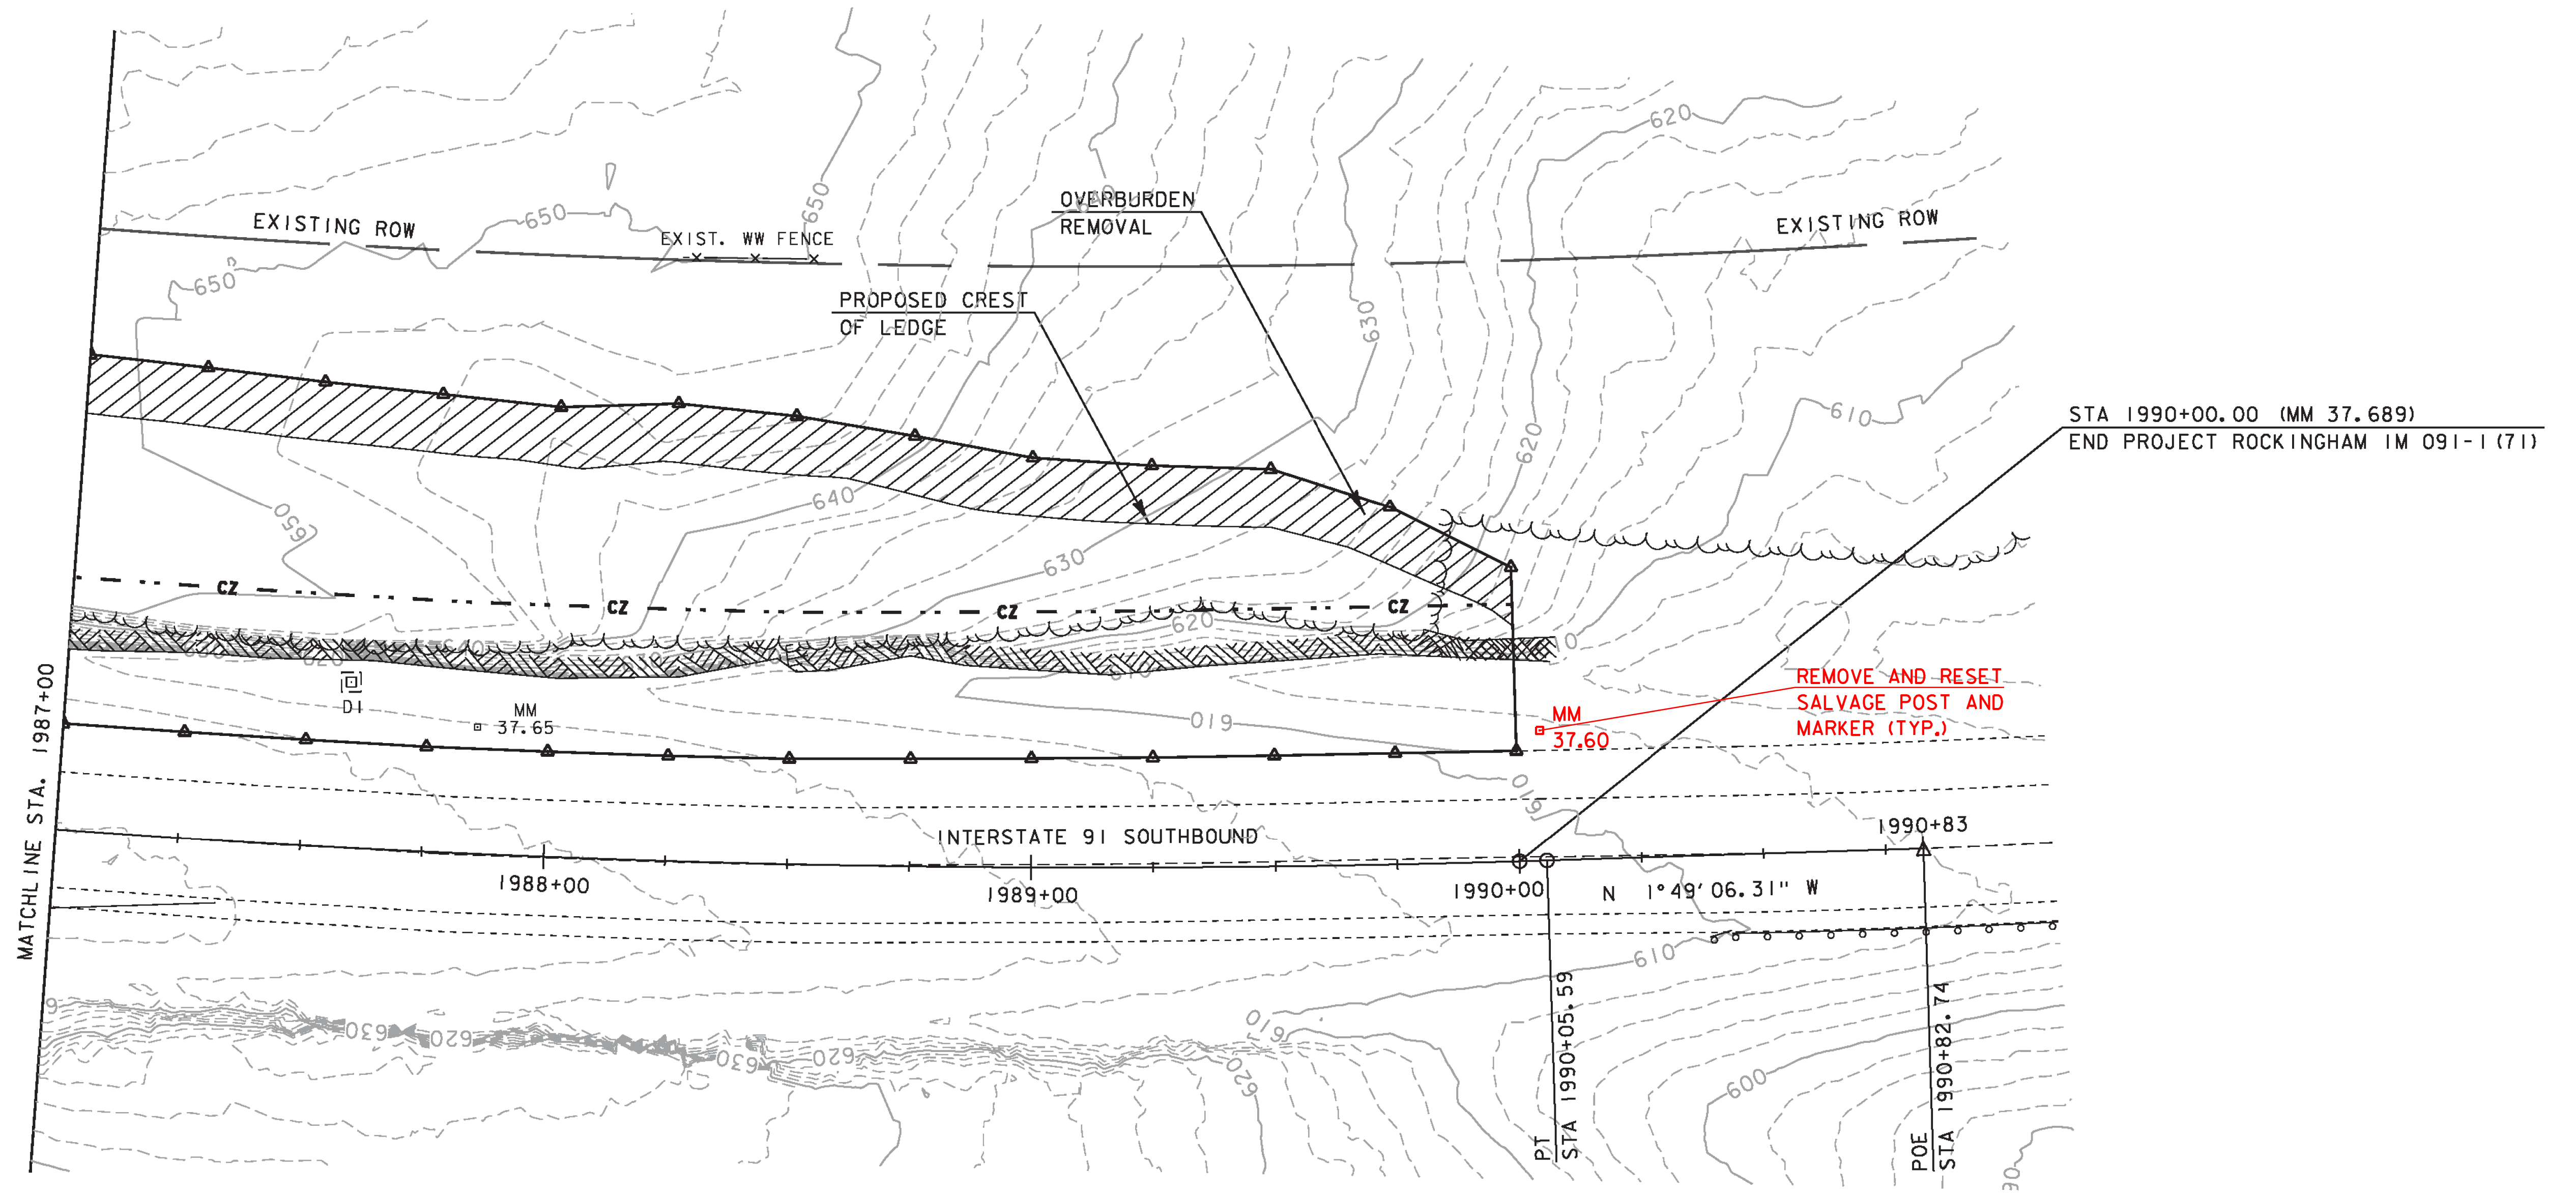

| | | | |
|-----------------|----------------|-------------|-------------|
| PROJECT NAME: | ROCKINGHAM | PLOT DATE: | 05-FEB-2016 |
| PROJECT NUMBER: | IM 091-(71) | DRAWN BY: | A. KEMPTON |
| FILE NAME: | d13a366nul.dgn | CHECKED BY: | M. GAMELIN |
| PROJECT LEADER: | B. MARTIN | SHEET | II OF 35 |
| DESIGNED BY: | A. KEMPTON | | |
| PLAN SHEET 2 | | | |