




1982+75

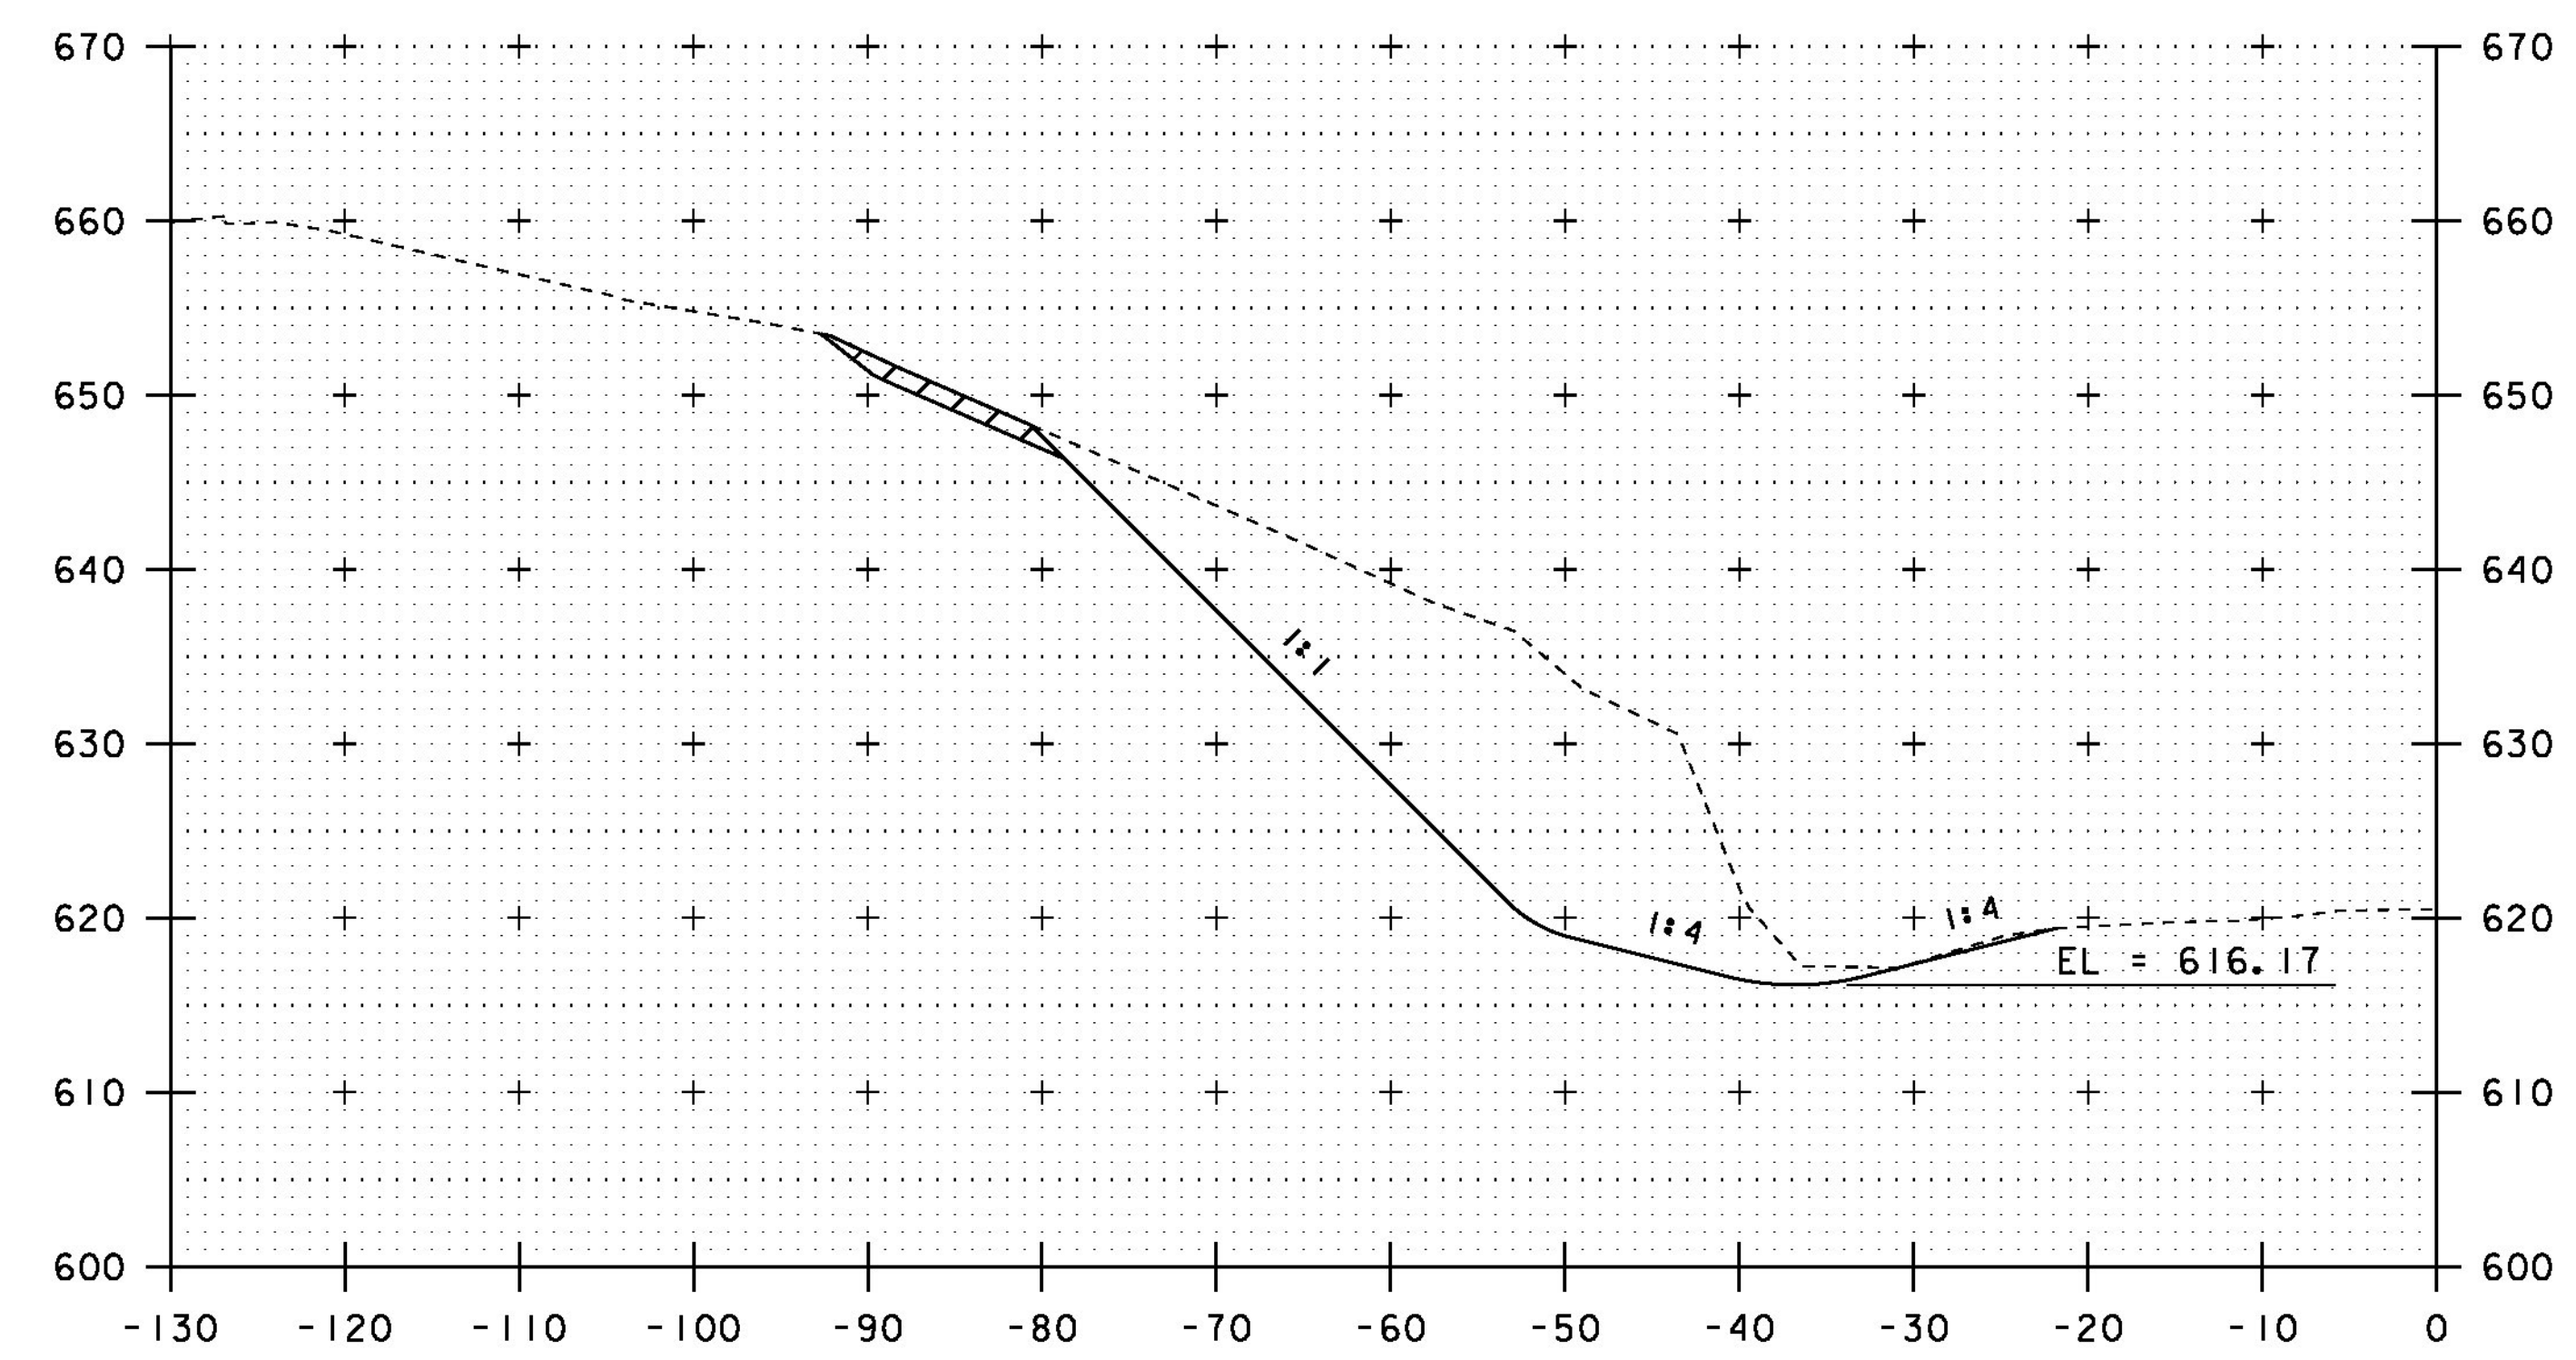

1983+25

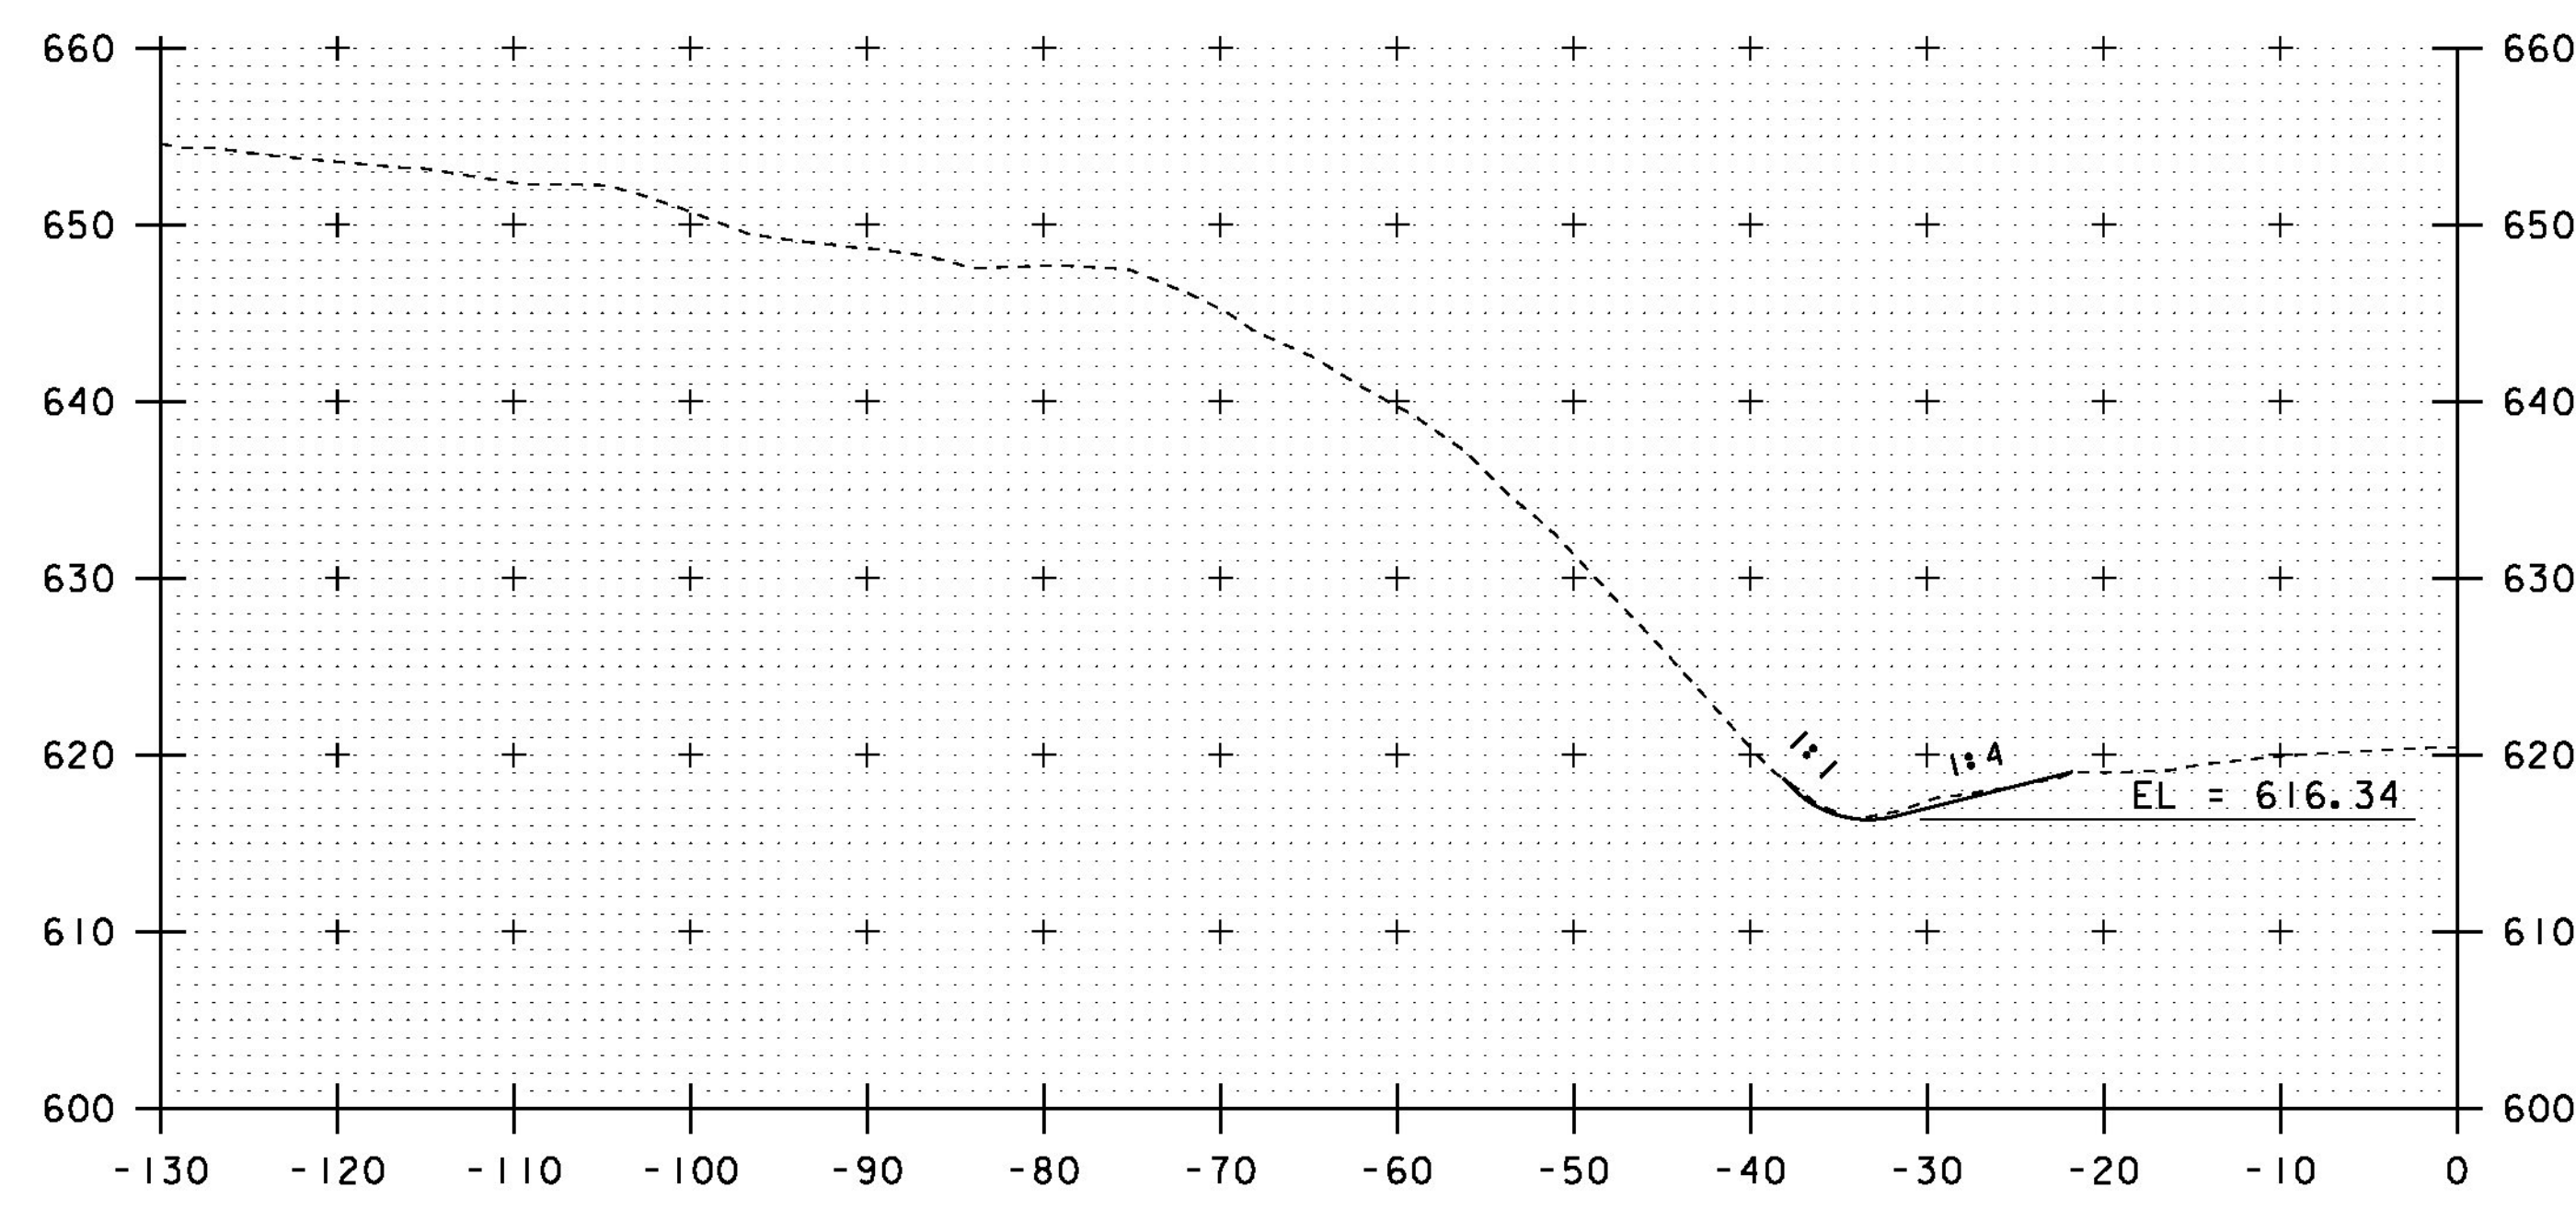

1982+50
BEGIN PROJECT

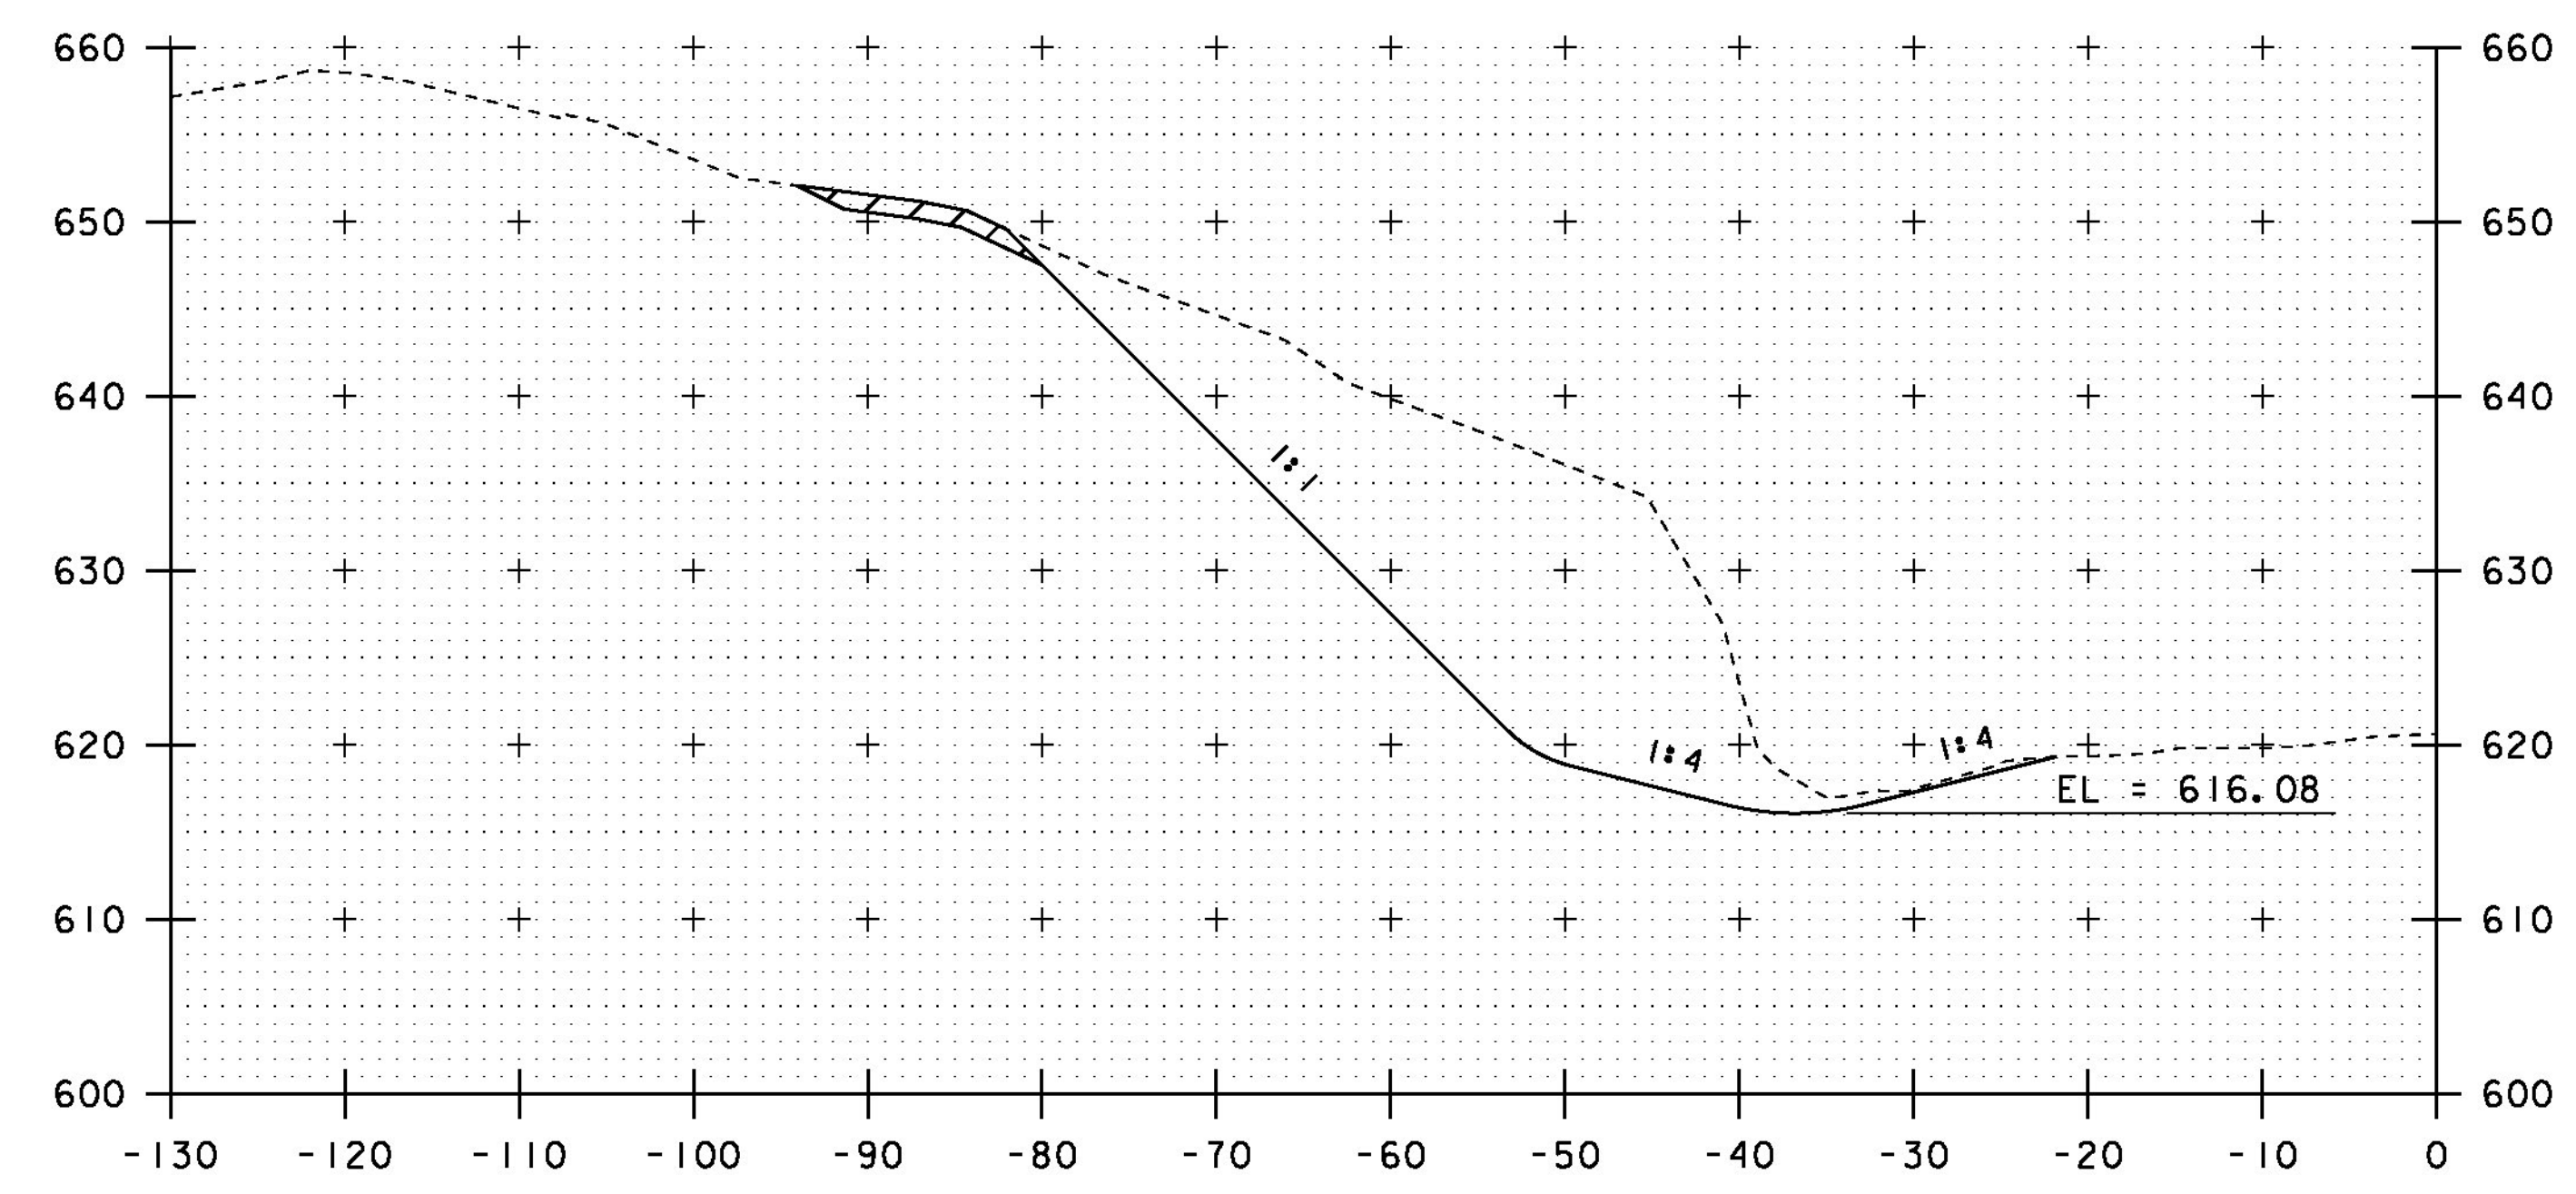

1983+00

STA. 1982+50 TO STA. 1983+25

PROJECT NAME: ROCKINGHAM	PLOT DATE: 29-JAN-2016
PROJECT NUMBER: IM 091-I(71)	DRAWN BY: A. KEMPTON
FILE NAME: d13a366xs.dgn	CHECKED BY: M. GAMELIN
PROJECT LEADER: B. MARTIN	SHEET 20 OF 35
DESIGNED BY: A. KEMPTON	
CROSS SECTION SHEET 1	