




1983+75

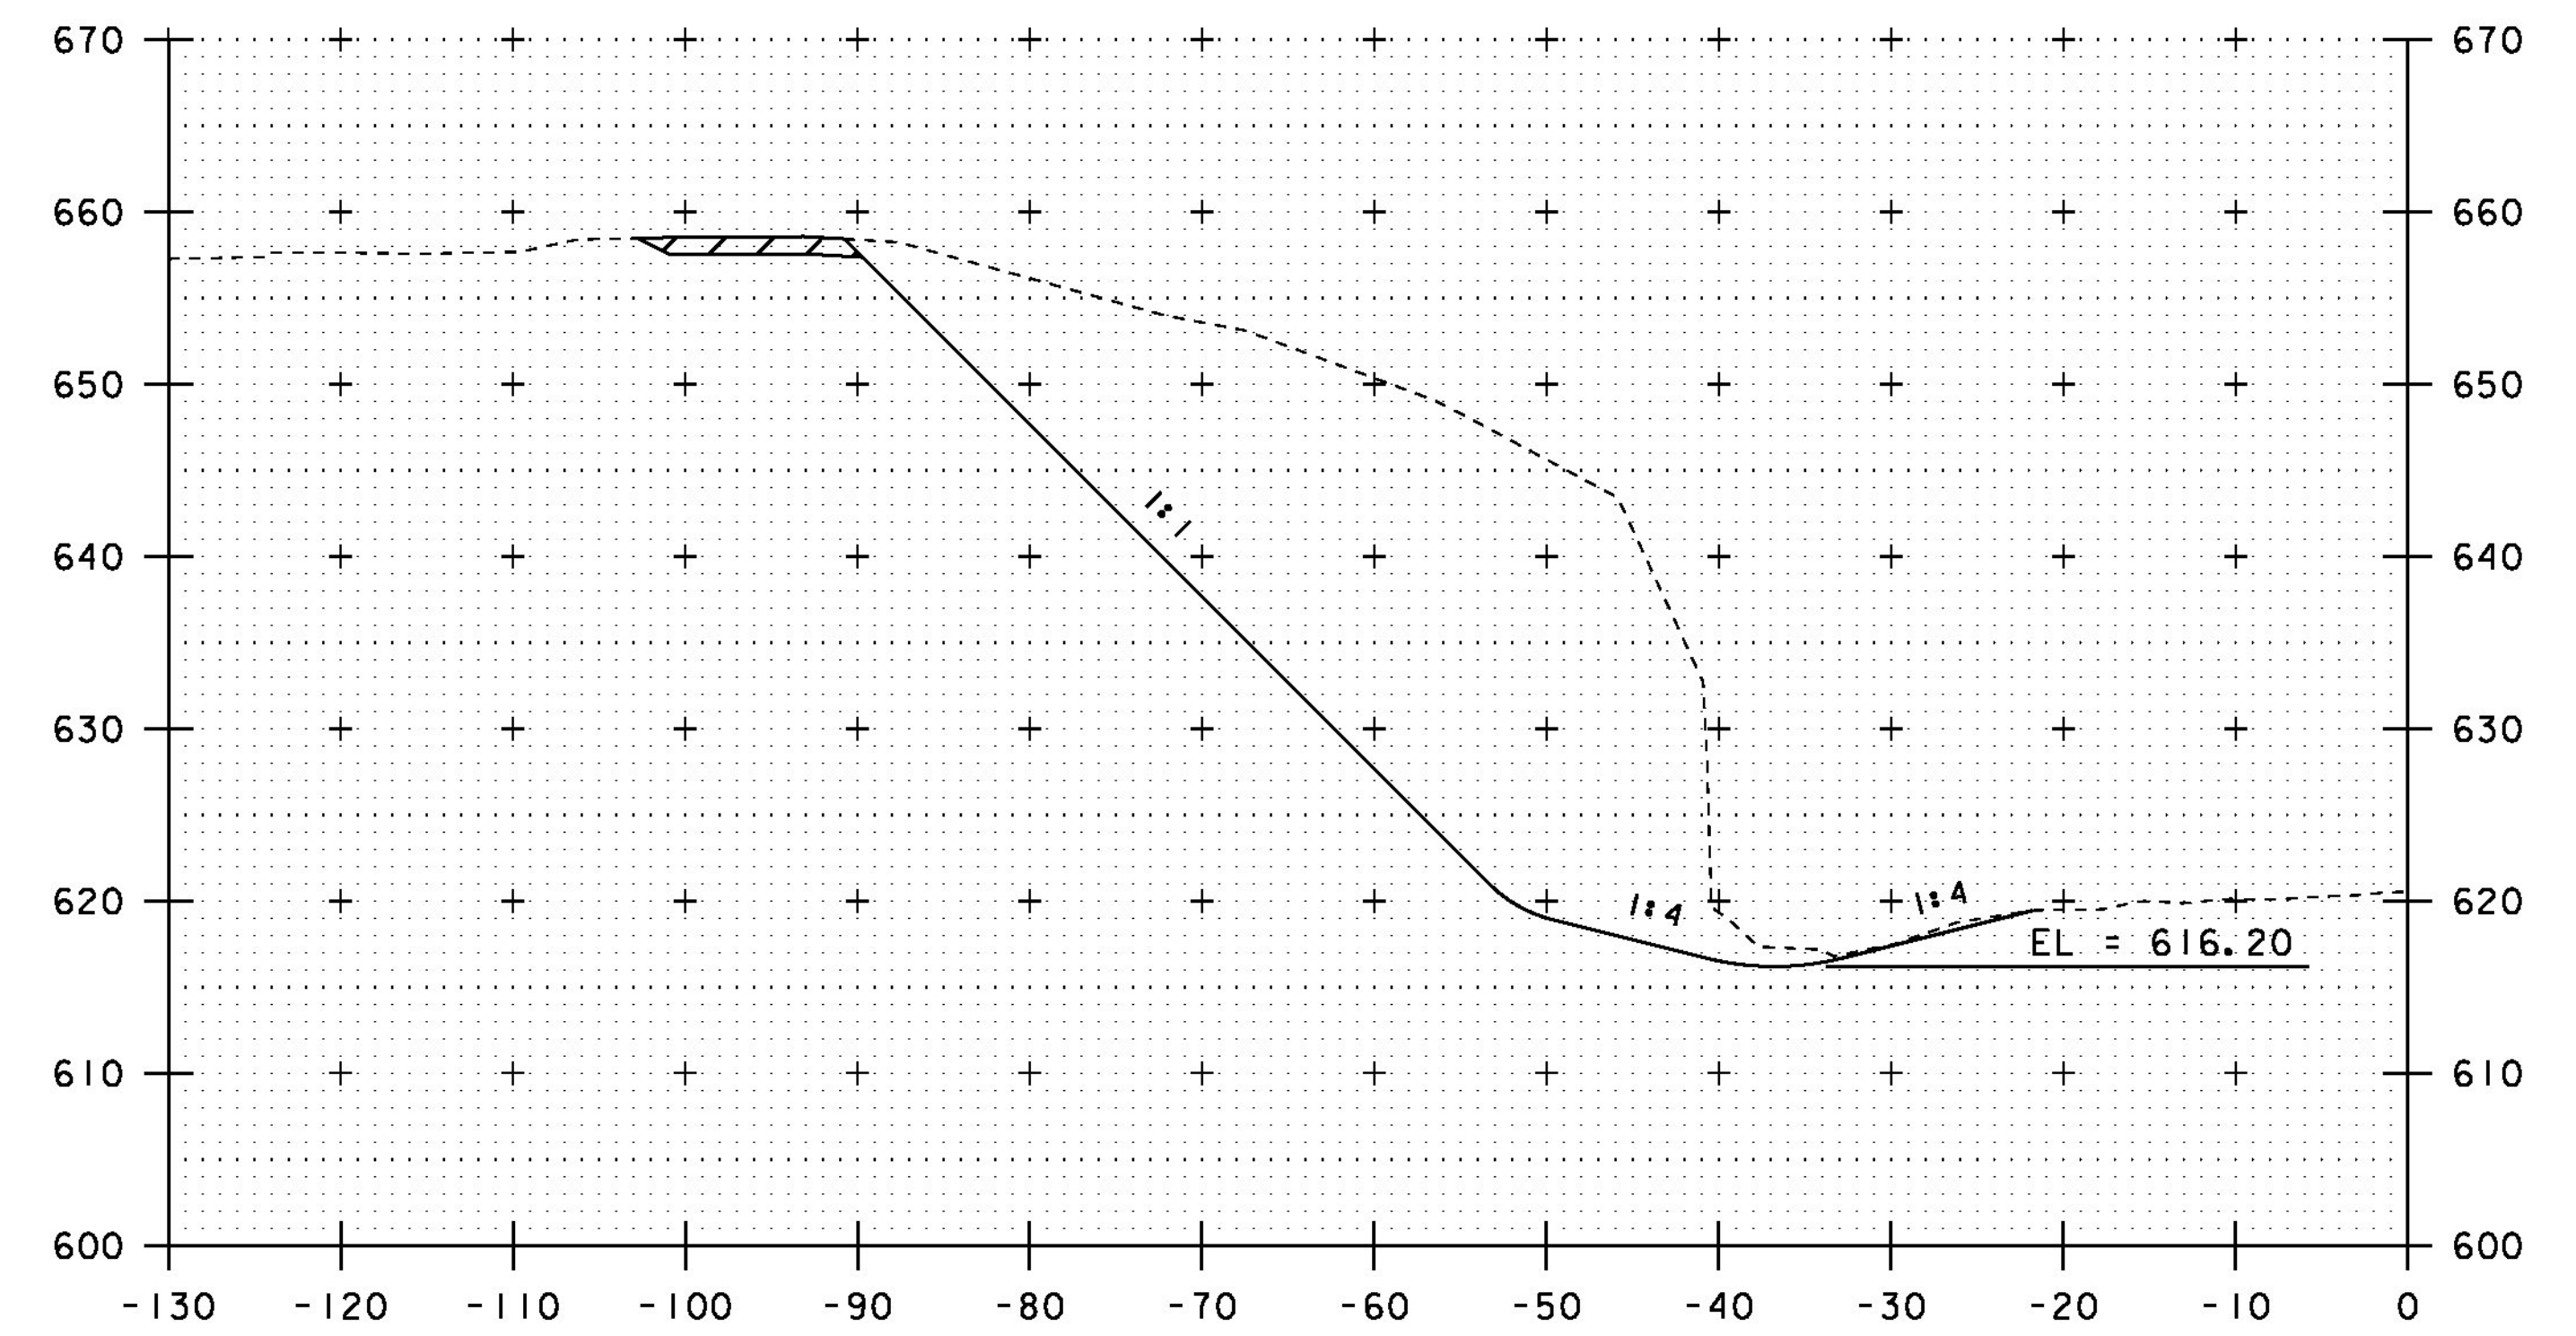

1984+25

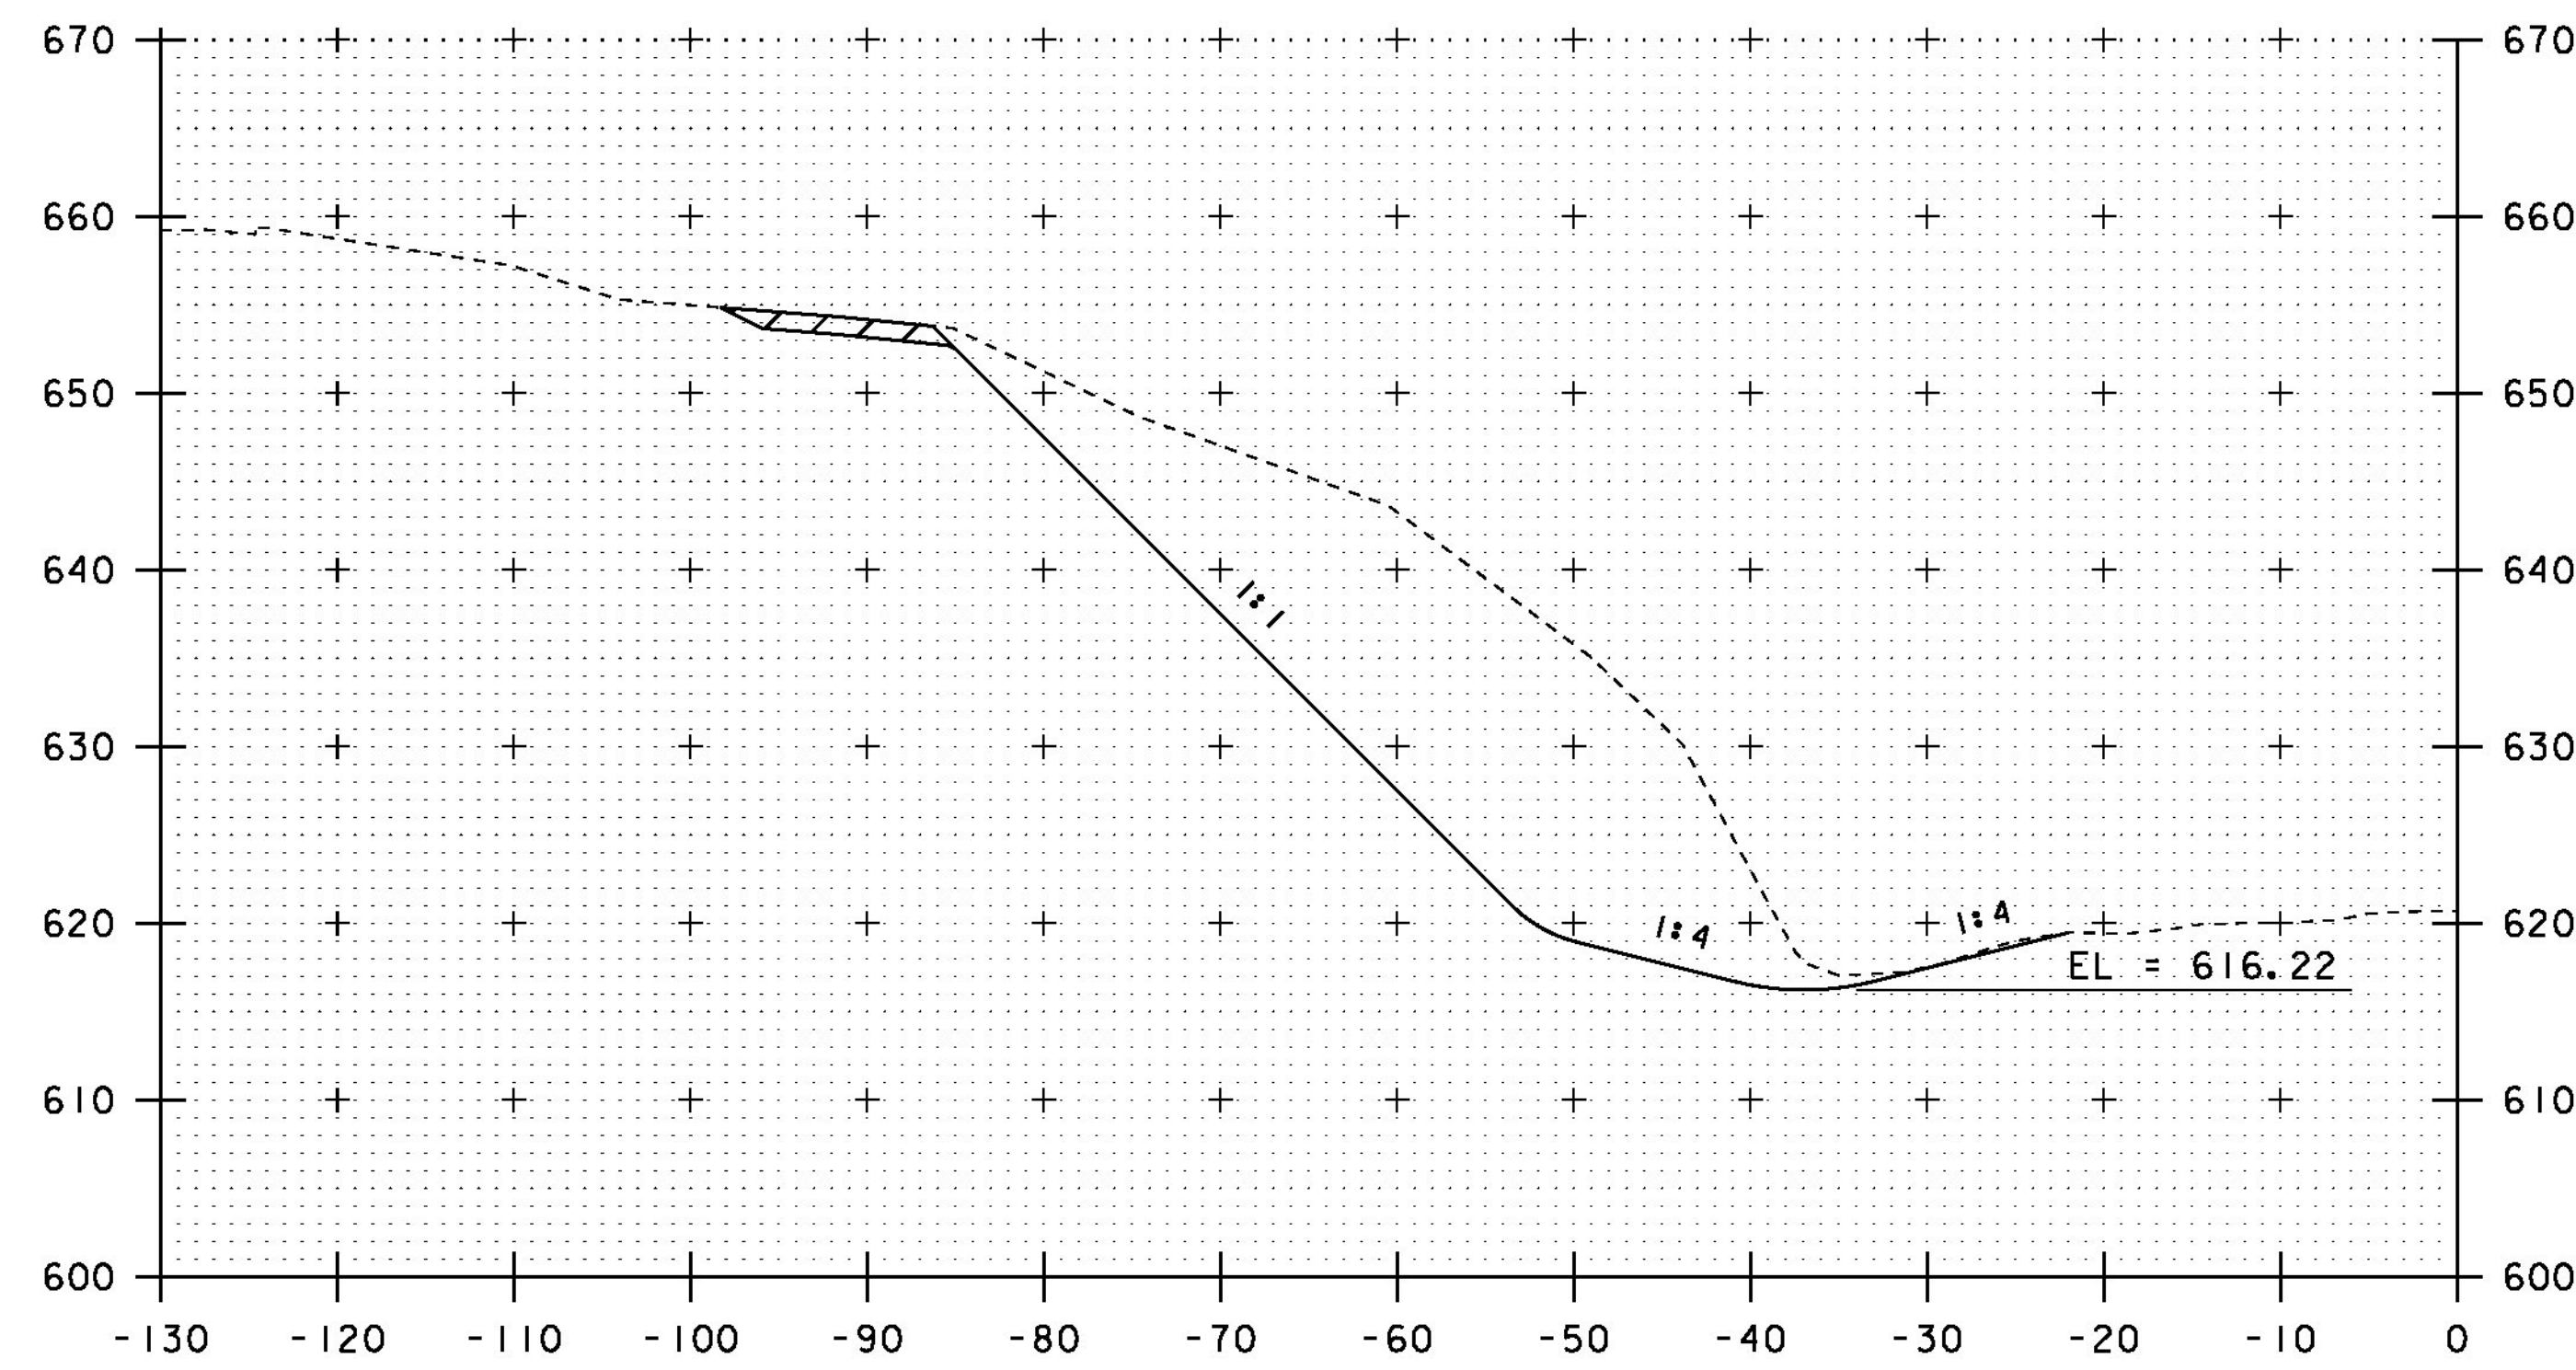

1983+50

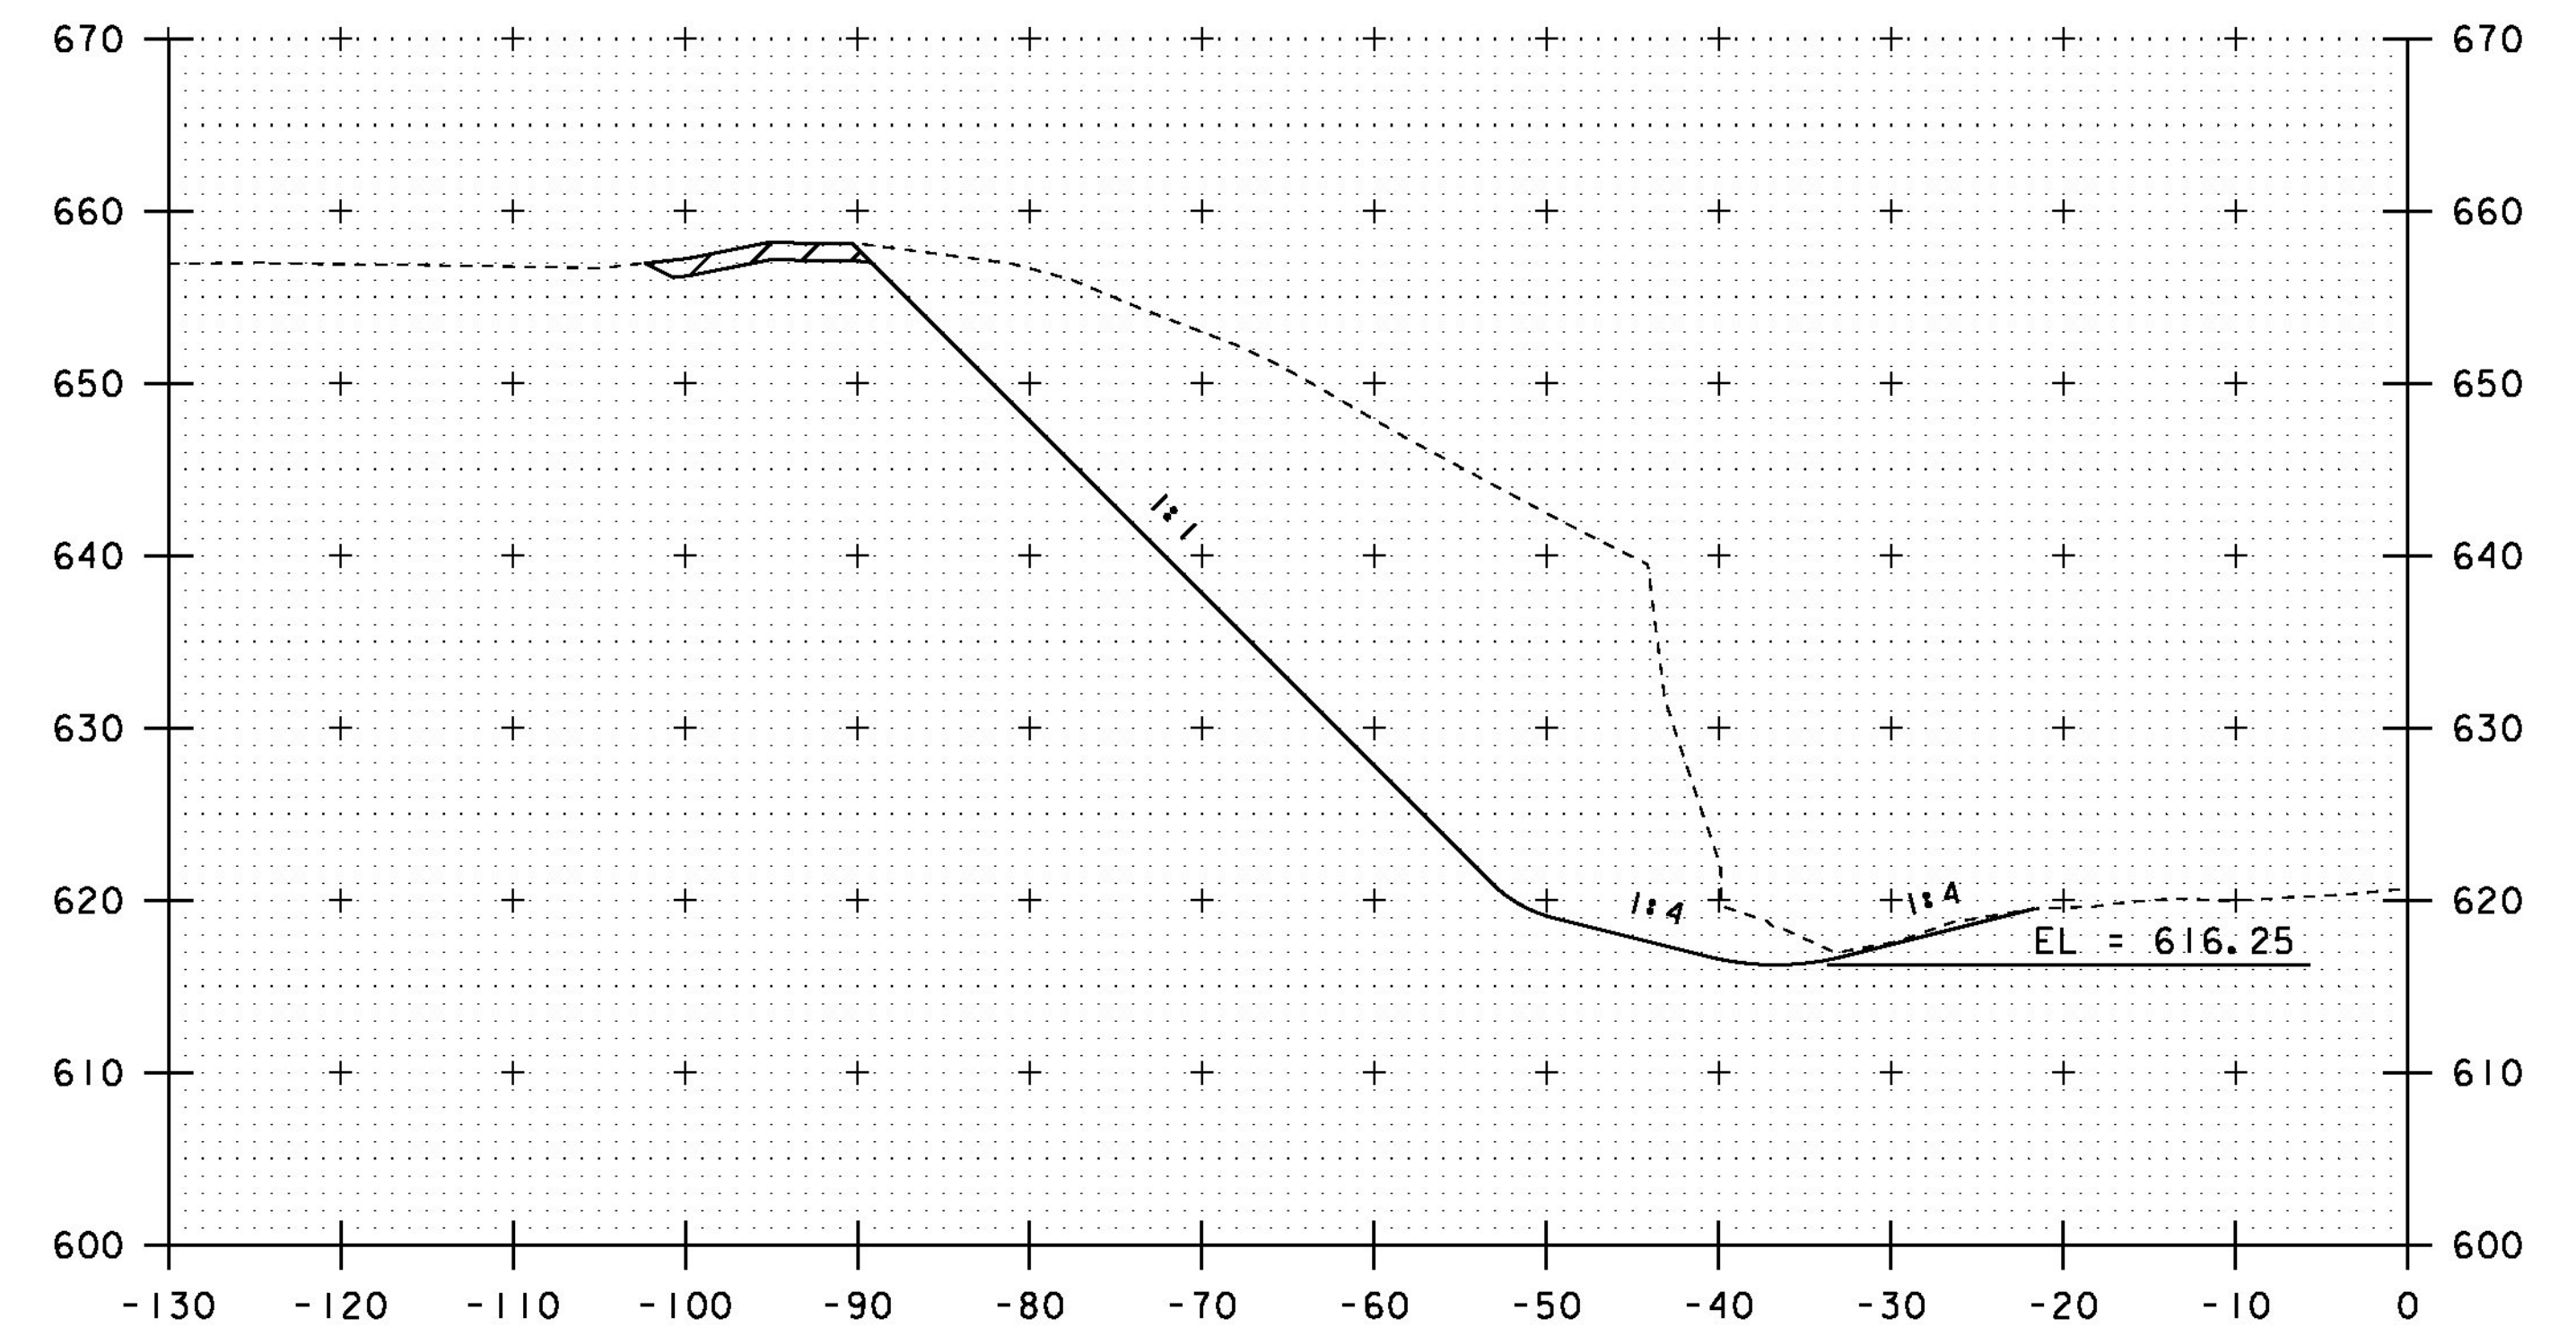

1984+00

STA. 1983+50 TO STA. 1984+25

PROJECT NAME: ROCKINGHAM	PLOT DATE: 29-JAN-2016
PROJECT NUMBER: IM 091-1(71)	DRAWN BY: A. KEMPTON
FILE NAME: d13a366xs.dgn	CHECKED BY: M. GAMELIN
PROJECT LEADER: B. MARTIN	SHEET 21 OF 35
DESIGNED BY: A. KEMPTON	
CROSS SECTION SHEET 2	