




1984+75

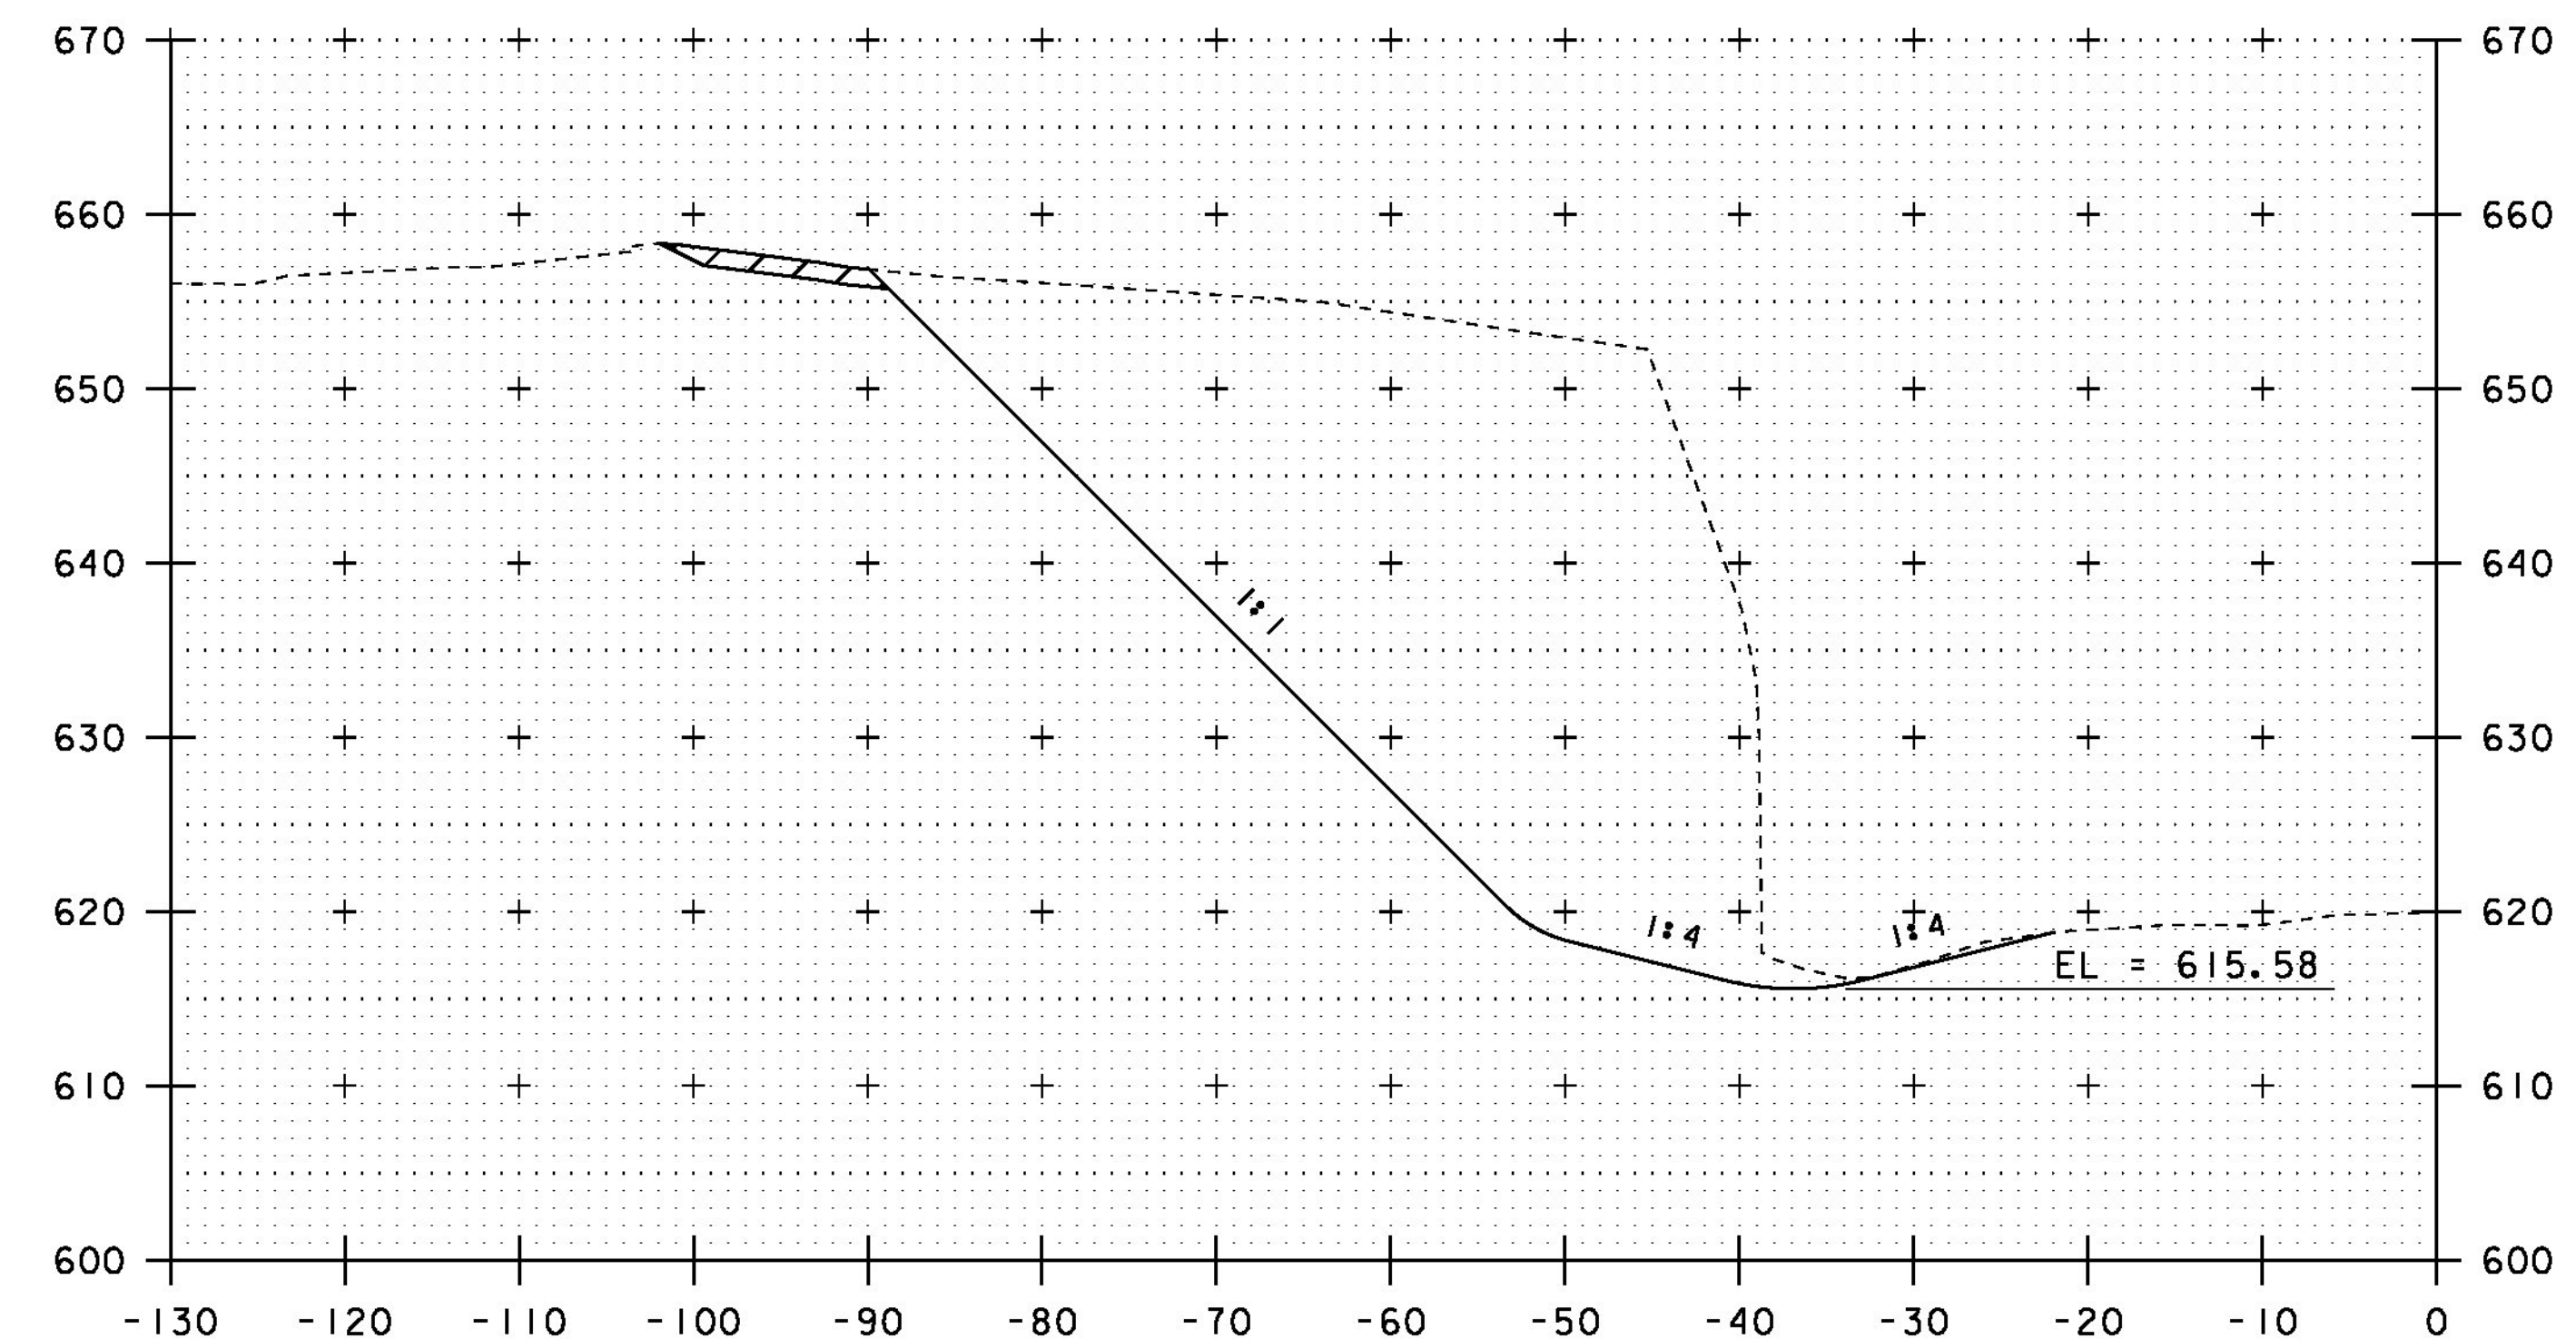

1985+25

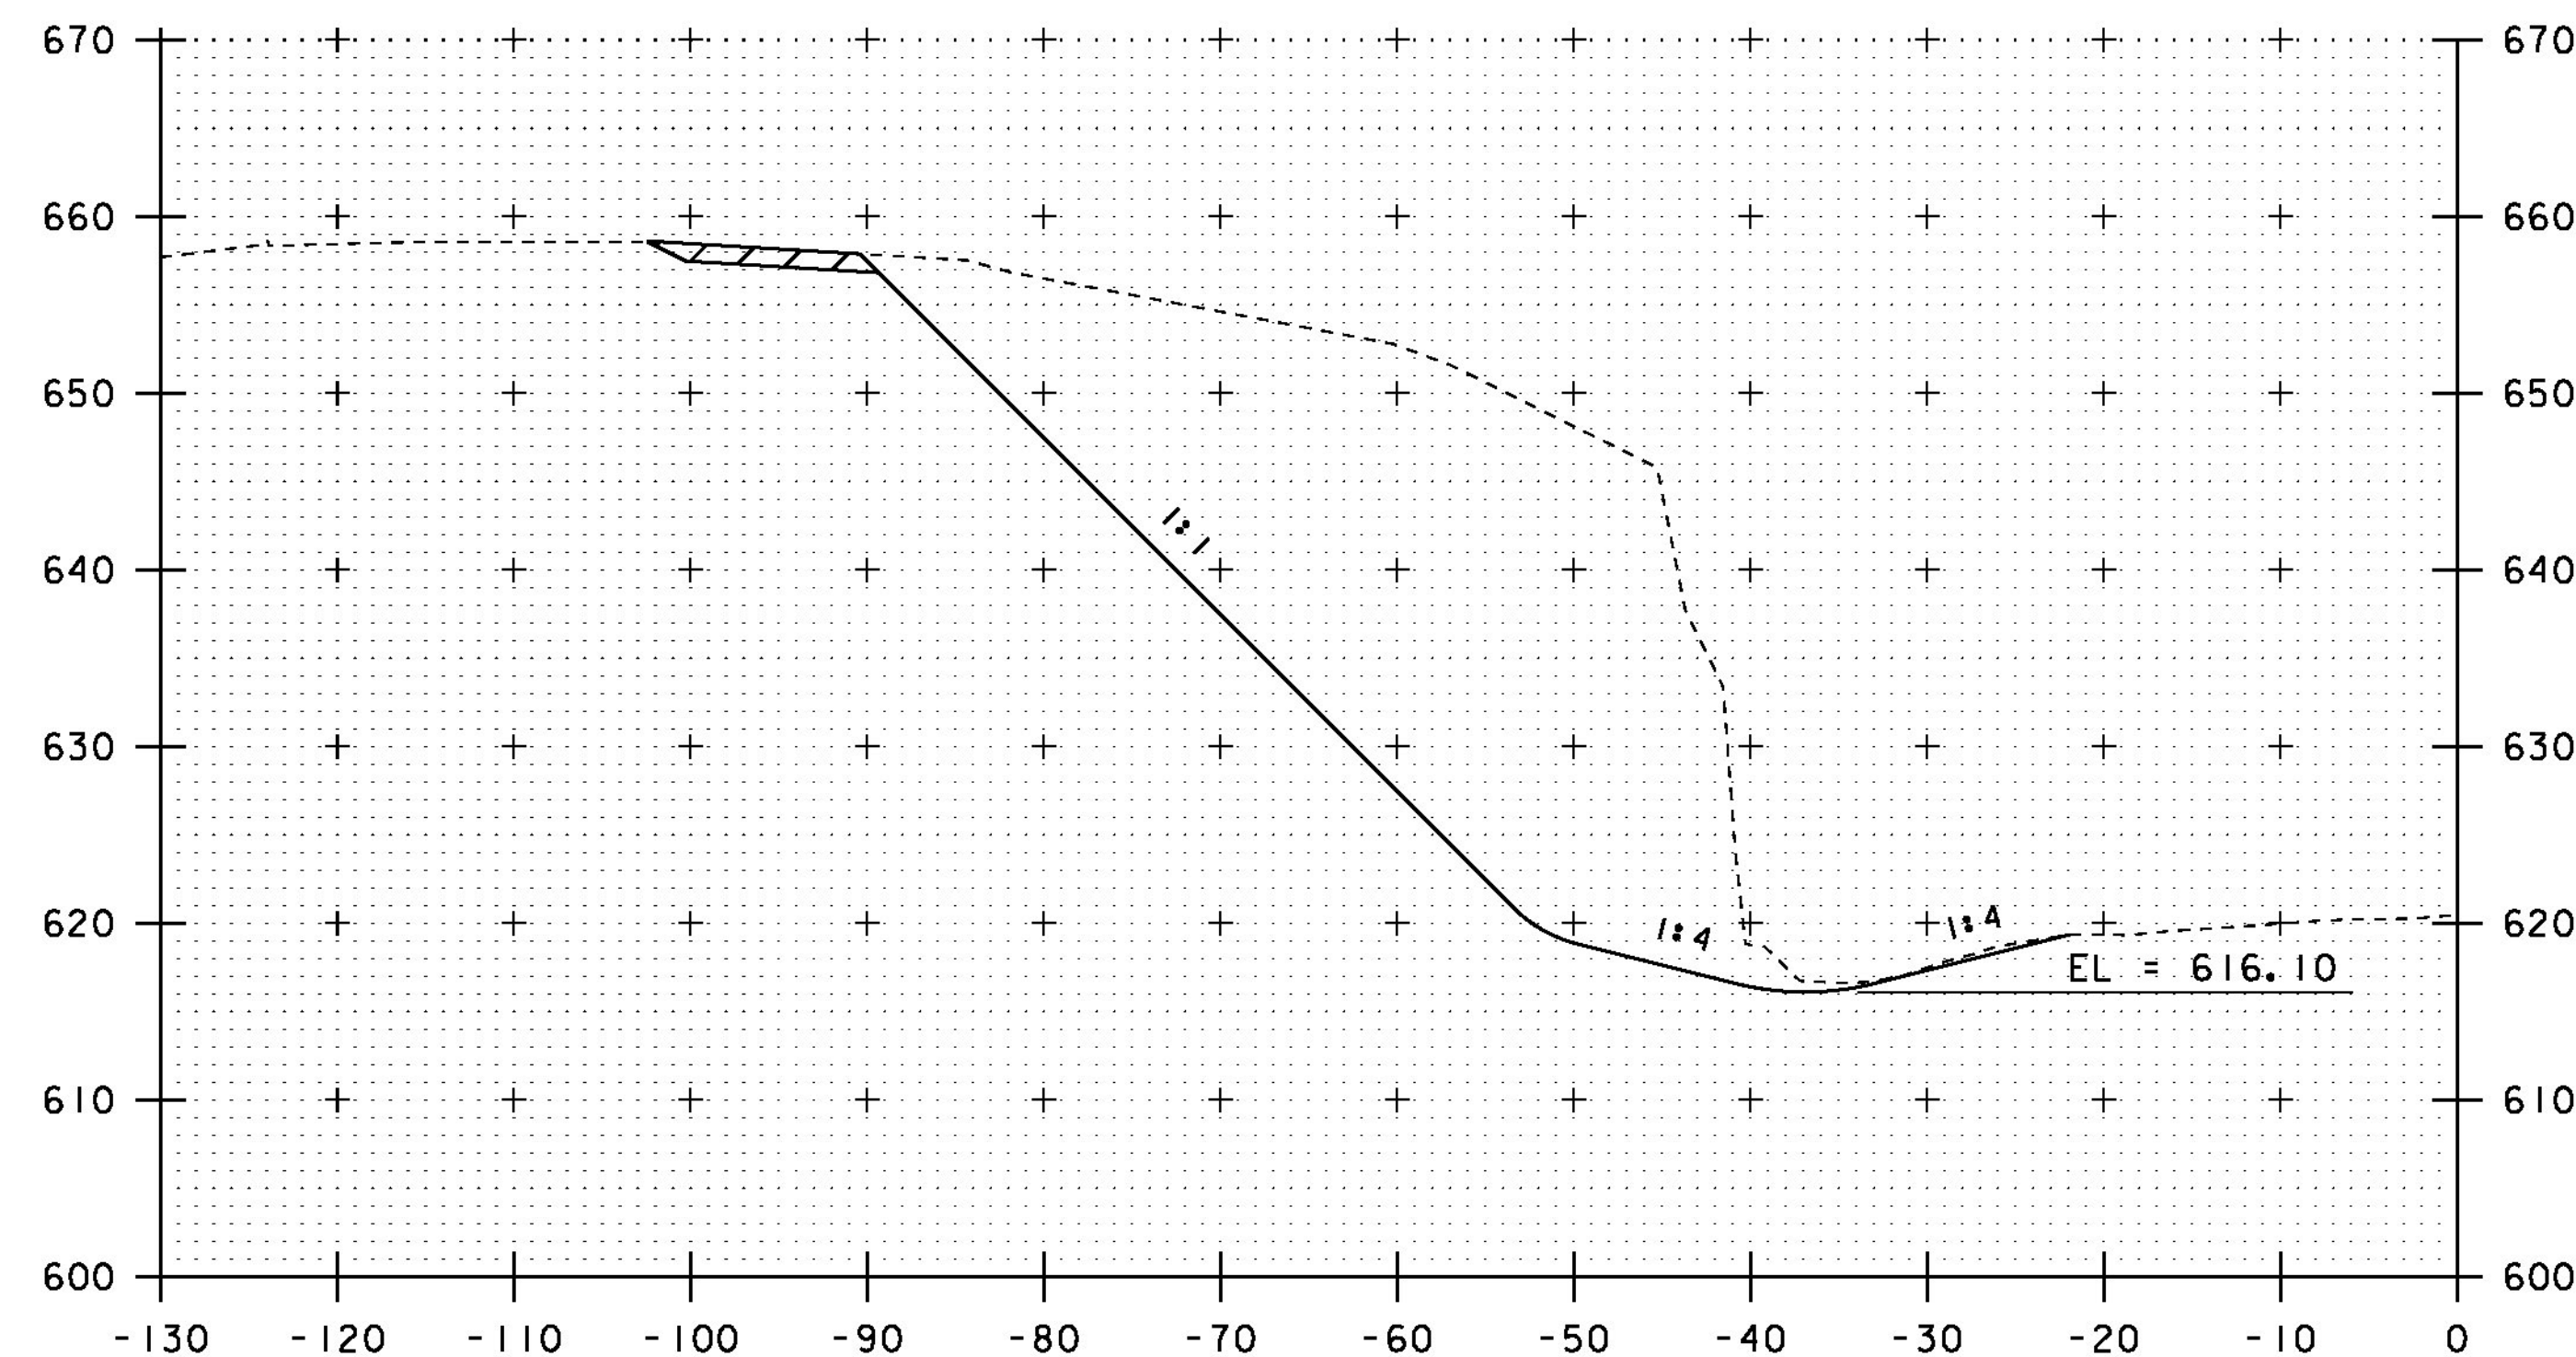

1984+50

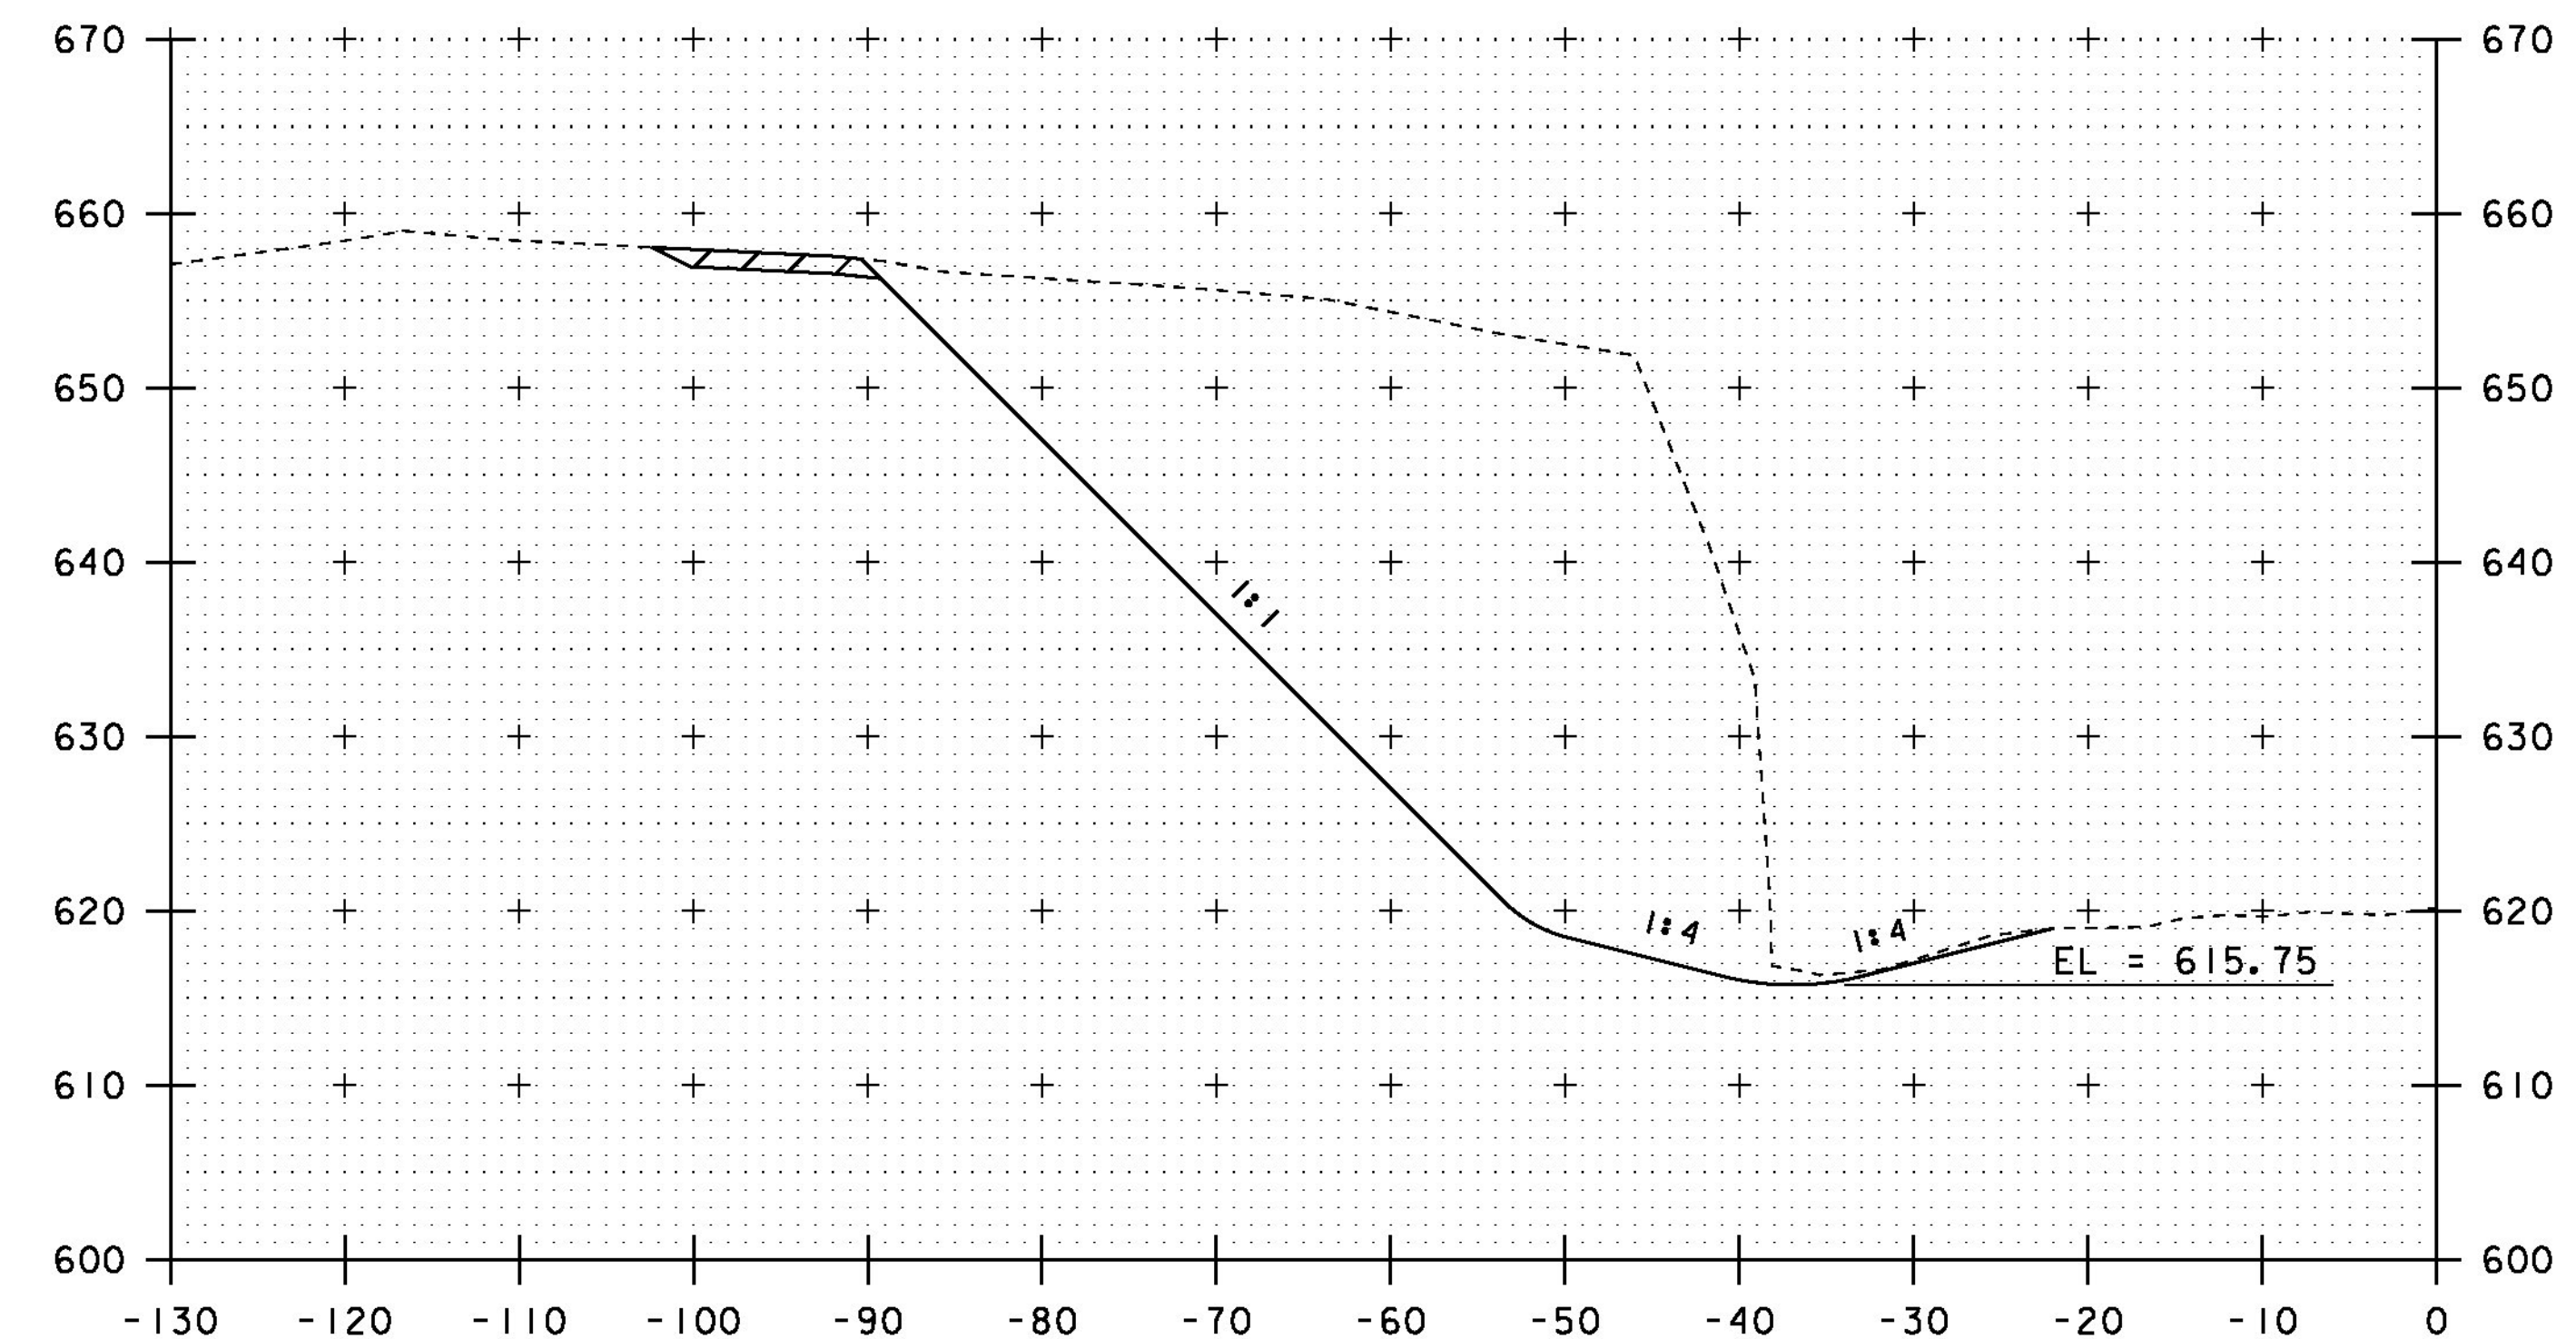

1985+00

STA. 1984+50 TO STA. 1985+25

PROJECT NAME: ROCKINGHAM	PLOT DATE: 29-JAN-2016
PROJECT NUMBER: IM 091-1(71)	DRAWN BY: A. KEMPTON
FILE NAME: d13a366xs.dgn	CHECKED BY: M. GAMELIN
PROJECT LEADER: B. MARTIN	SHEET 22 OF 35
DESIGNED BY: A. KEMPTON	
CROSS SECTION SHEET 3	