




1985+75

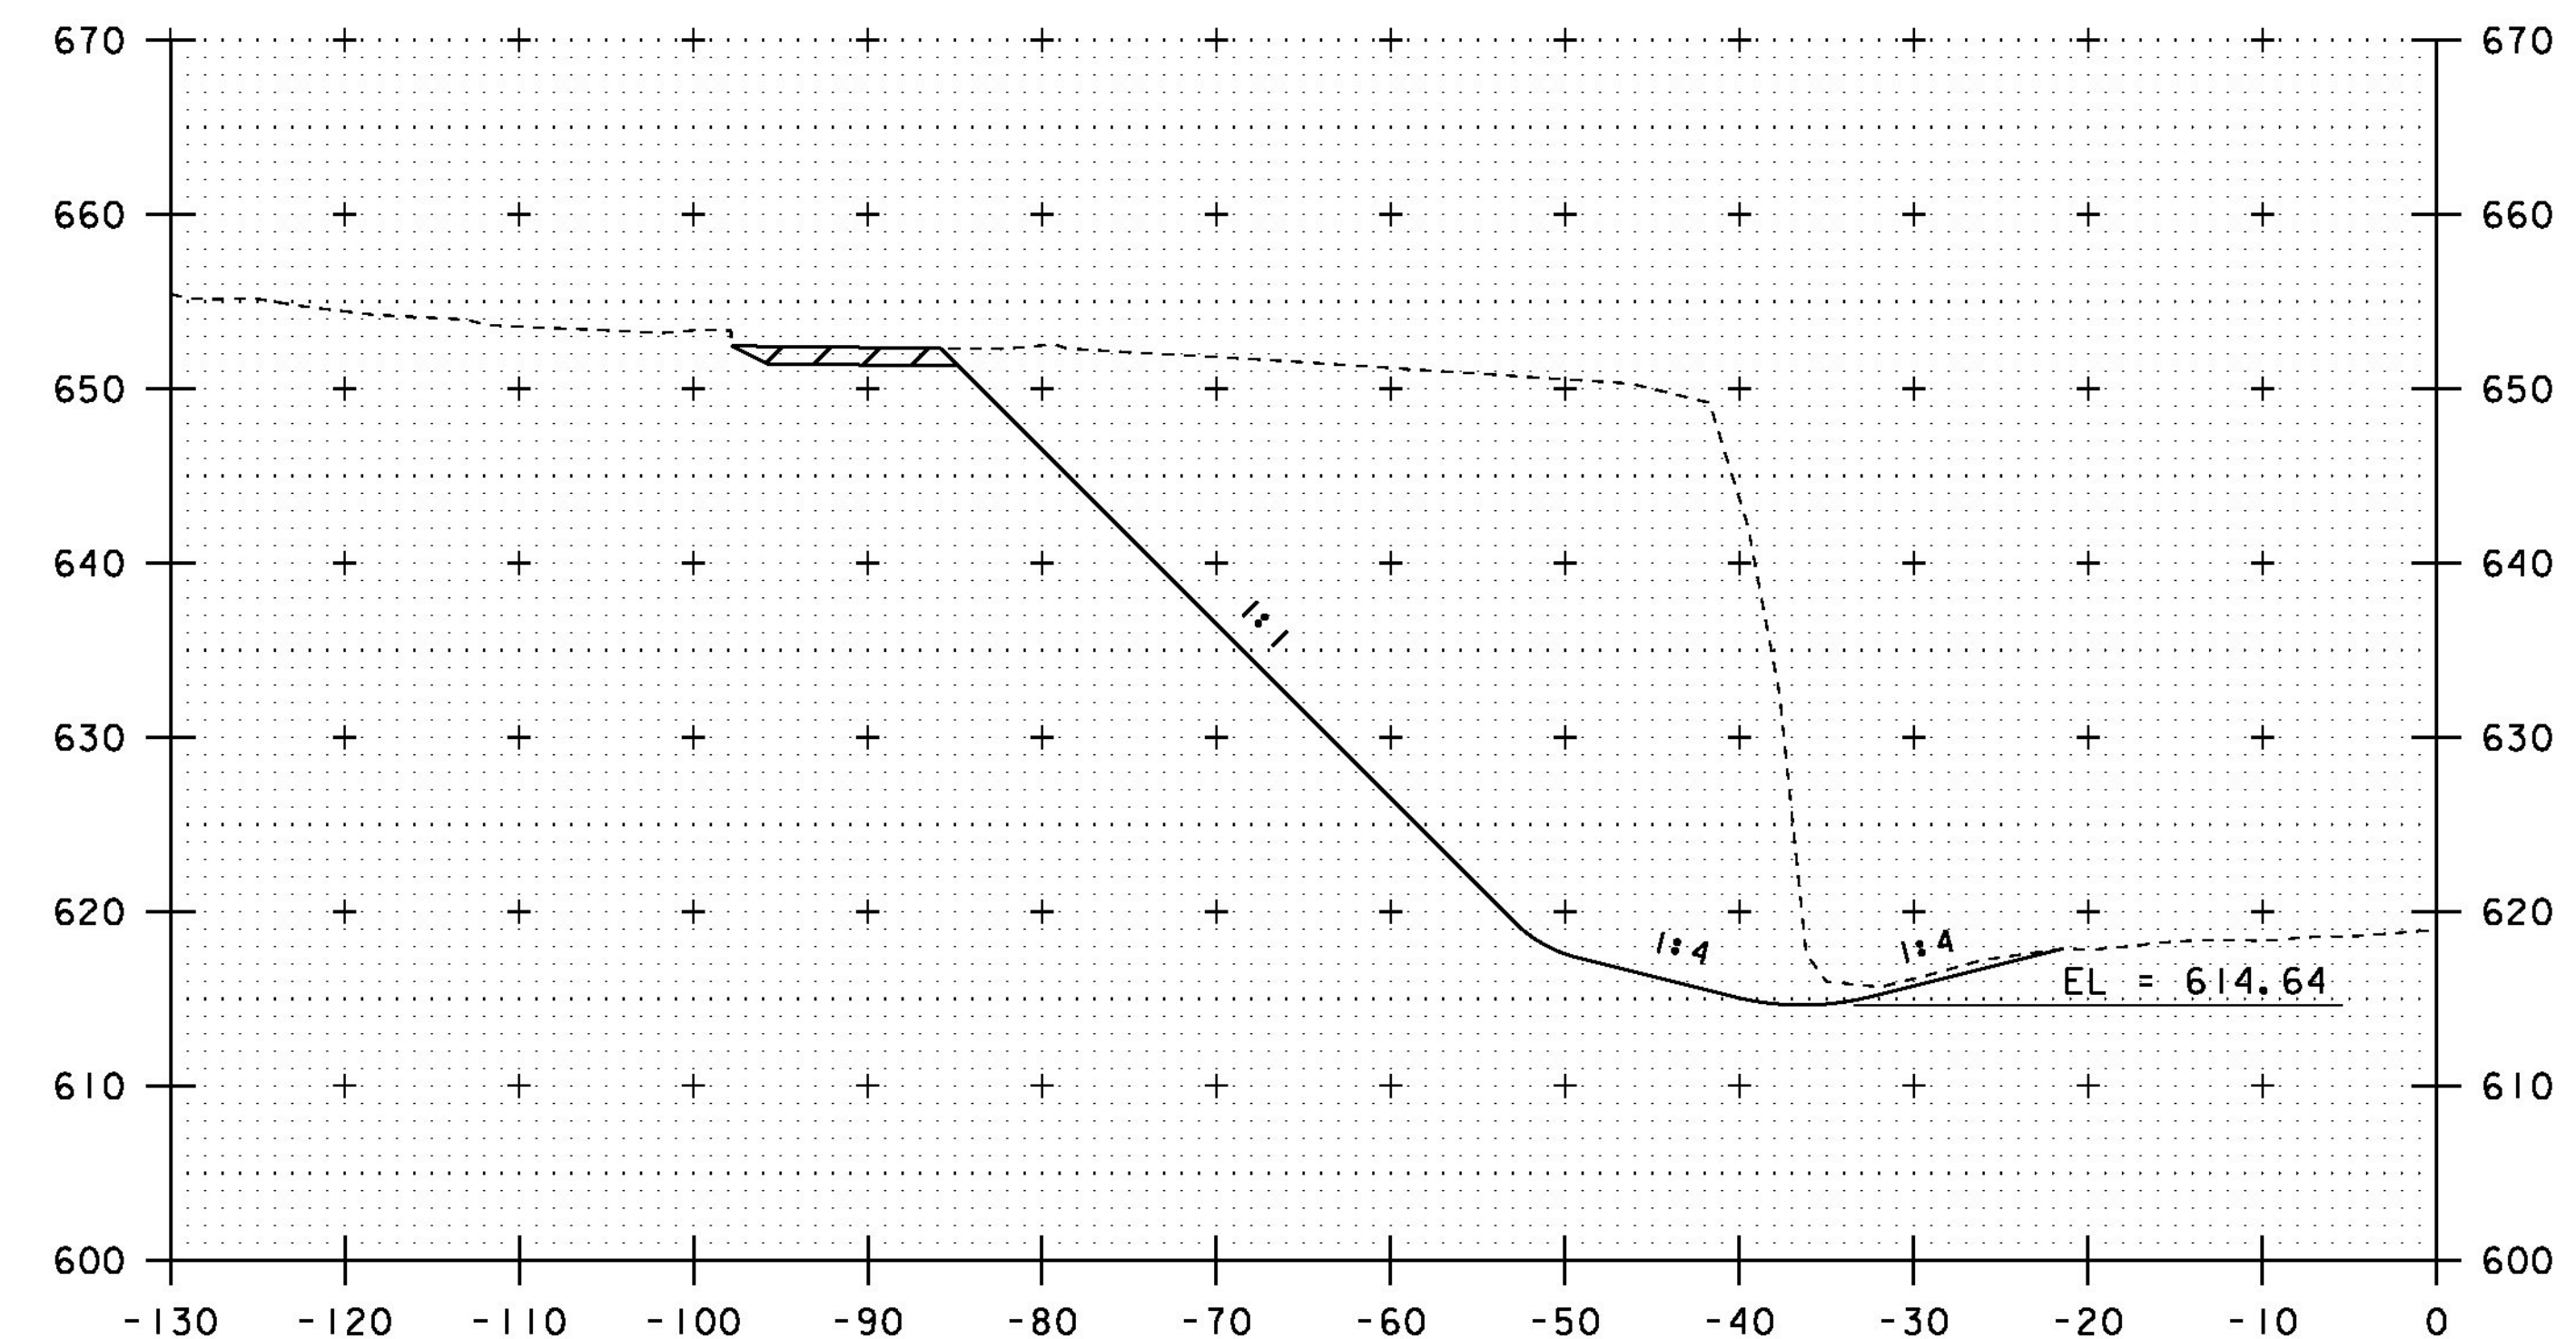

1986+25

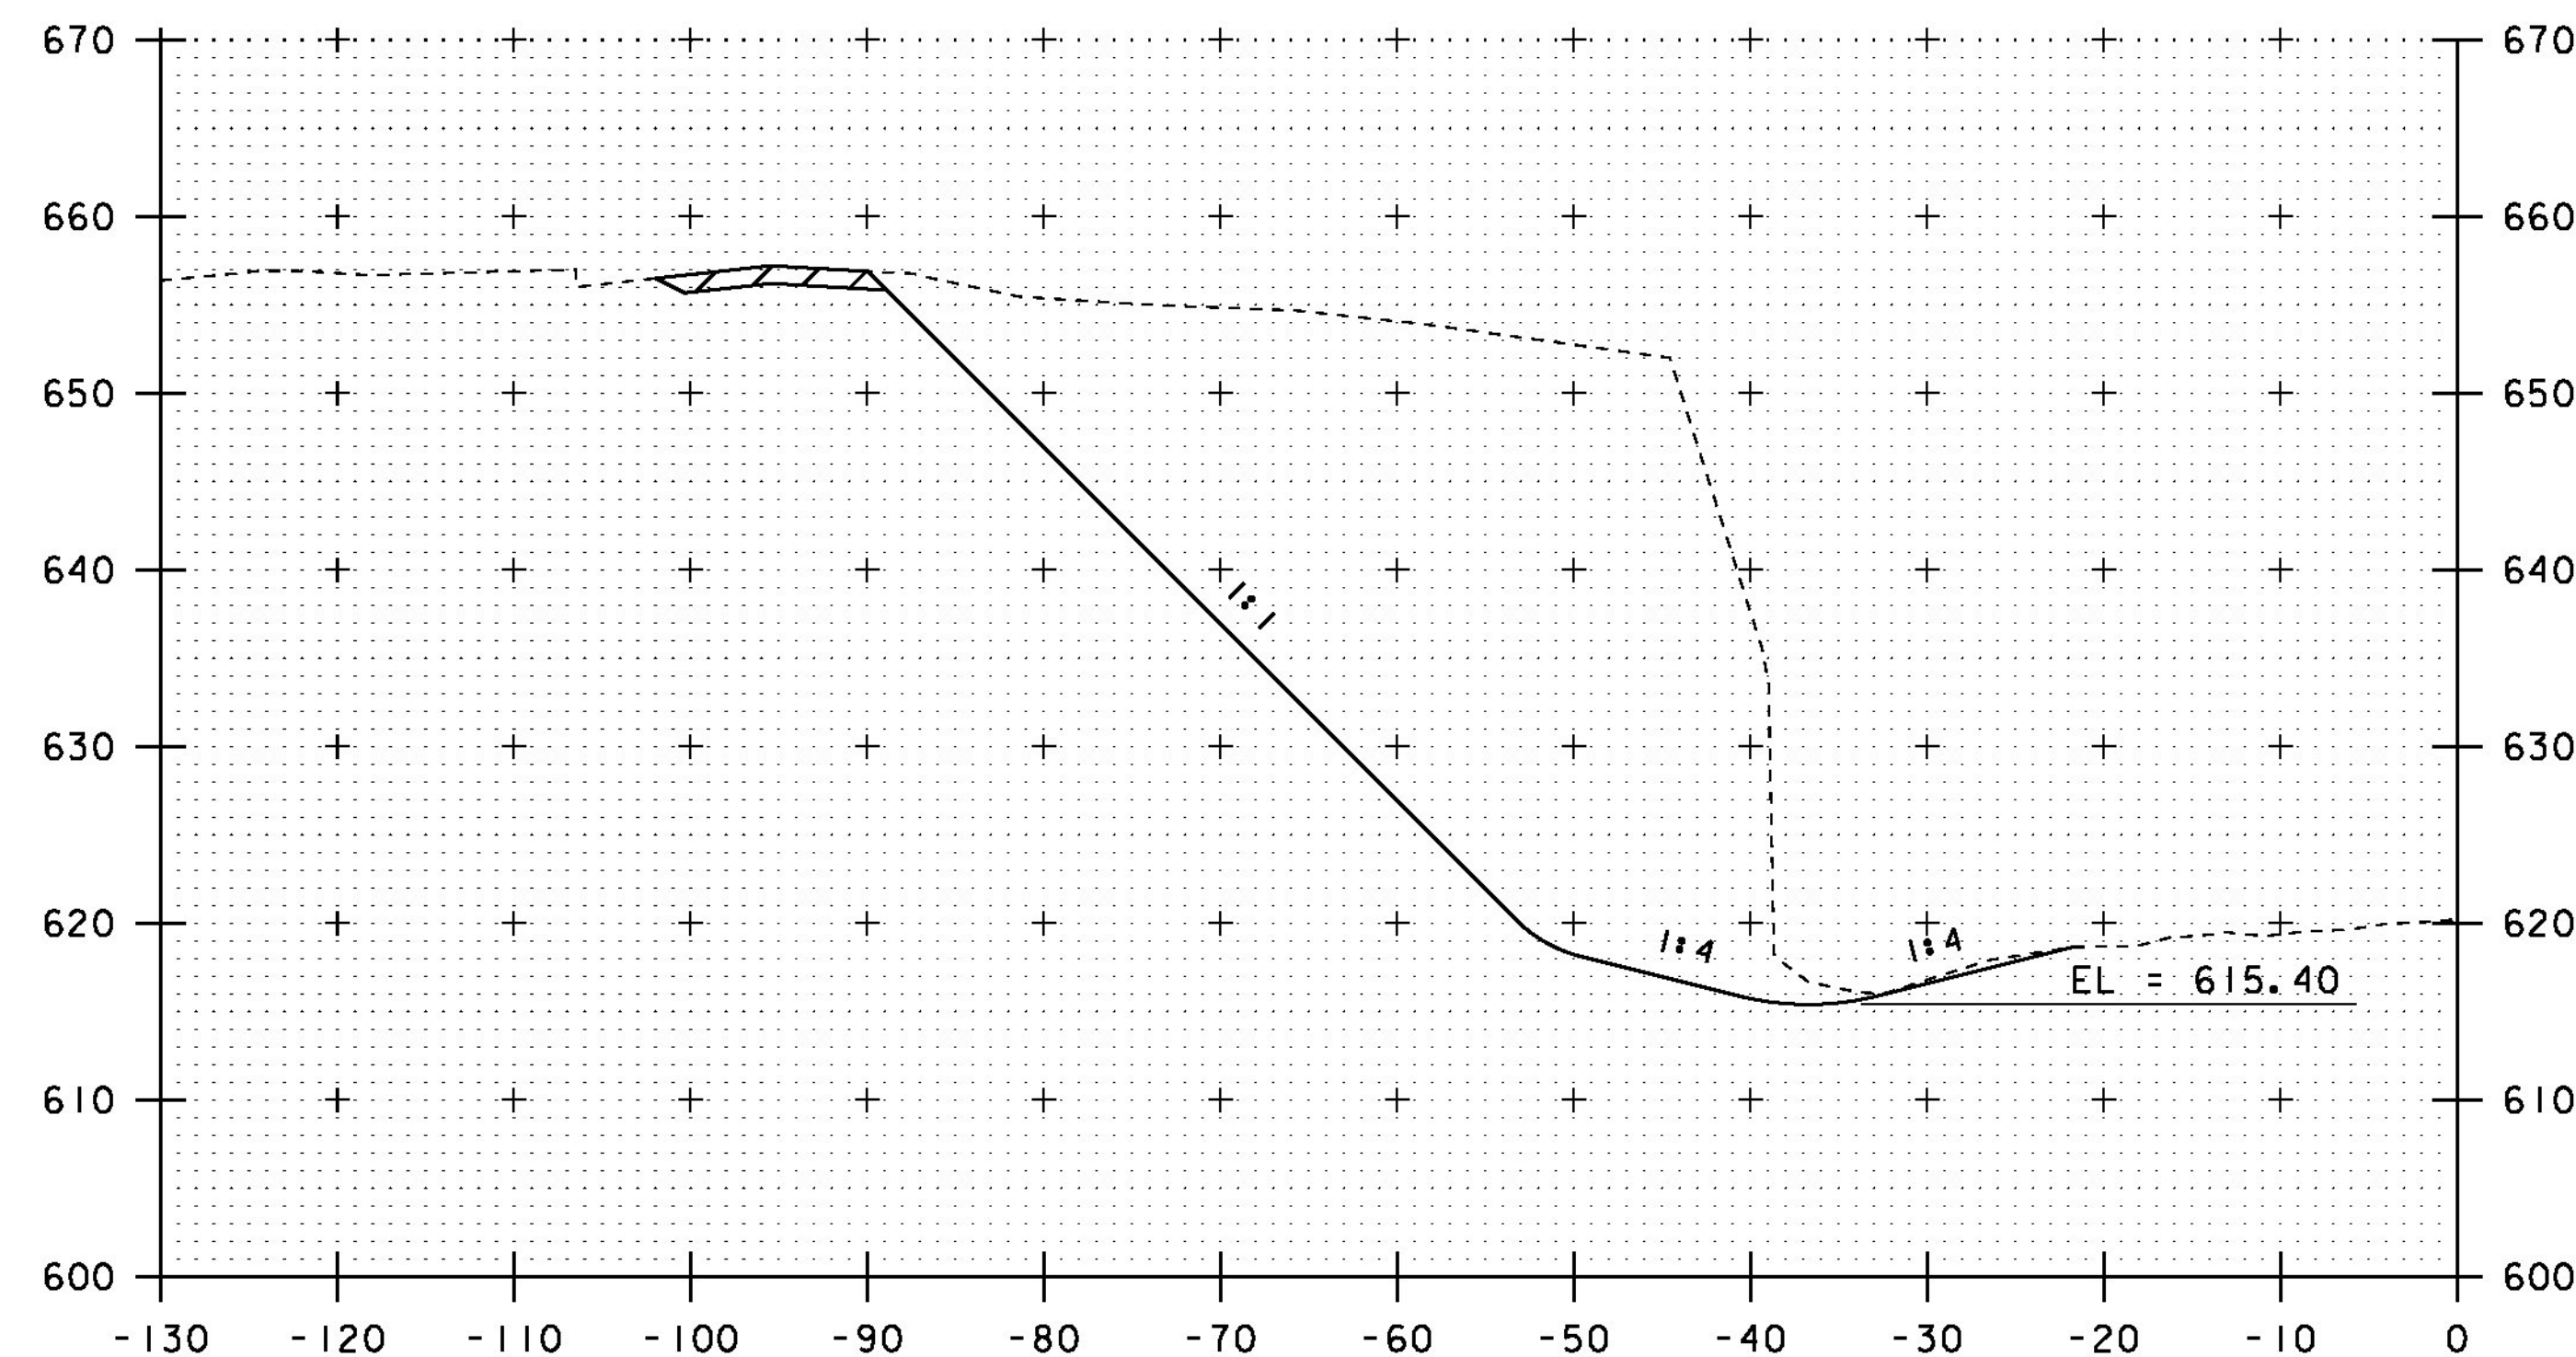

1985+50

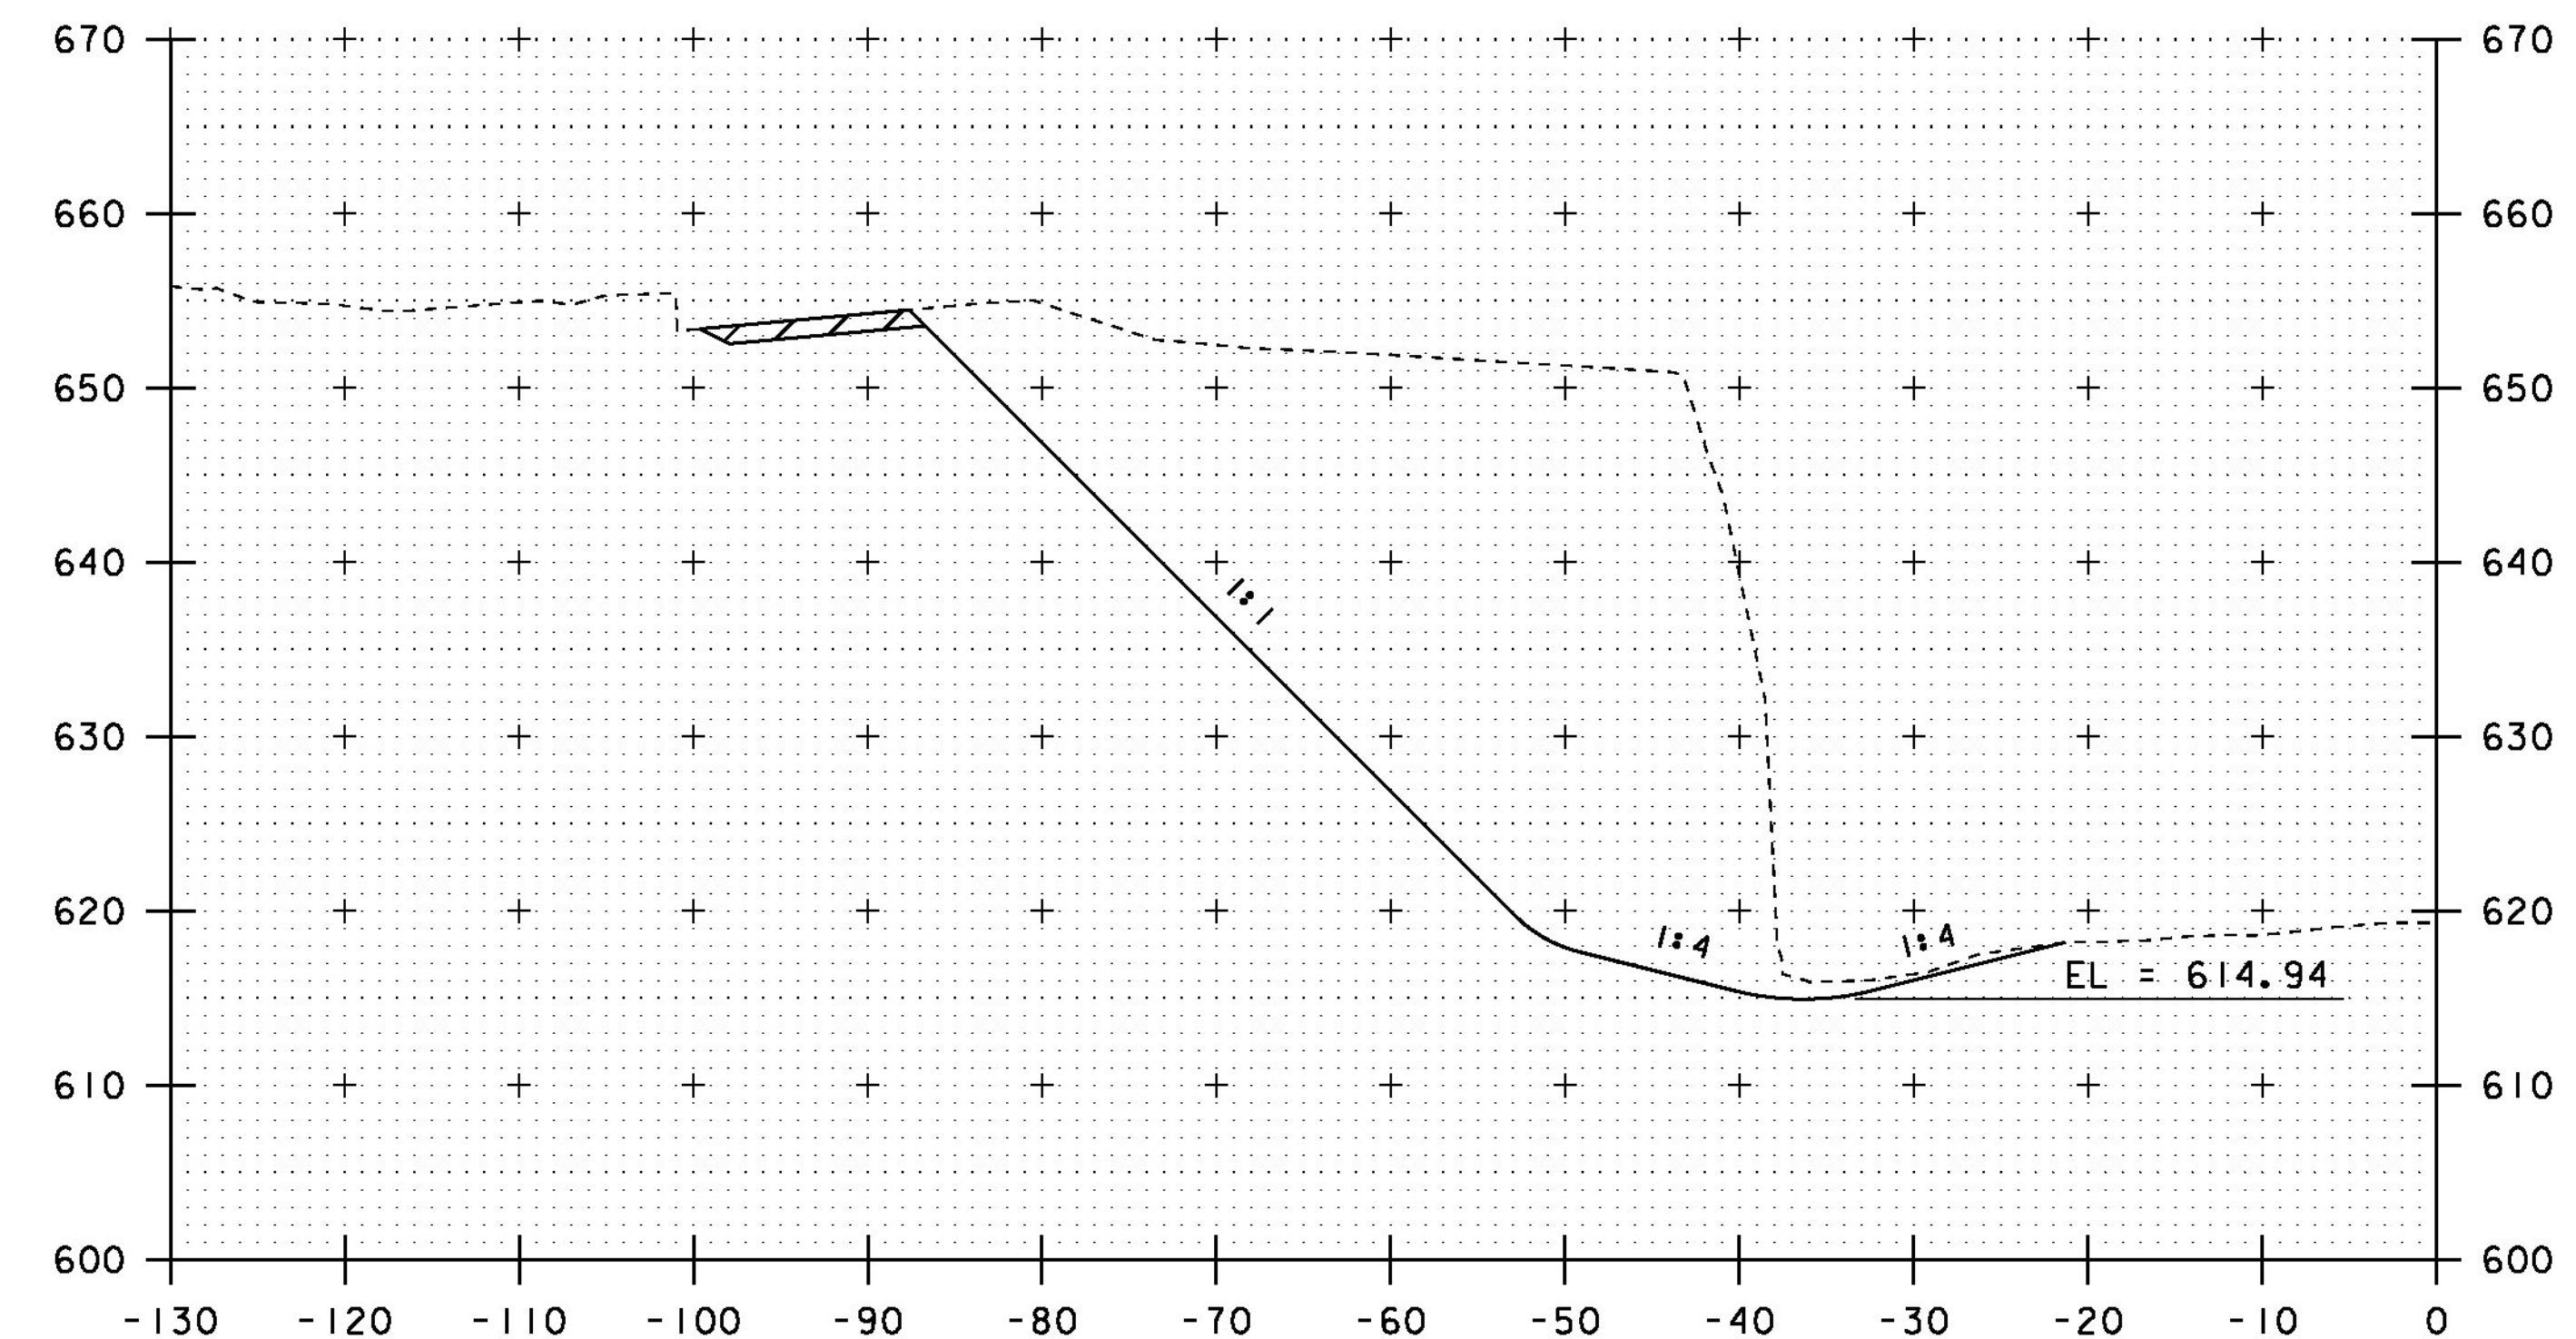

1986+00

STA. 1985+50 TO STA. 1986+25

PROJECT NAME: ROCKINGHAM	PLOT DATE: 29-JAN-2016
PROJECT NUMBER: IM 091-1(71)	DRAWN BY: A. KEMPTON
FILE NAME: d13a366xs.dgn	CHECKED BY: M. GAMELIN
DESIGNED BY: A. KEMPTON	SHEET 23 OF 35
CROSS SECTION SHEET 4	