




1987+59

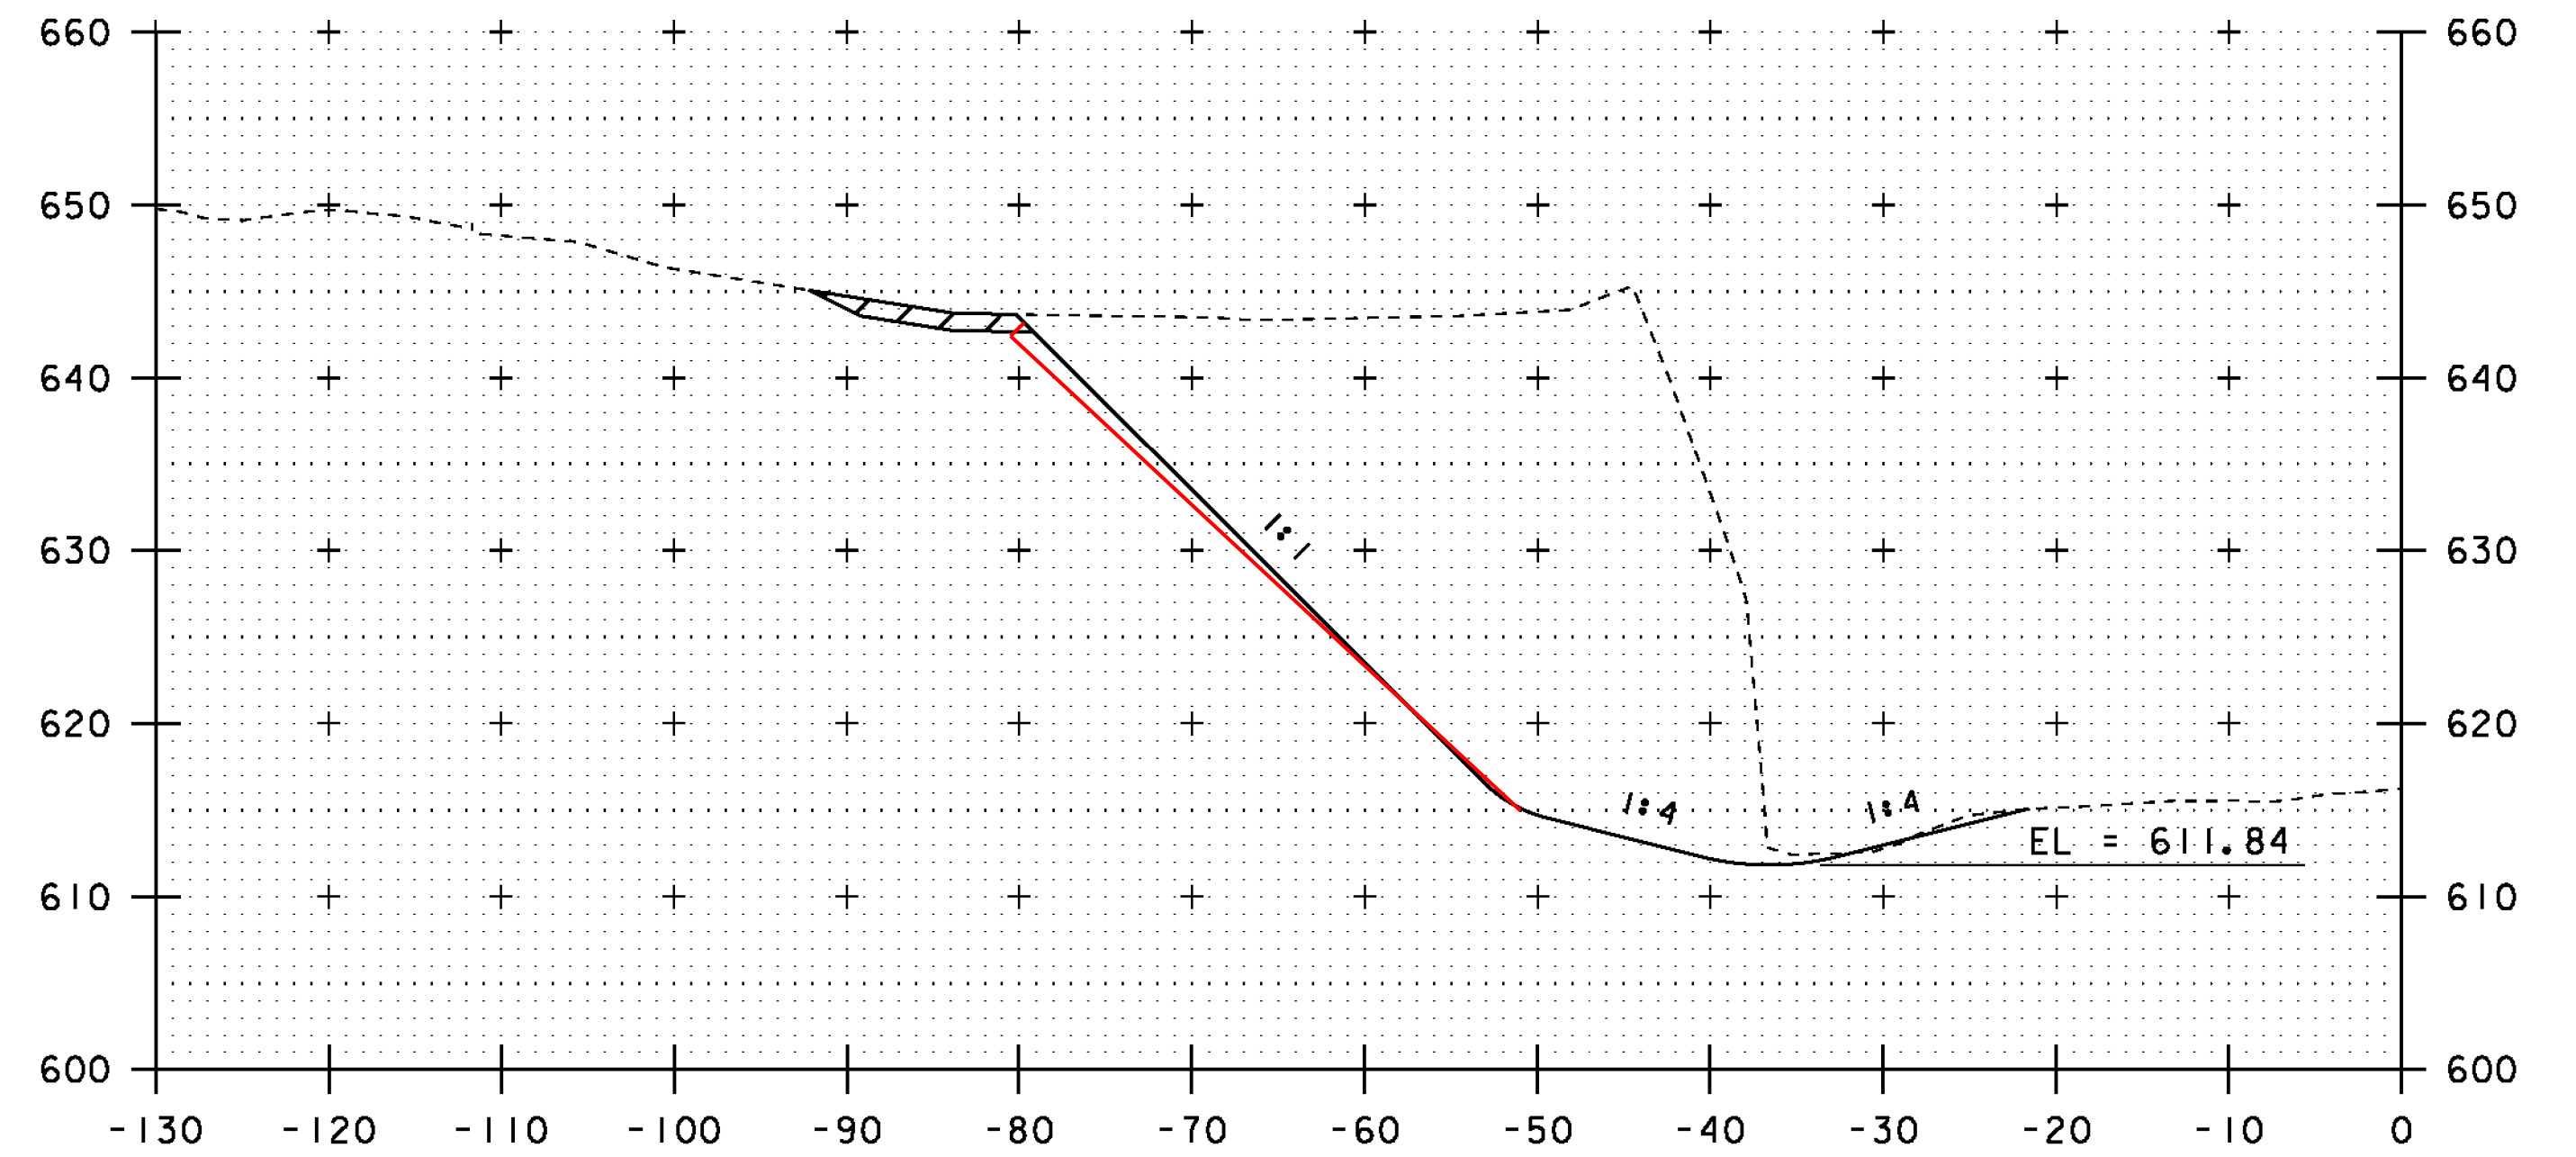

1988+00

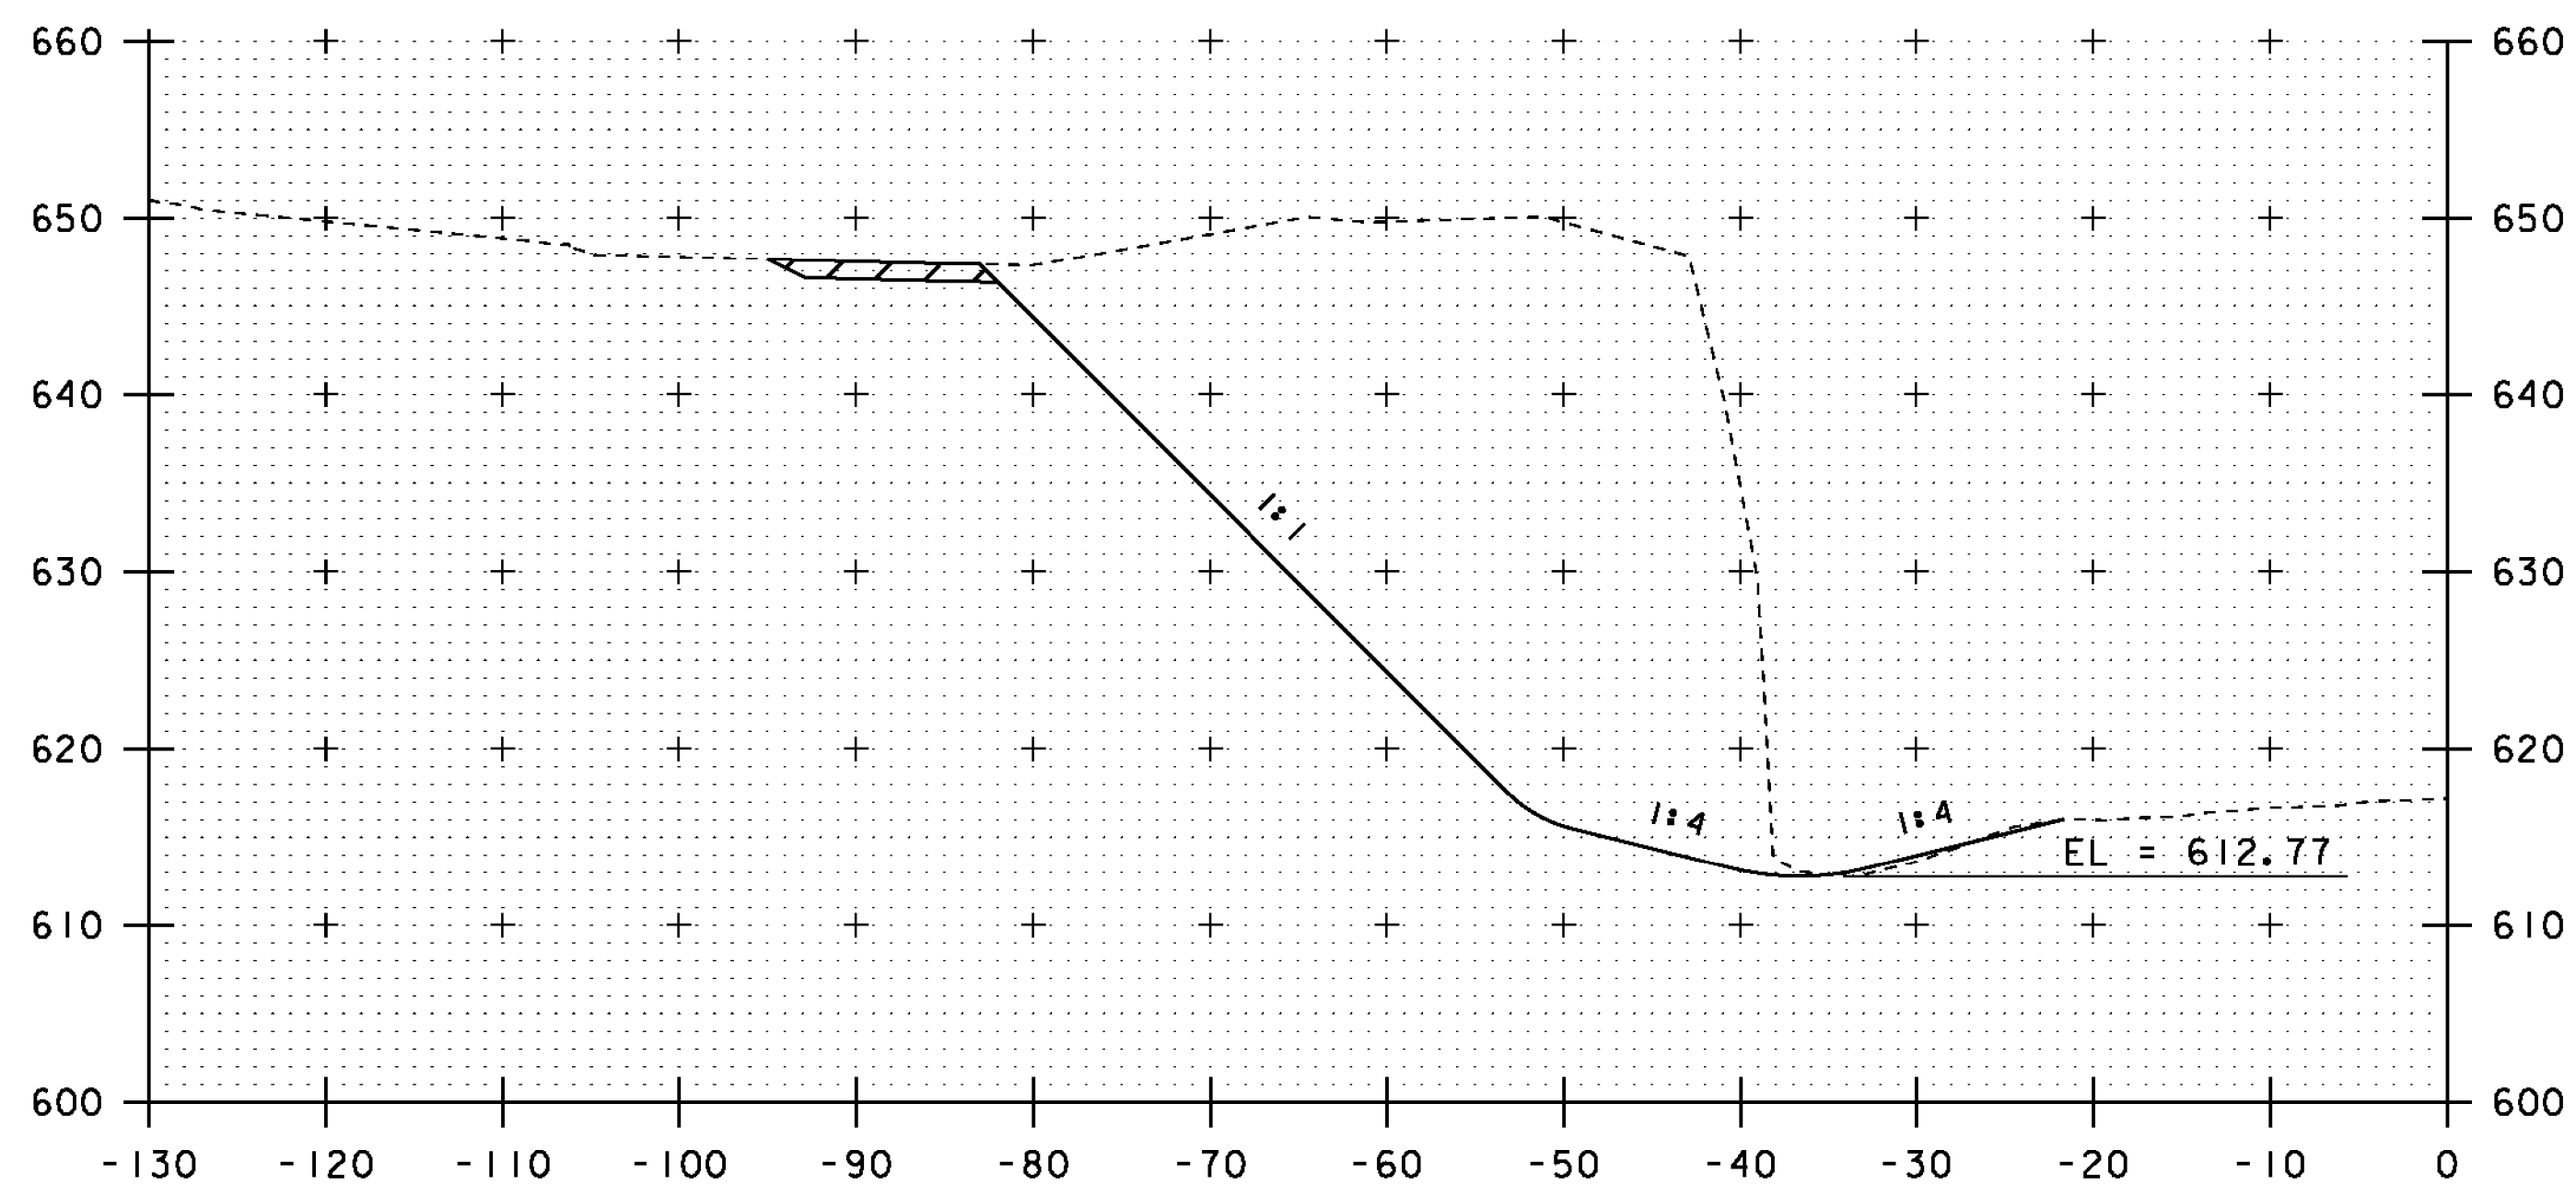

1987+50

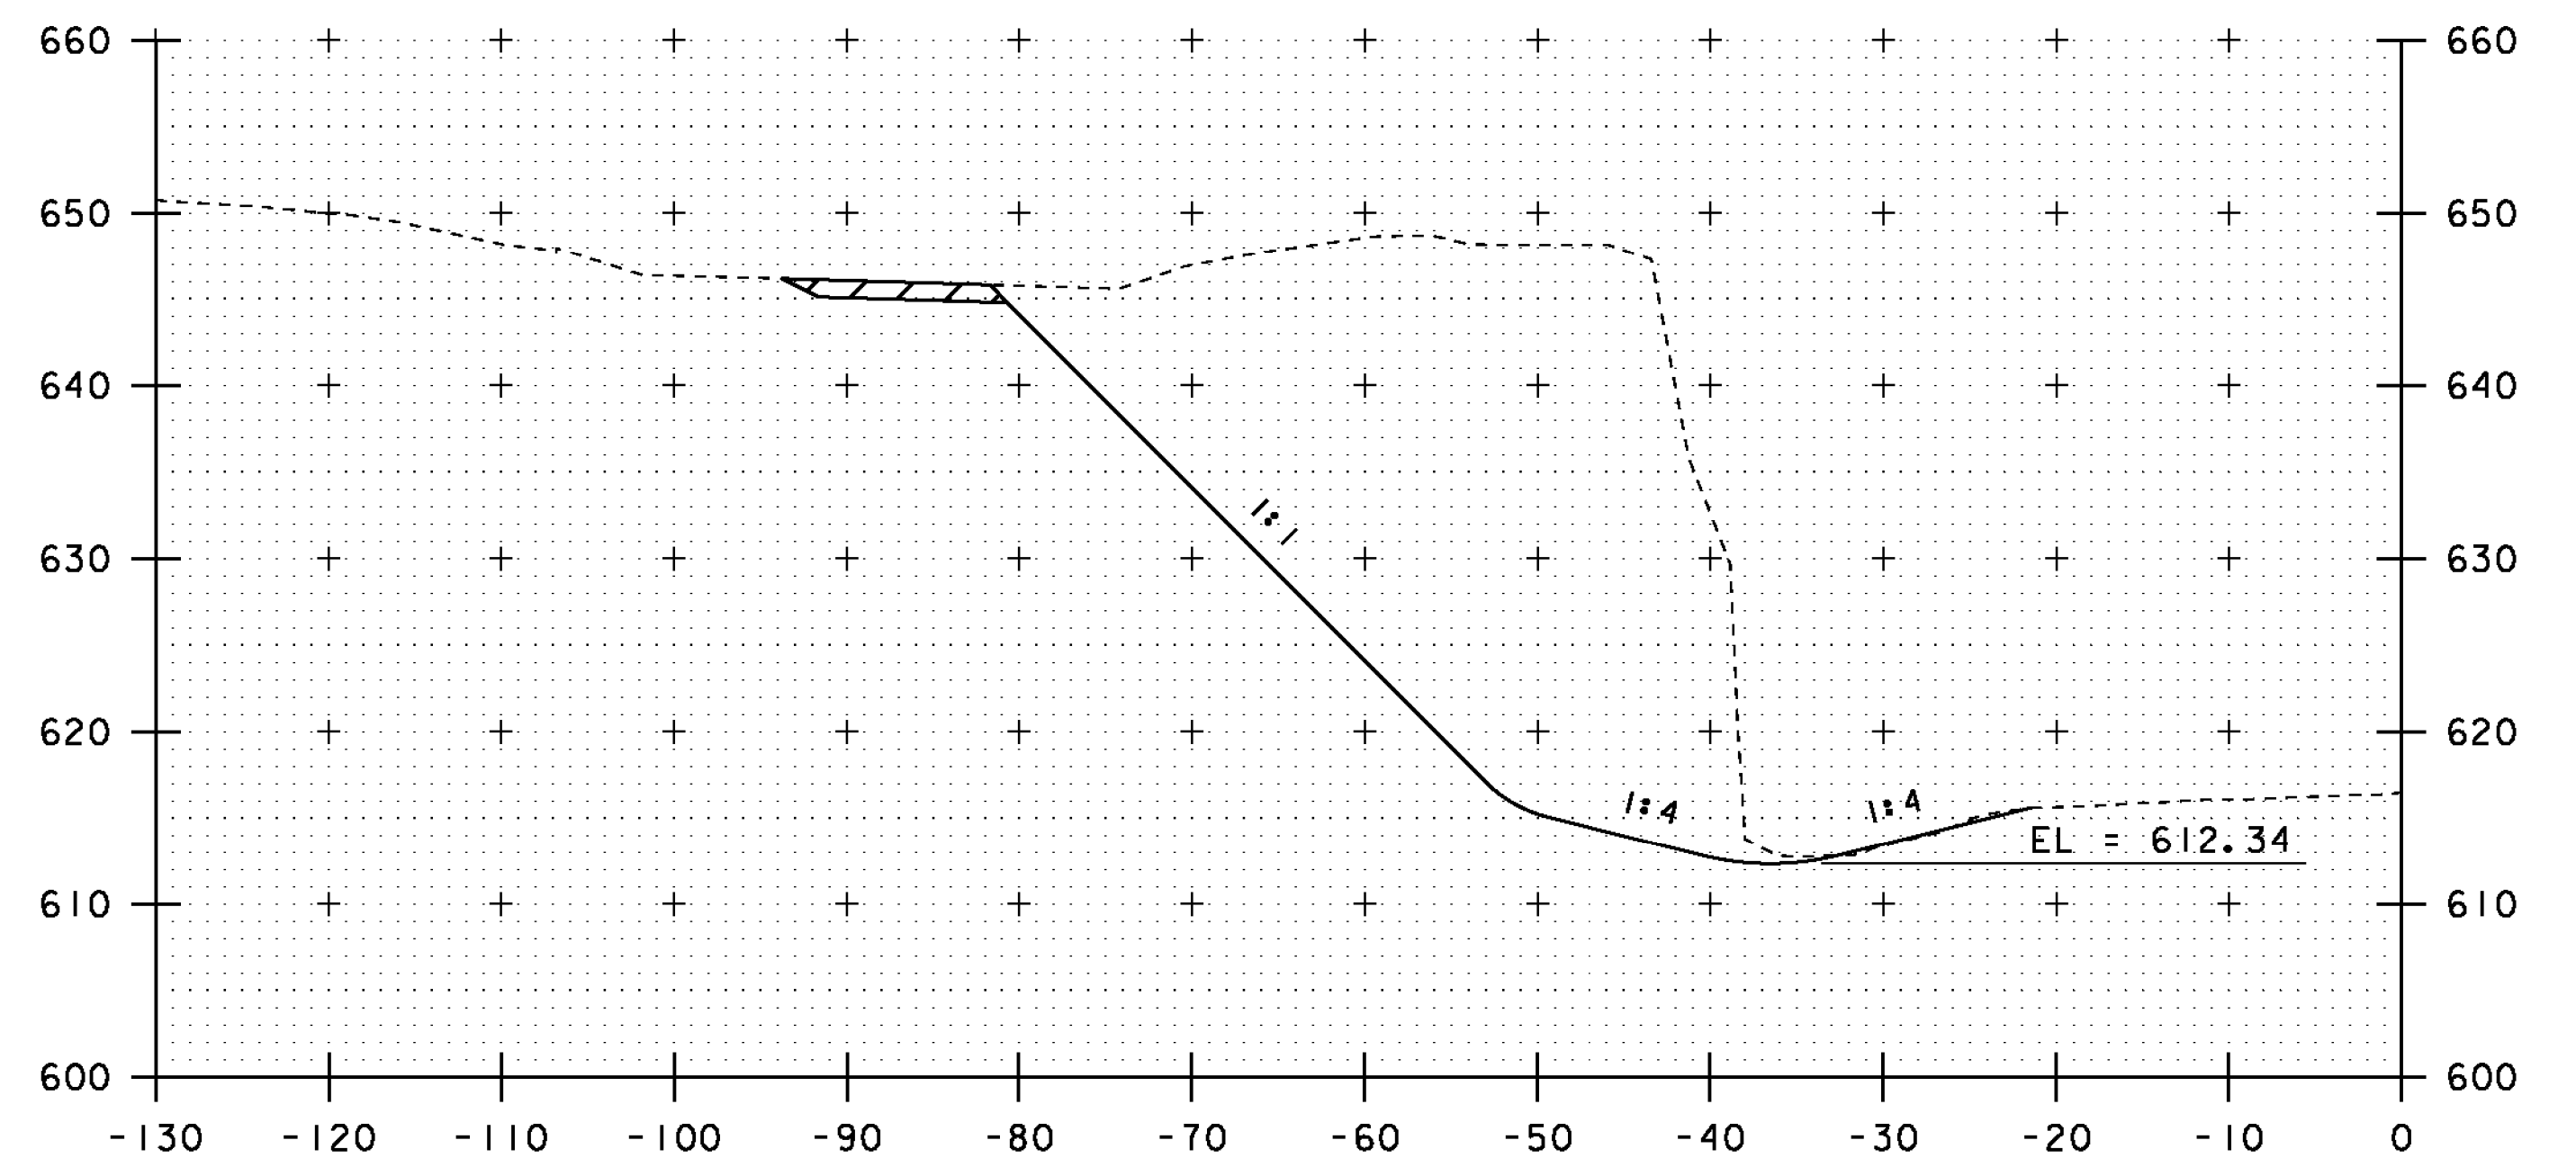

1987+75

STA. 1987+50 TO STA. 1988+00

PROJECT NAME: ROCKINGHAM	PLOT DATE: 29-JAN-2016
PROJECT NUMBER: IM 091-(7)	DRAWN BY: A. KEMPTON
FILE NAME: d13a366xs.dgn	CHECKED BY: M. GAMELIN
PROJECT LEADER: B. MARTIN	SHEET 25 OF 35
DESIGNED BY: A. KEMPTON	
CROSS SECTION SHEET 6	