




1988+50

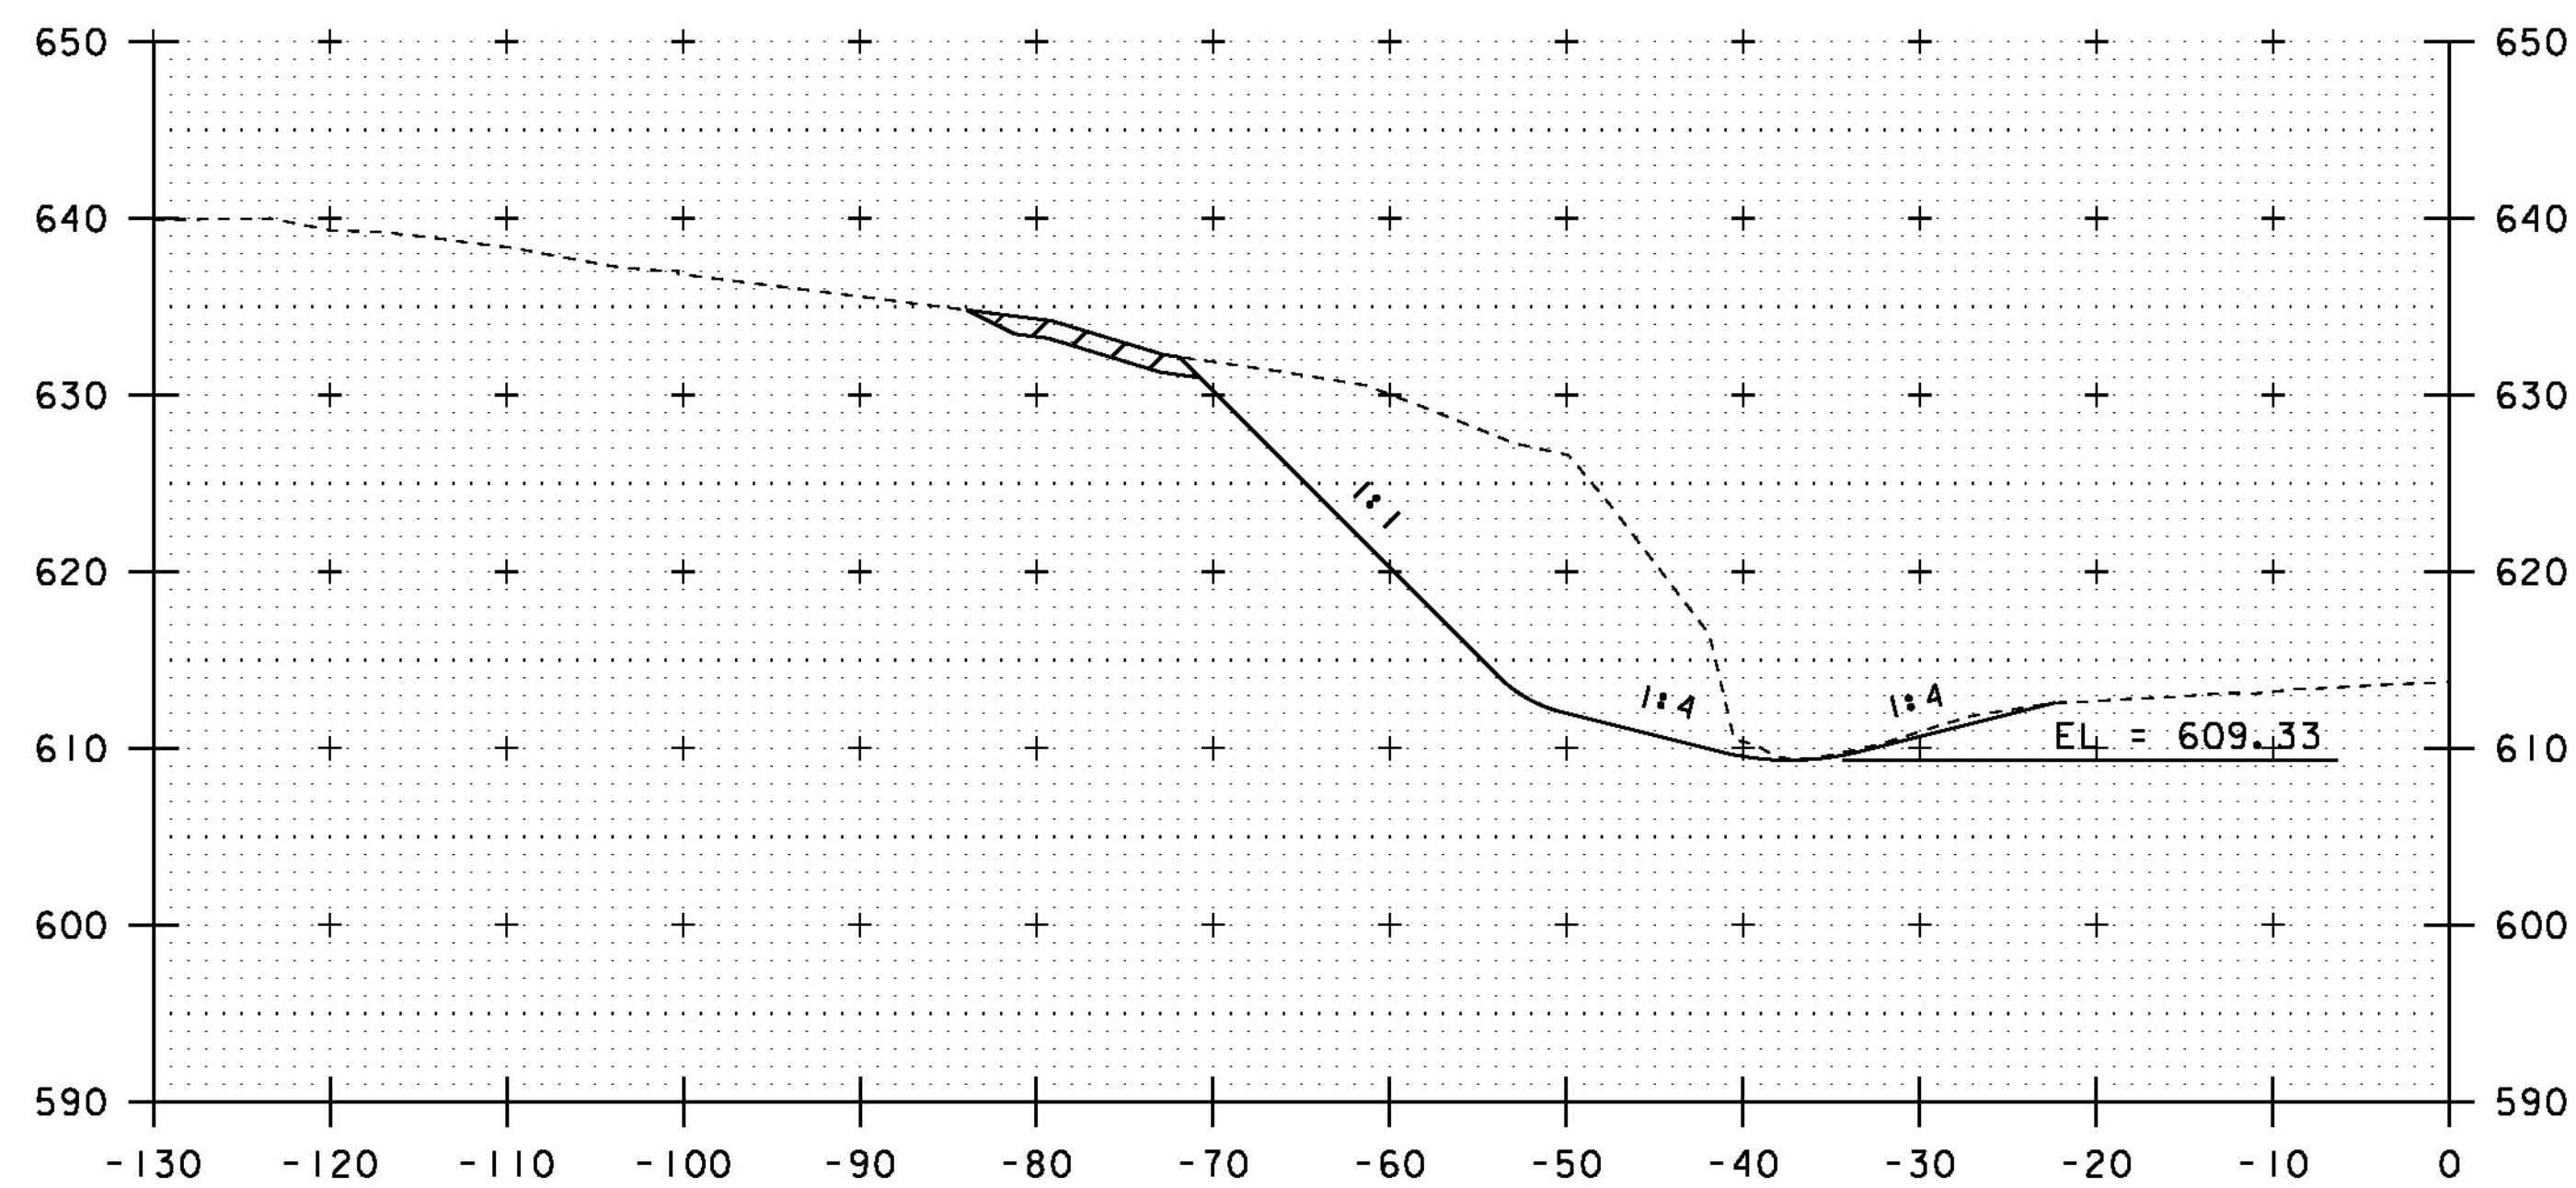

1989+00

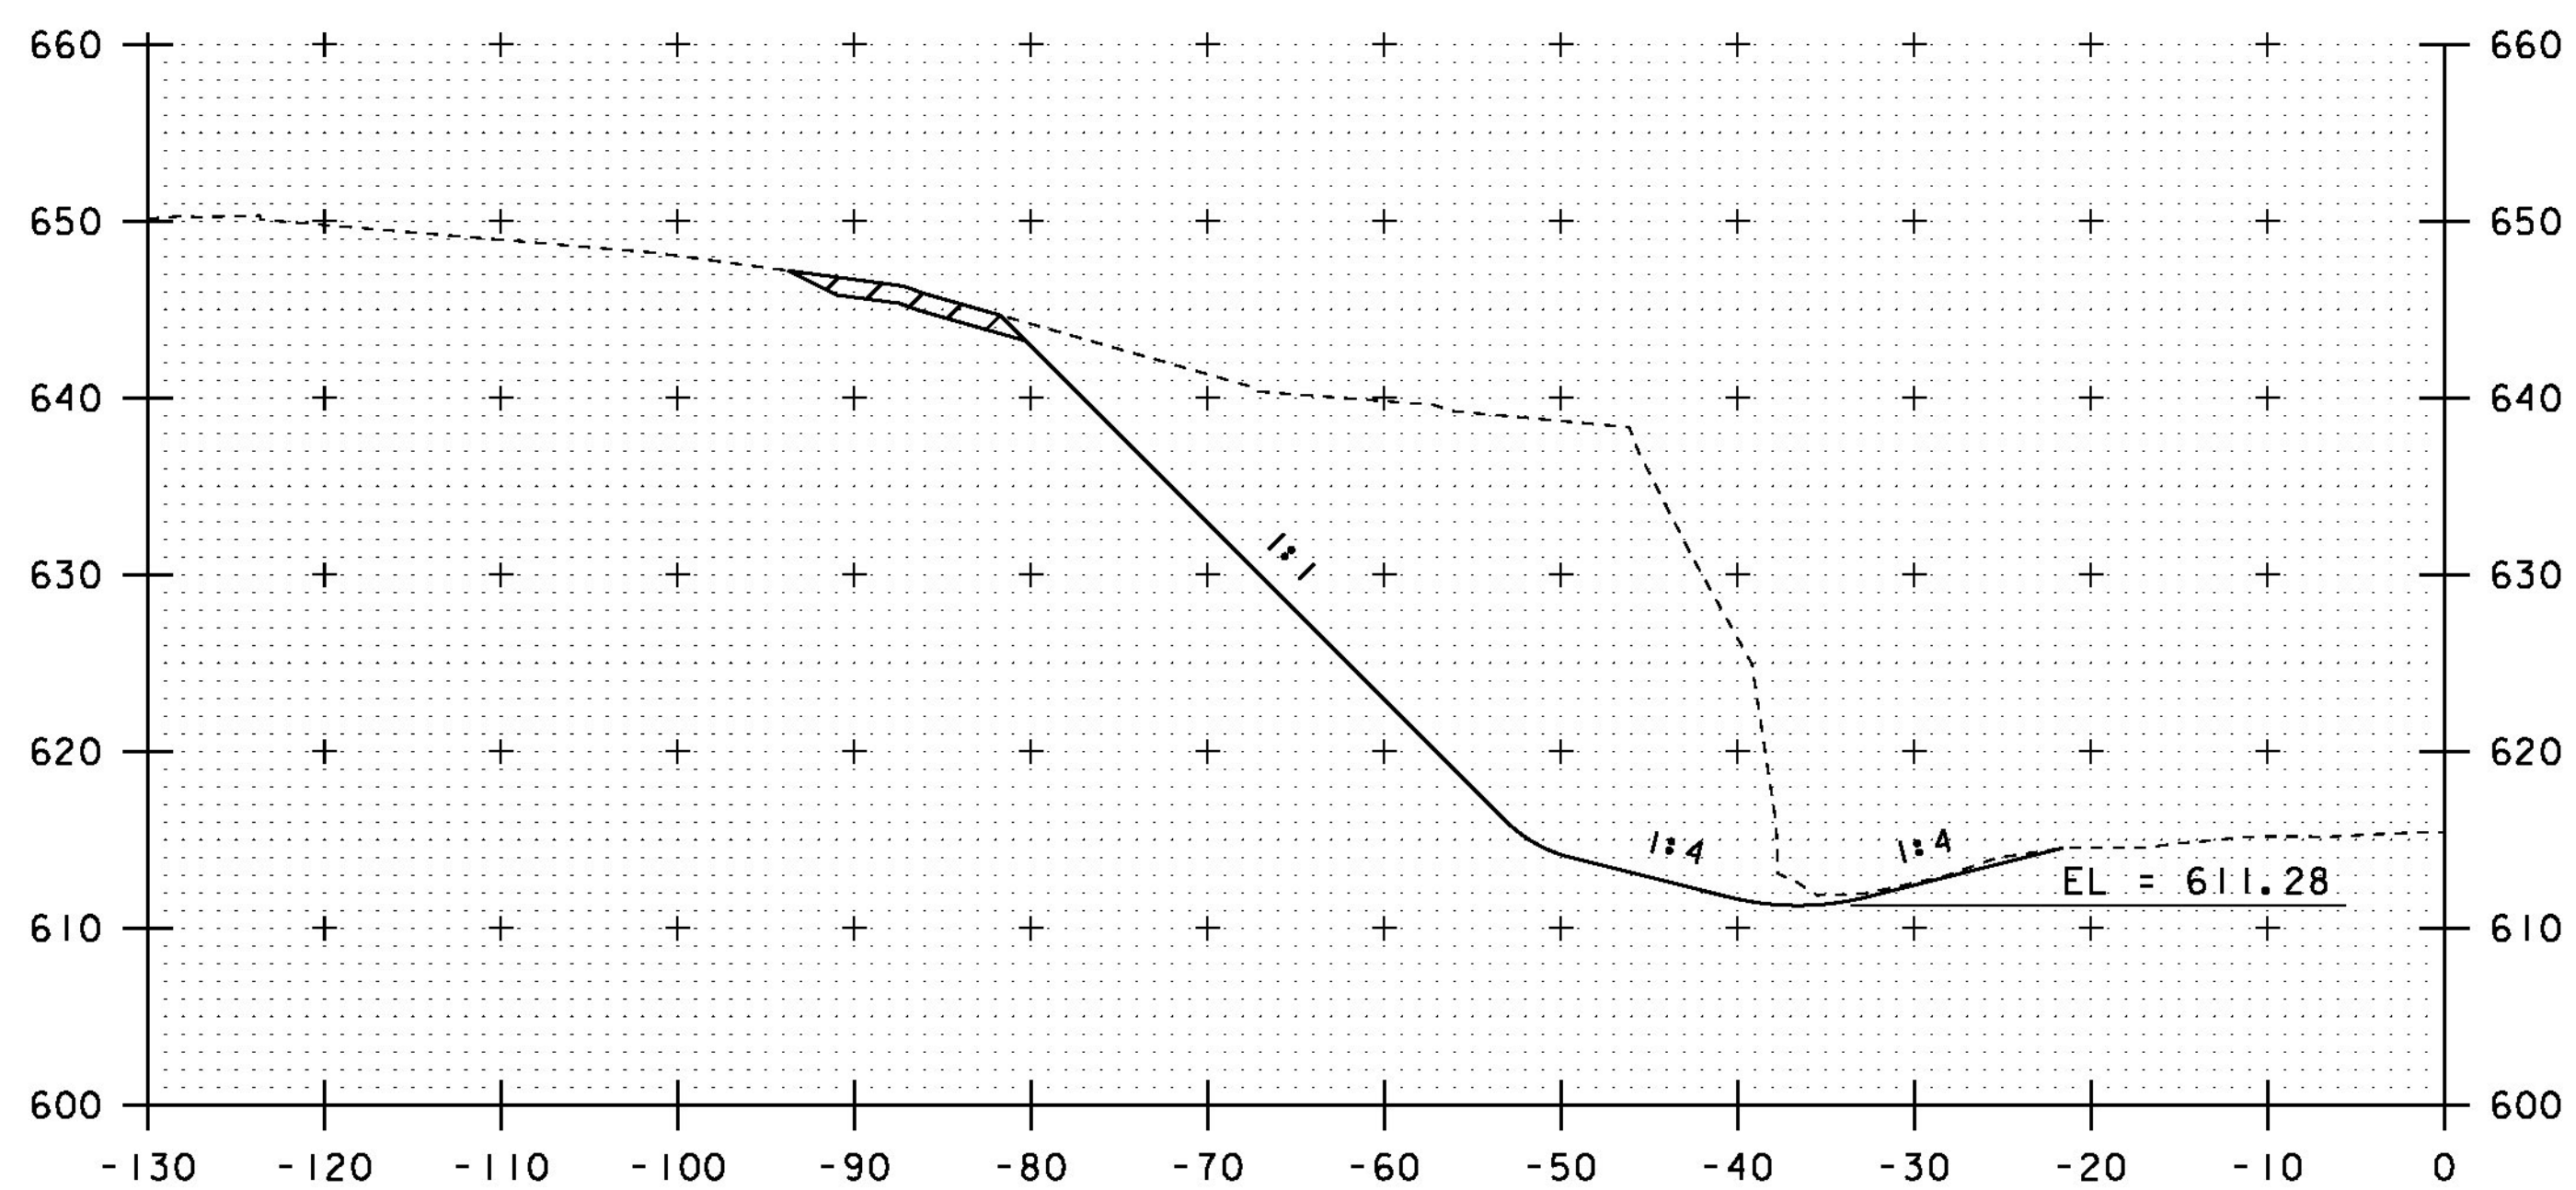

1988+25

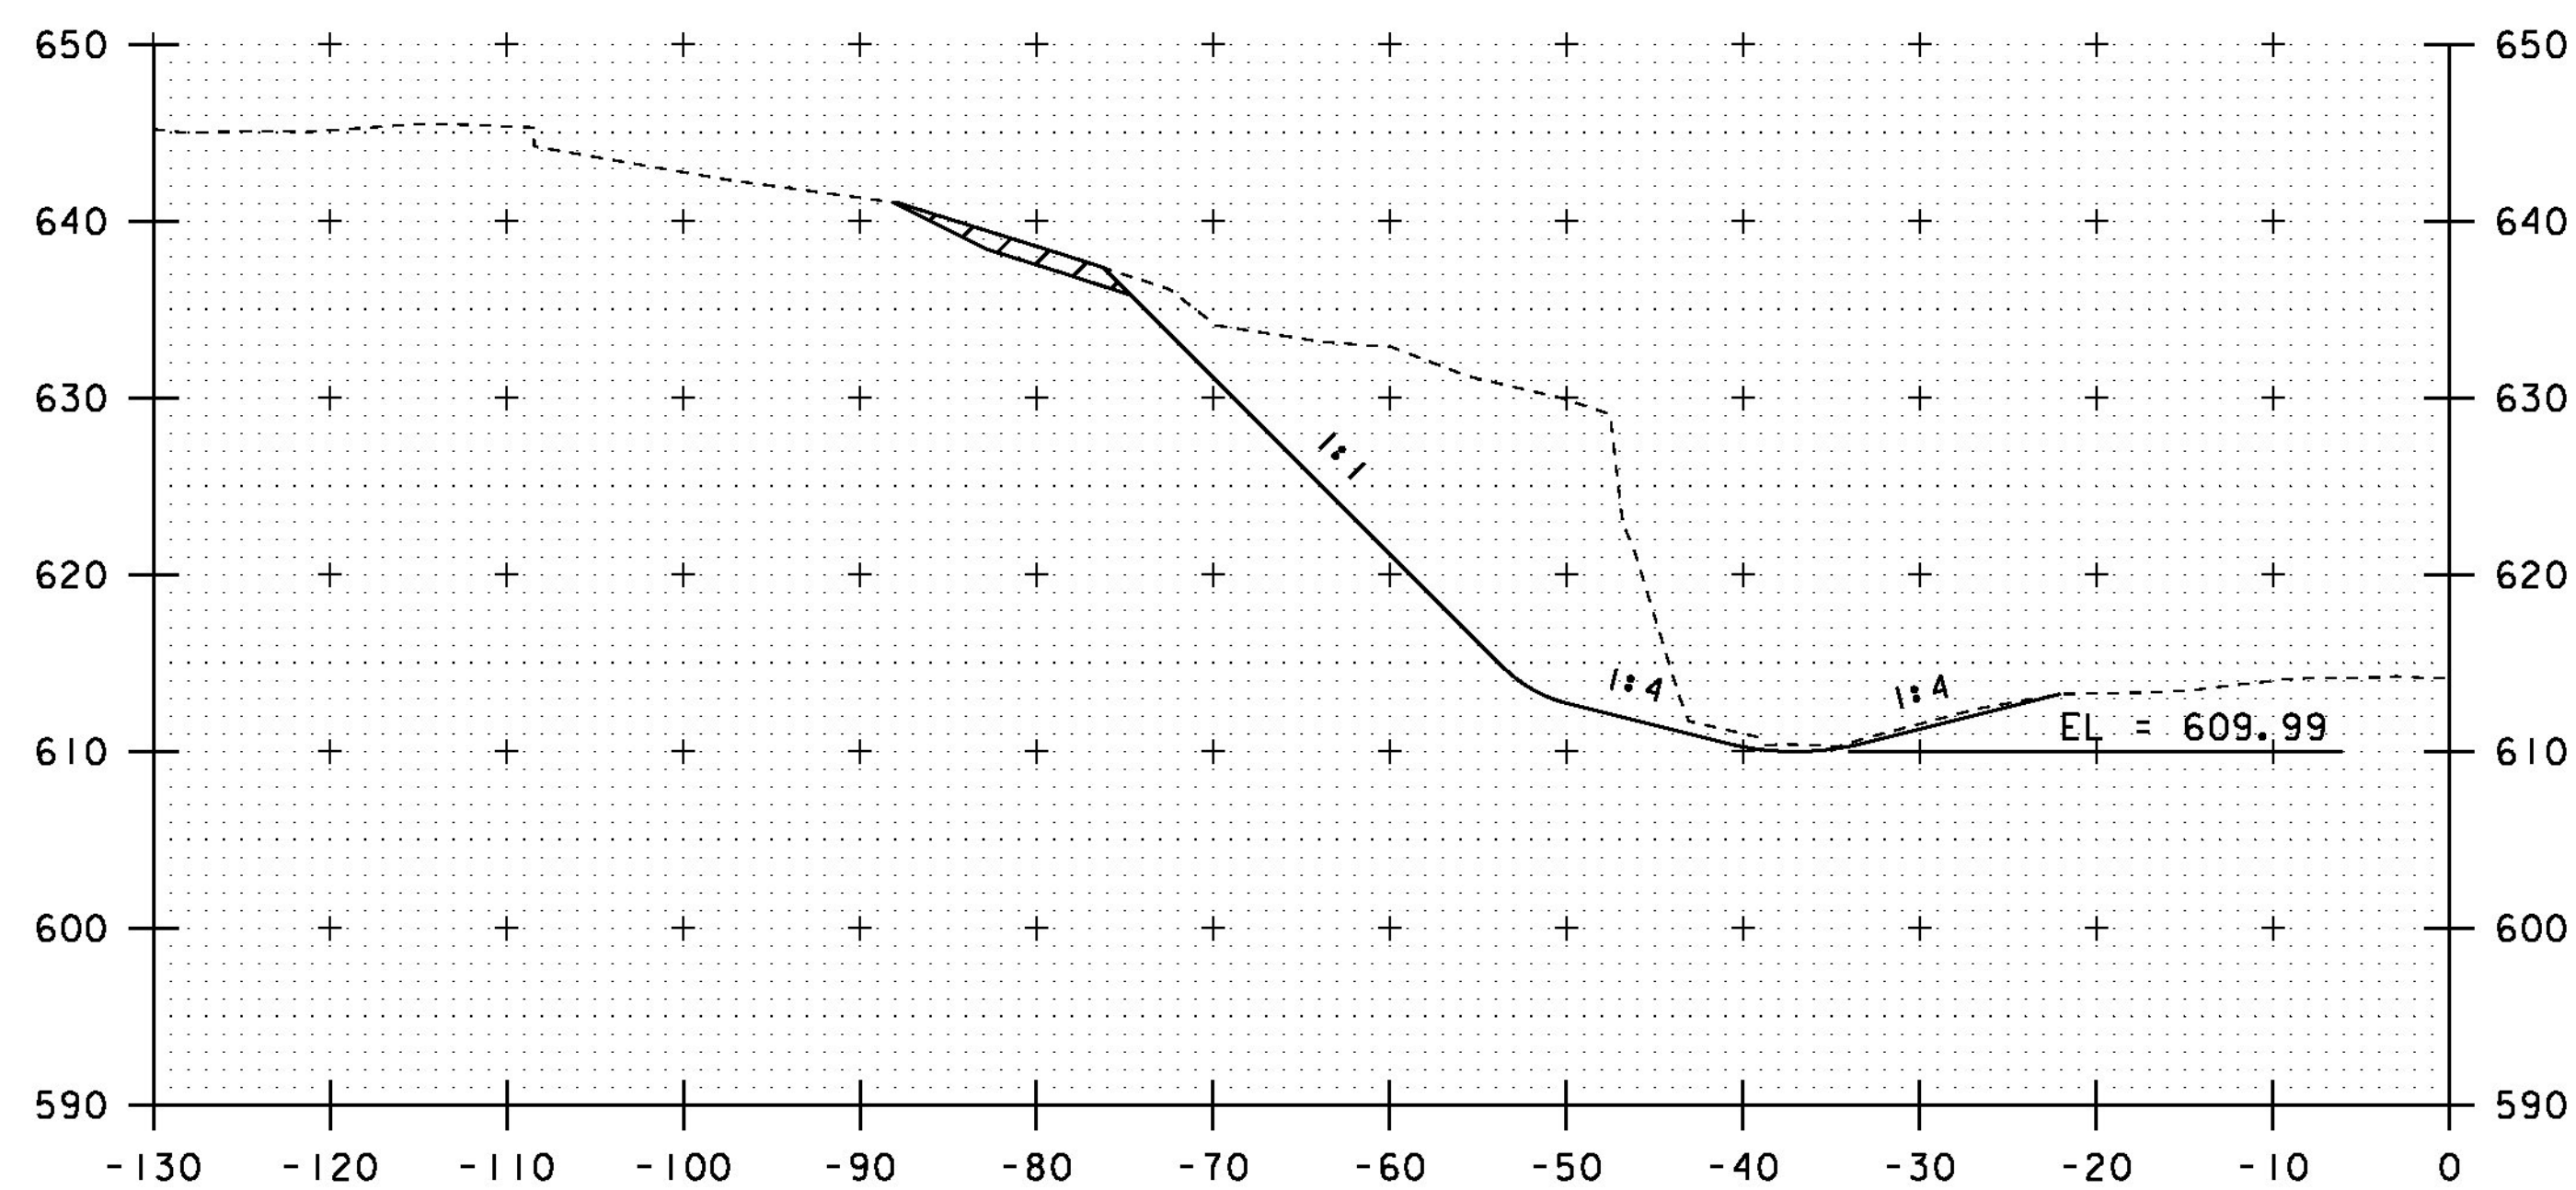

1988+75

STA. 1988+25 TO STA. 1989+00

PROJECT NAME: ROCKINGHAM	PLOT DATE: 29-JAN-2016
PROJECT NUMBER: IM 091-I(71)	DRAWN BY: A. KEMPTON
FILE NAME: d13a366xs.dgn	CHECKED BY: M. GAMELIN
PROJECT LEADER: B. MARTIN	SHEET 26 OF 35
DESIGNED BY: A. KEMPTON	
CROSS SECTION SHEET 7	