



1989+50

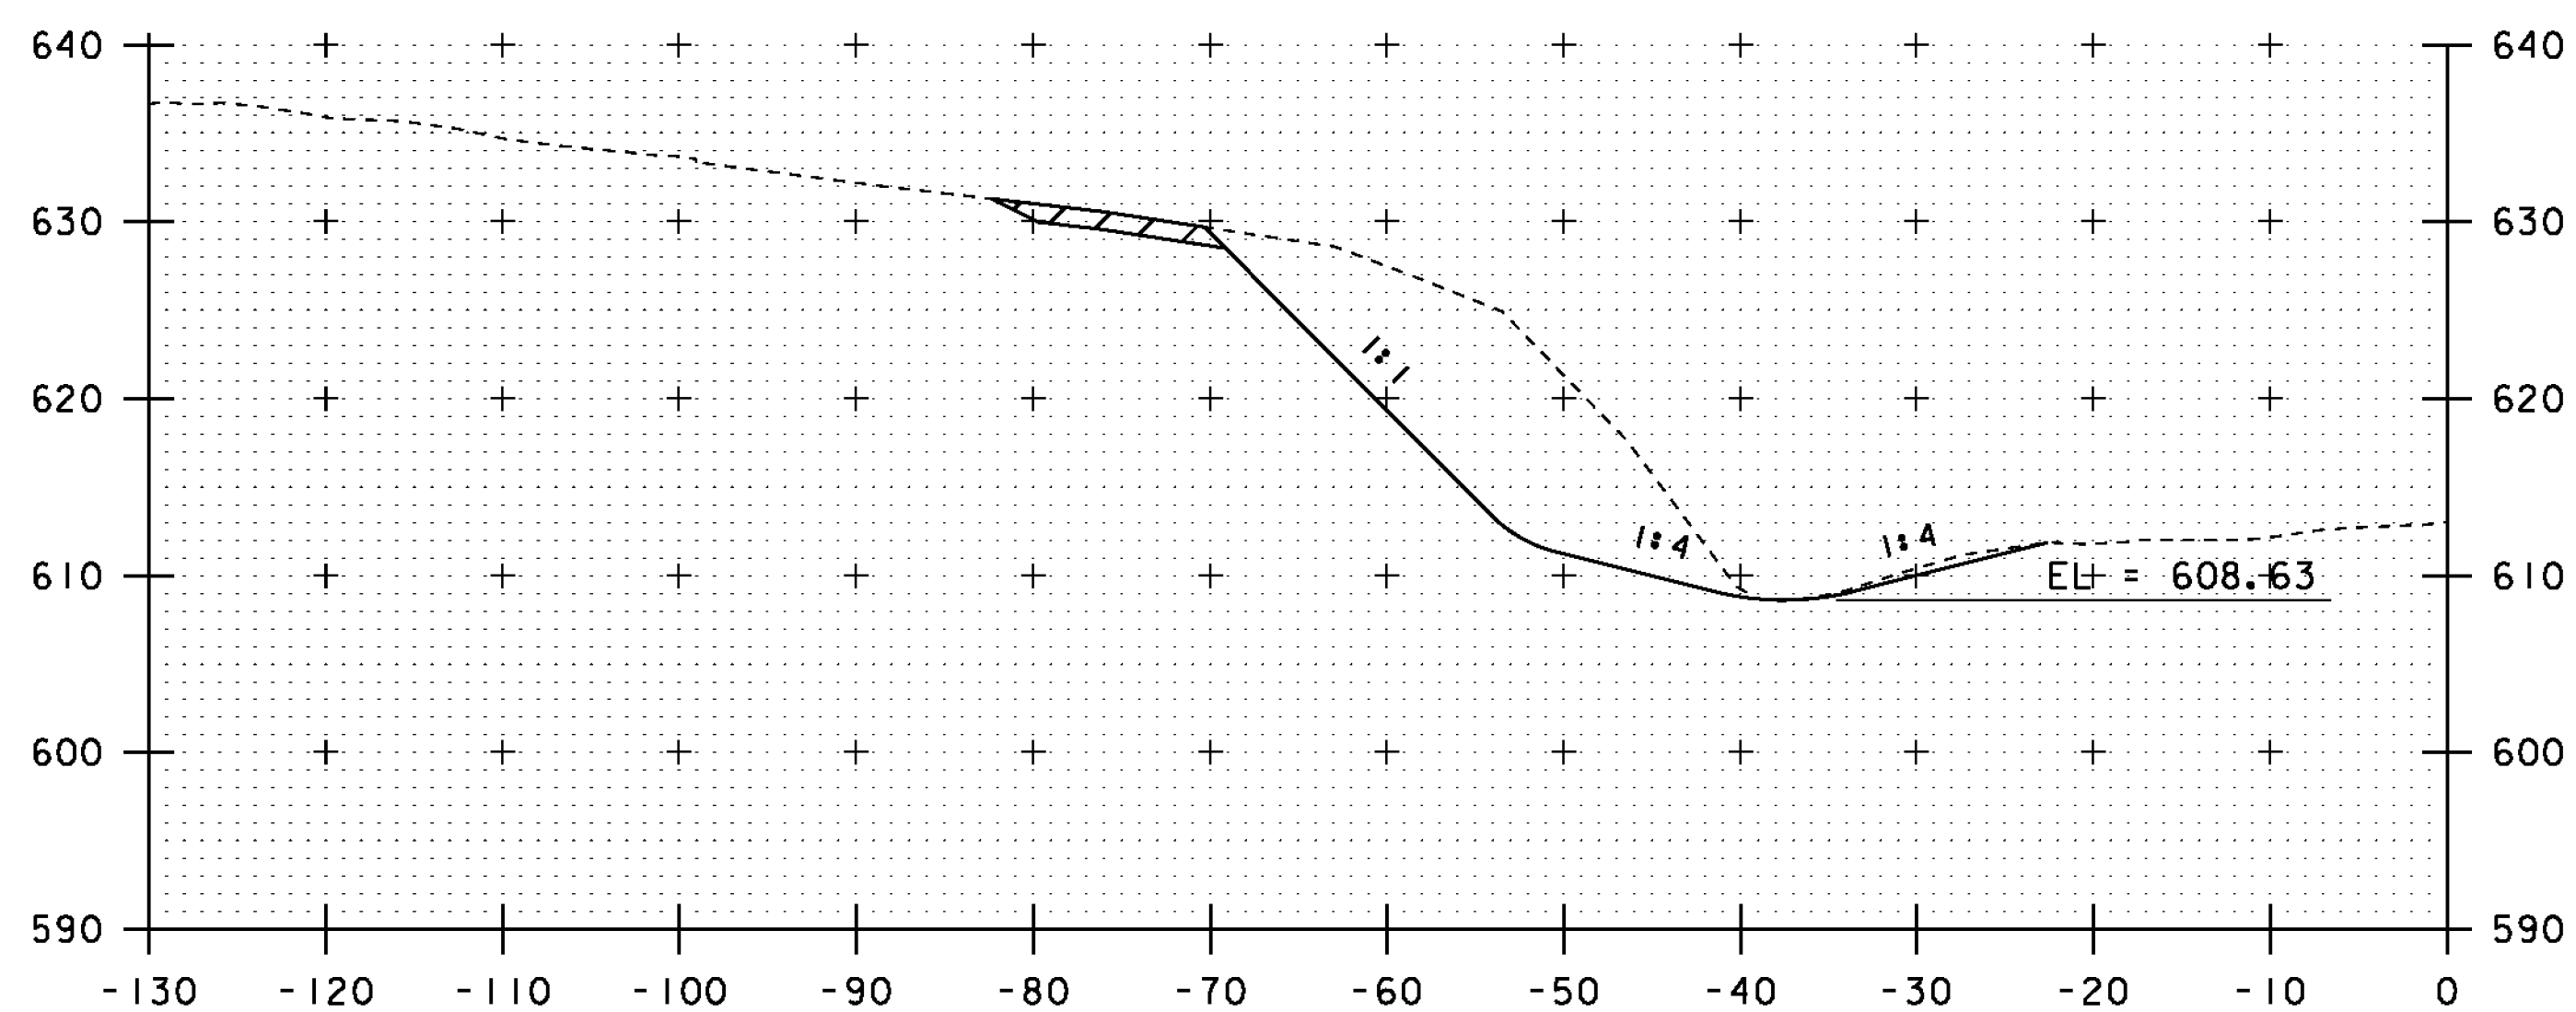


1989+25

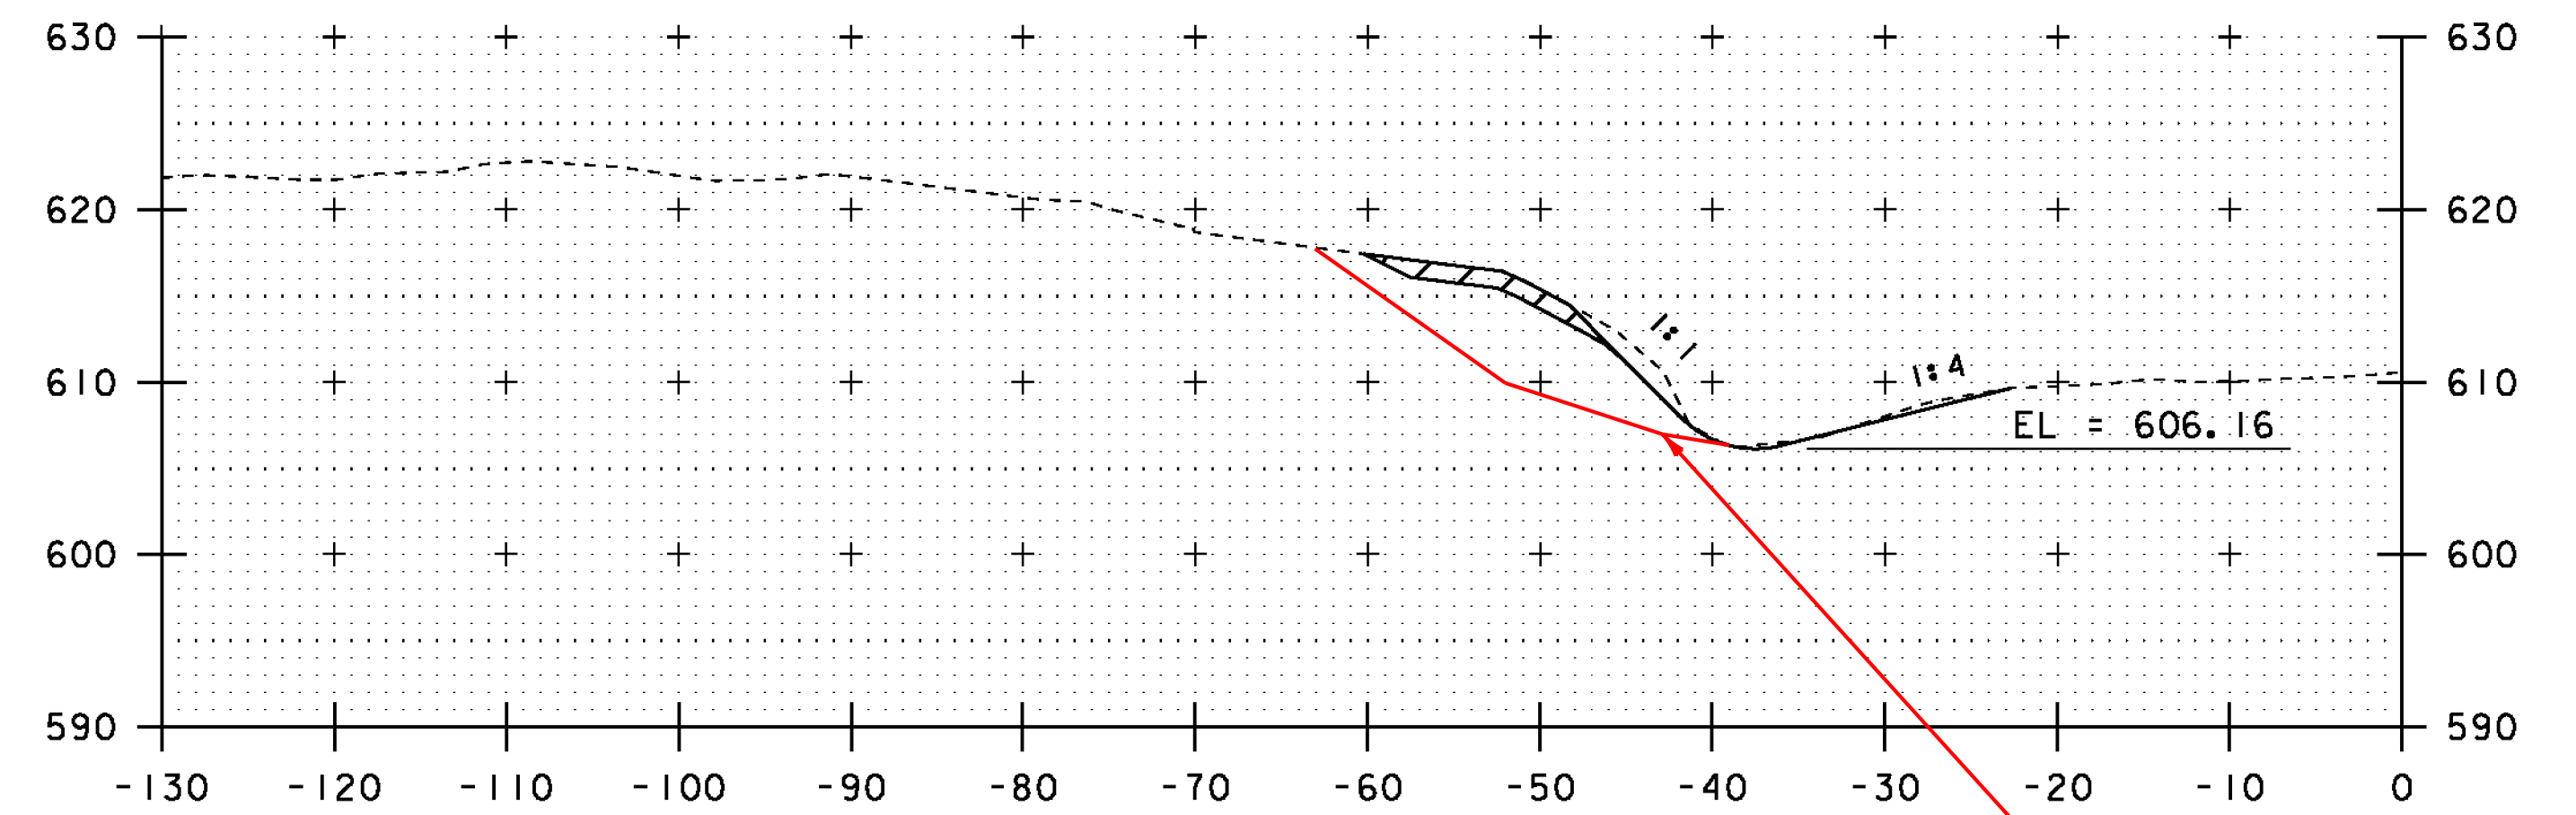

1990+00
END PROJECT

RED LINES INDICATE FINAL LIMITS
OF SOLID ROCK EXCAVATION (TYP.)

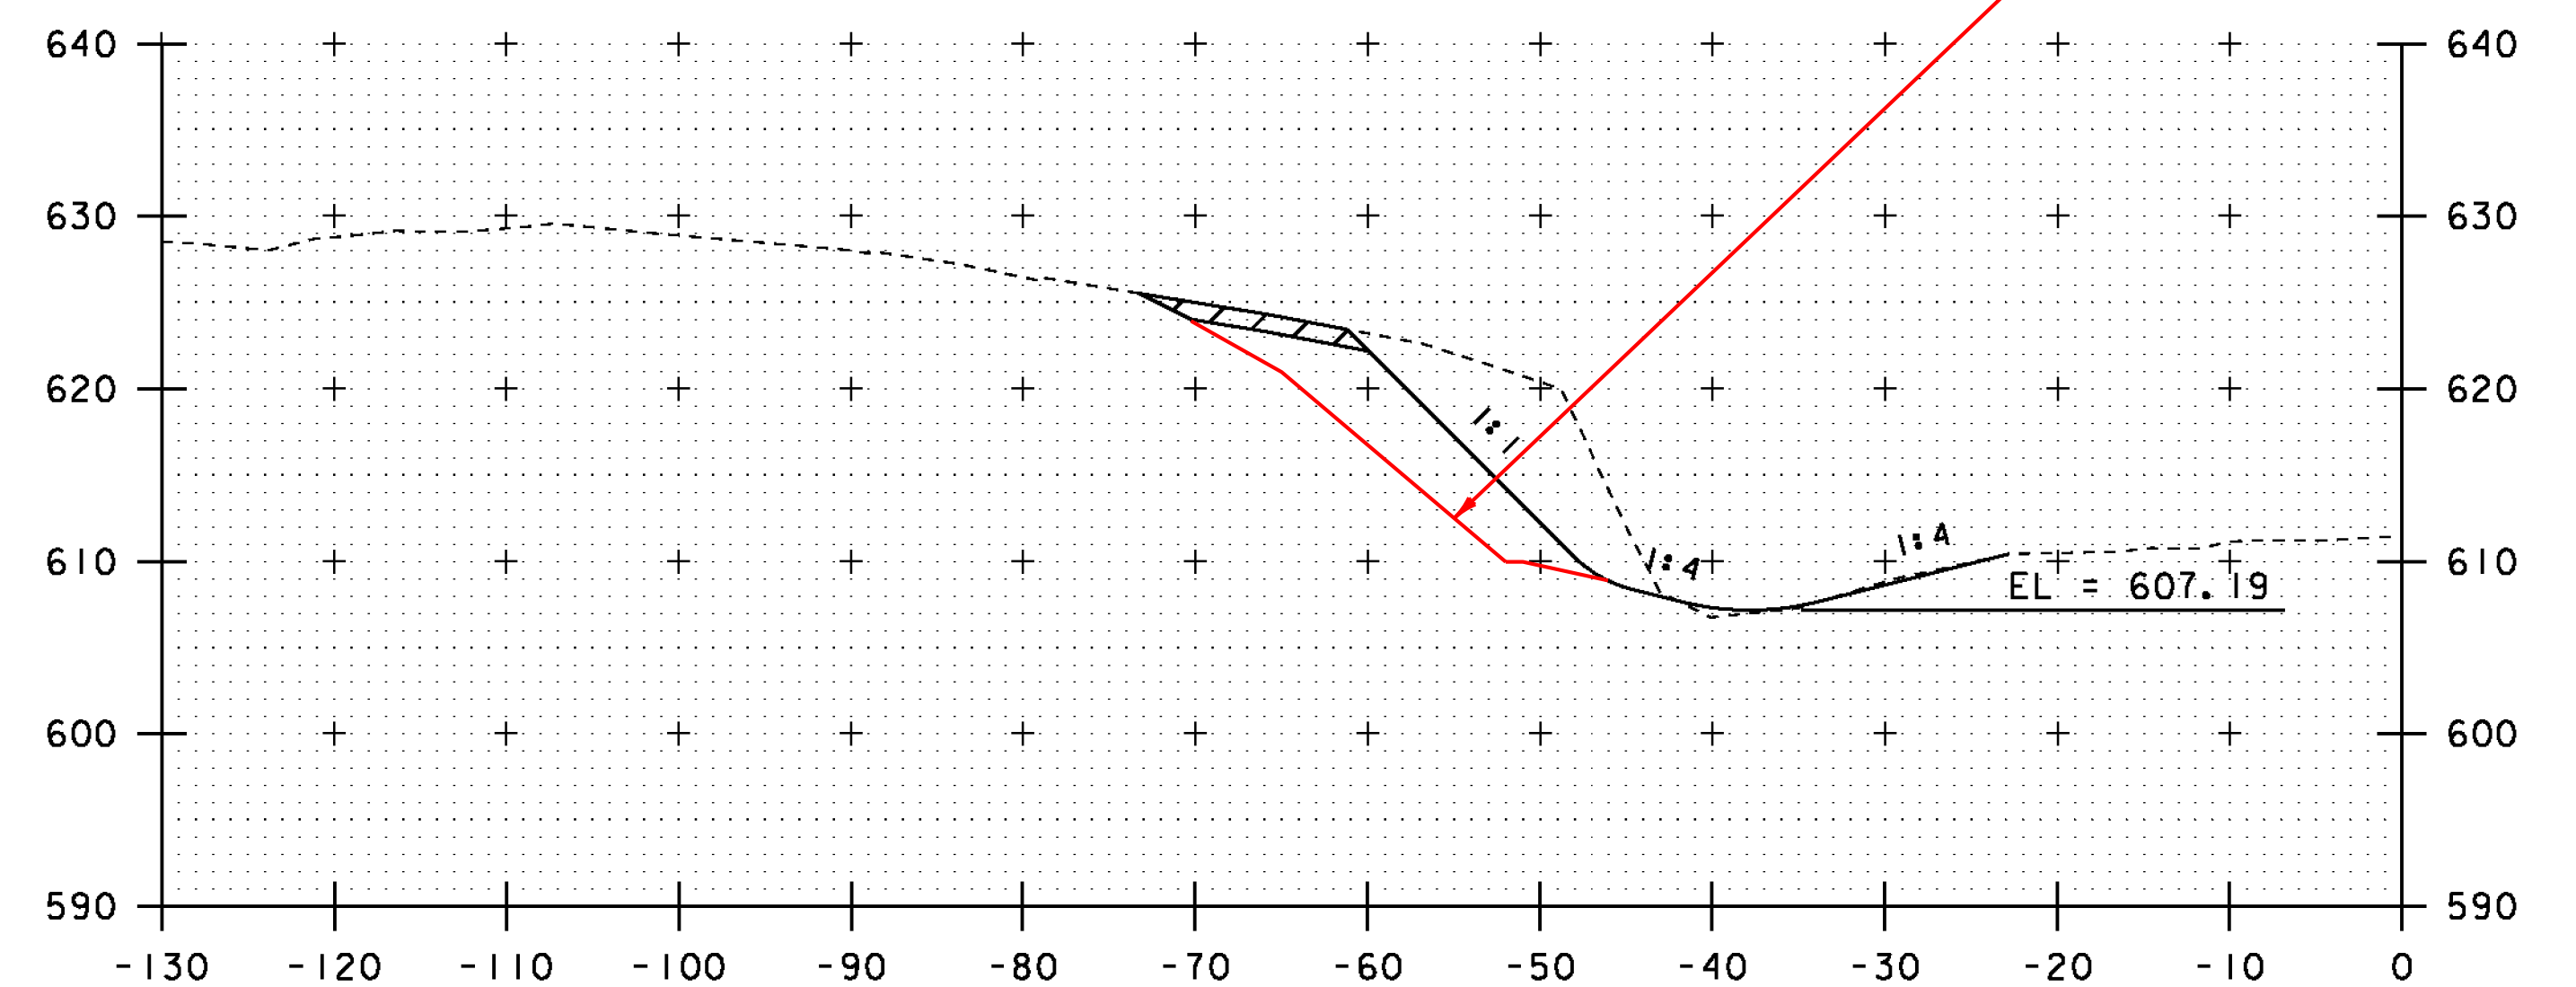

1989+75

STA. 1989+25 TO STA. 1990+00

PROJECT NAME: ROCKINGHAM	PLOT DATE: 29-JAN-2016
PROJECT NUMBER: IM 091-(71)	DRAWN BY: A. KEMPTON
FILE NAME: d13a366xs.dgn	CHECKED BY: M. GAMELIN
PROJECT LEADER: B. MARTIN	SHEET 27 OF 35
DESIGNED BY: A. KEMPTON	
CROSS SECTION SHEET 8	