



STATE OF VERMONT AGENCY OF TRANSPORTATION

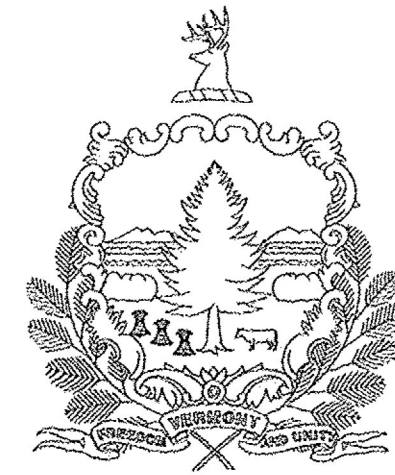

PROPOSED IMPROVEMENT TOWN OF RYEGATE COUNTY OF CALEDONIA I-91 (PRINCIPAL ARTERIAL - INTERSTATE) (NHS)

RECORD PLANS	
CONTRACTOR:	WINTerset, INC. - LYNDONVILLE, VT
RESIDENT ENGINEER:	MIKE BOOTH
CONSTRUCTION BEGAN:	AUGUST 28, 2017
CONSTRUCTION COMPLETE:	MAY 17, 2018
RECORD PLANS BY:	MIKE BOOTH & JESSE IVES
I HEREBY CERTIFY THAT ALL THE CONSTRUCTION REQUIRED BY THIS SET OF DRAWINGS HAS BEEN ACCOMPLISHED AS INDICATED HEREIN.	
BY	RESIDENT ENGINEER
DATE	10-9-18
NOTE: Any further information concerning final quantities, amounts or other details relative to this project may be found at Central Files in the electronic archives.	

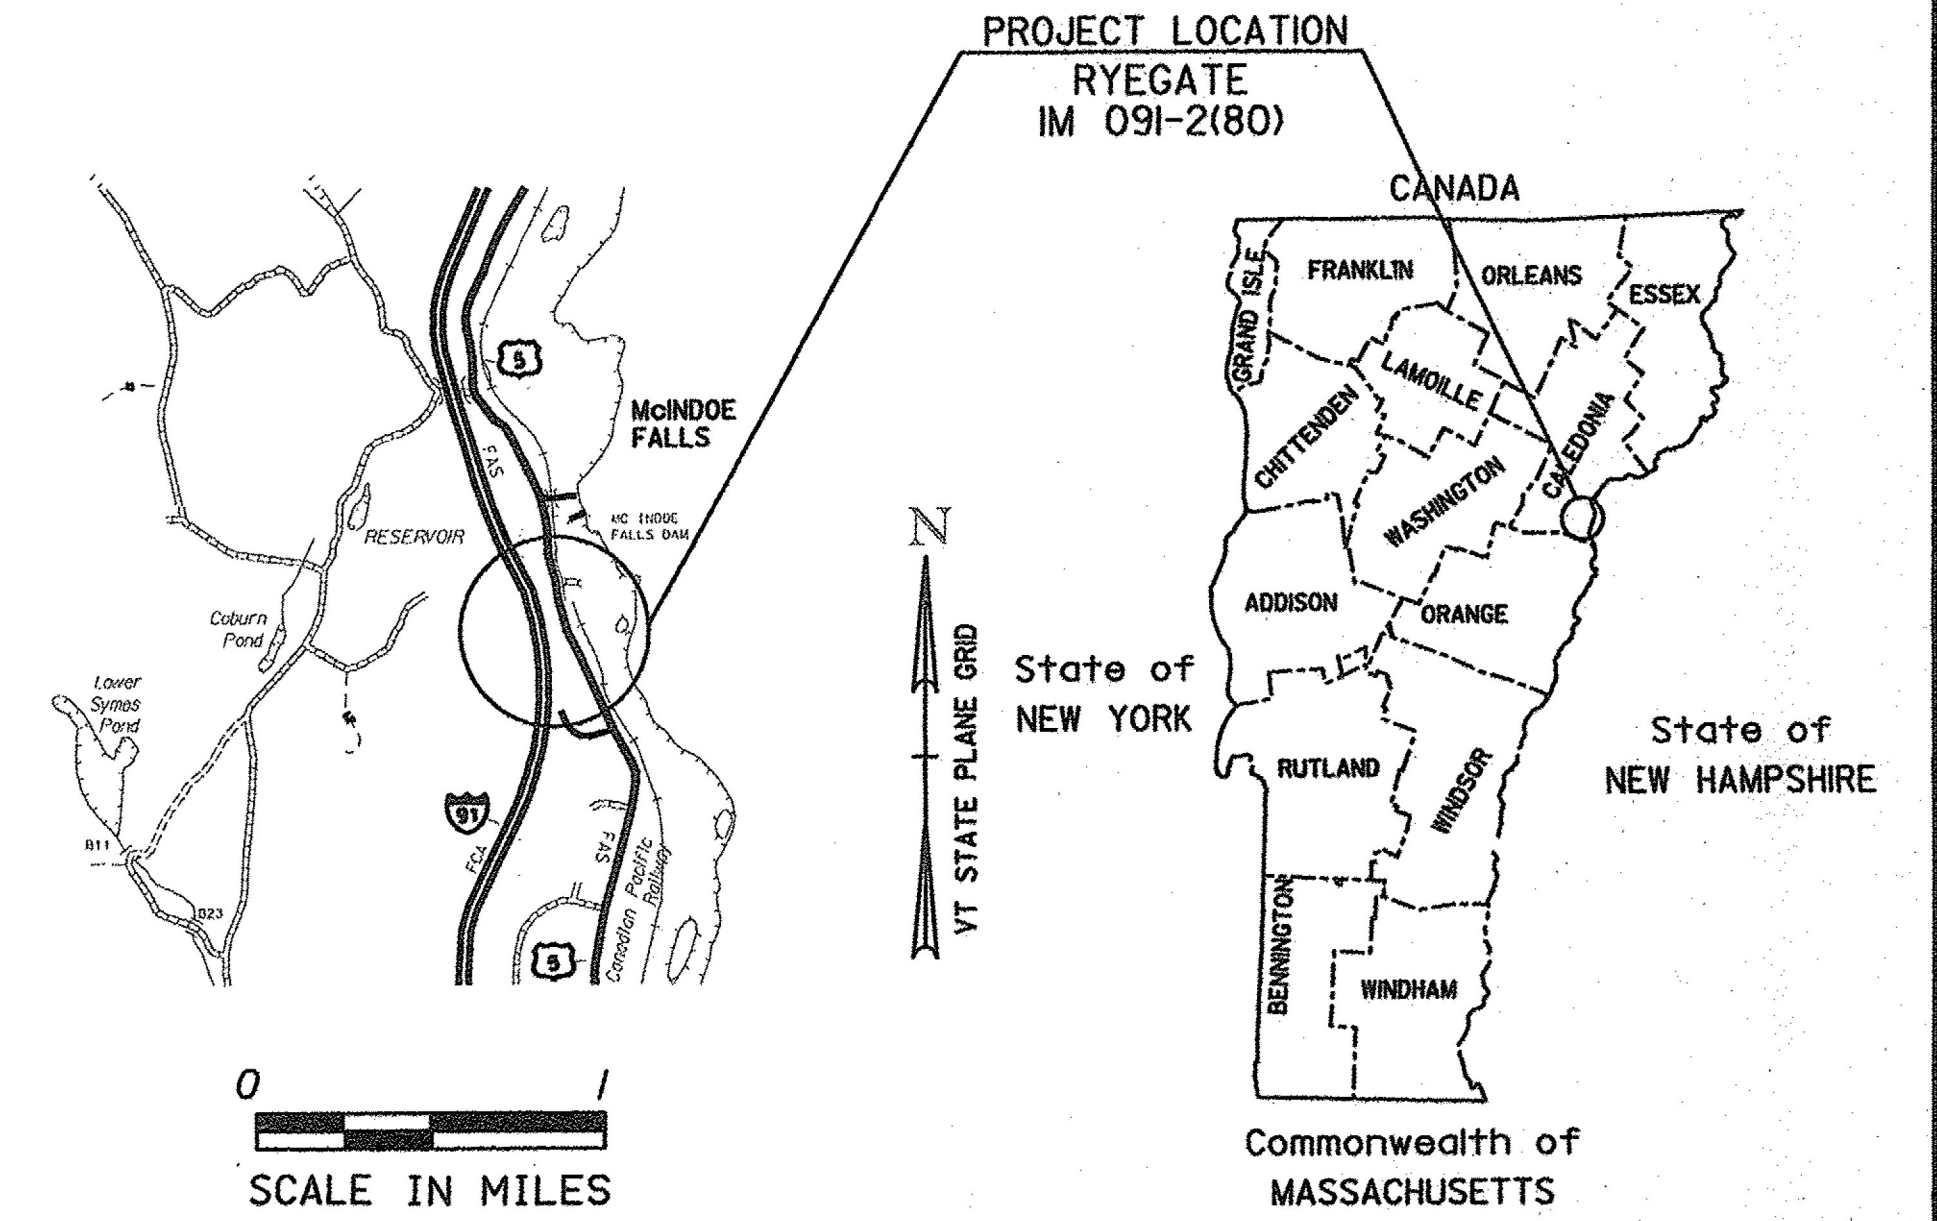


ADJACENT TO AND RIGHT OF INTERSTATE 91 NORTHBOUND BEGINNING AT STA N 6169+35.00 (MM 116.844) AND EXTENDING NORTHERLY 875.00 FEET (0.166 MILE) TO AN ENDING POINT AT STA N 6178+10.00 (MM 117.009).

LENGTH OF PROJECT NORTHBOUND = 875.00 FEET (0.166 MILE)

ALSO, ADJACENT TO AND LEFT OF INTERSTATE 91 SOUTHBOUND BEGINNING AT STA S 6171+15.50 (MM 116.878) AND EXTENDING NORTHERLY 1,229.40 FEET (0.233 MILE) TO AN ENDING POINT AT STA S 6183+44.90 (MM 117.111).


LENGTH OF PROJECT SOUTHBOUND = 1,229.40 FEET (0.233 MILE)
TOTAL LENGTH OF PROJECT = 2,104.40 FEET (0.399 MILE)

WORK TO BE PERFORMED UNDER THIS PROJECT INCLUDES HAND SCALING, TRIM BLASTING, CATCHMENT DITCH EXCAVATION, WIRE MESH ROCK SLOPE PROTECTION SYSTEM INSTALLATION, GUARDRAIL INSTALLATION AND OTHER HIGHWAY RELATED ITEMS.

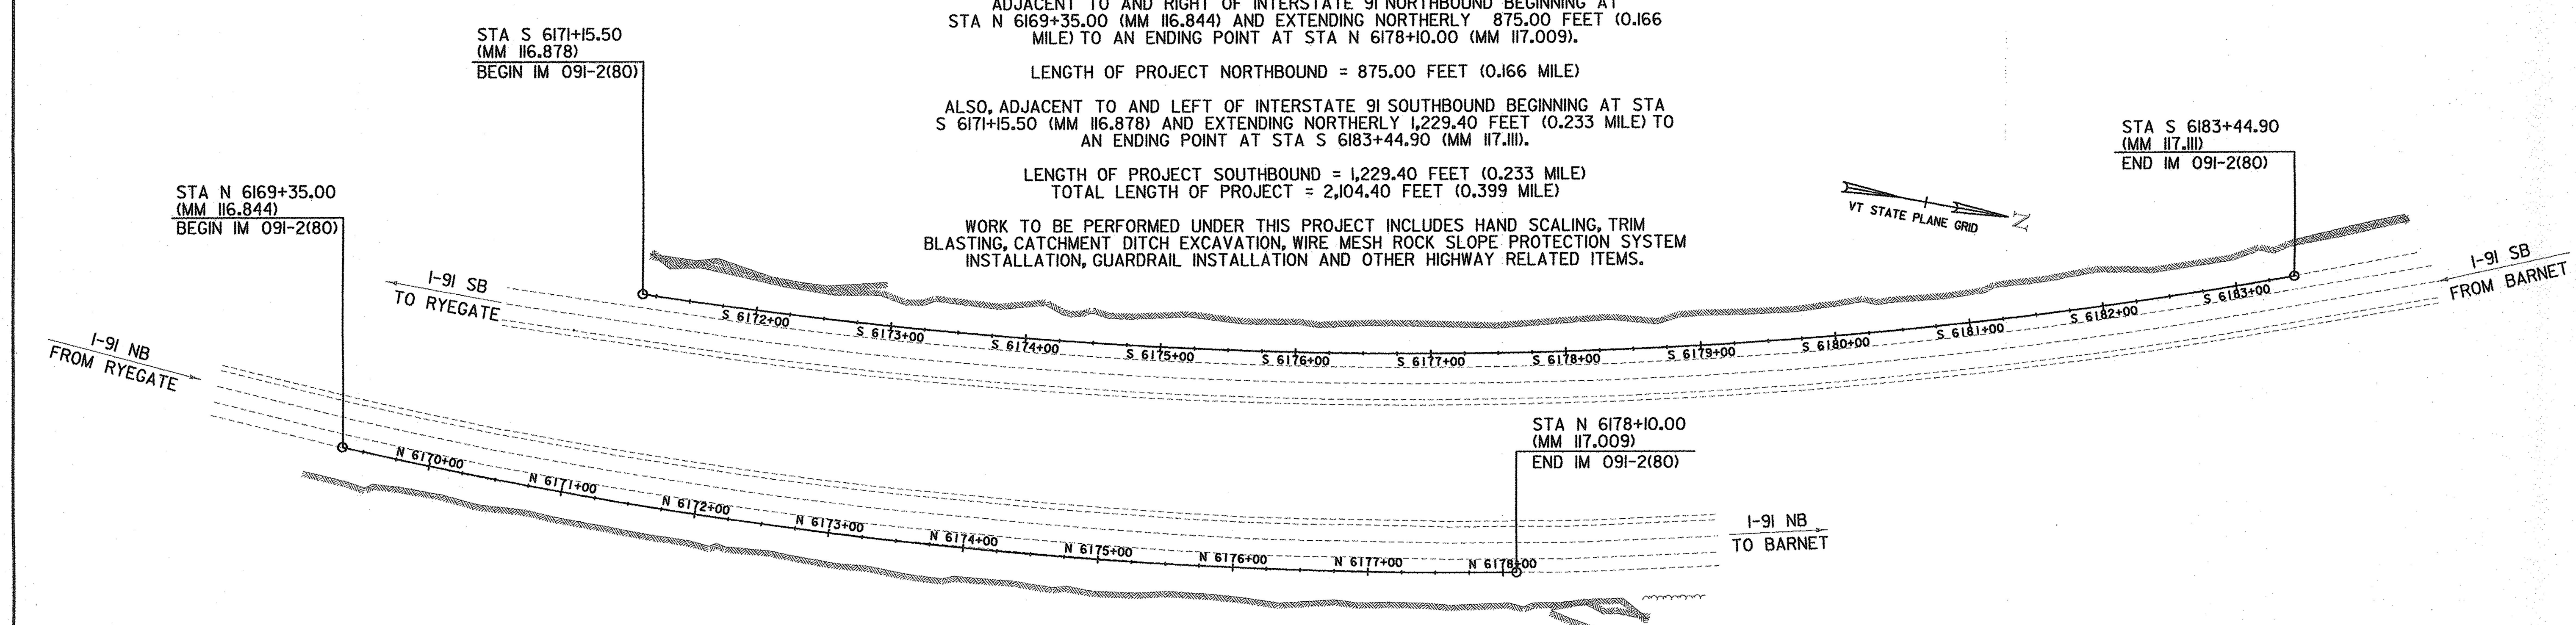

CONSTRUCTION IS TO BE CARRIED ON IN ACCORDANCE WITH THESE PLANS AND THE STANDARD SPECIFICATIONS FOR CONSTRUCTION DATED 2011, AS APPROVED BY THE FEDERAL HIGHWAY ADMINISTRATION ON JULY 20, 2011 FOR USE ON THIS PROJECT, INCLUDING ALL SUBSEQUENT REVISIONS AND SUCH REVISED SPECIFICATIONS AND SPECIAL PROVISIONS AS ARE INCORPORATED IN THESE PLANS.

QUALITY ASSURANCE PROGRAM : LEVEL I	
SURVEYED BY :	R. GILMAN, VAOT
SURVEYED DATE :	06/2014
DATUM	
VERTICAL	NAVD88
HORIZONTAL	NAD 83 (2011)

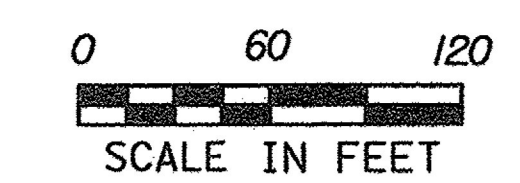

PLANS PREPARED BY 	DIRECTOR OF PROJECT DELIVERY APPROVED DATE 4/4/2017 PROJECT MANAGER : BRUCE MARTIN, P.E. PROJECT NAME : RYEGATE PROJECT NUMBER : IM 091-2(80) SHEET 1 OF 61 SHEETS
-----------------------	--